



HOWARD COUNTY HEALTH DEPARTMENT

24463

DATE
5/11/06

PS

Received
From

5 K. PLUMBING & HEATING, INC. PHONE # 410-775-0562
1220 FISK HWY, KEYMAR MD 21757

For

Septic Permit - 10925 Tompkins Way
Preserve @ University Woods, Lot 5

☐ CASH

☒ CHECK

NO.

2801

Three Hundred Ninety Six and 00/100 Dollars

\$

396.00

Received By

Stephen Nelson

LAYOUT _____ INSP 4 _____
INSP 2 _____ INSP 5 _____
INSP 3 _____ INSP 6 _____

ISSUE DATE: 5/11/06

P 524463

APPROVAL DATE: 11/28/06

A 514619-E

PERMIT

ON-SITE SEWAGE DISPOSAL SYSTEM HOWARD COUNTY HEALTH DEPARTMENT BUREAU OF ENVIRONMENTAL HEALTH

S & K Plumbing & Heating, Inc. IS PERMITTED TO INSTALL ☒ ALTER ☐

ADDRESS: 1220 FSK Hwy, Keymar 21757 PHONE NUMBER: 410-775-0562

SUBDIVISION: Preserve @ Waverly Woods LOT NUMBER: 5

ADDRESS: 10925 Tompkins Way PROPERTY OWNER: Trinity Quality Homes

SEPTIC TANK CAPACITY (GALLONS): 1500 OUTLET BAFFLE FILTER REQUIRED ☐

PUMP CHAMBER CAPACITY (GALLONS): 1500 COMPARTMENTED TANK REQUIRED ☐

NUMBER OF BEDROOMS: 5

SQUARE FEET PER BEDROOM: 180

LINEAR FEET OF TRENCH REQUIRED: 180

TRENCHES:	Trench to be 3.0 feet wide. Inlet 3.0 feet below original grade. Bottom maximum depth 5.0 feet below original grade. Effective area begins at 3.0 feet below original grade. 2.0 feet of stone below distribution pipe.
LOCATION:	Place the distribution box as shown on the approved septic plan.
NOTES:	

PLANS APPROVED: Sara Fegel DATE: 2/22/06

NOTE: PERMIT VOID AFTER 2 YEARS

NOTE: CONTRACTOR RESPONSIBLE FOR SCHEDULING A PRE-CONSTRUCTION INSPECTION FOR ALL INSTALLATIONS


NOTE: WATERTIGHT SEPTIC TANKS REQUIRED

NOTE: ALL PARTS OF SEPTIC SYSTEM SHALL BE 100 FEET FROM ANY WATER WELL

NOTE: MANHOLE RISERS REQUIRED ON ALL SEPTIC TANKS AND PUMP CHAMBERS UNLESS SPECIFICALLY AUTHORIZED

**NEITHER THE HOWARD COUNTY COUNCIL NOR THE HEALTH DEPARTMENT IS
RESPONSIBLE FOR THE SUCCESSFUL OPERATION OF ANY SYSTEM
PERMITTEE RESPONSIBLE FOR OBTAINING FINAL APPROVAL ON THIS PERMIT
CALL 410-313-2640 FOR INSPECTION OF SEPTIC SYSTEM**

NOT TO SCALE.

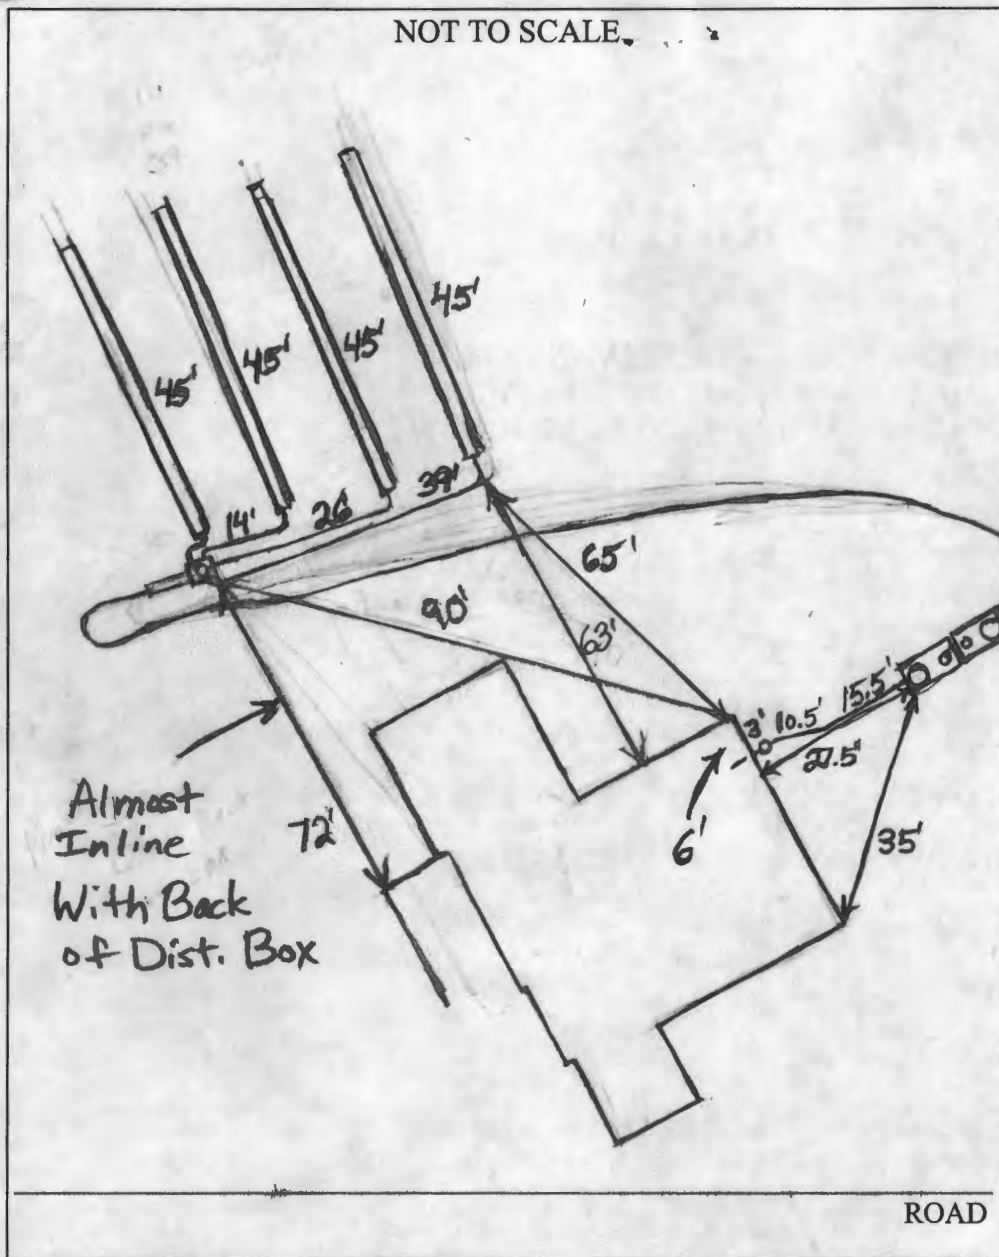

TRENCH/DRAINFIELD DATA

WIDTH	INLET	BOTTOM
3'	3'	5'
NUMBER OF TRENCHES		4
TOTAL LENGTH		180'
ABSORPTION AREA		540+Sidewall
DISTRIBUTION BOX LEVEL		Yes
DISTRIBUTION BOX BAFFLE		Yes
DISTRIBUTION BOX PORT		Yes

SEPTIC TANK DATA

SEPTIC TANK 1 LEVEL		Yes
CAPACITY	1500	GAL
SEAM LOC	Top	
TANK LID DEPTH	2'-4'	
BAFFLES	Yes	
BAFFLE FILTER	No	
MANHOLE LOC	Front	
6" PORT LOC	Rear	
WATERTIGHT TEST	No	
SEPTIC TANK 2 LEVEL		Yes
CAPACITY	1500	GAL
SEAM LOC	Top	
TANK LID DEPTH	0.5'-2'	
BAFFLES	Front	
BAFFLE FILTER	No	
MANHOLE LOC	Rear	
6" PORT LOC	Front	
WATERTIGHT TEST	No	

PRE-CONSTRUCTION

INSTALLATION 7/10/06 Need pump and alarm test. (BB)

11/28/06 P/A Test OK. System passed (Kw)

FINAL INSPECTOR

[Signature]

DATE OF APPROVAL

11/28/06