



Building Permit Application

Howard County Maryland
Department of Inspections, Licenses and Permits
3430 Court House Drive
Permits: 410-313-2455
www.howardcountymd.gov

Date Received: _____

Permit No.: B160050413

Building Address: 12014 TRIADOLPHIA Rd
City: ELICOTT City State: MD Zip Code: 21042
Suite/Apt. #: _____ SDP/WP/BA #: _____
Census Tract: _____ Subdivision: _____
Section: _____ Area: _____ Lot: _____
Tax Map: _____ Parcel: _____ Grid: _____
Zoning: _____ Map Coordinates: _____ Lot Size: _____

Existing Use: _____
Proposed Use: _____
Estimated Construction Cost: \$ _____
Description of Work: _____

Occupant/Tenant Name: MARTIN SIEGEL
Was tenant space previously occupied? ☒ Yes ☐ No
Contact Name: _____
Address: _____
City: _____ State: _____ Zip Code: _____
Phone: _____ Fax: _____
Email: _____

Property Owner's Name: MARTIN SIEGEL
Address: 12014 TRIADOLPHIA Rd
City: ELICOTT City State: _____ Zip Code: 21042
Phone: 410-905-5228 Fax: 443-535-2387
Email: _____

Applicant's Name & Mailing Address, (If other than stated herein)
Applicant's Name: Owner
Address: _____
City: _____ State: _____ Zip Code: _____
Phone: _____ Fax: _____
Email: _____

Contractor Company: Paul Davis Restoration
Contact Person: Chris
Address: _____
City: ELICOTT City State: MD Zip Code: 21042
License No.: 39055
Phone: 410-120-1100 Fax: _____
Email: Chris@PDRHOWA.com

Engineer/Architect Company: _____
Responsible Design Prof.: _____
Address: _____
City: _____ State: _____ Zip Code: _____
Phone: _____ Fax: _____
Email: _____

Commercial Building Characteristics	Residential Building Characteristics
Height:	☐ SF Dwelling ☐ SF Townhouse
No. of stories:	Depth Width
Gross area, sq. ft./floor:	1 st floor:
	2 nd floor:
Area of construction (sq. ft.):	Basement:
	☐ Finished Basement
Use group:	☐ Unfinished Basement
	☐ Crawl Space
Construction type:	☐ Slab on Grade
☐ Reinforced Concrete	No. of Bedrooms:
☐ Structural Steel	Multi-family Dwelling
☐ Masonry	No. of efficiency units:
☐ Wood Frame	No. of 1 BR units:
☐ State Certified Modular	No. of 2 BR units:
	No. of 3 BR units:
	Other Structure:
	Dimensions:
☒ Roadside Tree Project Permit	Footings:
☐ Yes ☐ No	Roof:
Roadside Tree Project Permit #	☐ State Certified Modular
	☐ Manufactured Home

Utilities
Electric: ☐ Yes ☐ No
Gas: ☐ Yes ☐ No
Water Supply
☐ Public
☐ Private
Sewage Disposal
☐ Public
☐ Private
Heating System
☐ Electric ☐ Oil
☐ Natural Gas ☐ Propane Gas
☐ Other:
Sprinkler System:
☐ Yes ☐ No
Grading Permit Number:
Building Shell Permit Number:

THE UNDERSIGNED HEREBY CERTIFIES AND AGREES AS FOLLOWS: (1) THAT HE/SHE IS AUTHORIZED TO MAKE THIS APPLICATION; (2) THAT THE INFORMATION IS CORRECT; (3) THAT HE/SHE WILL COMPLY WITH ALL REGULATIONS OF HOWARD COUNTY WHICH ARE APPLICABLE THERETO; (4) THAT HE/SHE WILL PERFORM NO WORK ON THE ABOVE REFERENCED PROPERTY NOT SPECIFICALLY DESCRIBED IN THIS APPLICATION; (5) THAT HE/SHE GRANTS COUNTY OFFICIALS THE RIGHT TO ENTER ONTO THIS PROPERTY FOR THE PURPOSE OF INSPECTING THE WORK PERMITTED AND POSTING NOTICES.

Applicant's Signature: _____ Print Name: _____
Email Address: TSKLM@yahoo.com Date: Dec 3 2016
Title/Company: _____

Checks Payable to: DIRECTOR OF FINANCE OF HOWARD COUNTY
PLEASE WRITE NEATLY & LEGIBLY
FOR OFFICE USE ONLY

AGENCY	DATE	SIGNATURE OF APPROVAL
State Highways		
Building Officials		
PSZA (Zoning)		
PSZA (Engineering)		
Health	<u>12/19/16</u>	<u>R. Buck</u>

Is Sediment Control approval required for issuance? ☐ Yes ☐ No
☐ CONTINGENCY CONSTRUCTION START

DPZ SETBACK INFORMATION
Front:
Rear:
Side:
Side St.:
All minimum setbacks met? ☐ Yes ☐ No
Is Entrance Permit Required? ☐ Yes ☐ No
Historic District? ☐ Yes ☐ No
Lot Coverage for New Town Zone:
SDP/Red-line approval date:

Filing Fee	\$
Permit Fee	\$
Tech Fee	\$
Excise Tax	\$
PSFS	\$
Guaranty Fund	\$
Add'l per Fee	\$
Total Fees	\$
Sub- Total Paid	\$
Balance Due	\$
Check	# <u>194</u>



DDA 16000012

Building Permit Application

Howard County Maryland
Department of Inspections, Licenses and Permits
3430 Court House Drive
Permits: 410-313-2455
www.howardcountymd.gov

Date Received: _____

Permit No.: B16005009

Building Address: 12014 TRIADDELPHIA RD
City: ELICOTT CITY State: MD Zip Code: 21042
Suite/Apt. #: _____ SDP/WP/BA #: _____
Census Tract: _____ Subdivision: _____
Section: _____ Area: _____ Lot: _____
Tax Map: _____ Parcel: _____ Grid: _____
Zoning: _____ Map Coordinates: _____ Lot Size: _____

Existing Use: SFD
Proposed Use: SFD
Estimated Construction Cost: \$ 120,000
Description of Work: REPLACE 7 DAMAGED TRUSS ROOF SHEATHING / ROOF, REPAIR MASONRY VENEER (NON STRUCTURAL), REPLACE INSULATION DETAIL / FLOORING (AS-BUILT / PER CODE)
Occupant/Tenant Name: _____
Was tenant space previously occupied? ☒ Yes ☐ No
Contact Name: Apex 980 Sq. ft.
Address: to original condition
City: *NO INCIDENT REPORT CREATED* State: _____ Zip Code: _____
Phone: _____ Fax: _____
Email: _____

Property Owner's Name: MARTIN SIEGEL
Address: 12014 TRIADDELPHIA RD
City: ELICOTT CITY State: MD Zip Code: 21042
Phone: 410 905 5228 Fax: _____
Email: _____

Applicant's Name & Mailing Address, (if other than stated herein)

Applicant's Name: _____
Address: _____
City: _____ State: _____ Zip Code: _____
Phone: _____ Fax: _____
Email: _____

Contractor Company: PAUL DAVIS RESTORATION
Contact Person: CHRIS LAMBROS
Address: 4785 Suite 103 Dorsey Hall Dr
City: ELICOTT CITY State: MD Zip Code: 21042
License No.: 39055
Phone: 443 875 5099 Fax: 410 730 6160
Email: CHRIS@PDRHOWA.COM

Engineer/Architect Company: _____
Responsible Design Prof.: _____
Address: _____
City: _____ State: _____ Zip Code: _____
Phone: _____ Fax: _____
Email: _____

Commercial Building Characteristics	Residential Building Characteristics	
Height: _____	☐ SF Dwelling	☐ SF Townhouse
No. of stories: _____	Depth	Width
Gross area, sq. ft./floor: _____	1 st floor: _____	
	2 nd floor: _____	
Area of construction (sq. ft.): _____	Basement: _____	
Use group: _____	☐ Finished Basement	
	☐ Unfinished Basement	
	☐ Crawl Space	
Construction type:	☐ Slab on Grade	
☐ Reinforced Concrete	No. of Bedrooms: _____	
☐ Structural Steel	Multi-family Dwelling	
☐ Masonry	No. of efficiency units: _____	
☐ Wood Frame	No. of 1 BR units: _____	
☐ State Certified Modular	No. of 2 BR units: _____	
	No. of 3 BR units: _____	
	Other Structure: _____	
	Dimensions: _____	
☒ Roadside Tree Project Permit	Footings: _____	
☐ Yes ☒ No	Roof: _____	
Roadside Tree Project Permit # _____	☐ State Certified Modular	
	☐ Manufactured Home	

Utilities	
Electric: ☒ Yes ☐ No	
Gas: ☐ Yes ☐ No	
Water Supply	
☐ Public	
☒ Private	
Sewage Disposal	
☐ Public	
☒ Private	
Heating System	
☐ Electric ☐ Oil	
☐ Natural Gas ☐ Propane Gas	
☐ Other: _____	
Sprinkler System:	
☐ Yes ☐ No	
Grading Permit Number: _____	
Building Shell Permit Number: _____	

RECEIVED

NOV 21 2016

LICENSES & PERMITS
DIVISION

THE UNDERSIGNED HEREBY CERTIFIES AND AGREES AS FOLLOWS: (1) THAT HE/SHE IS AUTHORIZED TO MAKE THIS APPLICATION; (2) THAT THE INFORMATION IS CORRECT; (3) THAT HE/SHE WILL COMPLY WITH ALL REGULATIONS OF HOWARD COUNTY WHICH ARE APPLICABLE THERETO; (4) THAT HE/SHE WILL PERFORM NO WORK ON THE ABOVE REFERENCED PROPERTY NOT SPECIFICALLY DESCRIBED IN THIS APPLICATION; (5) THAT HE/SHE GRANTS COUNTY OFFICIALS THE RIGHT TO ENTER ONTO THIS PROPERTY FOR THE PURPOSE OF INSPECTING THE WORK PERMITTED AND POSTING NOTICES.

Applicant's Signature

CHRIS @ PDRHOWA.COM
Email Address

Title/Company

Print Name

CHRIS LAMBROS
Date

Checks Payable to: DIRECTOR OF FINANCE OF HOWARD COUNTY

PLEASE WRITE NEATLY & LEGIBLY
-FOR OFFICE USE ONLY-

AGENCY	DATE	SIGNATURE OF APPROVAL
☒ State Highways		
☒ Building Officials		
PSZA (Zoning)		
PSZA (Engineering)		
Health		

Is Sediment Control approval required for issuance? ☐ Yes ☐ No
☐ CONTINGENCY CONSTRUCTION START

DPZ SETBACK INFORMATION
Front: _____
Rear: _____
Side: _____
Side St.: _____
All minimum setbacks met? ☐ Yes ☐ No
Is Entrance Permit Required? ☐ Yes ☐ No
Historic District? ☐ Yes ☐ No
Lot Coverage for New Town Zone: _____
SDP/Red-line approval date: _____

Filing Fee	\$ 135.00
Permit Fee	\$
Tech Fee	\$
Excise Tax	\$
PSFS	\$
Guaranty Fund	\$
Add'l per Fee	\$
Total Fees	\$
Sub-Total Paid	\$
Balance Due	\$
Check	# 2055

Distribution of Copies: White: Building Officials Green: PSZA, Zoning

Yellow: PSZA, Engineering

Pink: Health

Gold: SHA

DRYWELL

SEPTIC TANK

PROPOSED
ADDITION

EX. HOUSE

WELL

311.55' S 09° 25'23"E

304.00' S 09° 25'23"E

plan
not to
scale

ARCHITECT

13662



KAREN LYNN PITTSLEY
STATE OF MARYLAND



NORTH

LOT: 4
40,011 SF ±

130.00' N 80° 34'37"E

TRIADELPHIA ROAD



7612 Browns Bridge Rd
Highland, MD 20777
301-776-2666
301-776-2886 fax
1-877-828-7267
info@TransformingArchitecture.com
www.TransformingArchitecture.com

MARTIN-SIEGEL


12014 TRIADELPHIA RD, ELLICOTT CITY MD 21042

Site Plan


SCALE: 1" = 30'

DATE: 11/22/2016


PROJECT No: 16-289

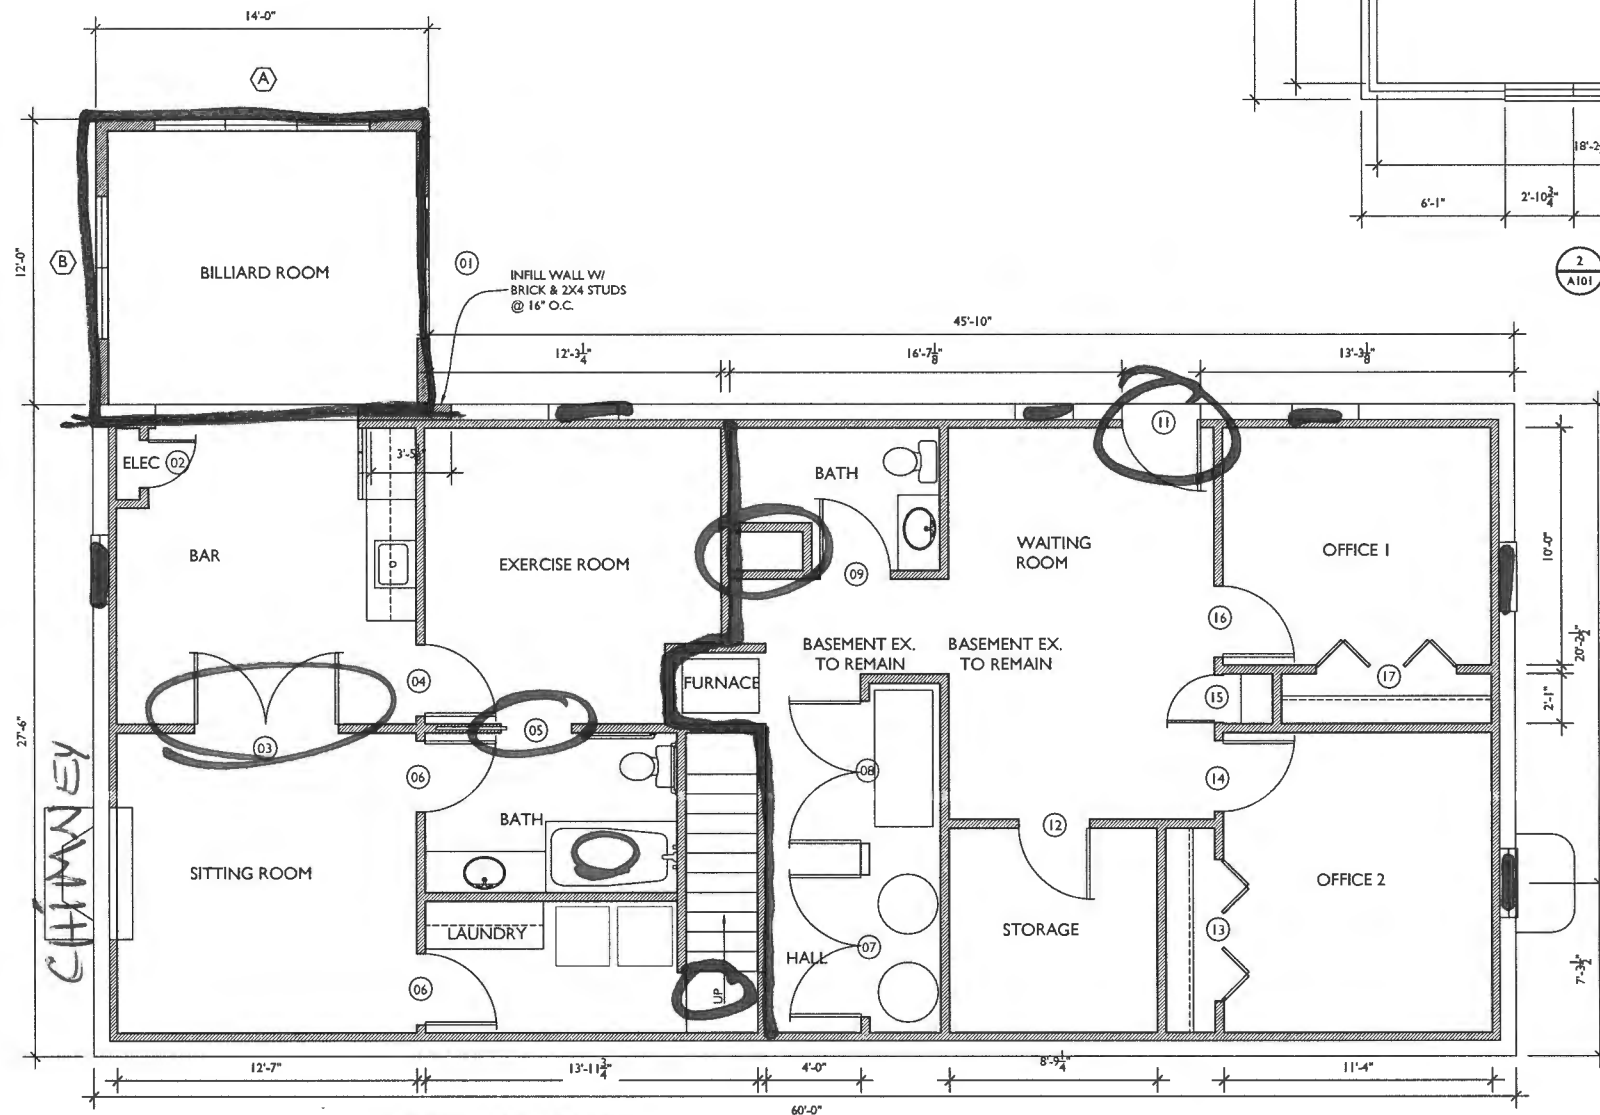


1
A101
BASEMENT PLAN
SCALE: 1/4"=1'-0"

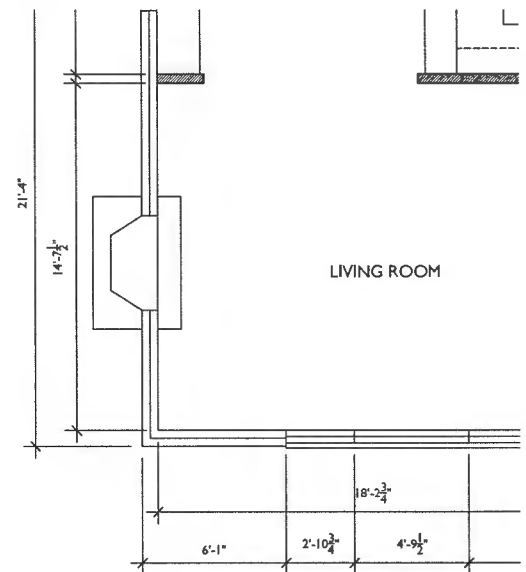

2
A101
FIRST FLOOR
SCALE: 1/4"=1'-0"

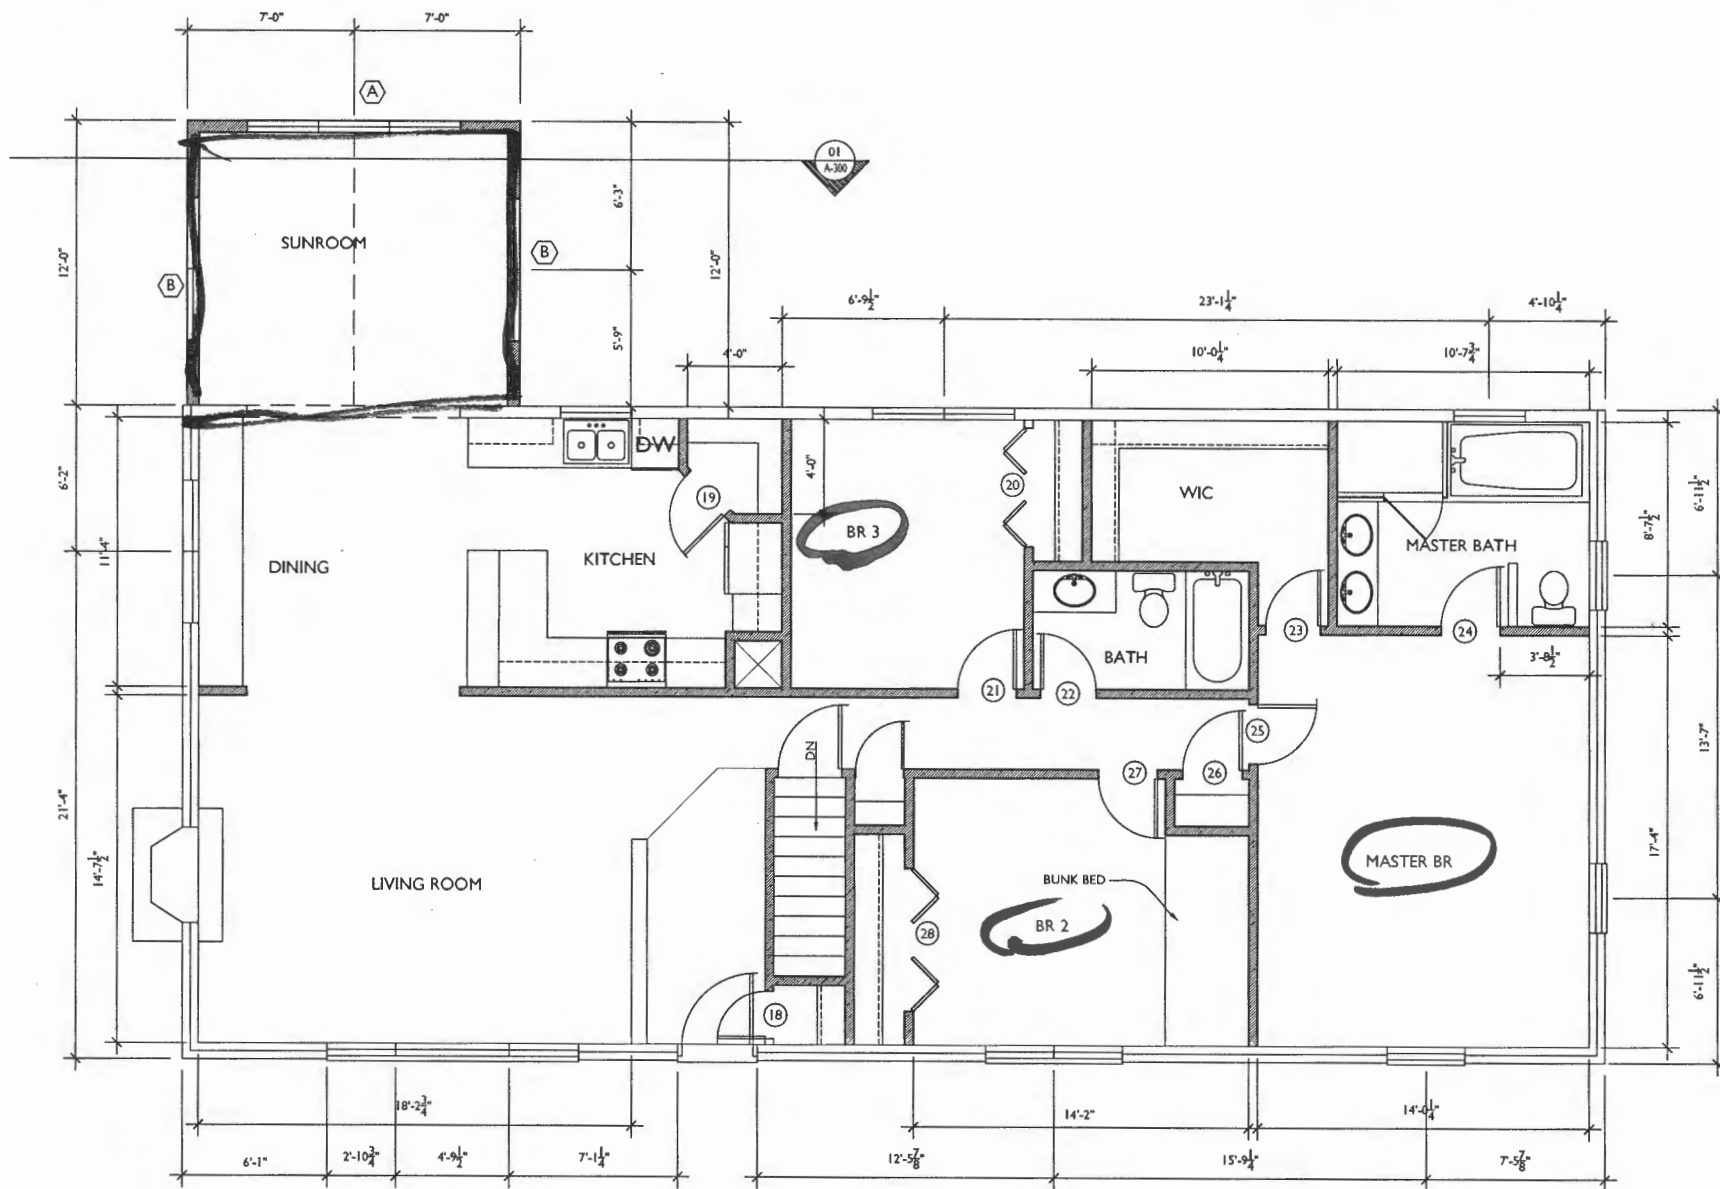

2 FIRST FLOOR PLAN
A101 SCALE: 1/4"=1'-0"

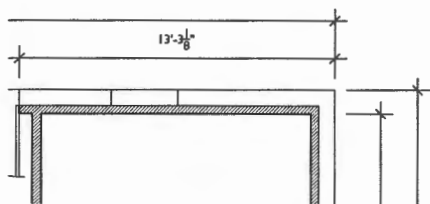

info@
www.

STAMP

I CERT
PREPAR
AM A D
LAWS C
NUMBE

NOTE:
OF TRA
SUCH, P
EITHER
WRITTE
ARCHIT

PROJEC

PROJEC

F
I
E

SYMB