



# HOWARD COUNTY HEALTH DEPARTMENT

60621

DATE  
4/26/17

A5

Received  
From

True Contractors  
Inc.

PHONE #

For

Perc / App - 12014  
Philadelphia

☐ CASH

☒ CHECK

NO.

011131

Five hundred six


Dollars

\$

500.00

Received By

J. Kemp

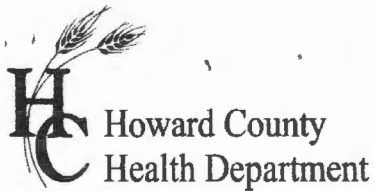

# APPLICATION

## FOR PERCOLATION TESTING AND SITE EVALUATION

TEST DATE(S) \_\_\_\_\_ TEST TIME \_\_\_\_\_

A/P 5/6/21

AGENCY REVIEW: \_\_\_\_\_

DATE 4/26/17

DO NOT WRITE ABOVE THIS LINE

I HEREBY APPLY FOR THE NECESSARY TESTING/EVALUATION PRIOR TO ISSUANCE OF SEWAGE DISPOSAL SYSTEM PERMIT(S) TO:

CHECK AS NEEDED:

- ☒ CONSTRUCT NEW SEPTIC SYSTEM(S)  
☐ REPAIR/ADD TO AN EXISTING SEPTIC SYSTEM  
☐ REPLACE AN EXISTING SEPTIC SYSTEM

CHECK AS NEEDED:

- ☐ NEW STRUCTURE(S)  
☐ ADDITION TO AN EXISTING STRUCTURE  
☒ REPLACE AN EXISTING STRUCTURE

CHECK ONE:

- ☒ CREATE NEW LOT(S)  
☐ BUILD ON AN EXISTING LOT IN A SUBDIVISION  
☐ BUILD ON AN EXISTING PARCEL OF RECORD

IS THE PROPERTY WITHIN 2500' OF ANY RESERVOIR?

- ☐ YES  
☒ NO

THE TYPE OF STRUCTURE IS:

- ☒ RESIDENTIAL WITH 10 PROPOSED BEDROOMS IN THE COMPLETED STRUCTURE (NOTE UNKNOWN IF APPROPRIATE)  
☐ COMMERCIAL (PROVIDE DETAIL OF NUMBERS AND TYPES OF EMPLOYEES/ CUSTOMERS ON ACCOMPANYING PLAN)  
☐ INSTITUTIONAL/GOVERNMENT (PROVIDE DETAIL OF NUMBERS AND TYPES OF EMPLOYEES/USERS ON ACCOMPANYING PLAN)

Note: House was destroyed in storm last year - applying for BAT grant & need septic replacement tank

PROPERTY OWNER(S) MARTIN & Toby Siegal

DAYTIME PHONE 836-520-6496 CELL \_\_\_\_\_ FAX \_\_\_\_\_

MAILING ADDRESS 12014 Triadelphia Rd Ellicott City MD 21042  
STREET CITY/TOWN STATE ZIP

APPLICANT Freedom Septic, Inc. - Ben True

DAYTIME PHONE 410-795-2947 CELL 410-984-6863 FAX 410-549-1163

MAILING ADDRESS 2809 Liberty Rd Sykesville MD 21784  
STREET CITY/TOWN STATE ZIP

APPLICANT'S ROLE: DEVELOPER BUILDER BUYER RELATIVE/FRIEND REALTOR CONSULTANT

PROPERTY LOCATION

SUBDIVISION/PROPERTY NAME Green Henge LOT NO. 4

PROPERTY ADDRESS 12014 Triadelphia Rd Ellicott City  
STREET TOWN/POST OFFICE

TAX MAP PAGE(S) 16 GRID 19 PARCEL(S) 240 PROPOSED LOT SIZE 39,988 SF


AS APPLICANT, I UNDERSTAND THE FOLLOWING: THE SYSTEM INSTALLED SUBSEQUENT TO THIS APPLICATION IS ACCEPTABLE ONLY UNTIL PUBLIC SEWERAGE IS AVAILABLE. THIS APPLICATION IS COMPLETE WHEN ALL APPLICABLE FEES AND A SUITABLE SITE PLAN HAVE BEEN RECEIVED. I ACCEPT THE RESPONSIBILITY FOR COMPLIANCE WITH ALL M.O.S.H.A. AND "MISS UTILITY" REQUIREMENTS. APPROVAL IS BASED UPON SATISFACTORY REVIEW OF A PERC CERTIFICATION PLAN.

TEST RESULTS WILL BE MAILED TO APPLICANT.

Ben True, Owner for Freedom Septic  
SIGNATURE OF APPLICANT

HOWARD COUNTY HEALTH DEPARTMENT, BUREAU OF ENVIRONMENTAL HEALTH, WELL AND SEPTIC PROGRAM  
7178 COLUMBIA GATEWAY DRIVE COLUMBIA, MARYLAND 21046 (410) 313-2640 FAX (410) 313-2648  
TDD (410) 313-2323 TOLL FREE 1-877-4MD-DHMH

A/P \_\_\_\_\_

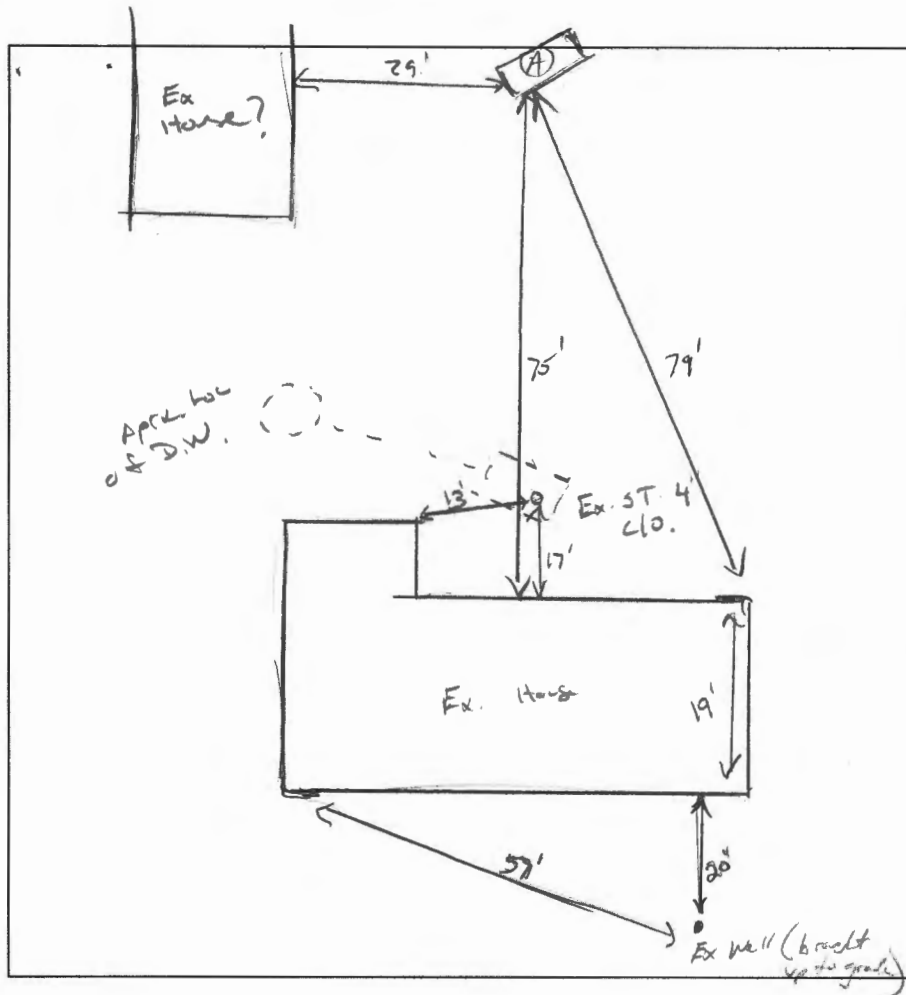

10" F/I  
11 BR L,  
WK SOK,  
10% rd., roots dry

2' 11 BR / Y SL,  
WK SOK  
10% rd., N/A

5' 11 BR / Y SL,  
15% rd., WK SOK  
10% rd., N/A

6' 11 BR / Y, WK PL  
15% rd.

13' Water seep  
0: Y/R SL  
couse,

16'

DATE	TEST #	DEPTH	START	BREAK 1" DROP	STOP 2" DROP	TIME OF 2ND INCH	P/F/H
5-18-17	A	6' 16"	00:33	00:35	00:38	3	P

REMARKS \_\_\_\_\_

SANITARIAN K. Wolf BACKHOE Dan OTHERS \_\_\_\_\_TEST HOLES USED IN SDA 1 AVG. PERC TIME 3 SQ. FT/BR 1.2TRENCH WIDTH 2 INLET DEPTH 3 MAX. BOT DEPTH 9 EFFECTIVE S/W 5-9 (36)

$$6BR \text{ Design} = \frac{900 \text{ gal}}{1.2} = 750 \div 2 = 375 (.36) = 135 \text{ LF}$$

**Davis, Michael J**

---

**From:** Kerry Toby Martin <tsklm@yahoo.com>  
**Sent:** Monday, December 19, 2016 1:43 PM  
**To:** Davis, Michael J; Bricker, Robert  
**Subject:** Waiver

To Whom It May Concern:

Our family is requesting a waiver from the PERC Certification plan due to extenuating, unforeseen circumstances that our family has dealt with related to damages to our home on 12014 Triadelphia Road, Ellicott City, MD 21042. The first incident occurred in March 2016 where we experienced water damage due to the well line. Because of improper handling of the claim and the cross contamination of mold from a water mitigation company, we resided in a hotel for two months while battling our insurance company for assistance. After the incident was resolved and the house remediated, we returned to our residence for repairs. The house was destroyed three weeks later from wind and tree damage as a result of the tornado on June 20, 2016.

There have been several delays contributing to the reconstruction of our home including an inaccurate plat with information missing, issues with the well, misunderstanding with the contractor, and so on. Our family of seven, plus a dog, has a limited amount of time until our insurance company will not pay for our temporary home and we are stretched to the capacity with our resources.

We would like to request the waiver in order to expedite the completion of our home to avoid the possibility of having no shelter in the near future. Thank you.

If you need any additional information, please contact me @410-905-5228 or you may contact my father, Martin Siegel, @ 443-535-2387.

Thank you again,

Toby Siegel  
Triadelphia Road, 21042

Sent from my iPhone

12/19/16  
Approved  
Michael J Davis