

ASSOCIATED EXCAVATORS CONTRACTORS, LLC
16657 FREDERICK ROAD
MT. AIRY, MD 21771
(410) 442-1886 FAX (410) 442-0100

October 3, 2011

Howard County Health Department
C/o Robert Brickford
7178 Columbia Gateway Drive
Columbia, MD 21045


Dear Mr. Brickford:

This letter is to inform you that my company performed the abandonment of a well & septic located at 4109 College Ave Ellicott City, Md.


Please note drawing to follow.

If you have any questions please call me at (410) 977.2216.

Thank you,



Mike Johnson

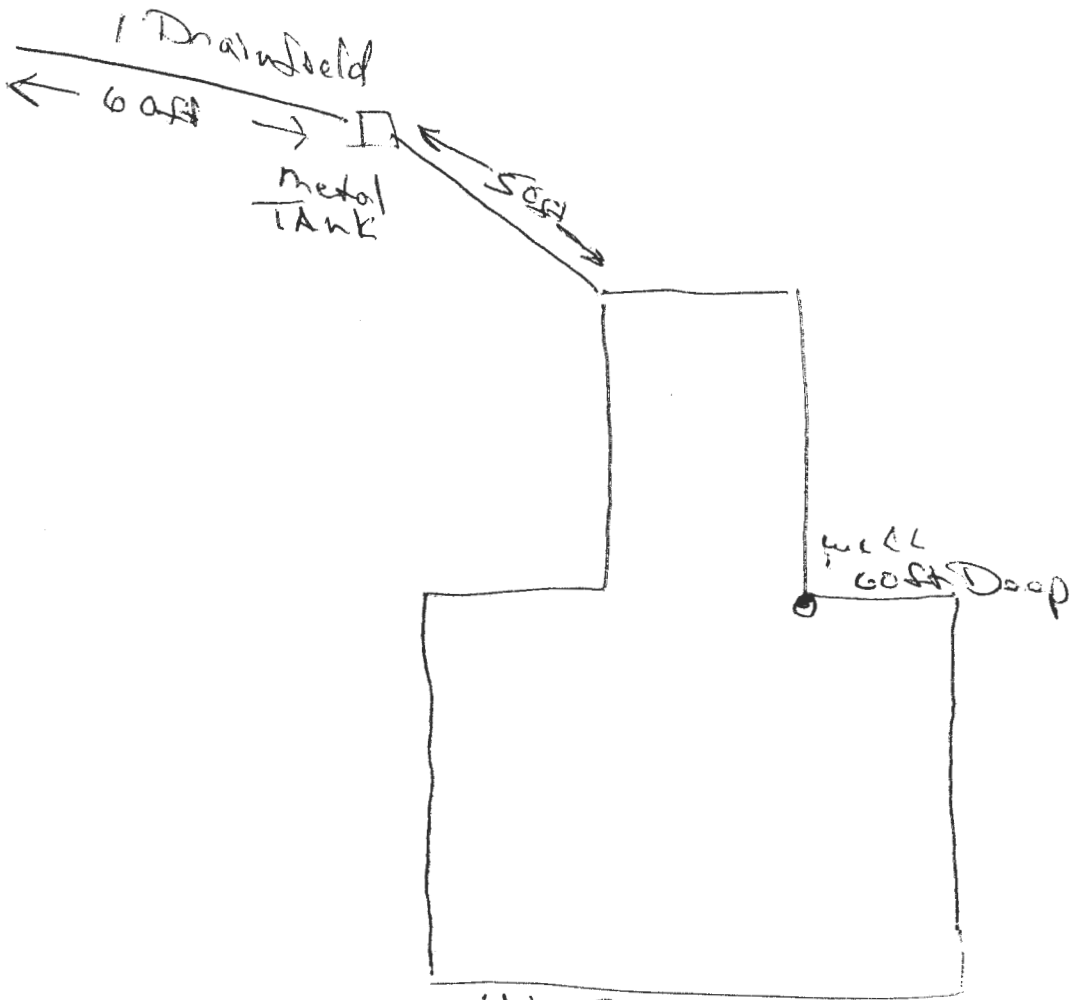

4109
Collage
Ave