

C 1 **2278** SEQUENCE NO. (DWR USE ONLY)
 2 3 (SEQ. NO.) 6
 THIS NUMBER IS TO BE PUNCHED IN COLS. 3-6 ON ALL CARDS

STATE OF MARYLAND
 DEPARTMENT OF WATER RESOURCES
 STATE OFFICE BLDG., ANNAPOLIS, MARYLAND 21401
WELL COMPLETION REPORT

THIS REPORT MUST BE SUBMITTED WITHIN 30 DAYS AFTER COMPLETION OF THE WELL
 FILL IN THIS FORM COMPLETELY

DATE WELL COMPLETED **7-18-70** DEPTH OF WELL **125** (TO NEAREST FOOT)
 PERMIT NO. FROM PERMIT TO DRILL WELL **40-71-0005**
 DRILLERS IDENTIFICATION NO. **122**

OWNER **Fisher, Jack** FIRST NAME
 STREET OR RFD **Willcrest Rd.** POST OFFICE **Hanover, Md. 21076**

WELL LOG STATE THE KIND OF FORMATIONS PENETRATED, THEIR COLOR, DEPTH, THICKNESS AND IF WATER BEARING	FEET		CHECK IF WATER BEARING
	FROM	TO	
Overburden	0	8	
Brown shale	8	37	
gray rock	37	125	

WELL DESCRIPTION

GROUTING RECORD
 WELL HAS BEEN GROUTED (CIRCLE APPROPRIATE BOX) Y N
 NO. 46

DEPTH OF GROUT SEAL TO NEAREST FOOT!
 FROM **0** FT. TO **40** FT.
 (ENTER 0 IF FROM SURFACE)

CASING RECORD

CASING TYPES (INSERT APPROPRIATE CODE BELOW)

<input type="checkbox"/> S	<input type="checkbox"/> T	<input type="checkbox"/> C	<input type="checkbox"/> O
STEEL	CONCRETE		
<input type="checkbox"/> P	<input type="checkbox"/> L	<input type="checkbox"/> O	<input type="checkbox"/> T
PLASTIC	OTHER		

MAIN CASING TYPE S T
 NOMINAL DIAMETER TOP (MAIN) CASING (NEAREST INCH) **6**
 TOTAL DEPTH OF MAIN CASING (NEAREST FOOT) **40**

OTHER CASING (IF USED)

EACH CASING	DIAMETER (INCH)	DEPTH (FEET) FROM	TO

SCREEN RECORD

SCREEN TYPE OR OPEN HOLE (INSERT APPROPRIATE CODE BELOW)

<input type="checkbox"/> S	<input type="checkbox"/> T	<input type="checkbox"/> B	<input type="checkbox"/> R	<input type="checkbox"/> H	<input type="checkbox"/> O
STEEL	BRASS OR BRONZE	OPEN HOLE			
<input type="checkbox"/> P	<input type="checkbox"/> L	<input type="checkbox"/> O	<input type="checkbox"/> T		
PLASTIC	OTHER				

PUMPING TEST

HOURS PUMPED (TO NEAREST HOUR) **4**

PUMPING RATE (GALLONS PER MINUTE TO NEAREST GALLON) **5**

METHOD USED TO MEASURE PUMPING RATE **air**

WATER LEVEL (DISTANCE FROM LAND SURFACE) BEFORE PUMPING **25** (NEAREST FOOT)
 WHEN PUMPING **115** (NEAREST FOOT)

TYPE OF PUMP USED (CIRCLE APPROPRIATE BOX)

<input type="checkbox"/> A	<input type="checkbox"/> P	<input type="checkbox"/> T
AIR	PISTON	TURBINE
<input type="checkbox"/> C	<input type="checkbox"/> R	<input type="checkbox"/> O
CENTRIFUGAL	ROTARY	OTHER (DESCRIBE BELOW)
<input type="checkbox"/> J	<input type="checkbox"/> S	
JET	SUBMERSIBLE	

PUMP INSTALLED

TYPE OF PUMP (WRITE APPROPRIATE LETTER IN BOX - SEE ABOVE: A, C, J, P, R, S, T, O)

29

CAPACITY: GALLONS PER MINUTE TO NEAREST GALLON **31** - **35**

PUMP HORSE POWER **37** - **41**


PUMP COLUMN LENGTH (NEAREST FOOT) **43** - **47**

CASING HEIGHT (CIRCLE APPROPRIATE BOX AND ENTER CASING HEIGHT)

ABOVE } LAND SURFACE (NEAREST FOOT)
 BELOW }

LOCATION OF WELL ON LOT

SHOW PERMANENT STRUCTURE SUCH AS BUILDINGS, SEPTIC TANKS, AND/OR OTHER LAND MARKS AND INDICATE NOT LESS THAN TWO DISTANCES (MEASUREMENTS TO WELL).

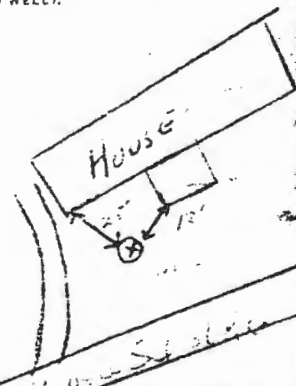

CIRCLE APPROPRIATE BOXES

A WELL WAS ABANDONED AND SEALED WHEN THIS WELL WAS COMPLETED

E ELECTRIC LOG OBTAINED

C COPY OF ELECTRIC LOG ATTACHED

I HEREBY CERTIFY THAT I HAVE COMPLIED WITH ALL CONDITIONS STATED ON THE ABOVE-CAPTIONED "PERMIT TO DRILL WELL", AND THAT INFORMATION CONTAINED IN THIS REPORT IS TRUE, ACCURATE, AND COMPLETE TO THE BEST OF MY KNOWLEDGE, INFORMATION AND BELIEF.

WELLDRO NAME
 G. Edgar Hart Sons Corp.
 SIGNATURE *G. Edgar Hart*

DEPTH (NEAREST WHOLE FOOT)

EACH SCREEN	FROM	TO
1	40	125
2		
3		
4		

IF WELL DRILLED WAS A FLOWING WELL, CIRCLE BOX **68** F

TELESCOPE CASING 73
 LOG INDICATOR 72

OTHER DATA AVAILABLE 74 75 76

FILE INQUIRY FORM

Property Address: 7000 Woodscape Dr
Thistle down Lot 1

Proposed house replacement
new ~~perc~~ perc req'd w/plan
yield test for BP

MUR 4/13/04

Obtained from signed record
 plat filed in record
 plat drawer. (FA)
 3/5/04

