

RECORDED

APPLICATION

A 11340

P _____

SEWAGE DISPOSAL TESTING

MARYLAND STATE DEPARTMENT OF HEALTH

HOWARD COUNTY

ELLICOTT CITY

DISTRICT 5

DATE 12/13/65

*275 gal. septa Tank.
Dry well 12 ft in dia by 9 ft deep
below the inlet located 9.3 ft from the
front property line and 110 ft off the right
side property line as shown with facing the
lot from Rt. 32.*

TO: THE COUNTY HEALTH OFFICER
ELLICOTT CITY, MARYLAND

I, HEREBY, APPLY FOR THE NECESSARY TESTS IN ORDER TO CONSTRUCT (OR RECONSTRUCT) A SEWAGE DISPOSAL SYSTEM.

PROPERTY OWNER Maurice Jager & Wife

ADDRESS Clarksville, Maryland PHONE AT 6-3394

PROPERTY LOCATION:

SUBDIVISION _____ LOT NO. _____

ROAD AND DESCRIPTION Rt. 32 - less than 1/4 mile East of Hall Shop Rd. going
towards Clarksville Ridge on right side going
East

OCCUPANT _____ PHONE _____

PERSON TO CONSTRUCT SYSTEM _____

ADDRESS _____ PHONE _____

SIZE OF LOT 57.196 acres TYPE BLDG. _____ NUMBER OF BEDROOMS 3

IF NOT SINGLE RESIDENCE DESCRIBE _____

SIGNATURE OF APPLICANT Maurice Jager


APPROVED BY [Signature] FOR Dry Well DATE 12-16-65
(KIND OF SYSTEM)

REJECTED BY _____ FOR _____ DATE _____
(KIND OF SYSTEM)

HOLD PENDING FURTHER TESTS _____ DATE _____

REASONS FOR REJECTION OR HOLDING _____



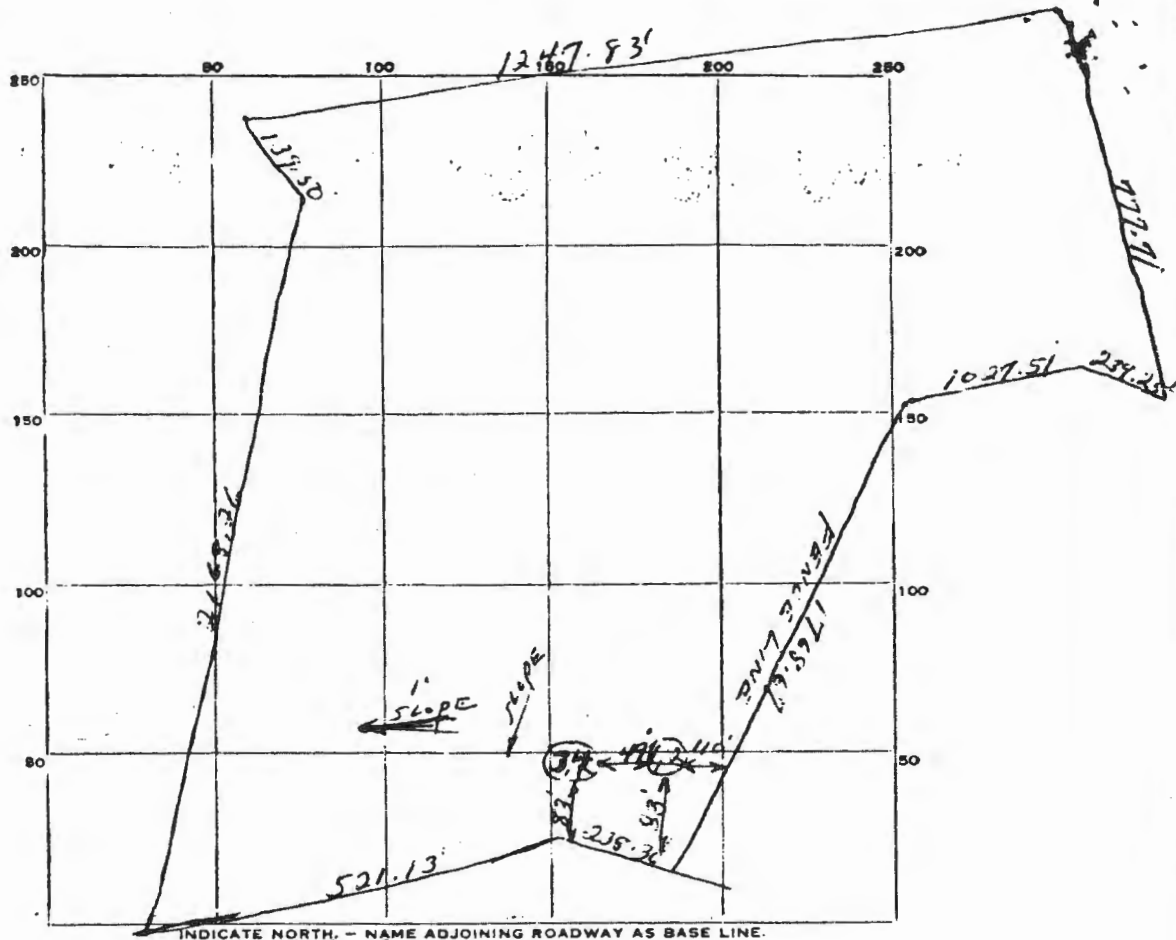









THIS IS NOT A PERMIT




DATE	TEST NO.	DEPTH	PRE-WET		TEST - 1" DROP		TIME
			START	STOP	START	STOP	
12-16-65	1 Same	9	9:58	10:00	10:00	10:03	3m
	2 Pit	4	10:05	10:07	10:07	10:09	2m
	3 Same	9 1/2	10:11	10:16	10:16	10:24	8m
	4 Pit	5	10:27	10:49	10:49	11:15	26m

4
4139
36
3/4

SOIL AUGER FINDING _____
 TESTED BY J.H.
 REMARKS 12-16-65 _____

- Help Me 
- Map Reset 
- Zoom Fit 
- Find Location 
- Remove Pin 
- Layer Control 
- Image Control 
- Theme Map 
- Local Print 
- Print Layout 
- Email Map 
- Map Exit 

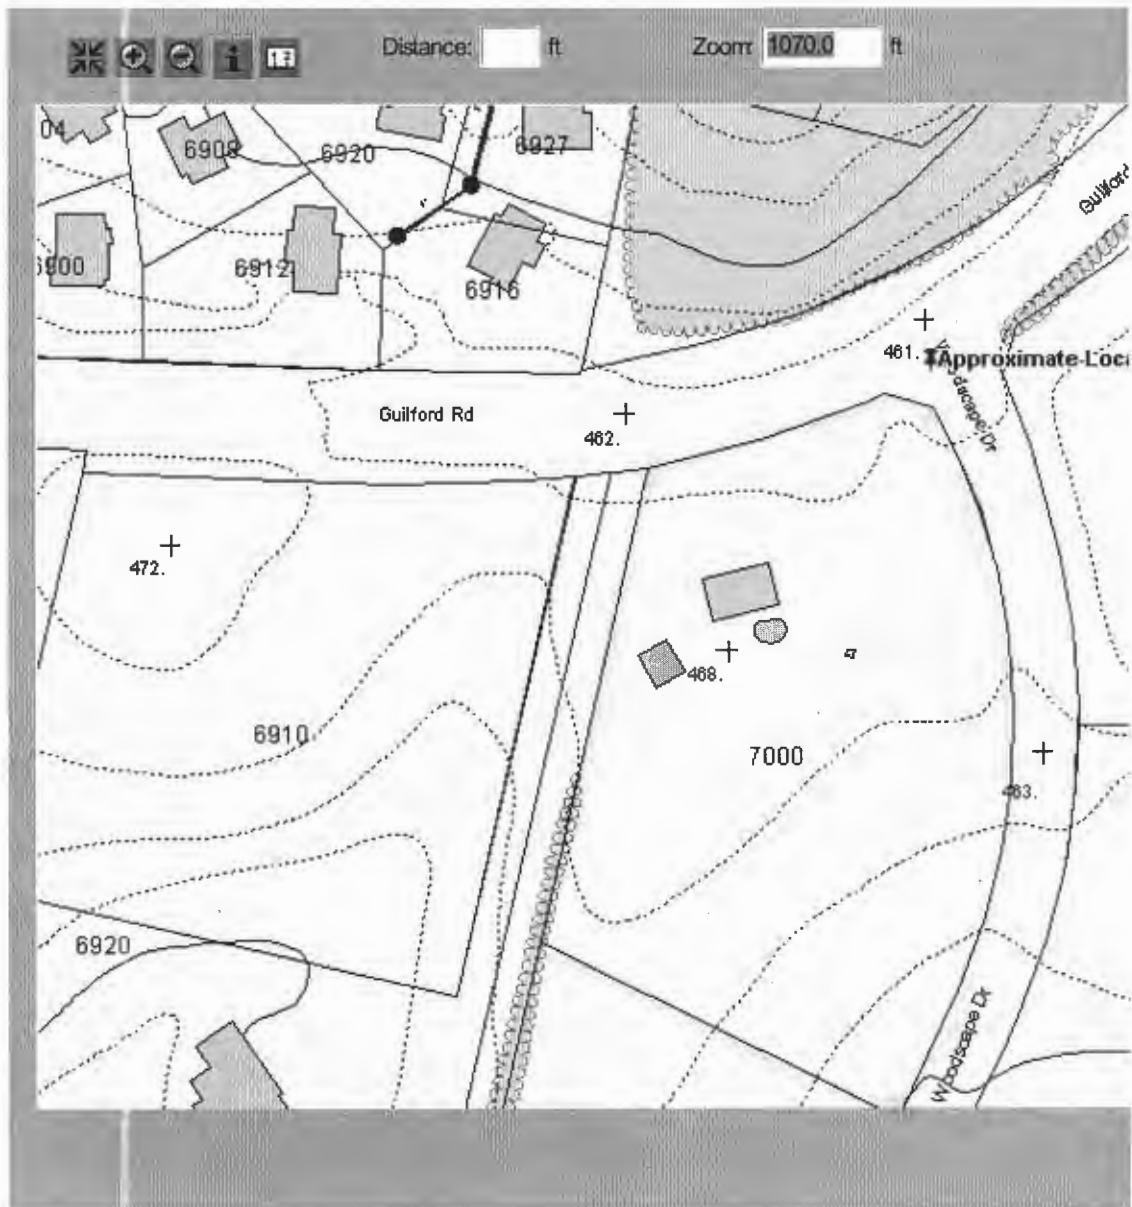

Disclaimer: Howard County, Maryland assumes no responsibility for the accuracy of this map or the information derived therefrom. The buyer and/or user assumes all risks and liabilities whatsoever resulting from or arising There are no oral agreements or warranties relating to this sale and/or use of this map.
Friday, March 05 2004 | 11:43:36 AM | @738

Contacts: John Bussiere (x3044) Virginia Peterman (x3659) Yut Phasukyued (x3093) Robert Slivinsky (x3094)