

HOWARD COUNTY HEALTH DEPARTMENT


THE PARTY OF THE P	5/11 /10 ps	
Received 140	Afields Egripment PHONE #	
CASH CHECK	For Septic permet - Walnut Johne Lot 42 12407 Walkers Bridge Los	-
2855	three hundred writy sig-	Dollars
\$ 396	Received By LLOMANT	

LAYOUT		-			
INSP 1 5/13	2010	INSP 3 INSP 5	The American		
INSP 2		INSP 5	- TENRYOU		
			,		
ISSUE DATE:	5/11/2	010	PERMIT	P 533739	
APPROVAL DATE:		SHAR	ED SEPTIC SYSTEM	A	
DATE.	8/17	12010			
	9/11		Tax ID # 5449030 ER LINE CONNECTION	,	
		HOWARD COUN	TY HEALTH DEPARTMENT		
HATFIELD	5 EQU		IS PERMITTED TO INST	ALL 🛛 ALTER 🗌	
ADDRESS:			PHONE NUMBER:		
SUBDIVISION	Walnut	Grove	LOT NUMBER:	42	
ADDRESS:	12407 Wa	tkins Bridge Lane	PROPERTY OWNER: Col	umbia Builders Inc.	
NUMBER OF B	BEDROOM	S:	4		
HOUSE SER	RVED BY	PUBLIC WATER	R? NO		
LOCATION:	Install 4	" house sewer line conne	ection per the approved site plan.		
NOTES:	This permit is limited to the installation of the individual house sewer line connection and installation of the grinder pump, if applicable. The Howard County Bureau of Utilities must be contacted for scheduling of inspection of these items as well, at 410-313-4900.				
PLANS APPRO	VED:	Dana Bernard		DATE: 3/10/10	

PERMIT VOID AFTER 2 YEARS

- 1. CONTRACTOR IS RESPONSIBLE FOR SCHEDULING A PRE-CONSTRUCTION INSPECTION FOR ALL INSTALLATIONS.
- 2. ALL PARTS OF SEPTIC SYSTEM SHALL BE 100 FEET FROM ANY WATER WELL UNLESS SPECIFICALLY AUTHORIZED.
- 3. MANHOLE RISERS REQUIRED ON ALL SEPTIC TANKS AND PUMP CHAMBERS UNLESS SPECIFICALLY AUTHORIZED.
- 4. CONTRACTOR RESPONSIBLE FOR COMPLIANCE WITH APPLICABLE REGULATIONS, GUIDELINES AND THE TERMS OF THIS PERMIT.
- 5. NEITHER THE HOWARD COUNTY COUNCIL NOR THE HEALTH DEPARTMENT IS RESPONSIBLE FOR THE SUCCESSFUL OPERATION OF ANY SYSTEM.
- 6. PERMITTEE RESPONSIBLE FOR OBTAINING FINAL APPROVAL ON THIS PERMIT.

CALL 410-313-1771 FOR INSPECTION HOUSE CONNECTION

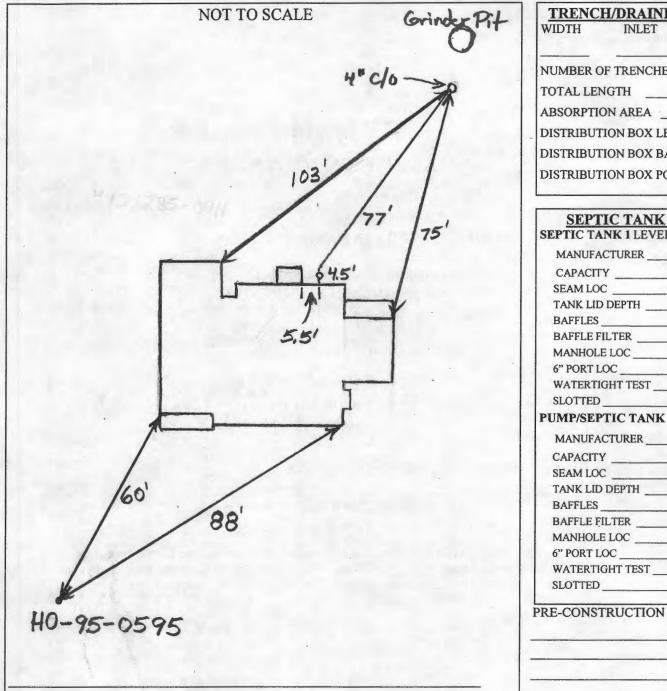

WIDTH	H/DRAINFIELD DA INLET BOTTO	OM
NUMBER (OF TRENCHES	
TOTAL LE	NGTH	-
ABSORPTI	ON AREA	
DISTRIBU"	TION BOX LEVEL	
	TION BOX BAFFLE	
	TION BOX PORT	
CAPACIT SEAM LO		
	D DEPTH	
BAFFLE	FILTER	
MANHOL	E LOC	
6" PORT I	LOC	
	IGHT TEST	
)	
	PTIC TANK LEVEL	
MANUFA	ACTURER	
	Υ (
SEAM LO	C	
TANK LII	DEPTH	
BAFFLES		
BAFFLE I	TILTER	

6" PORT LOC_ WATERTIGHT TEST SLOTTED __

. DATE OF APPROVAL 6/17/20/0

INSTALLATION: 5/13/2010 Cm	mosting and bound on the state of
pump. BB)	nection made from house to guinder
8/17/2010 System ino	peted and approved by utilities. BB
FINAL INSPECTOR B. Bake	DATE OF APPROVAL 8/17/20/0