

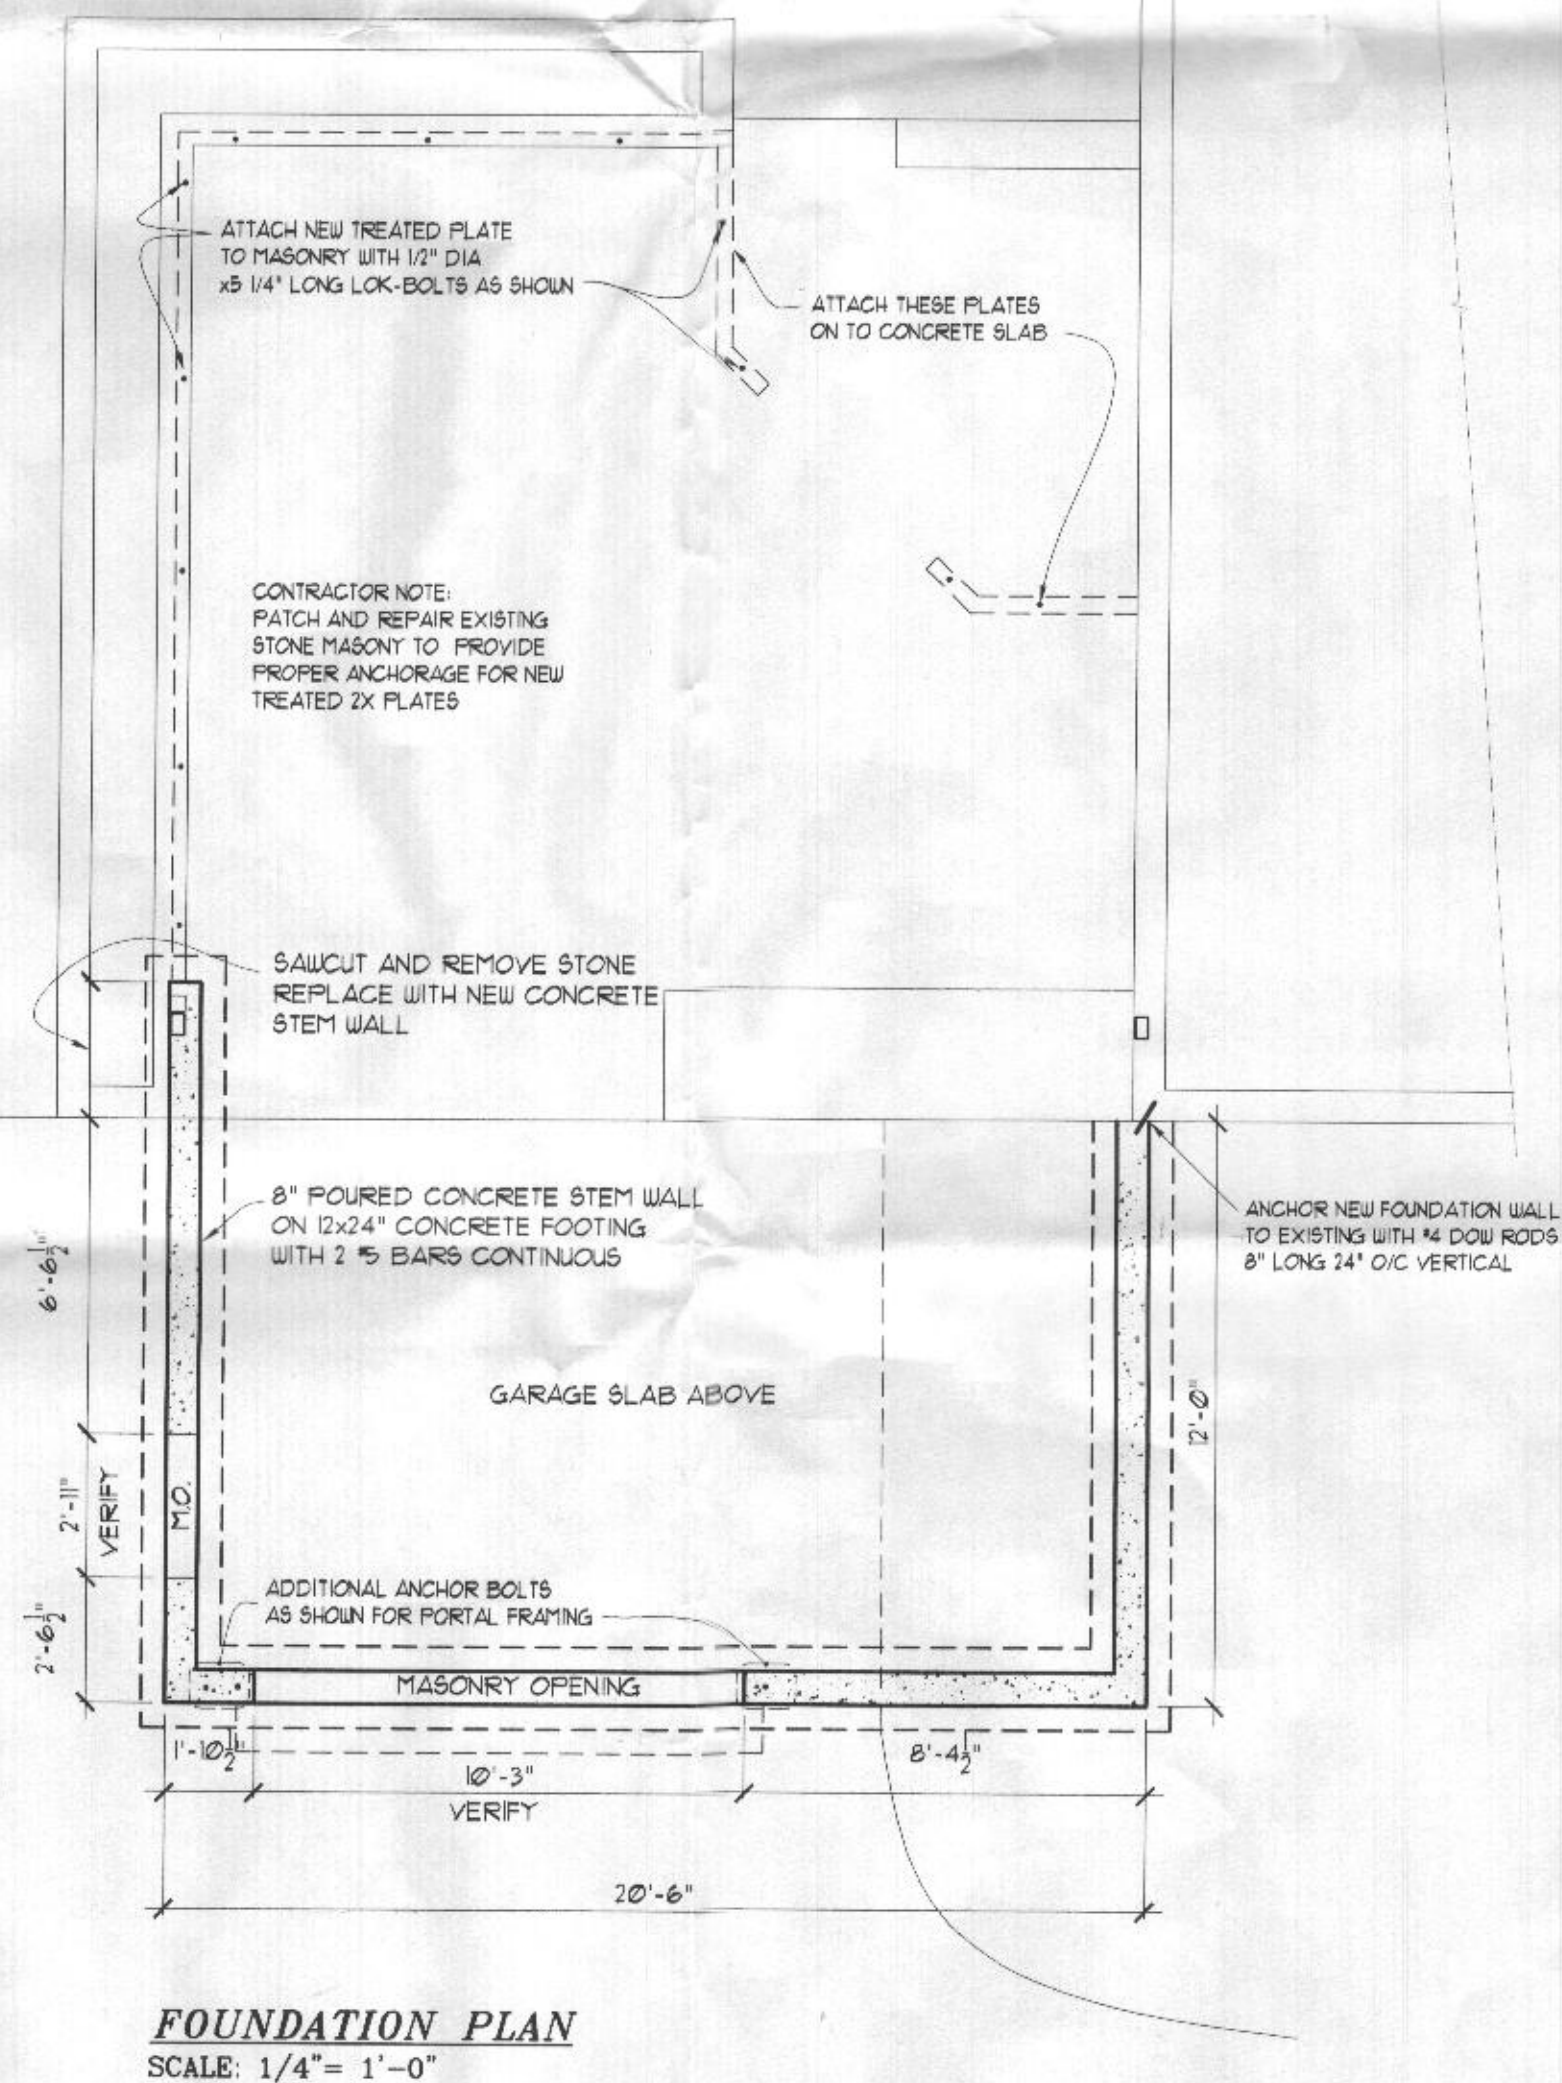
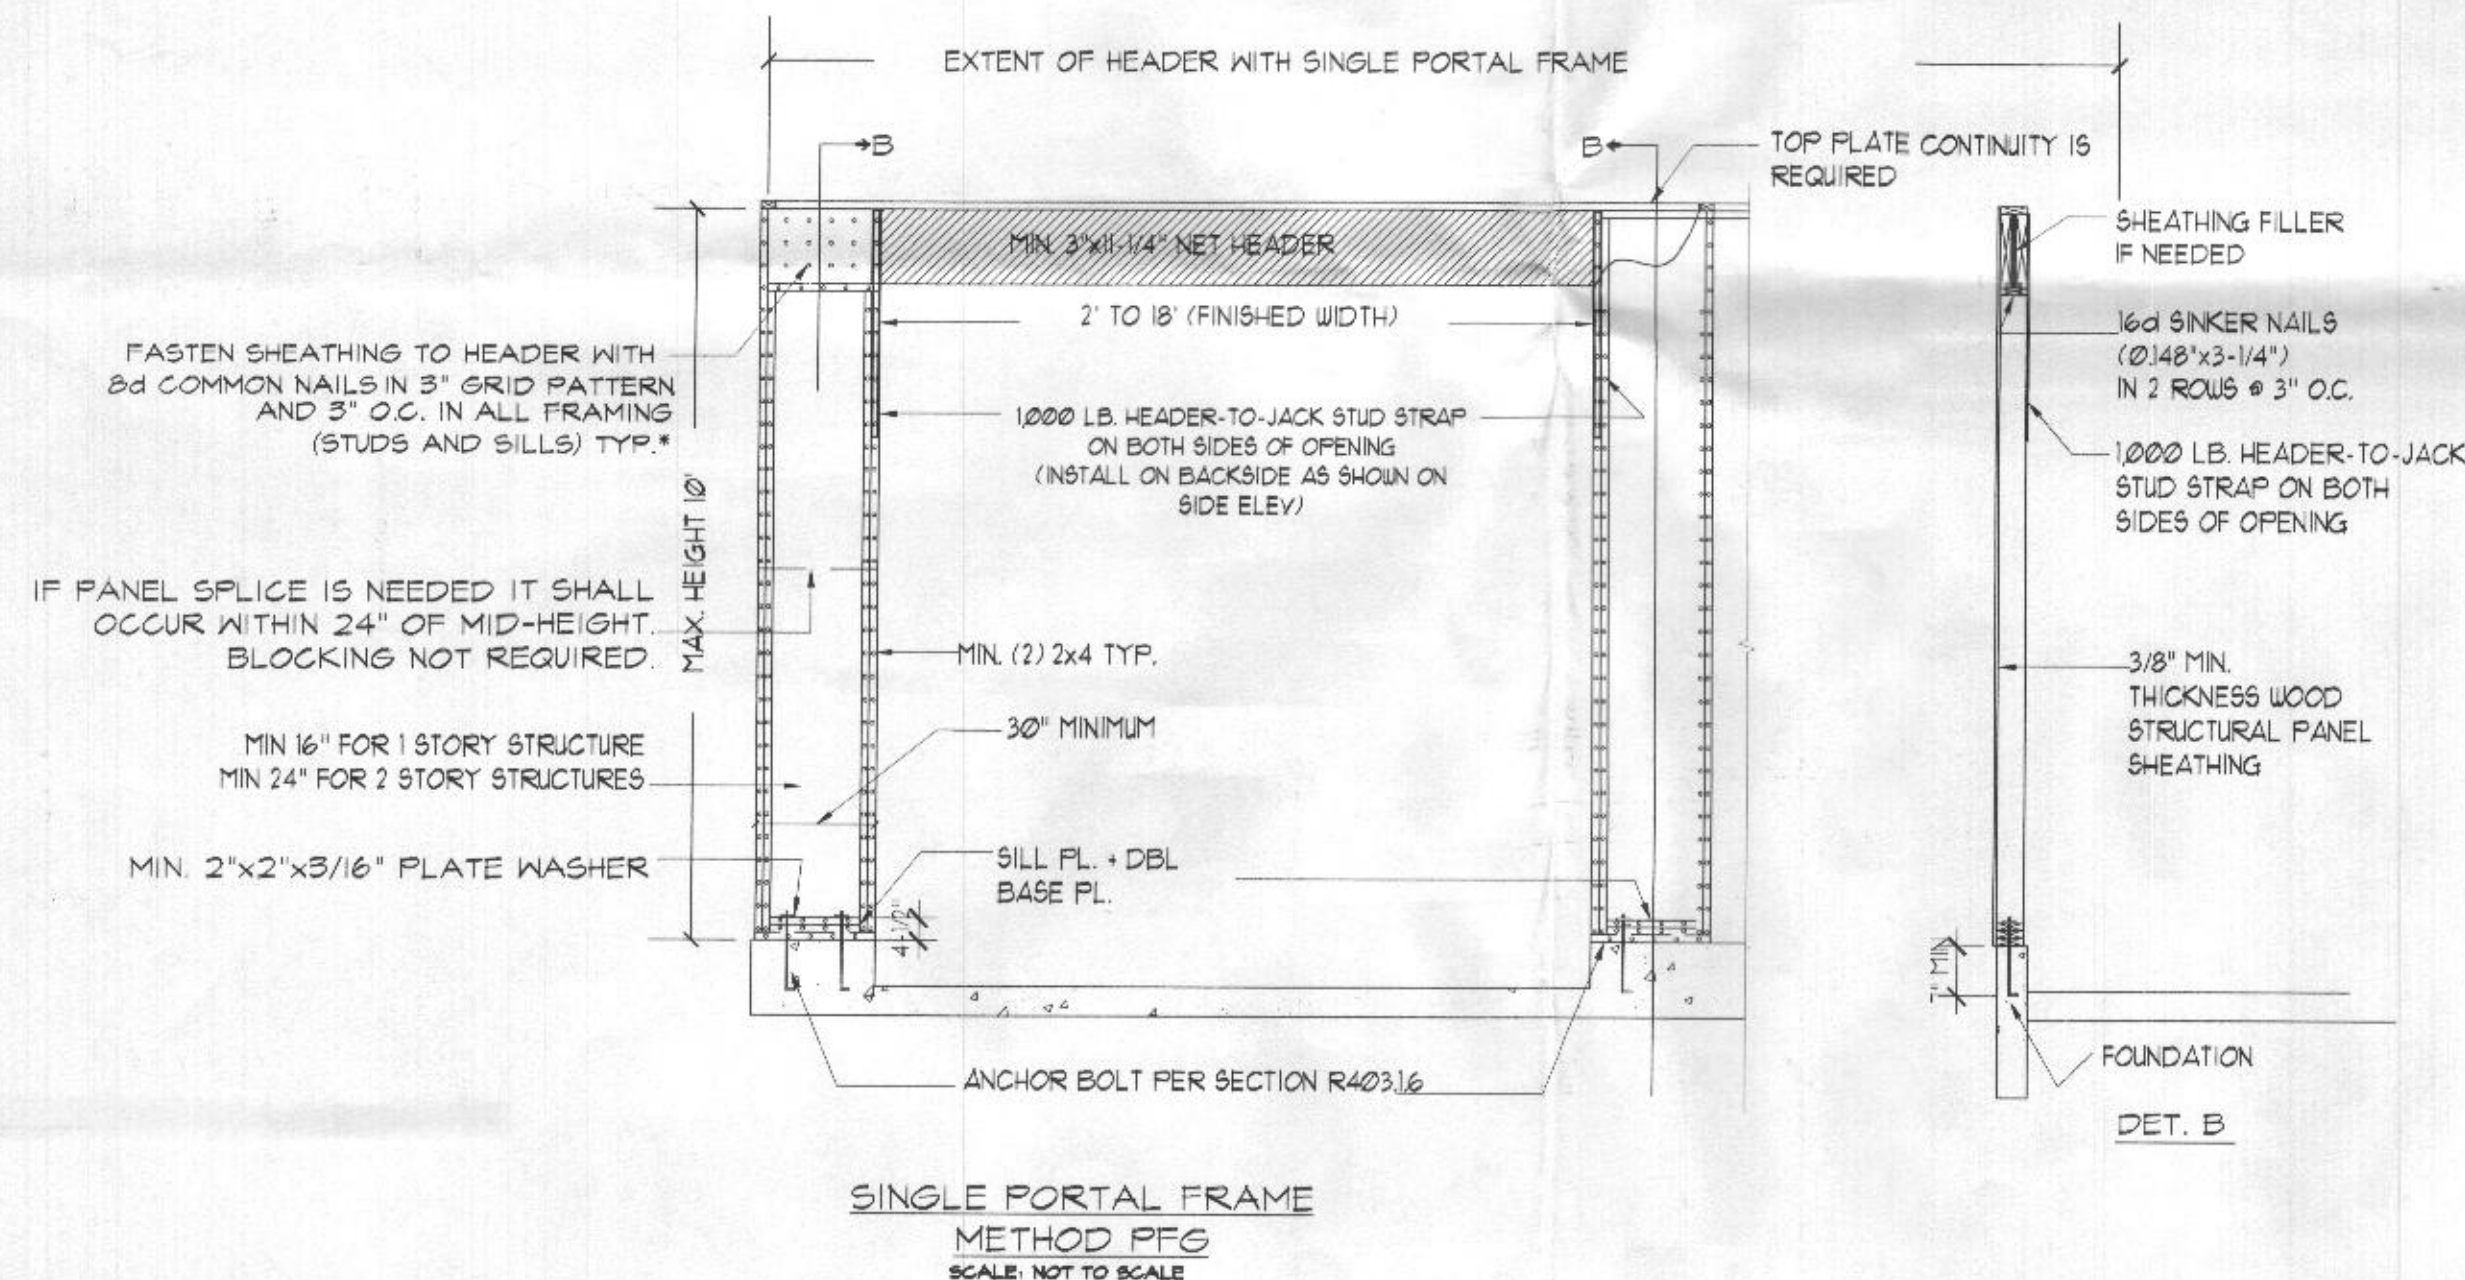
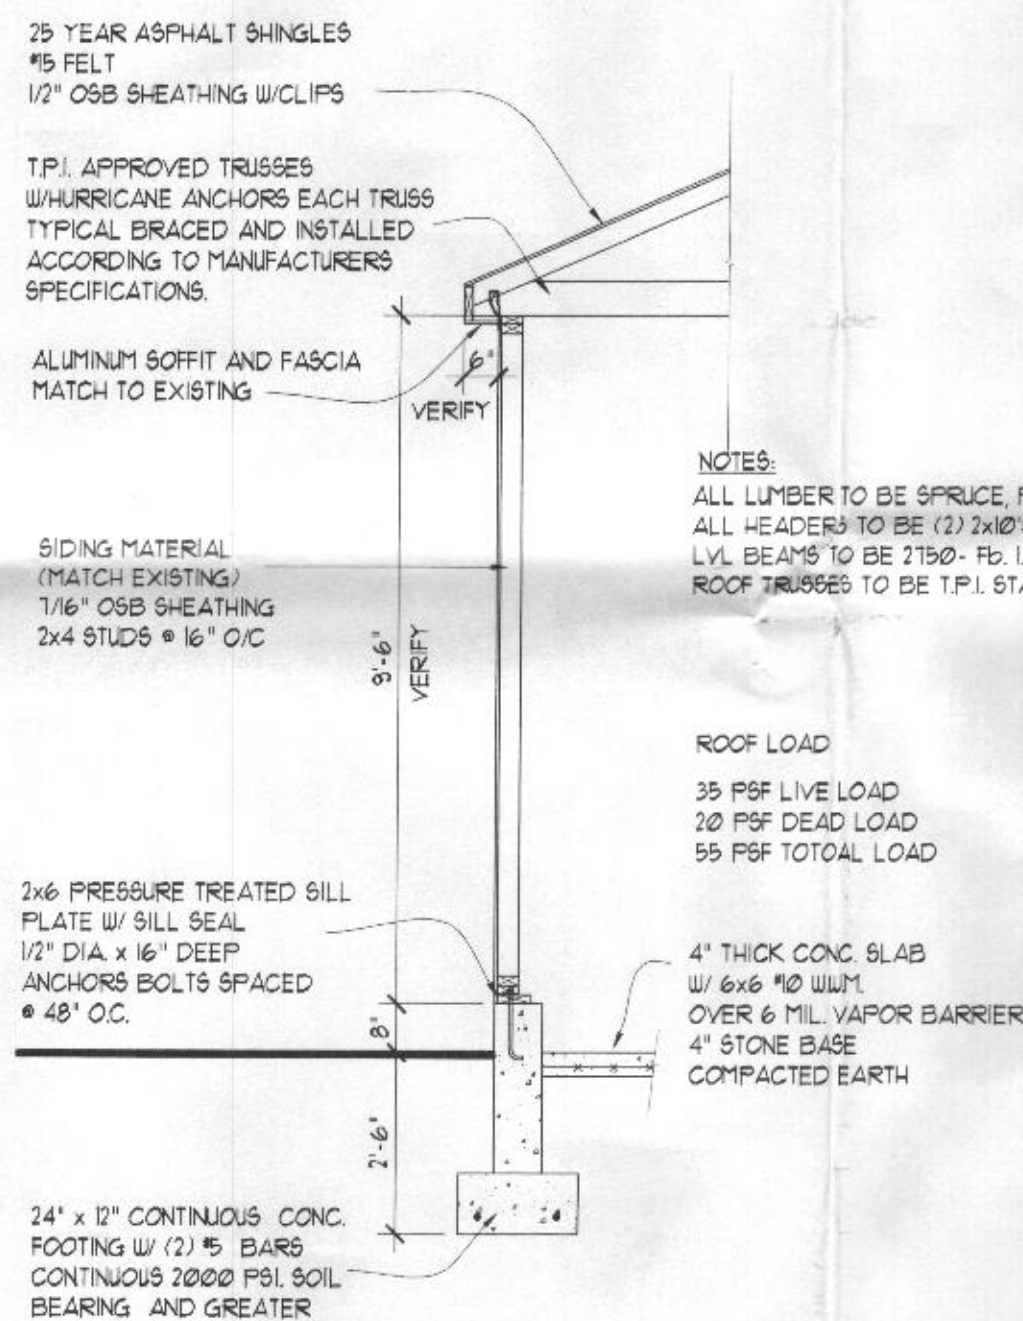
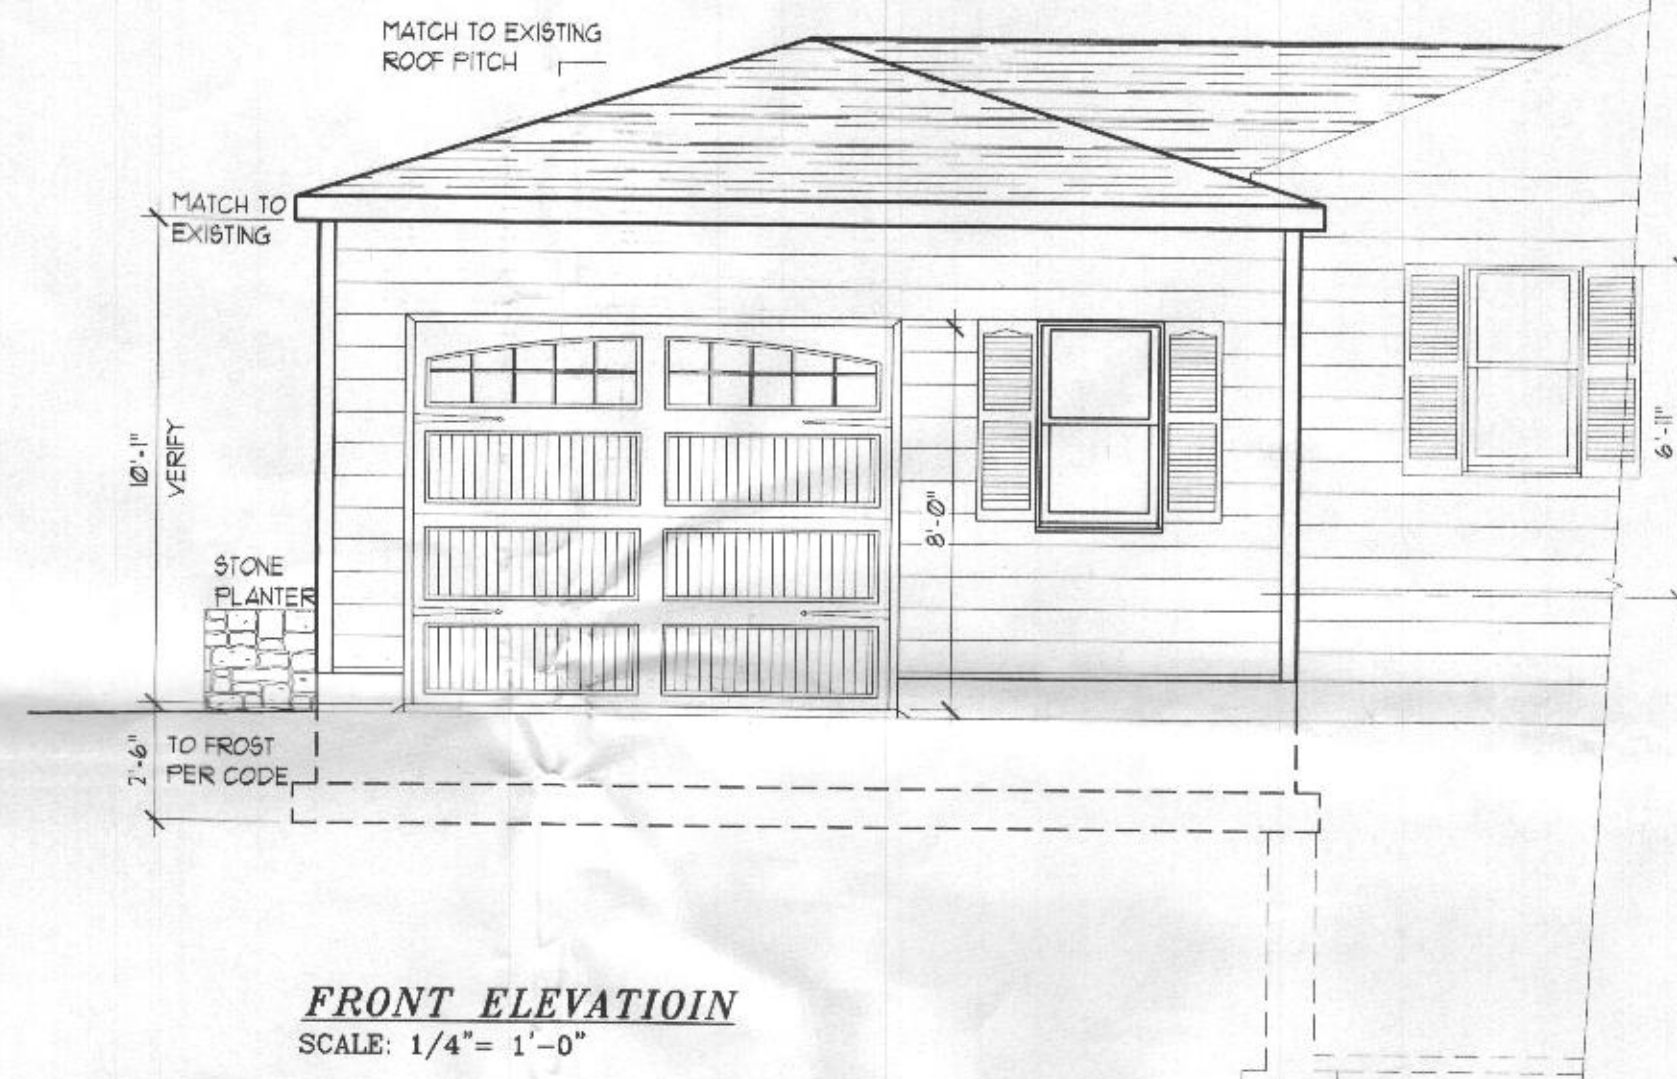


FILE INQUIRY NOTES





[illegible]

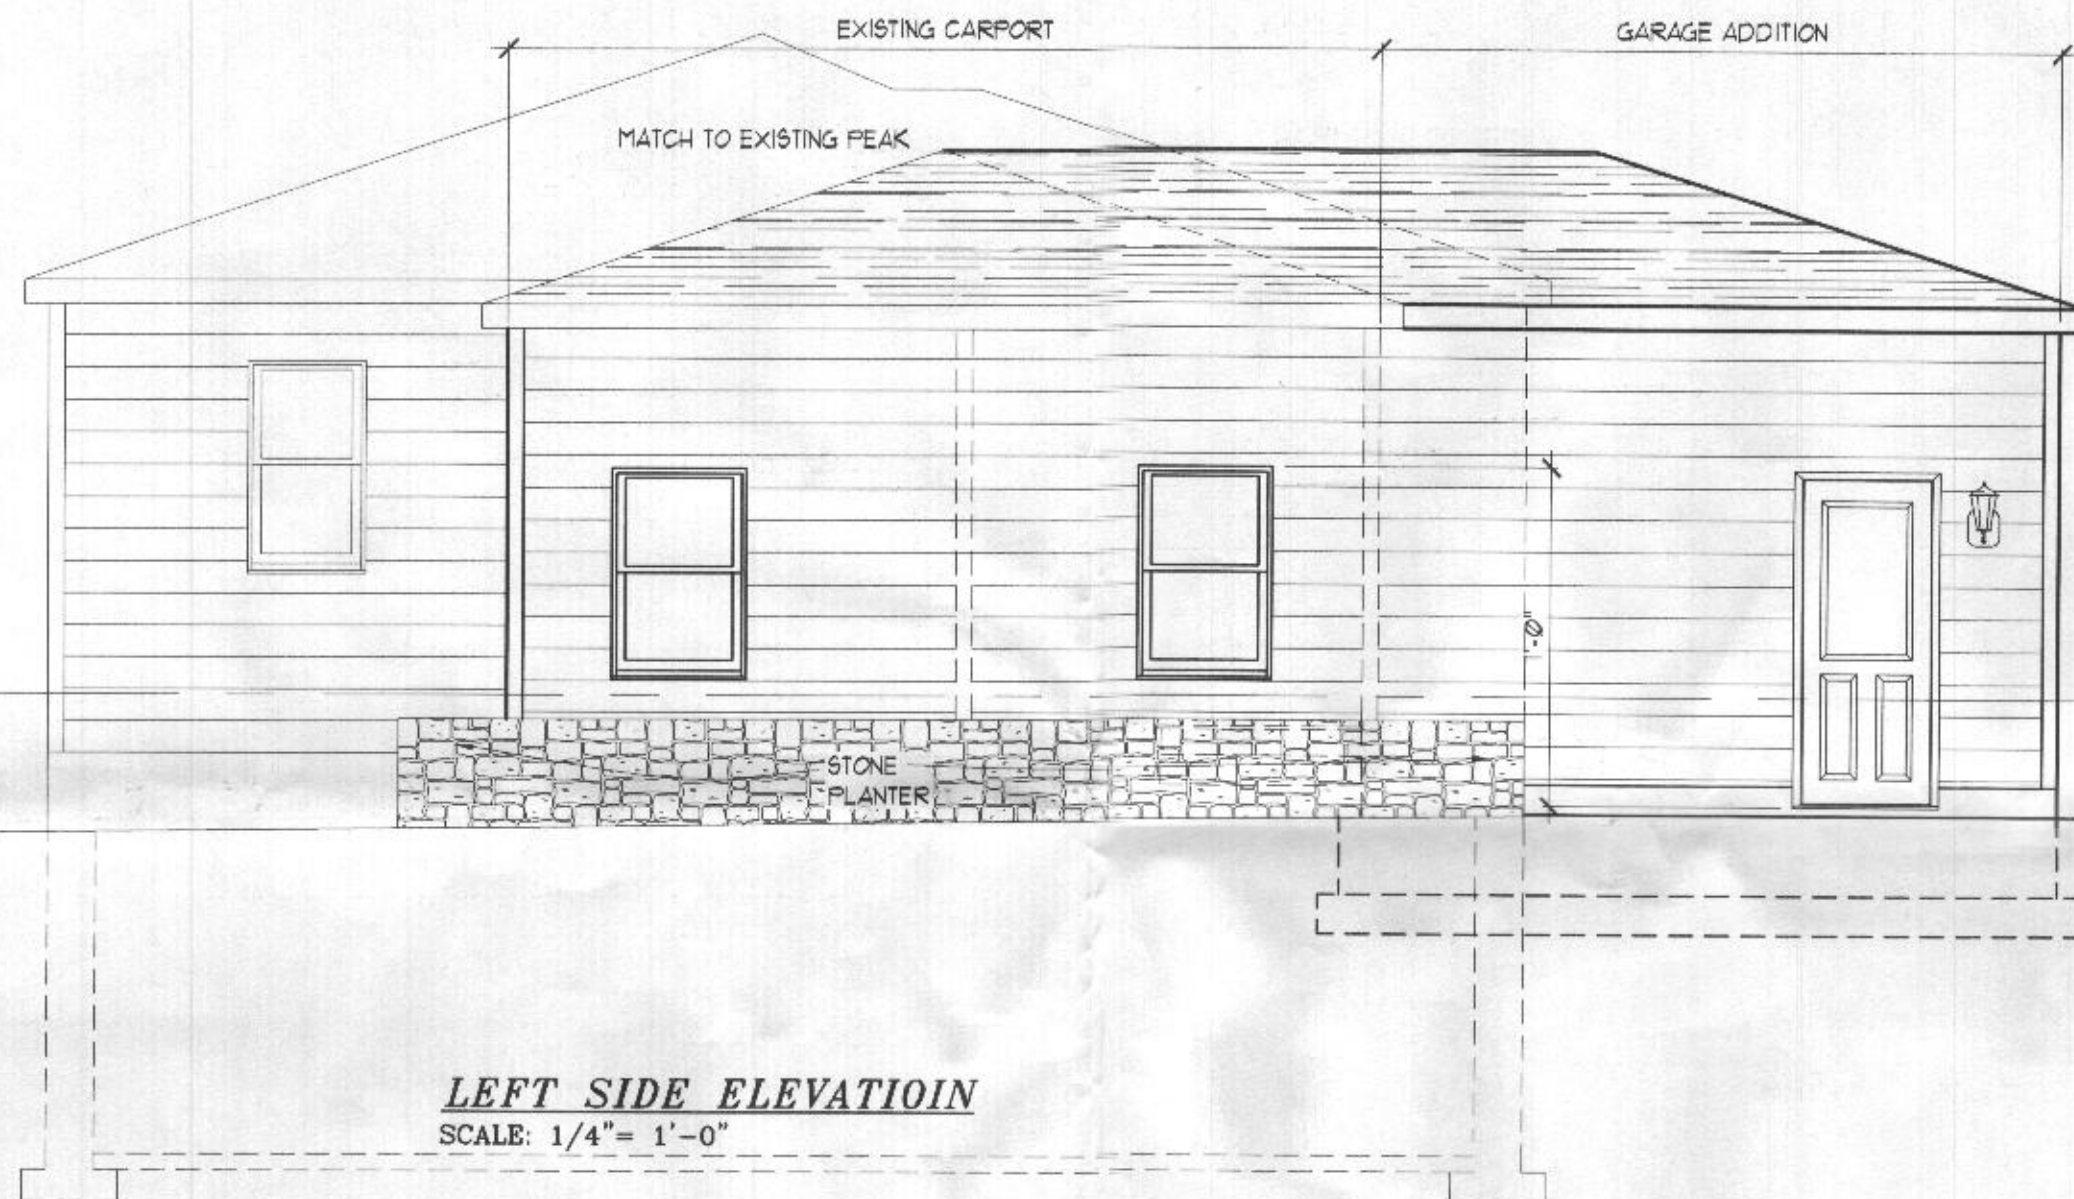

NOTES:
ALL EXTERIOR DIMENSIONS ARE FROM FACE OF SHEATHING UNLESS NOTED OTHERWISE.
ALL INTERIOR DIMENSIONS ARE FROM FACE OF STUD UNLESS NOTED OTHERWISE.
ALL MASONRY DIMENSIONS ARE FROM FACE OF MASONRY UNLESS NOTED OTHERWISE.
WINDOWS SHOWN AS ANDERSEN UNITS
SMOKE DETECTORS AS REQUIRED PER CODE

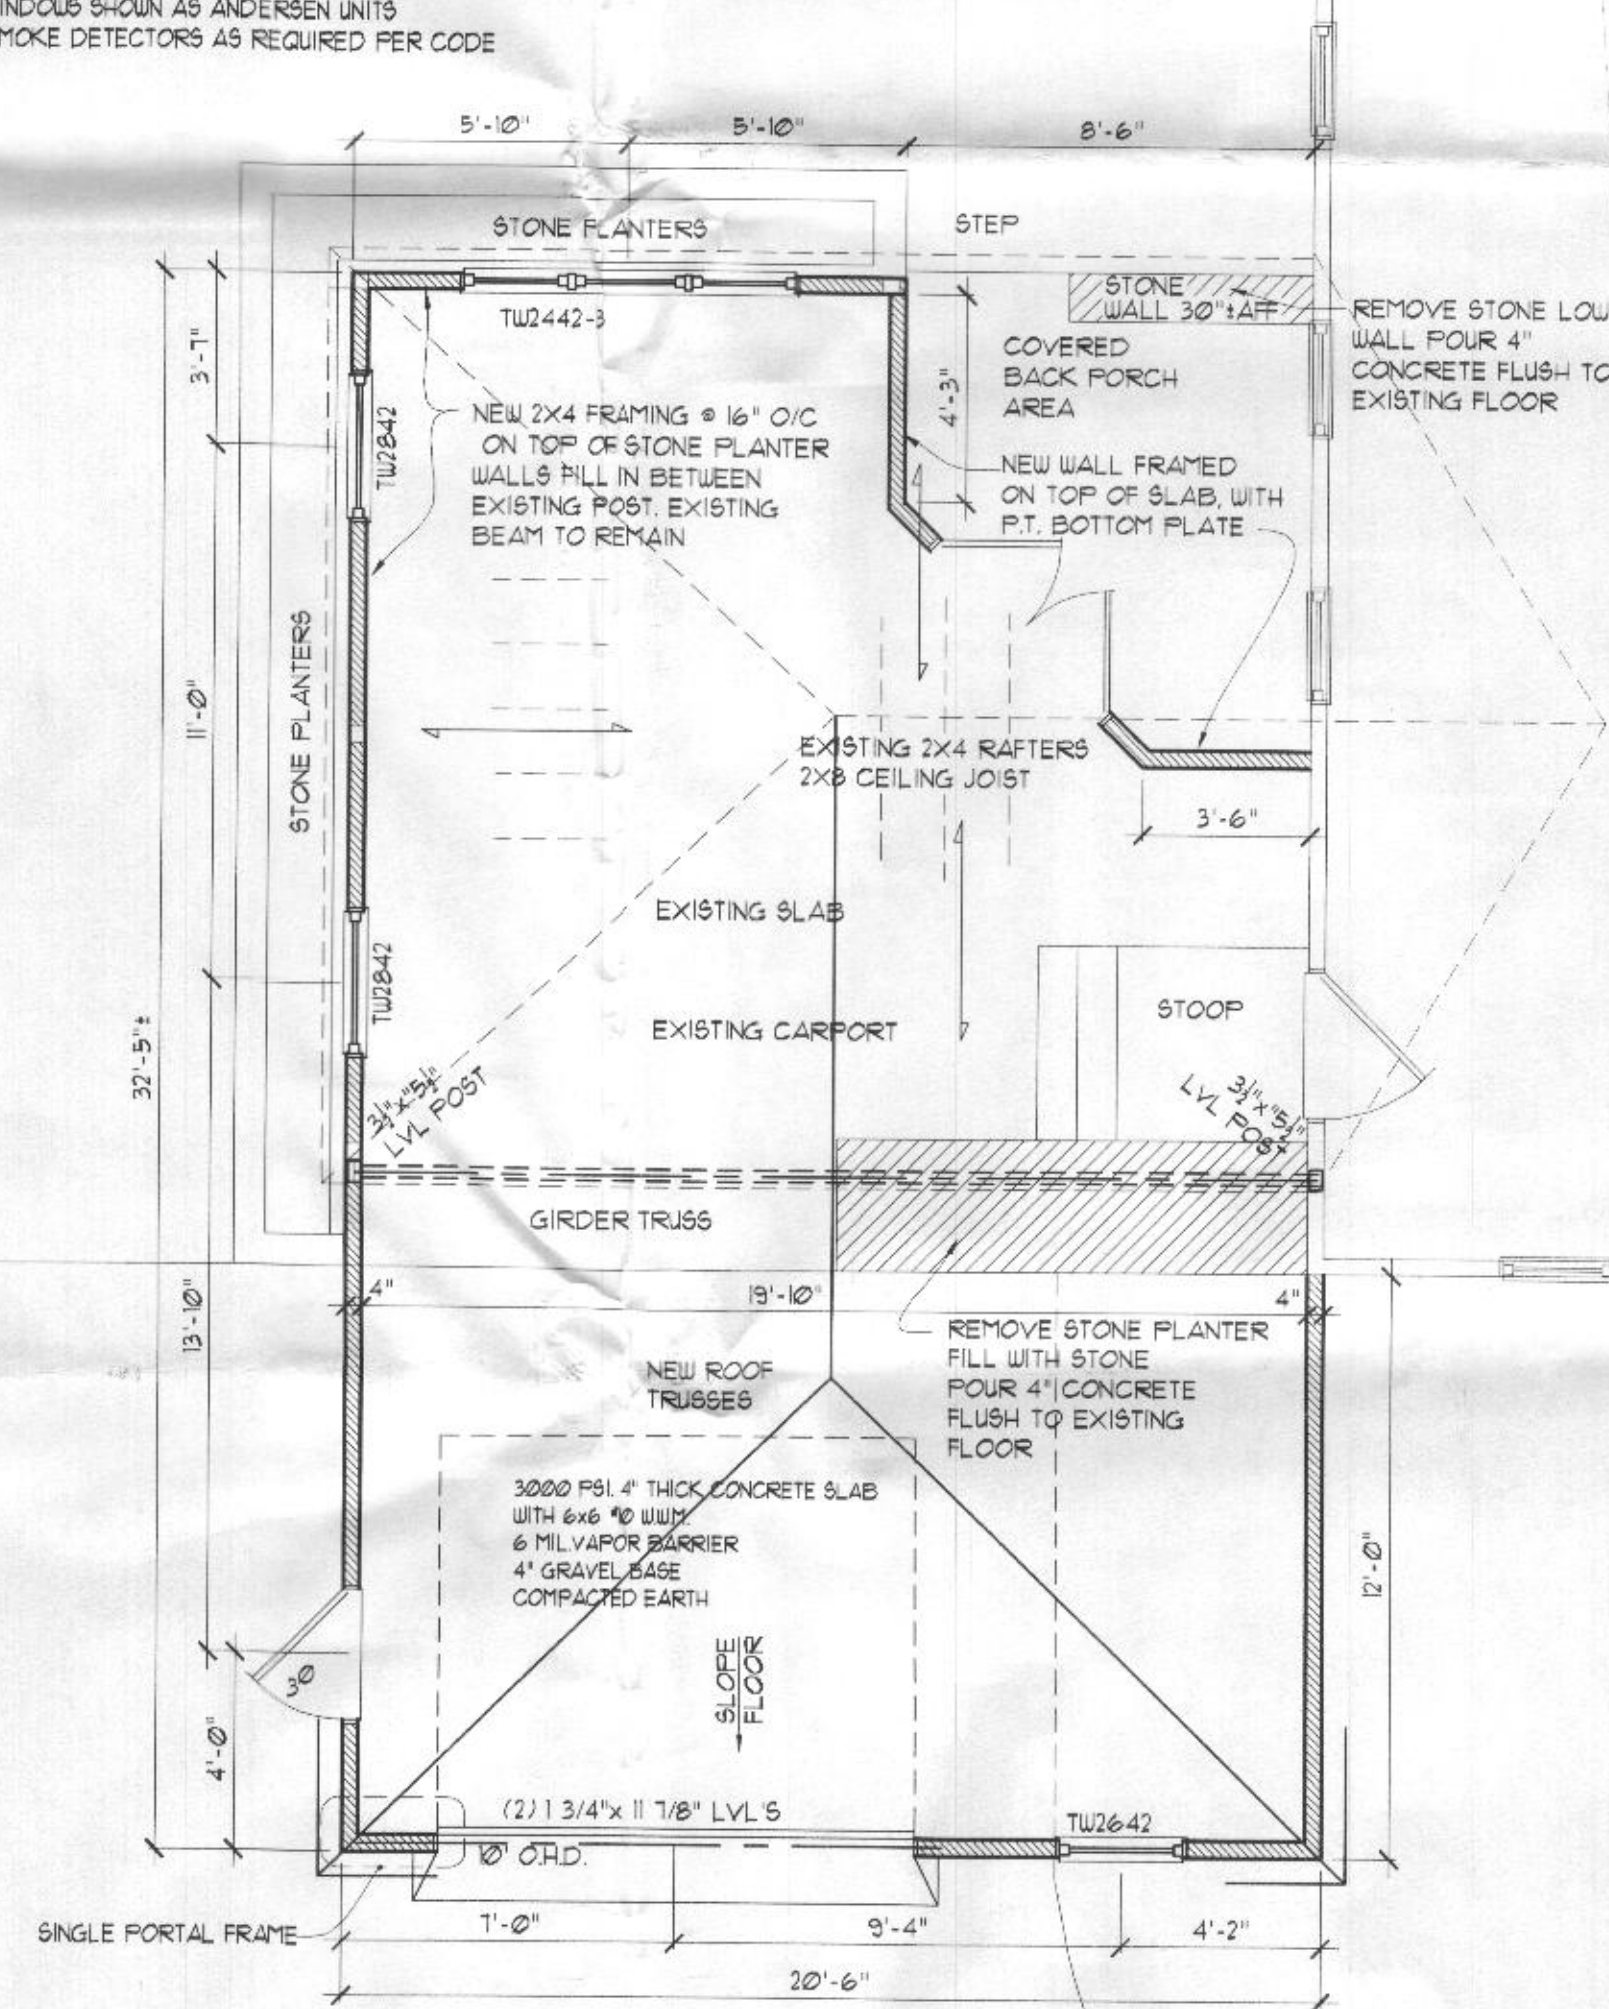

Contractor shall verify all dimensions and conditions and bring any discrepancy to the attention of the owner and the engineering LLC before proceeding with the work. All rights reserved. The work contained in this document is the exclusive property of RLC Design & Engineering LLC. Nothing contained herein, including this disclaimer, shall be used, copied, or distributed in any way or by any means without the express written permission of RLC Design & Engineering LLC.	
05-02-2012 REVIEW	PERMIT ISSUE 5-24-12
DESIGNED	RRF
DRAWN	MAG
CHECKED	
Professional Certification: I hereby certify that these documents were prepared or approved by me, and that I am a duly licensed professional engineer under the laws of the State of Maryland. License No. 10238, Expiration Date: 2/23/2013	
RLC Design & Engineering 13040 Old Hanover Road, Reston, Virginia 20190 Phone: 410.833.1300 Fax: 410.833.6803	
PROJECT TITLE	GREENE RESIDENCE 13237 TRIADPHIA RD ELLICOTT CITY MD 21042-1140
SHEET TITLE	PROPOSED GARAGE ADDITION
SCALE	As Noted
START DATE	04-14-2012
SHEET NO. A-1	

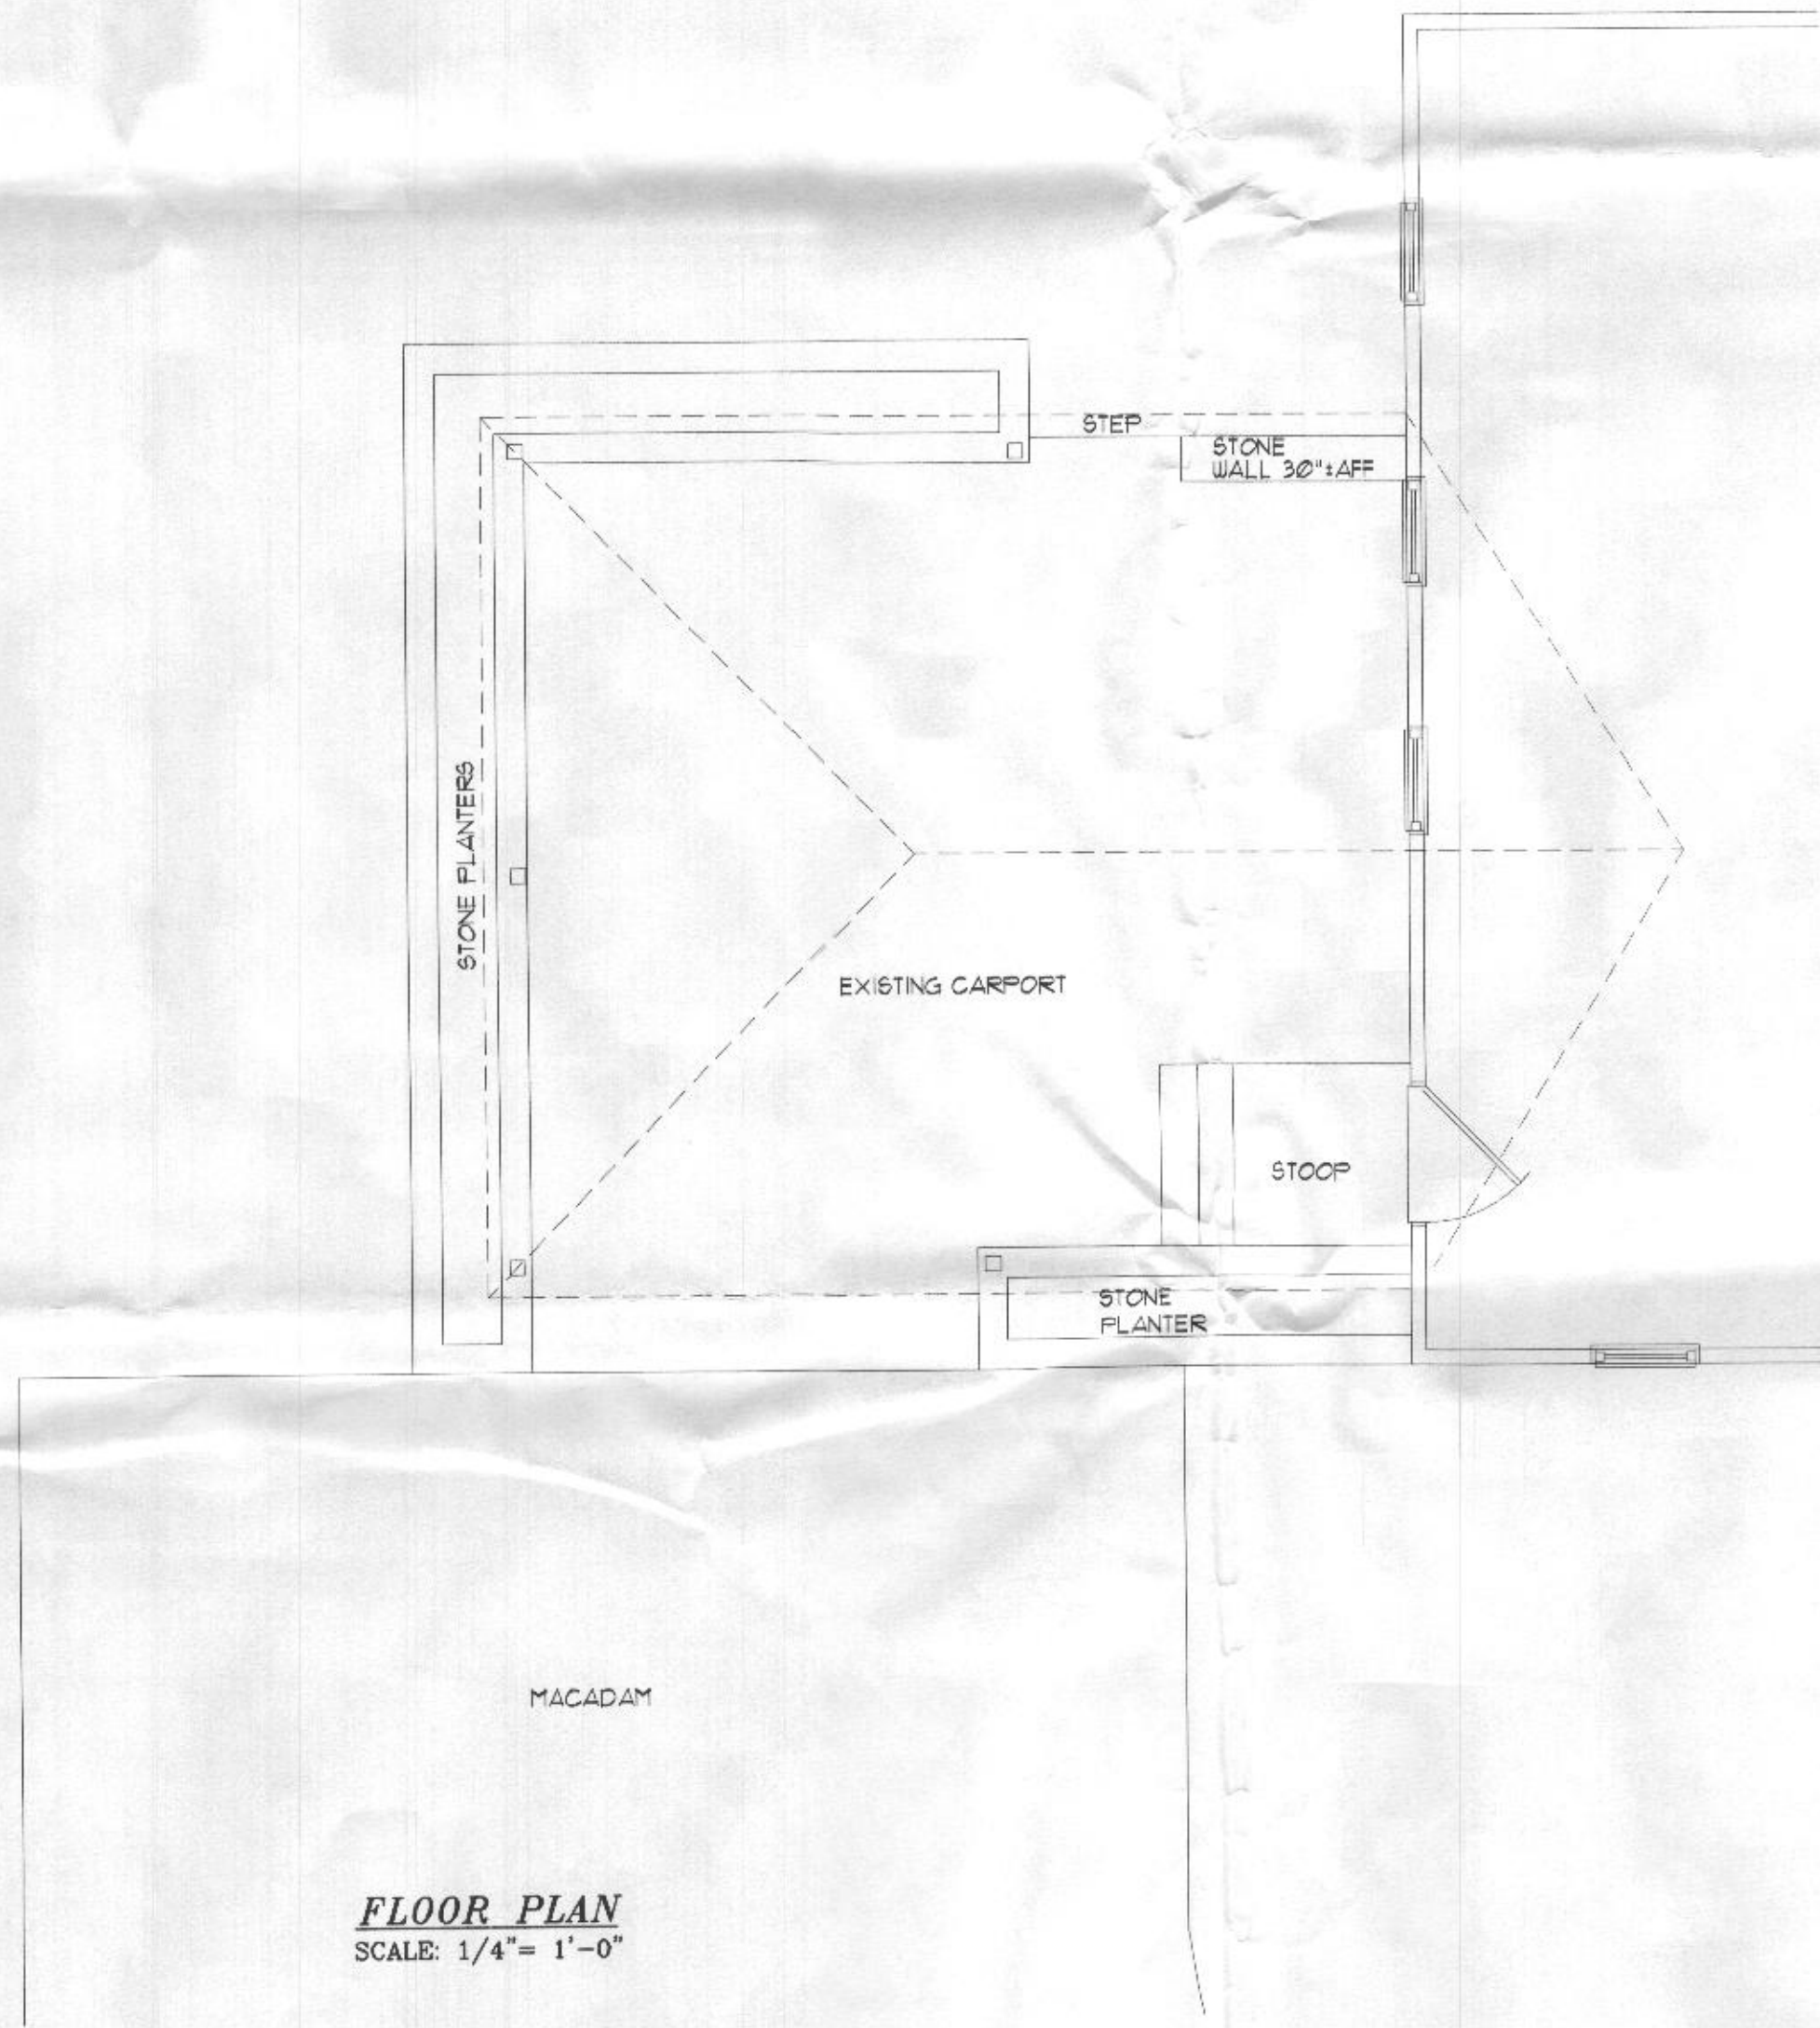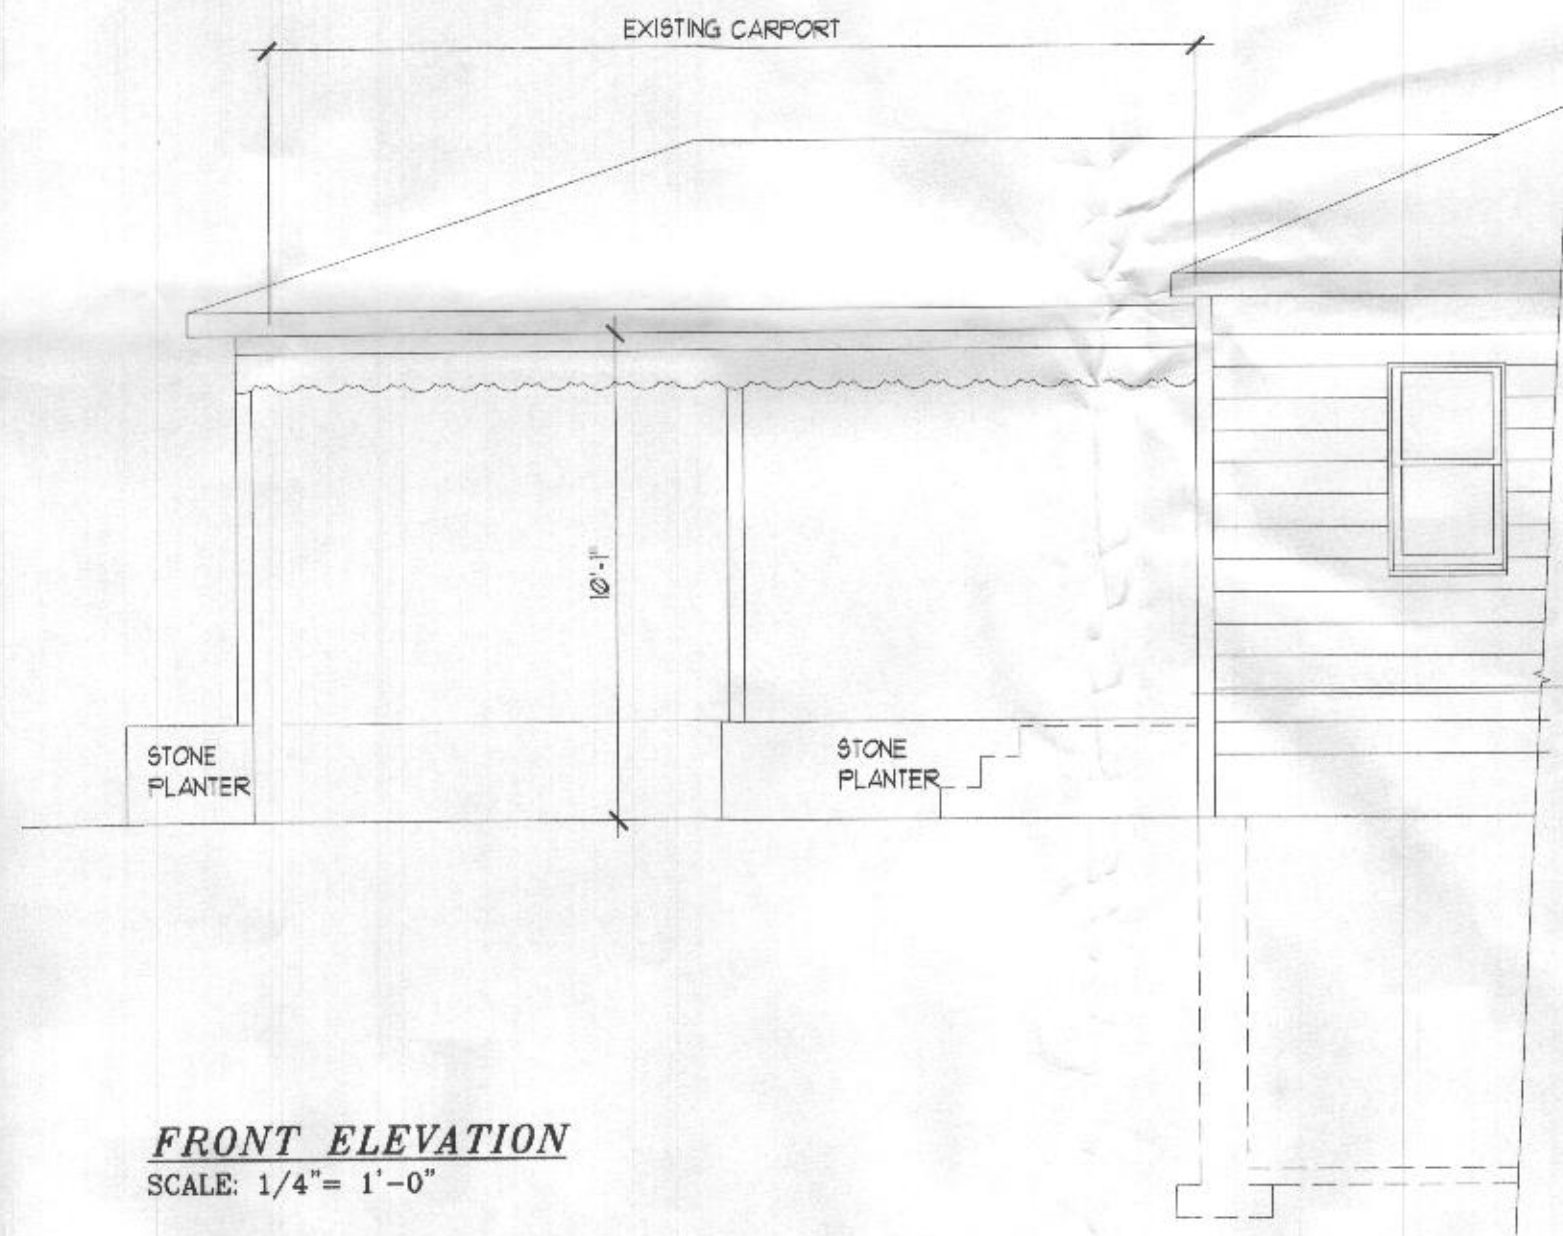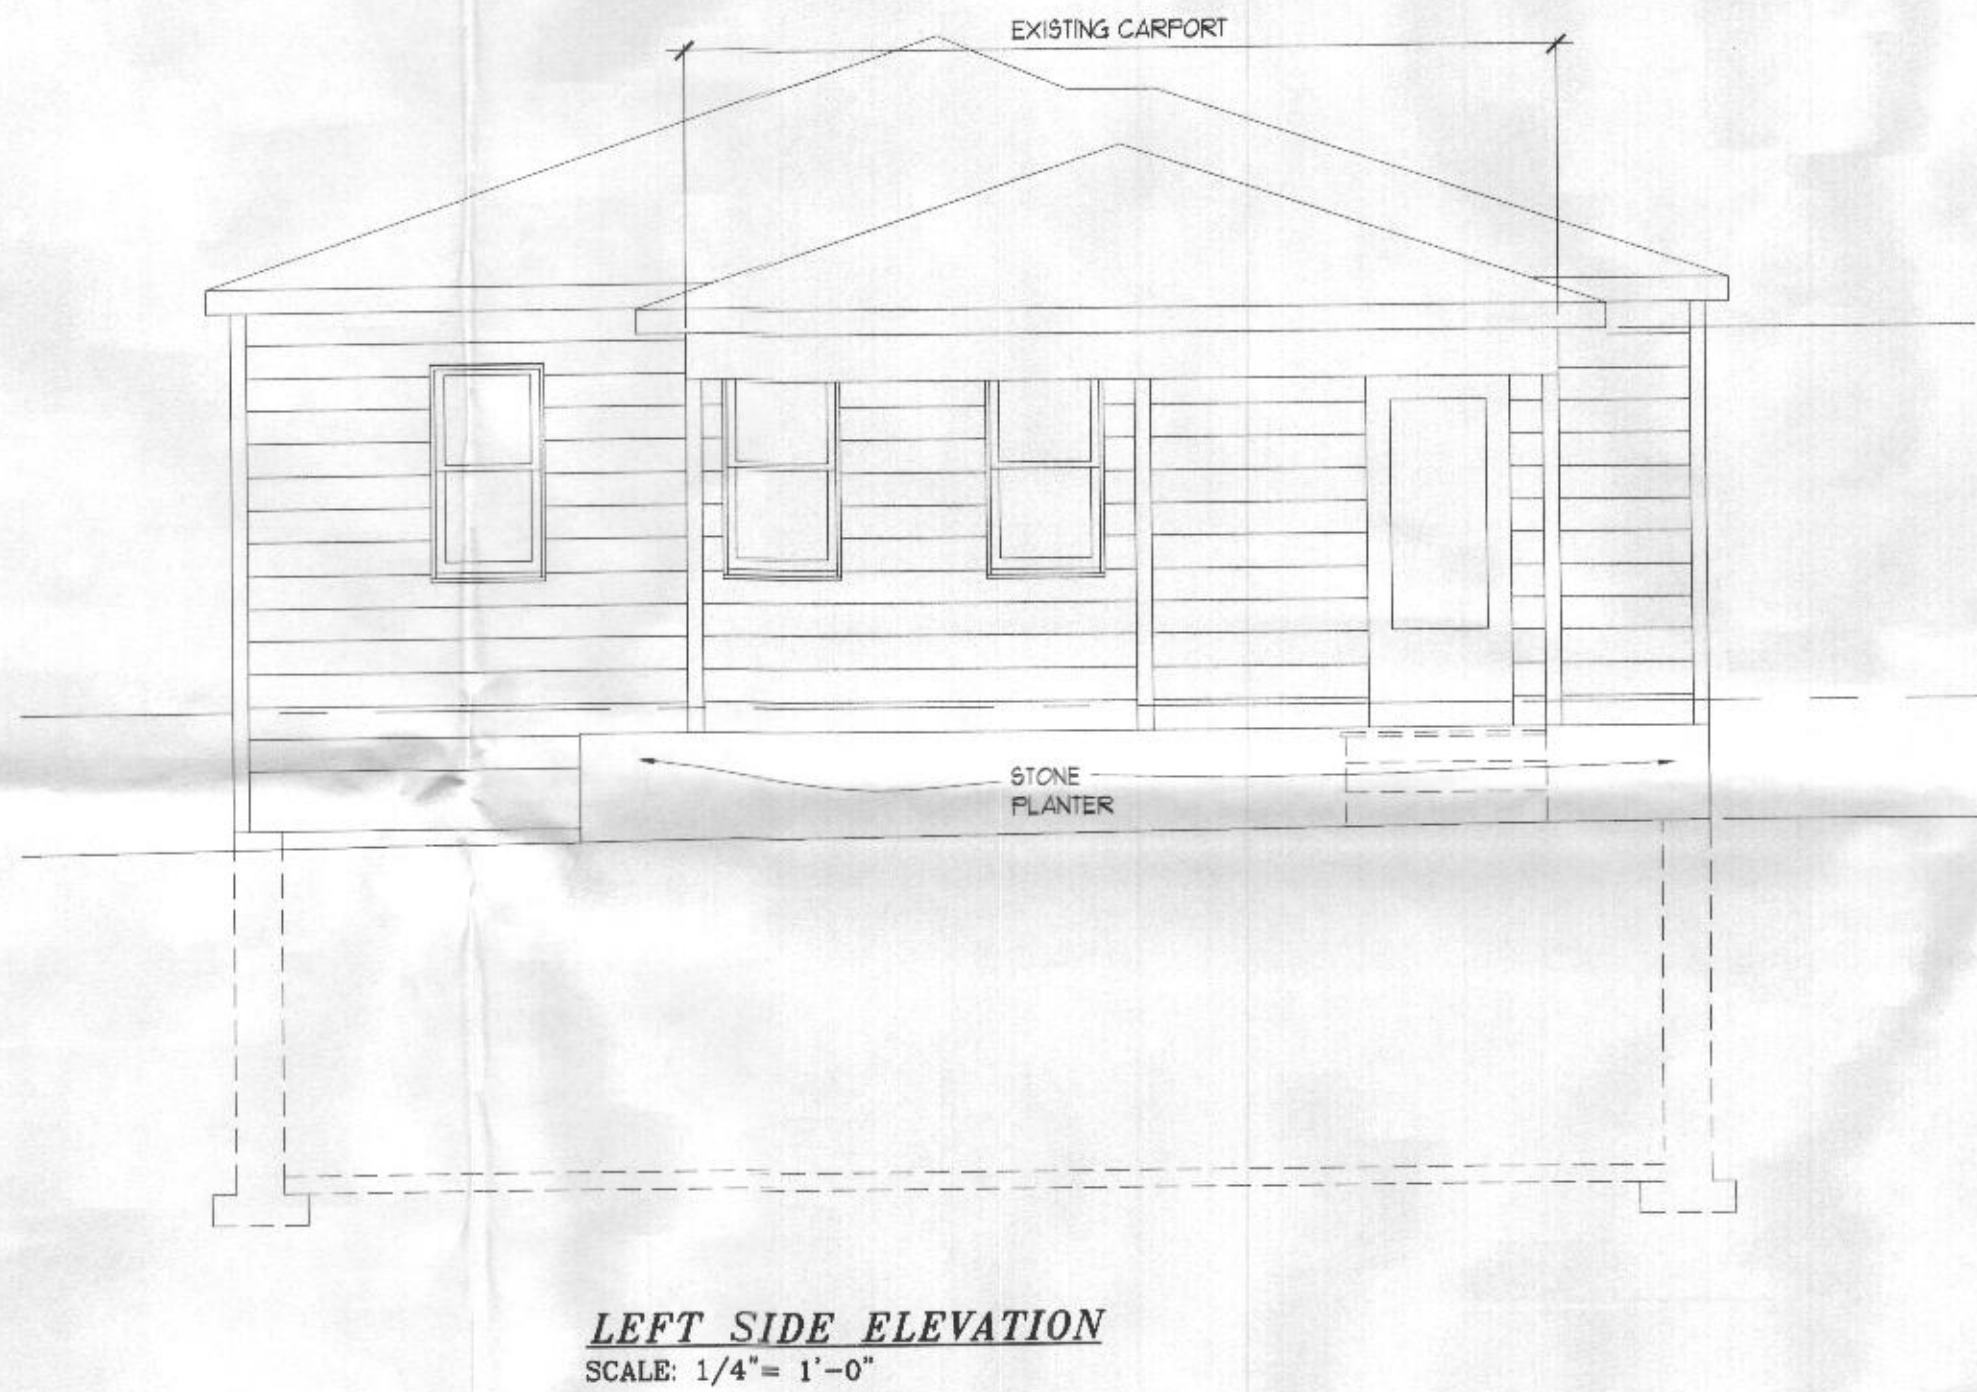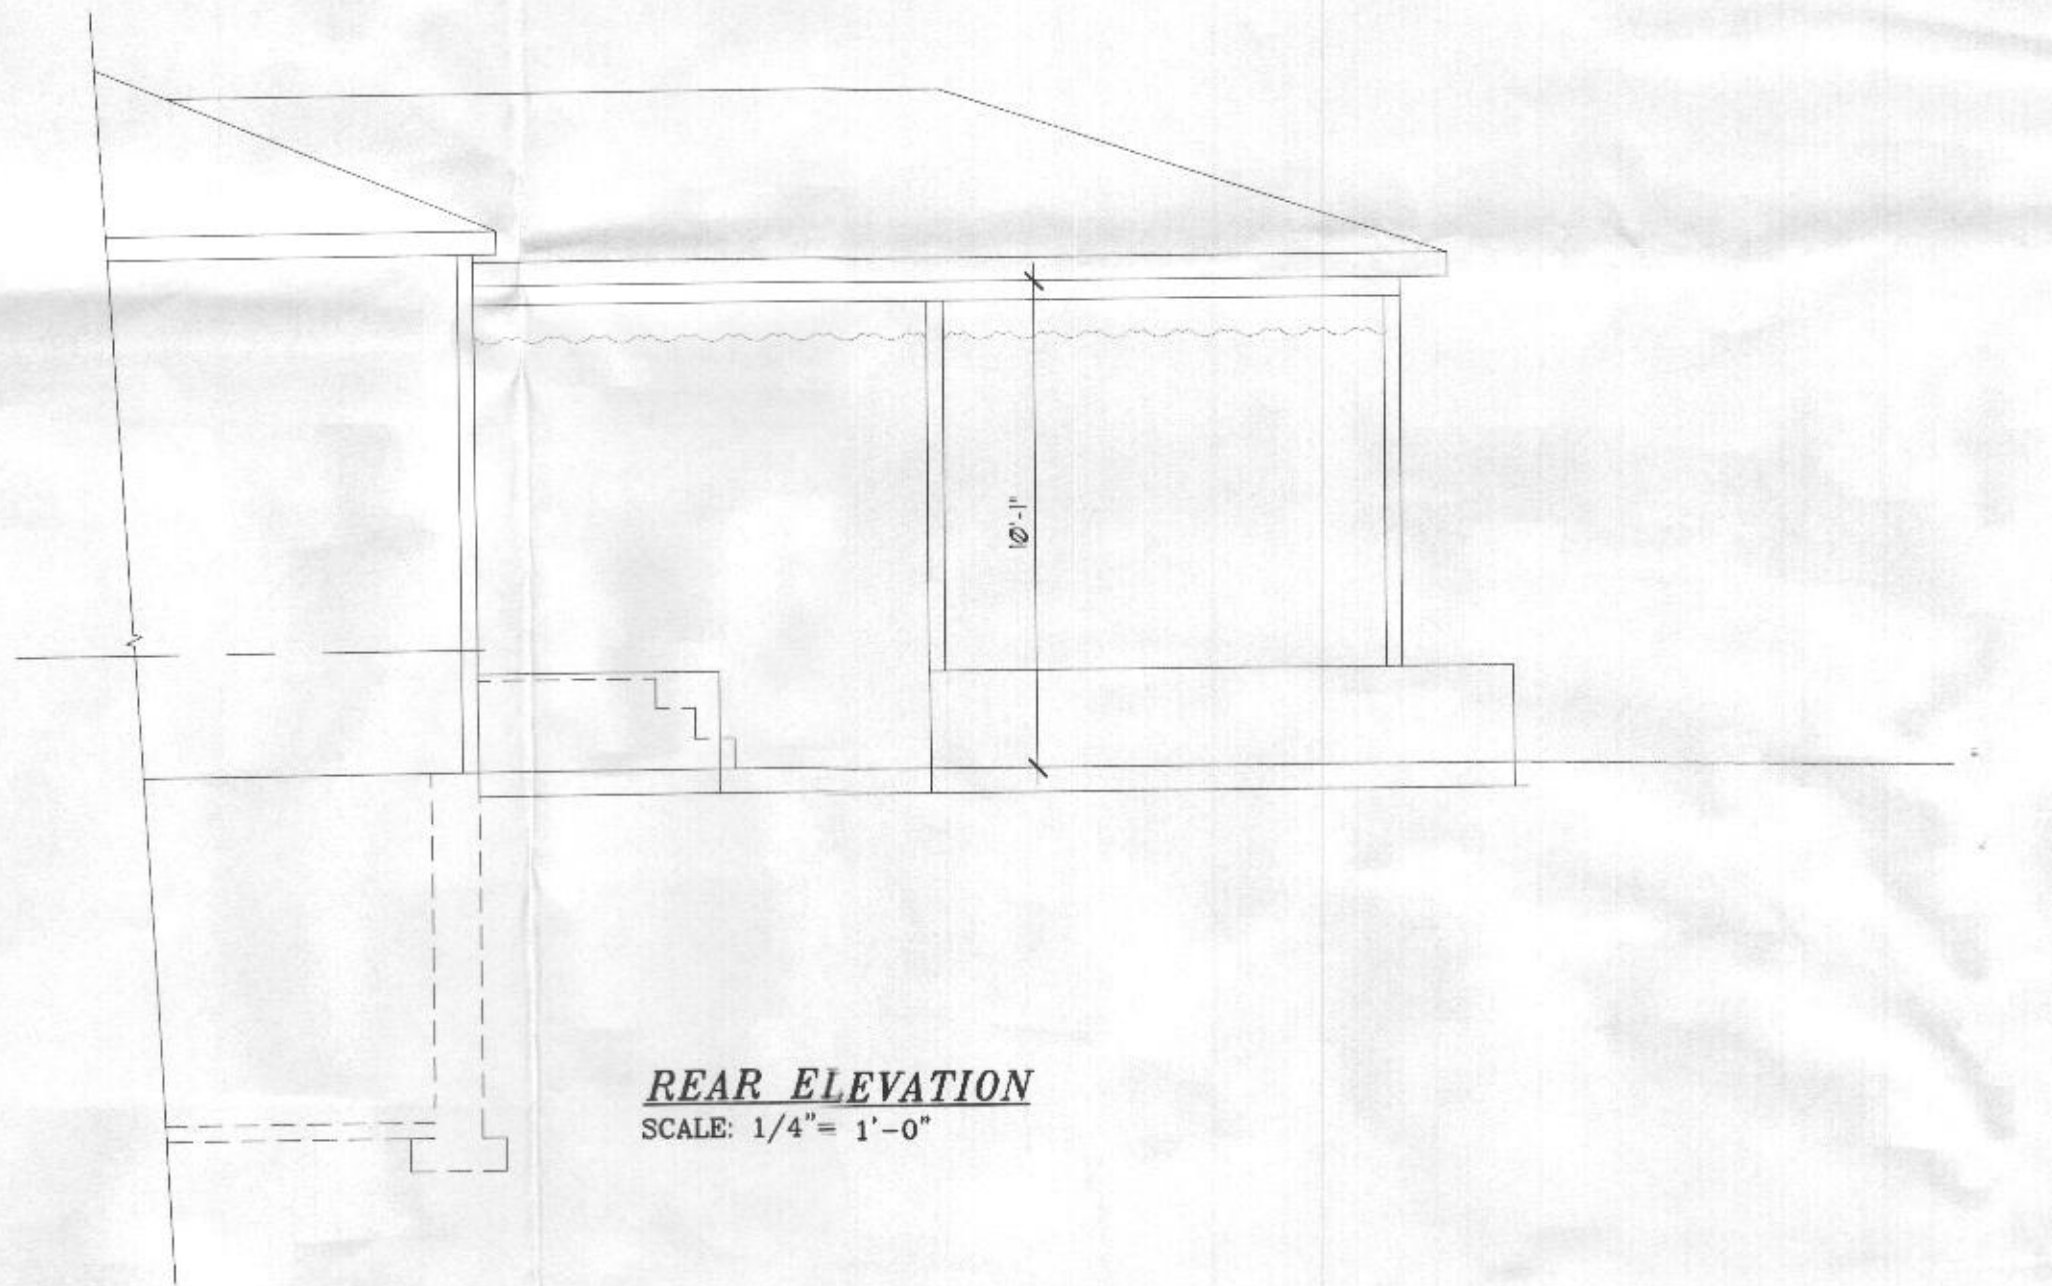

Note: This bar should equal 1" if drawing is at full scale.

SHEET NO.
A-2

2 OF 2

PROJECT TITLE
GREENE RESIDENCE
13237 TRIADAPHIA RD
ELLICOTT CITY MD 21042-1140

SHEET TITLE
AS CONSTRUCTED

SCALE
As Noted

START DATE
04-14-2012

RLC Design & Engineering
13040 Old Hanover Road, Reisterstown, Maryland 21136
Phone: 410.833.1300 Fax: 410.833.6803



Professional Certification:
I hereby certify that these documents were prepared or approved by me and that I am a duly licensed professional engineer under the laws of the State of Maryland. License No. 10238, Expiration Date: 05-02-2012

DESIGNED
RRF
DRAWN
MAG
CHECKED
MAG

05-02-2012 REVIEW
PERMIT ISSUE 5-24-12

Contractor shall verify all dimensions and conditions and bring any discrepancy to the attention of RLC Design & Engineering LLC. All work shall be done in accordance with the design contained in this document. The work contained in this document is the exclusive property of RLC Design & Engineering LLC. Nothing contained herein, including the design concept, may be reproduced, stored in a retrieval system, or transmitted in any form or by any means without the express written permission of RLC Design & Engineering LLC.