

RECEIVED

OCT 01 2021

PERMIT NUMBER: B 21003756

DATE ACCEPTED:

LICENSES & PERMITS DIVISION



RESIDENTIAL BUILDING PERMIT APPLICATION

HOWARD COUNTY DEPARTMENT OF INSPECTIONS, LICENSES, AND PERMITS

3430 COURT HOUSE DRIVE, ELLICOTT CITY, MD 21043 - PHONE: (410) 313-2455 OPTION #4

www.howardcountymd.gov

BUILDING SITE ADDRESS REQUIRED

Street Address: 702 Woodbine Crossing Rd
City: Mt Airy State: MD Zip Code: 21771
Subdivision/Village/Complex Name: SDP/WP/BA #:
Lot: 15 Tax Map: 0002 Parcel: 0253 Grading Permit #:

DESCRIPTION OF WORK REQUIRED

Existing Use: BASEMENT Proposed Use: Finish BASEMENT Estimated Cost: \$ 70,000
Trade Work to Be Completed (Separate Permits Required): Mechanical (HVACR) Electrical Plumbing None
Finish Basement to include BR ROOM, play room, full bath, 2x unfinished laundry rooms

PROPERTY OWNER INFORMATION REQUIRED

Owner(s) Name(s) (As it appears on tax records): Derek, Christine Shepherd Primary Residence: Yes No
Owner's Street Address: 702 Woodbine Crossing Rd
City: Mt Airy State: MD Zip Code: 21771
Phone: 667-686-7044 Email: Roberts8494@gmail.com

APPLICANT NAME REQUIRED - INDIVIDUAL WHO SIGNS THIS APPLICATION

Business Name: DNG Construction Inc Contact Name: David Gates
Street Address: 5844 Woodville Rd
City: Mt Airy State: MD Zip Code: 21771
Phone: 240-674-7305 Email: dgates152@gmail.com

CONTRACTOR INFORMATION REQUIRED

Business Name: DNG Construction Inc
Licensee's Name: David Gates License #: 123666
Street Address: 5844 Woodville Rd
City: Mt Airy State: MD Zip Code: 21771
Phone: 240 674 7305 Email: dgates152@gmail.com

ARCHITECT/ENGINEER INFORMATION INDIVIDUAL WHO SIGNED PLANS, IF APPLICABLE

Business Name: Name:
Street Address:
City: State: Zip Code:
Phone: Email:

BUILDING CHARACTERISTICS REQUIRED

Primary Structure: SF Dwelling SF Townhouse SF Duplex Mobile Home Multi-Family Dwelling (MF*) Condo: Yes No
Utilities: Electric Gas Water Supply: Public Private (Well) Sewage Disposal: Public Private (Septic)
Heating System: Electric Natural Gas Propane Other: Roadside Tree Project: No Yes: #
Sprinkler System: NFPA 13 NFPA 13R NFPA 13D None Fire Alarm System: Yes No Voice Evac

ADDITIONAL RESIDENTIAL INFORMATION (PLEASE SELECT/COMPLETE ALL THAT APPLY)

Model Name & Options:
of Bedrooms (SF): 4 # of efficiency units (MF*): # of 1 BR (MF*): # of 2 BR (MF*): # of 3 BR (MF*):
Rooms: 8 # Full Baths: 3 # Half Baths: 1 # Fireplaces: 1
Garage/Carport Info: Attached Garage Detached Garage Integral Garage Carport None
Basement/Foundation Info: Slab on Grade Post & Pier Unfinished Basement Finished Basement: Full or Partial
1st Fl Width: 45 1st Fl Depth: 34 2nd Fl Width: 52x6 2nd Fl Depth: 52x2 Bsmt Width: 52x4 Bsmt Depth: 52x4
Energy Method: Prescriptive Performance UA Alternative ERI Gross Area: 4428 sq ft Occupiable Area: 3114 sq ft

AGREEMENT/ DISCALIMER REQUIRED


THE UNDERSIGNED HEREBY CERTIFIES AND AGREES AS FOLLOWS: (1) THAT HE/SHE IS AUTHORIZED TO MAKE THIS APPLICATION; (2) THAT THE INFORMATION IS CORRECT; (3) THAT HE/SHE WILL COMPLY WITH ALL REGULATIONS OF HOWARD COUNTY WHICH ARE APPLICABLE THERETO; (4) THAT HE/SHE WILL PERFORM NO WORK ON THE ABOVE REFERENCED PROPERTY NOT SPECIFICALLY DESCRIBED IN THIS APPLICATION; (5) THAT HE/SHE GRANTS COUNTY OFFICIALS THE RIGHT TO ENTER ONTO THIS PROPERTY FOR THE PURPOSE OF INSPECTING THE WORK PERMITTED AND POSTING NOTICES.

David Gates (Signature) 9-10-21 (Date Signed)
APPLICANT'S ORIGINAL SIGNATURE DATE SIGNED

FOR OFFICE USE ONLY CHECKS PAYABLE TO: DIRECTOR OF FINANCE OF HOWARD COUNTY

AGENCIES REQUIRED/APPROVALS:
Health 10/12/21
SHA CID


SUBMITTAL FEES: 135- PAYMENT: 136 ACCEPTED BY: [Signature]

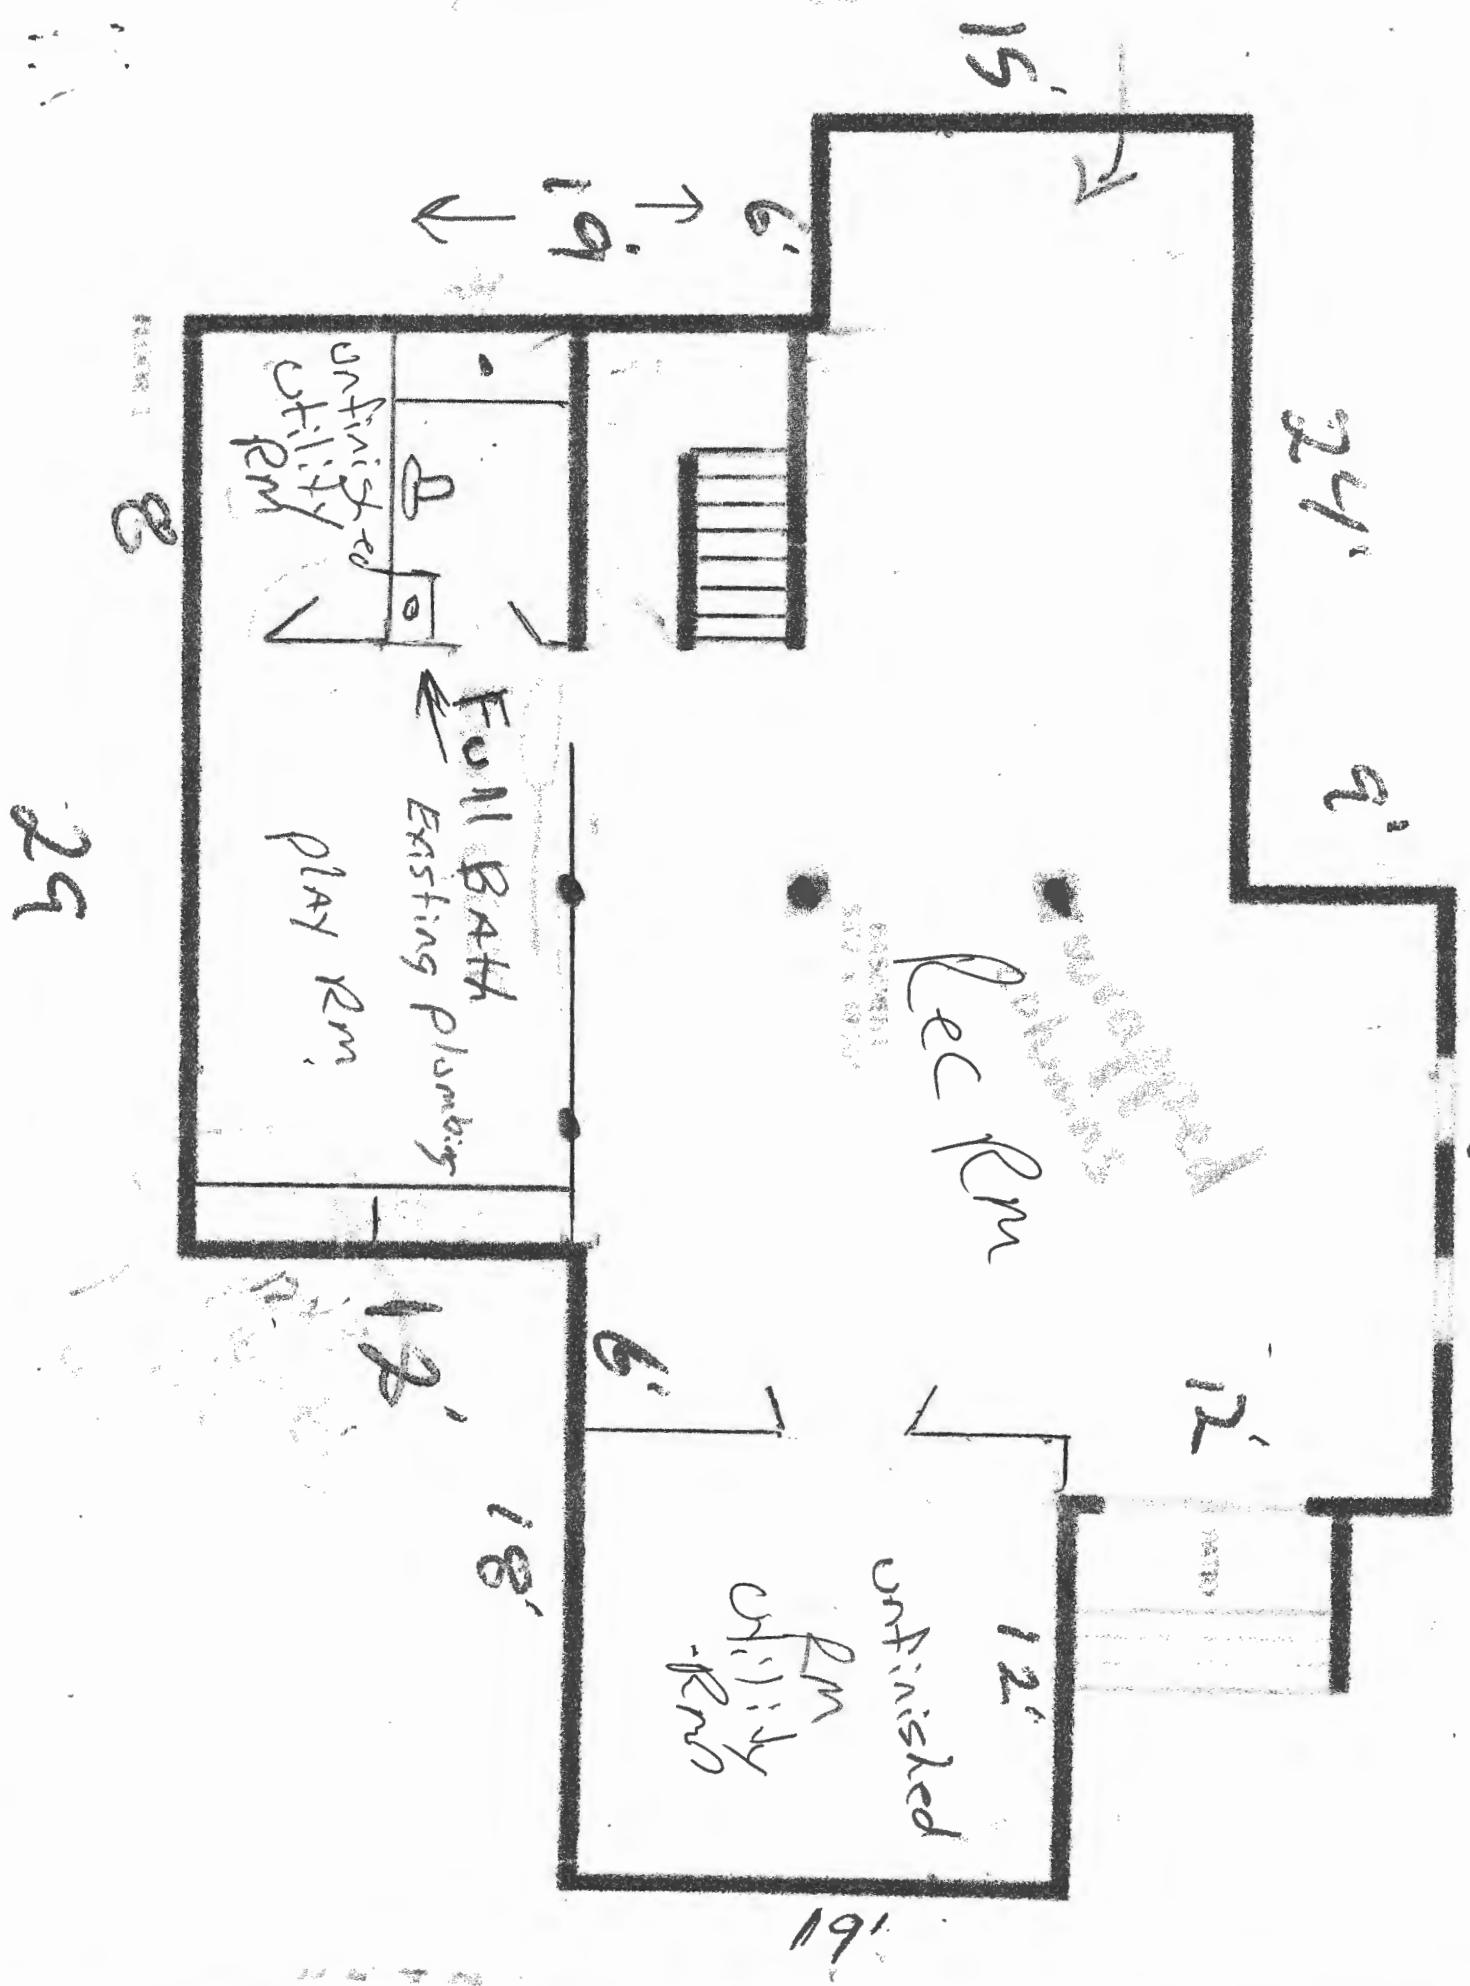


EXISTING
SPRINKLERS
TO REMAIN
IN SAME
SPOT.

drywall
ceiling

Grade
Foundation wall
INSULATION
2x4 walls
w/ Fire Blocking
1/2" Drywall

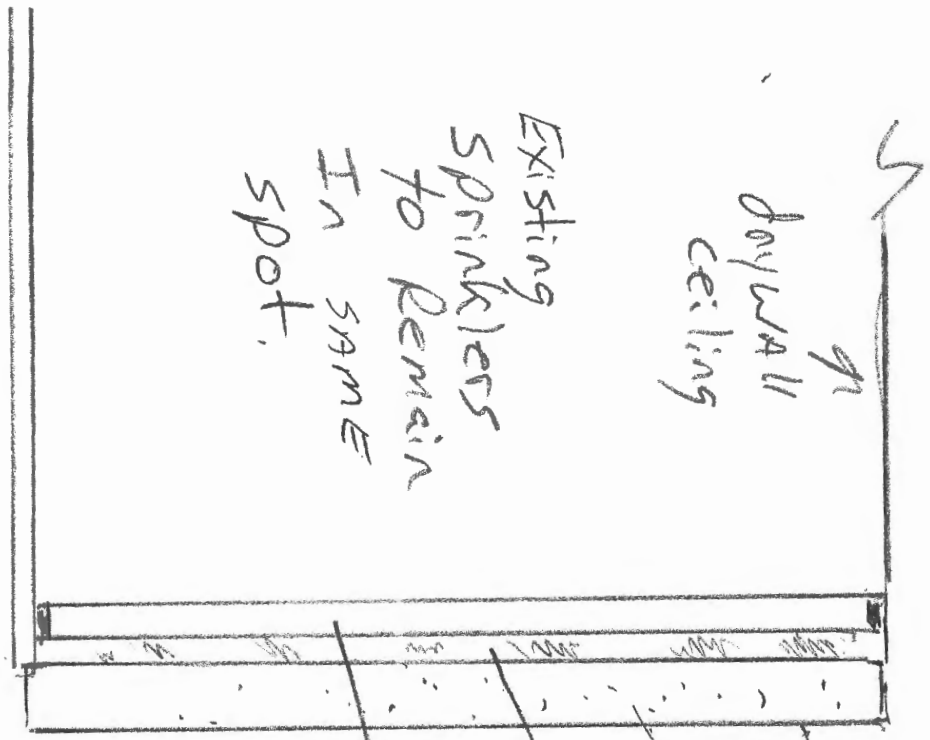

This is a two page document and is not valid without both pages. See page two (or reverse) for Survey Notes.

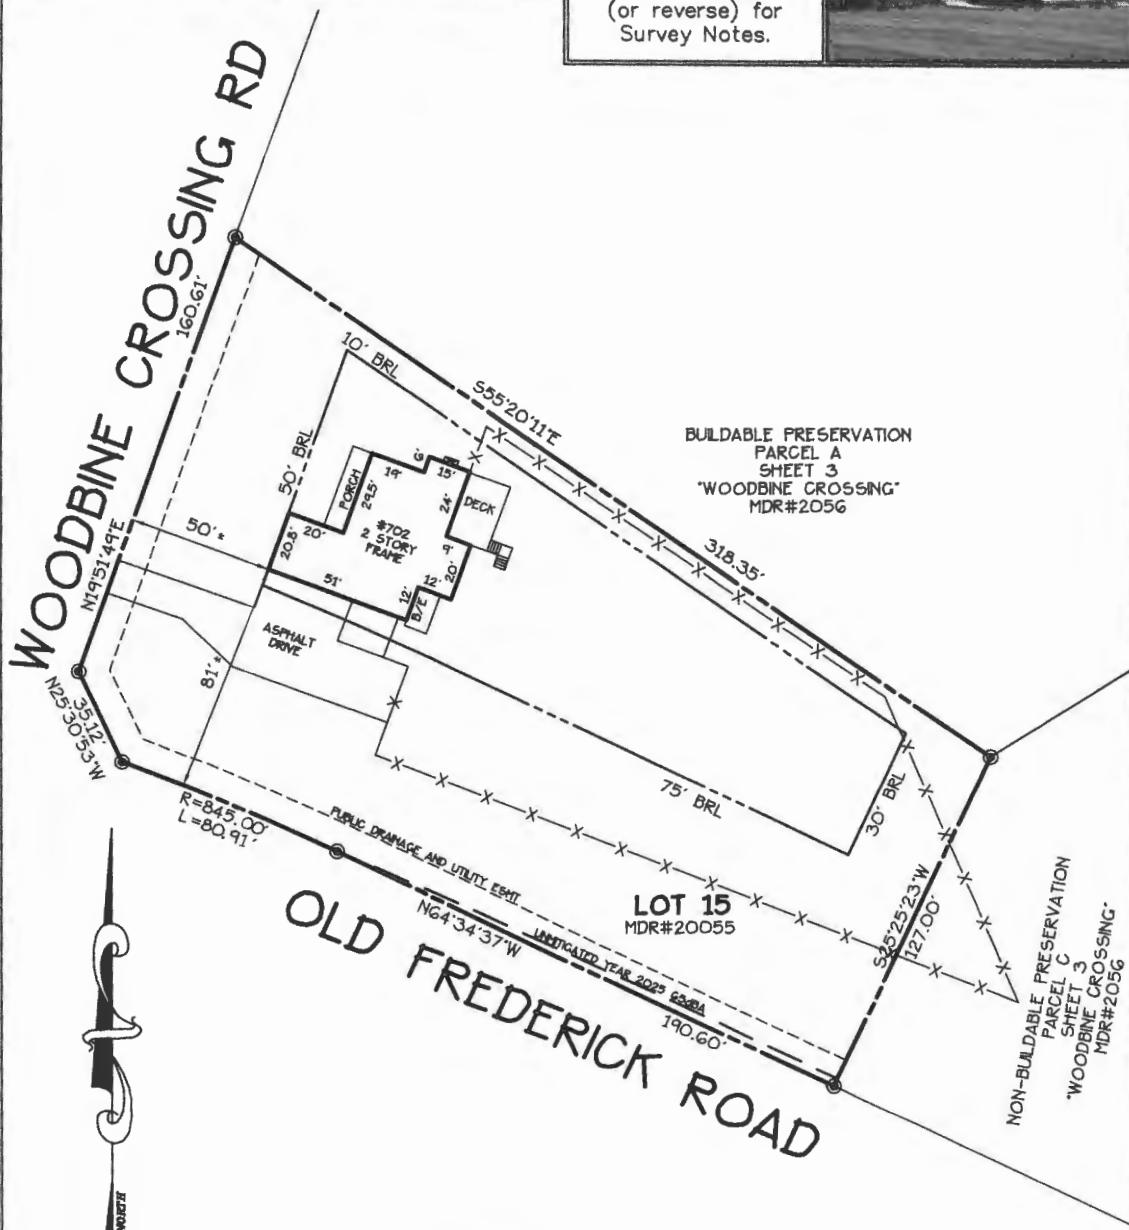

I hereby certify that the improvements shown hereon, to the best of my professional knowledge and ability, have been located by a transit, tape or total-station survey.

George A. Parrish IV

GEORGE A. PARRISH IV PROP.LS#577 05/11/21
 LICENSE EXPIRATION DATE 03/24/23

702 WOODBINE CROSSING ROAD MDR#20055

LOCATION DRAWING
 LOT 15 SHEET 2

WOODBINE CROSSING

FOURTH DISTRICT
 HOWARD COUNTY, MARYLAND
 SCALE: 1" = 50' MAY 2021

PROJECT#62113
 F/N: WOODBINECROSSING-SH2-L15
 DRAWN BY: BTG



Established 1975
 PO BOX 880
 CHESAPEAKE BEACH, MD 20732
 P: (410)286-9712 F: (410)286-9716