

Menu Save Reset Cancel Help

Record Detail * (This section is required.)

Permit Type

Building/Residential/Misc/Tanks

Permit Number

B20003433

Opened Date

10/07/2020

Description of Work

SFD//INSTALL (1) 500 GAL ABOVE GROUND PROPANE TANK

[check spelling](#)

Address * (This section is required.)

Search

Reset

Clear

Get Parcel & Owner

Street

6964

Street Name

WESTCOTT

Street Type

PL

Unit Type

--Select--

Unit

X Coordinate

-76.93136

Y Coordinate

39.18005

City

CLARKSVILLE

State

MD

Zip Code

21029

Primary

Yes

Parcel * (This section is required.)

Search

Reset

Clear

Get Address & Owner

GIS ID *

850789

Parcel

458

Parcel Area

3

Land Value

232500

Improved Value

679800

Exemption Value

447300

Plan Area

RURAL

Legal Description

IMPSLOT 7 3.0046 A[]6964 WESTCOTT PL[]ASHLEIGH GREENE SUB S1

[check spelling](#)

Block

Lot

7

Census Tract

605102

Council Dist

4

Inspection Dist

Supervisor Dist

Map

DAP Zone

Plan Area

State Tax Id

1405409896

Subdivision Name

Ashleigh Greene Subdivision

Section

Area

Tax Map

41

Grid

41-1

Zoning District

RR-DEO

ADC Map

5052-A2

SDP No.

Final Plan No.

WP File No.

Record Plat No.

8726

WS Contract No.

FDP No.

Primary

Yes

Owner Occupied

☐ Yes ☐ No

Year Built

1990

Historic District

☐ Yes ☒ No

Historic District Registry No.

Stat Area

5-15A

Flood Plain

☐ Yes ☒ No

Building No

Dana reviewed
and approved
last week
I added it to
Accela - (22)

Owner * (This section is required.)

Search

Reset

Clear

Name *

COLLINS CHARLES E

Address Line 1

6964 WESTCOTT PL

Address Line 2

Address Line 3

Mail City

CLARKSVILLE

Mail State

MD

Mail Zip Code

21029

Phone

301-725-3232

Primary

Yes

E-mail

Cell Number

Fax Number

Professionals (This section is not required.)

Search

Reset

Clear

License # *

20100103851

Business Name

THE H.J. POIST GAS COMPANY, INC

License Type *

Propane Gs

✓

First Name

SEAN

Middle Name

MICHAEL

Last Name

UNDERWOOD

Primary

Yes

✓

Address Line 1

360 MAIN STREET

Address Line 2

City

LAUREL

State

MD

ZIP Code

207070000

Phone 1

4434149582

Phone 2

Fax

E-mail

Applicant (This section is not required.)

Search

As Owner

As Lic. Prof

As Contact

Type *

Applicant

✓

First Name

MICHELLE

MI

Last Name

CLANCY

Relationship

Applicant

✓

Full Name

MICHELLE CLANCY

Primary

Yes

✓

Organization Name

APPLIED & APPROVED PERMITS LLC

Street Address

P.O. BOX 310

Address Line 2

City

PERRY HALL

State

MD

Zip Code

21128

Phone

443-340-1229

Cell

Fax

E-mail *

MICHELLE@APPLIEDANDAPPROVED.COM

Addtl Info

Est Construction Cost *	Housing Units *	Number of Buildings *	Public Owned
700	0	0	No ▼
Construction Type			
--Select-- ▼			

TANK INFORMATION

RESIDENTIAL TANK INFORMATION

Capital Project-No Fee *	Capital Project Number	Fee Exempt *	Roadside Tree Project Permit *	Roadside Tree Permit #
☐ Yes ☒ No		☐ Yes ☒ No	☐ Yes ☒ No	
Existing Use	Number of Tanks Installed *	Number of Tanks Removed *		
SFD ▼	1	0		
Water Supply	Sewage Disposal	Expiration Date	Relocate Existing Tank *	
Private ▼	Private ▼	4/7/2021	0	

PAYMENT INFORMATION

Check 1	Payee 1	Check 2	Payee 2	SAP Doc No	SAP Entered

Submit Cancel

WINGH.

LOCATION OF HOUSE
6964 WESTCOTT PLACE
LOT 7

ASHLEIGH GREENE
SUBDIVISION

SECTION 1


LOTS 1 THRU 27

5TH ELECTION DISTRICT
HOWARD COUNTY, MARYLAND


Wall Check: 12-19-89

Top of Wall El: 512.99

Final: 4-11-90

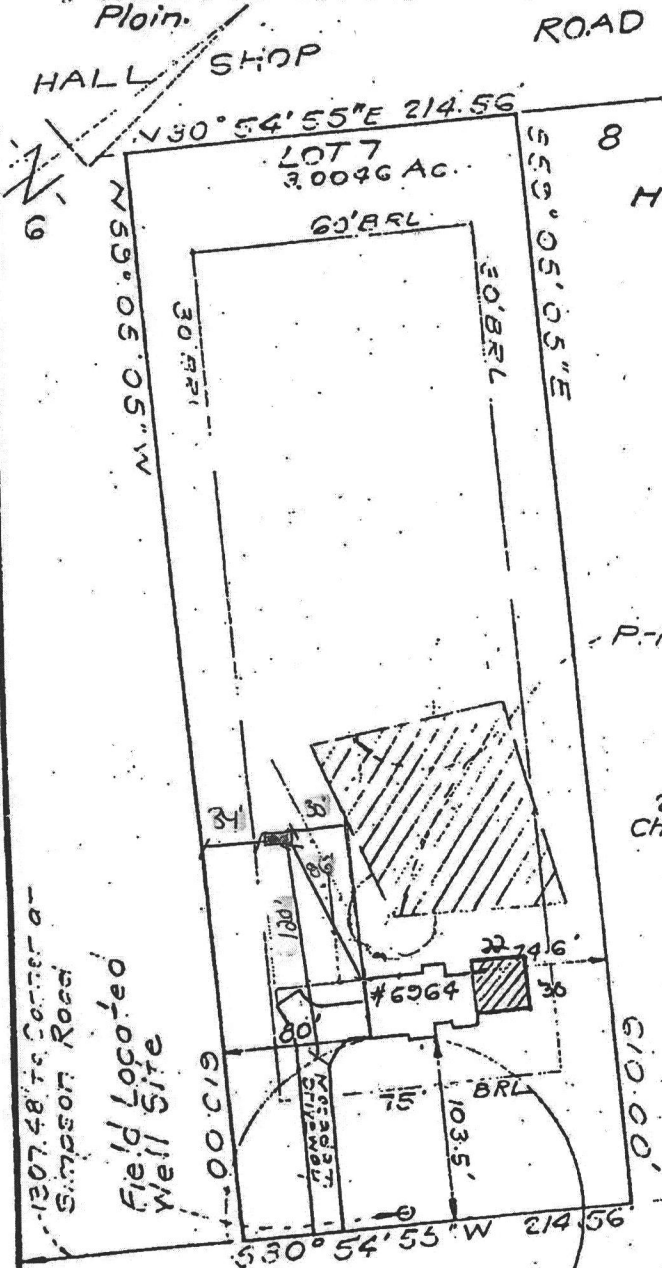

Private Sewage Easement
F No. 8343

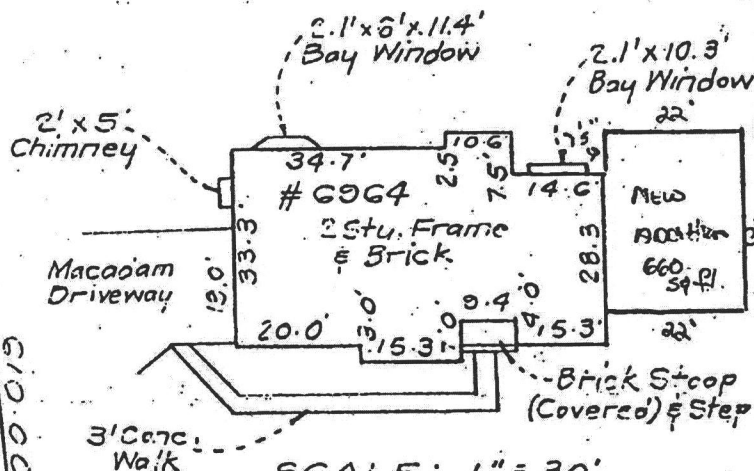

SCALE: 1" = 30'

WESTCOTT PLACE
50' R/W

89-001 Serial No. 25460

SURVEYOR'S CERTIFICATE

I hereby certify that the position of all existing improvements on the above described property have been carefully established by a transit tape survey and that unless otherwise shown, there are no encroachments.

Donald B. Gellert #6059

CLARK • FINEFROCK & SACKETT, INC.

ENGINEERS • PLANNERS • SURVEYORS
7135 MINSTREL WAY COLUMBIA, MD. 21045
(301) 381-7500-BALTO. • (301) 621-8100-WASH.

REFERENCE	DRAWN BY <i>SNP</i>	CHECKED BY <i>KWC</i>
Plat <i>No. 8343</i>	DATE <i>4-12-90</i>	FILE NO. <i>1512-W</i>
	SCALE <i>1"=100'</i>	