



Building Permit Application

Howard County Maryland
Department of Inspections, Licenses and Permits
3430 Court House Drive
Permits: 410-313-2455
www.howardcountymd.gov

Date Received: _____

Permit No.: _____

Building Address: 15901 Willis Way
City: Woodbine State: MD Zip Code: 21797
Suite/Apt. # _____ SDP/WP/BA #: _____
Subdivision: _____
Lot: 34 Tax Map: _____ Parcel: _____

Existing Use: _____
Proposed Use: Building (Free Standing Deck)
Estimated Construction Cost: \$ \$5,000

Description of Work: Building deck using Trex floor boards and Veranda PVC railing. Framing will be wood, following all County Codes) 16x16 Deck with stairs

Occupant/Tenant Name: _____
Was tenant space previously occupied? ☒ Yes ☐ No
Contact Name: _____
Address: _____
City: _____ State: _____ Zip Code: _____
Phone: _____ Fax: _____
Email: _____

Property Owner's Name: Thamman Valappil
Address: 15901 Willis Way
City: Woodbine State: MD Zip Code: 21797
Phone: (301) 905-7525 Fax: _____
Email: valappil@gmail.com

Applicant's Name & Mailing Address, (If other than stated herein)
Applicant's Name: Lynne Anderson
Address: 22253 Trentworth Way
City: Germantown State: MD Zip Code: 20876
Phone: (301) 980-1037 Fax: _____
Email: info@Deck-Renovations.com

Contractor Company: Deck-Renovations
Contact Person: Lynne Anderson
Address: _____
City: _____ State: _____ Zip Code: 20871
License No.: MTHC # 113379
Phone: 301 980-1037 Fax: _____
Email: LAnderson@Deck-Renovations.com

Engineer/Architect Company: _____
Responsible Design Prof.: _____
Address: _____
City: _____ State: _____ Zip Code: _____
Phone: _____ Fax: _____
Email: _____

Commercial Building Characteristics	Residential Building Characteristics
Height:	<input type="checkbox"/> SF Dwelling <input type="checkbox"/> SF Townhouse
No. of stories:	Depth Width
Gross area, sq. ft./floor:	1 st floor:
	2 nd floor:
Area of construction (sq. ft.):	Basement:
	<input type="checkbox"/> Finished Basement
Use group:	<input type="checkbox"/> Unfinished Basement
	<input type="checkbox"/> Crawl Space
Construction type:	<input type="checkbox"/> Slab on Grade
<input type="checkbox"/> Reinforced Concrete	No. of Bedrooms:
<input type="checkbox"/> Structural Steel	Multi-family Dwelling
<input type="checkbox"/> Masonry	No. of efficiency units:
<input type="checkbox"/> Wood Frame	No. of 1 BR units:
<input type="checkbox"/> State Certified Modular	No. of 2 BR units:
	No. of 3 BR units:
	Other Structure:
	Dimensions:
➤ Roadside Tree Project Permit	Footings:
<input type="checkbox"/> Yes <input type="checkbox"/> No	Roof:
Roadside Tree Project Permit #	<input type="checkbox"/> State Certified Modular
	<input type="checkbox"/> Manufactured Home

Utilities	
Electric: <input type="checkbox"/> Yes <input type="checkbox"/> No	
Gas: <input type="checkbox"/> Yes <input type="checkbox"/> No	
Water Supply	
<input type="checkbox"/> Public	
<input checked="" type="checkbox"/> Private	
Sewage Disposal	
<input type="checkbox"/> Public	
<input checked="" type="checkbox"/> Private	
Heating System	
<input type="checkbox"/> Electric <input type="checkbox"/> Oil	
<input type="checkbox"/> Natural Gas <input type="checkbox"/> Propane Gas	
<input type="checkbox"/> Other:	
Sprinkler System:	
<input type="checkbox"/> Yes <input type="checkbox"/> No	
Grading Permit Number:	
Building Shell Permit Number:	

THE UNDERSIGNED HEREBY CERTIFIES AND AGREES AS FOLLOWS: (1) THAT HE/SHE IS AUTHORIZED TO MAKE THIS APPLICATION; (2) THAT THE INFORMATION IS CORRECT; (3) THAT HE/SHE WILL COMPLY WITH ALL REGULATIONS OF HOWARD COUNTY WHICH ARE APPLICABLE THERETO; (4) THAT HE/SHE WILL PERFORM NO WORK ON THE ABOVE REFERENCED PROPERTY NOT SPECIFICALLY DESCRIBED IN THIS APPLICATION; (5) THAT HE/SHE GRANTS COUNTY OFFICIALS THE RIGHT TO ENTER ONTO THIS PROPERTY FOR THE PURPOSE OF INSPECTING THE WORK PERMITTED AND POSTING NOTICES.

Applicant's Signature: Lynne Anderson Print Name: Lynne Anderson
Email Address: info@Deck-Renovations.com Date: Nov-29-2017
Title/Company: Deck-Renovations

Checks Payable to: DIRECTOR OF FINANCE OF HOWARD COUNTY
PLEASE WRITE NEATLY & LEGIBLY
-FOR OFFICE USE ONLY-

AGENCY	DATE	SIGNATURE OF APPROVAL
State Highways		
Building Officials		
PSZA (Zoning)		
PSZA (Engineering)		
Health	<u>12/6/18</u>	<u>R Bruckner</u>
Is Sediment Control approval required for issuance? <input type="checkbox"/> Yes <input type="checkbox"/> No		
<input type="checkbox"/> CONTINGENCY CONSTRUCTION START		

DPZ SETBACK INFORMATION
Front:
Rear:
Side:
Side St.:
All minimum setbacks met? <input type="checkbox"/> Yes <input type="checkbox"/> No
Is Entrance Permit Required? <input type="checkbox"/> Yes <input type="checkbox"/> No
Historic District? <input type="checkbox"/> Yes <input type="checkbox"/> No
Lot Coverage for New Town Zone:
SDP/Red-line approval date:

Filing Fee	\$
Permit Fee	\$
Tech Fee	\$
Excise Tax	\$
PSFS	\$
Guaranty Fund	\$
Add'l per Fee	\$
Total Fees	\$
Sub- Total Paid	\$
Balance Due	\$
Check	#


Distribution of Copies: White: Building Officials Green: PSZA,Zoning Yellow: PSZA,Engineering Pink: Health Gold: SHA

ORDERED BY:

CAPITOL TITLE

Settle on Our Experience®
www.capitoltitle.com

ELLICOTT CITY, MARYLAND
Tel-410-465-2437 Fax-410-465-8028

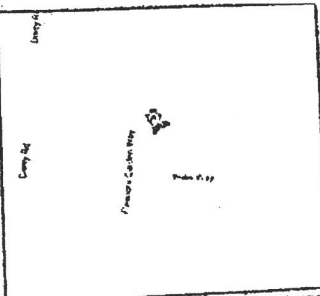

PROPERTY ADDRESS: 15901 WILLIS WAY

WOODBINE, MARYLAND 21797

SURVEY NUMBER: MD1504.2716

FIELD WORK DATE: 4/24/2015

REVISION HISTORY: (REV.1 4/24/2015)

MD1504.2716
LOCATION DRAWING
LOT 25
WATERFORD FARMS
HOWARD COUNTY, MARYLAND
04-24-2015 SCALE 1"=80'

APPROVED
WALKTHRU BUILDING PERMIT

BP# A# DATE: 12/6/18
APP. SAN
DESC. OF WORK: 16' x 16' Deck
w/ stairs to grade

LOT 34

S 85°23'54" E 145.32' (P)

LOT 26

LOT 25
45262 S.F.

S 4°36'06" W 325.00' (P)

N 85°23'54" W 115.00' (P)


WILLIS WAY
(40' R/W)

WILLIS WAY
(40' R/W)


N 40°23'54" W
35.36' (P)

N 4°36'06" E 257.82' (P)

R=170.00'
A=42.82' (P)

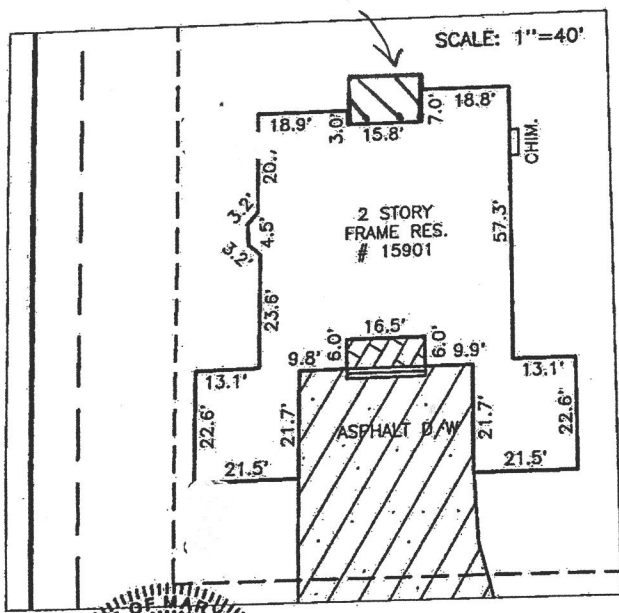

William J. H. H.
EXPIRES 1-15-2017

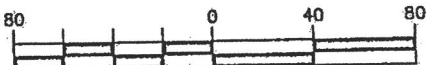

GRAPHIC SCALE (In Feet)
1 inch = 80' ft.

ACCURACY=3±