


AVP 57289M

ALL
 16" →
 27"
 37"
 78"
 9.5'
 14'

A
 GRAY ASPH P HORIZON
 BRN CL 2 SBK m FIR
 RED BRN SCL m FIC
 RED BRN SSCL
 FEW STONE 15%
 YEL BRN SISL vFR
 RED YEL
 SIL 2SBK MICACEOUS

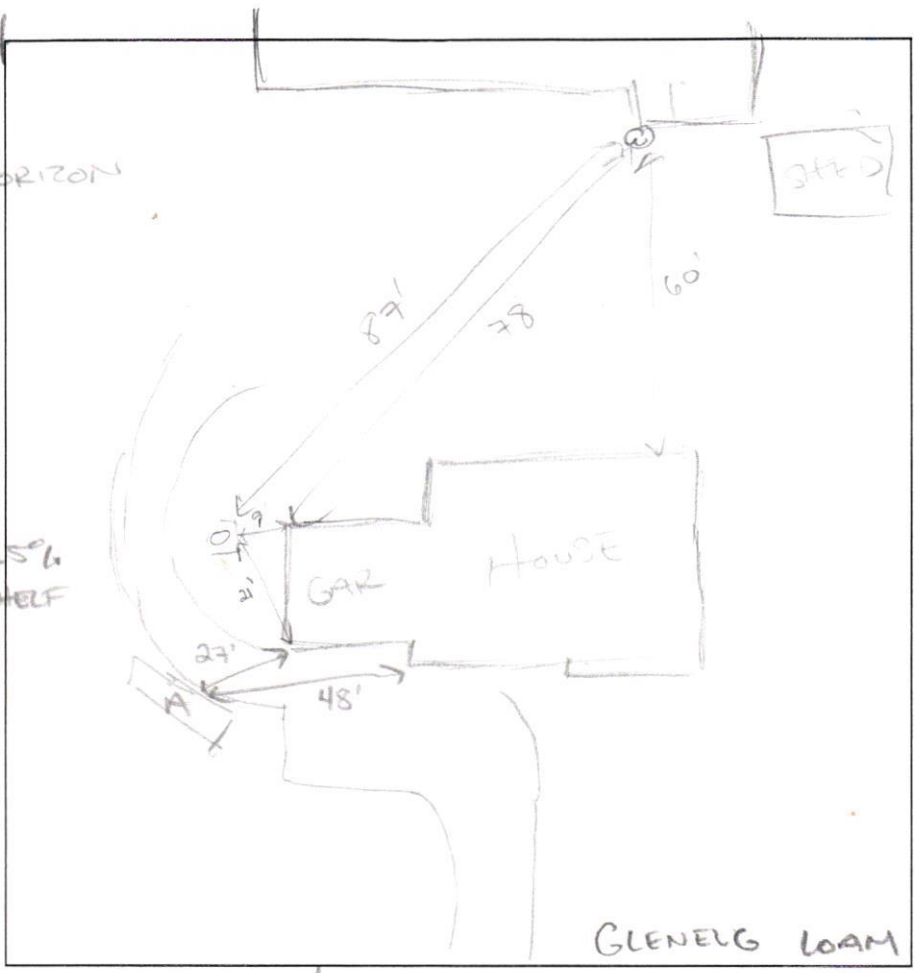

SHELF/BOTTOM

DATE	TEST #	DEPTH	START	BREAK 1" DROP	STOP 2" DROP	TIME OF 2ND INCH	P/F/H
12/23/2008	A	78" 14'	0:00	8:00	25:00	17:00	P

REMARKS EX TANK WATERLINE IS ABOVE INLET

SANITARIAN _____ BACKHOE _____ OTHERS _____

TEST HOLES USED IN SDA _____ AVG. PERC TIME _____ SQ. FT/BR 4

TRENCH WIDTH _____ INLET DEPTH _____ MAX. BOT DEPTH 9' EFFECTIVE S/W _____

$$\frac{4 \times 150}{0.6} = 1000$$

3	334	.5	167
2	500	.44	220