

HOWARD COUNTY  
PERMIT APPLICATION

PERMIT NUMBER

B10002819

Building Address 689 West Waterville Rd  
Mount Airy MD 21771

Suite/Apt. #: \_\_\_\_\_ SDP/WP/Petition #: \_\_\_\_\_

Census Tract \_\_\_\_\_ Subdivision \_\_\_\_\_

Section \_\_\_\_\_ Area \_\_\_\_\_ Lot 41

Tax Map \_\_\_\_\_ Parcel \_\_\_\_\_ Grid \_\_\_\_\_

Zoning \_\_\_\_\_ Map Coordinates \_\_\_\_\_ Lot Size \_\_\_\_\_

Existing Use SFD

Proposed Use SFD

Estimated Construction Cost \$ \$85,000.

Description of Work Inlaw sewer 22'x28'  
10x12 patch

Occupant or Tenant Rick Perry

Contact Name Rick Perry

Address 689 West Waterville Rd.

City MT. State \_\_\_\_\_ Zip Code \_\_\_\_\_

Phone \_\_\_\_\_ Fax \_\_\_\_\_

Property Owner's Name Rick Perry  
Address 689 West Waterville Rd  
City MT Airy State MD Zip Code \_\_\_\_\_  
Home Phone \_\_\_\_\_ Work Phone \_\_\_\_\_  
Applicant's Name & Mailing Address, (if other than stated herein): \_\_\_\_\_

Phone \_\_\_\_\_ Fax \_\_\_\_\_

Contractor Company Viking Development

Contact Person Curtis Cumberland

Address 815 Wood River Dr

City Sperryville State MD Zip Code 21784

License No. 120643

Phone 301252-1122 Fax \_\_\_\_\_

Engineer or Architect Company CADWORKS

Contact Person Dennis Repolge

Address 332 West Patrick St.

City Fredrick State MD Zip Code 21701

Phone \_\_\_\_\_ Fax \_\_\_\_\_

BUILDING DESCRIPTION - COMMERCIAL

Building Characteristics

Height: \_\_\_\_\_

No. of stories: \_\_\_\_\_

Gross area, sq. ft. per floor: \_\_\_\_\_

Use group: \_\_\_\_\_

Construction type: \_\_\_\_\_

Reinforced Concrete \_\_\_\_\_

Structural Steel \_\_\_\_\_

Masonry \_\_\_\_\_

Wood Frame \_\_\_\_\_

State Certified Modular \_\_\_\_\_

Utilities

Water Supply: \_\_\_\_\_

Public \_\_\_\_\_

Private \_\_\_\_\_

Sewage Disposal: \_\_\_\_\_

Public \_\_\_\_\_

Private \_\_\_\_\_

Electric Yes ☐ No ☐

Gas Yes ☐ No ☐

Heating System: \_\_\_\_\_

Electric ☐ Oil ☐

Natural Gas ☐

Propane Gas ☐

Sprinkler system: N/A ☐

Full \_\_\_\_\_

Partial \_\_\_\_\_

Other Suppression \_\_\_\_\_

# of Heads \_\_\_\_\_

BUILDING DESCRIPTION - RESIDENTIAL

Building Characteristics

SF Dwelling ☐ SF Townhouse ☐

Depth \_\_\_\_\_ Width \_\_\_\_\_

1<sup>st</sup> floor: 28' x 22'

2<sup>nd</sup> floor: \_\_\_\_\_

Basement: 28' x 22'

Finished Basement ☐ Unfinished Basement ☐ Crawl

space ☐ Slab on Grade ☐

No. of Bedrooms 1

Multi-family dwellings: \_\_\_\_\_

No. of efficiency units: \_\_\_\_\_

No. of 1 BR units: \_\_\_\_\_

No. of 2 BR units: \_\_\_\_\_

No. of 3 BR units: \_\_\_\_\_

Other Structure: \_\_\_\_\_

Dimensions: \_\_\_\_\_

Footings: \_\_\_\_\_

Roof: \_\_\_\_\_

State Certified Modular \_\_\_\_\_

Manufactured Home \_\_\_\_\_

Utilities

Water Supply: \_\_\_\_\_

Public \_\_\_\_\_

Private ☒

Sewage Disposal: \_\_\_\_\_

Public \_\_\_\_\_

Private ☒

Electric Yes ☒ No ☐

Gas Yes ☐ No ☒

Heating System: \_\_\_\_\_

Electric ☒ Oil ☐

Natural Gas ☐

Propane Gas ☒

Sprinkler system: N/A ☒

NFPA #13D \_\_\_\_\_

NFPA #13R \_\_\_\_\_

Other: \_\_\_\_\_

THE UNDERSIGNED HEREBY CERTIFIES AND AGREES AS FOLLOWS: (1) THAT HE/SHE IS AUTHORIZED TO MAKE THIS APPLICATION; (2) THAT THE INFORMATION IS CORRECT; (3) THAT HE/SHE WILL COMPLY WITH ALL REGULATIONS OF HOWARD COUNTY WHICH ARE APPLICABLE THERETO; (4) THAT HE/SHE WILL PERFORM NO WORK ON THE ABOVE REFERENCED PROPERTY NOT SPECIFICALLY DESCRIBED IN THIS APPLICATION; (5) THAT HE/SHE GRANTS COUNTY OFFICIALS THE RIGHT TO ENTER ONTO THIS PROPERTY FOR THE PURPOSE OF INSPECTING THE WORK PERMITTED AND POSTING NOTICES.

Curtis Cumberland  
Applicant's Signature

CCUMBE5437@GMAIL.COM  
Email Address

Manager  
Title/Company

Curtis Cumberland  
Print Name

RECEIVED

SEP 07 2010

LICENSES & PERMITS

DIVISION

Checks payable to: DIRECTOR OF FINANCE OF HOWARD COUNTY  
\*\*PLEASE WRITE NEATLY AND LEGIBLY.\*\*

- FOR OFFICE USE ONLY -

DPZ SETBACK INFORMATION

Front: \_\_\_\_\_

Rear: \_\_\_\_\_

Side: \_\_\_\_\_

Side St.: \_\_\_\_\_

All minimum setbacks met?

YES ☐ NO ☐

Is Entrance Permit Required?

YES ☐ NO ☐

Historic District?

YES ☐ NO ☐

Lot Coverage for New Town Zone

SDP/Red-line approval date \_\_\_\_\_

Filing fee \$ 25.00

Permit fee \$ \_\_\_\_\_

Excise tax \$ \_\_\_\_\_

Add'l per fee \$ \_\_\_\_\_

TOTAL FEES \$ \_\_\_\_\_

Sub-total paid \$ \_\_\_\_\_

Balance due \$ \_\_\_\_\_

Check # 6340

Validation # 217539

Accepted by \_\_\_\_\_

AGENCY DATE SIGNATURE APPROVAL

Land Development, DPZ

State Highways

Building Officials

Dev. Engineering, DPZ

Health

Fire Protection

Is Sediment Control approval required prior to issuance?

YES ☐ NO ☐

CONTINGENCY CONSTRUCTION START: ☐

ONE STOP SHOP: ☐

Distribution of Copies

White: Building Officials


Green: LDD, DPZ

Yellow: DED, DPZ


Pink: Health

Gold: SHA


T:\Operations\Updated forms

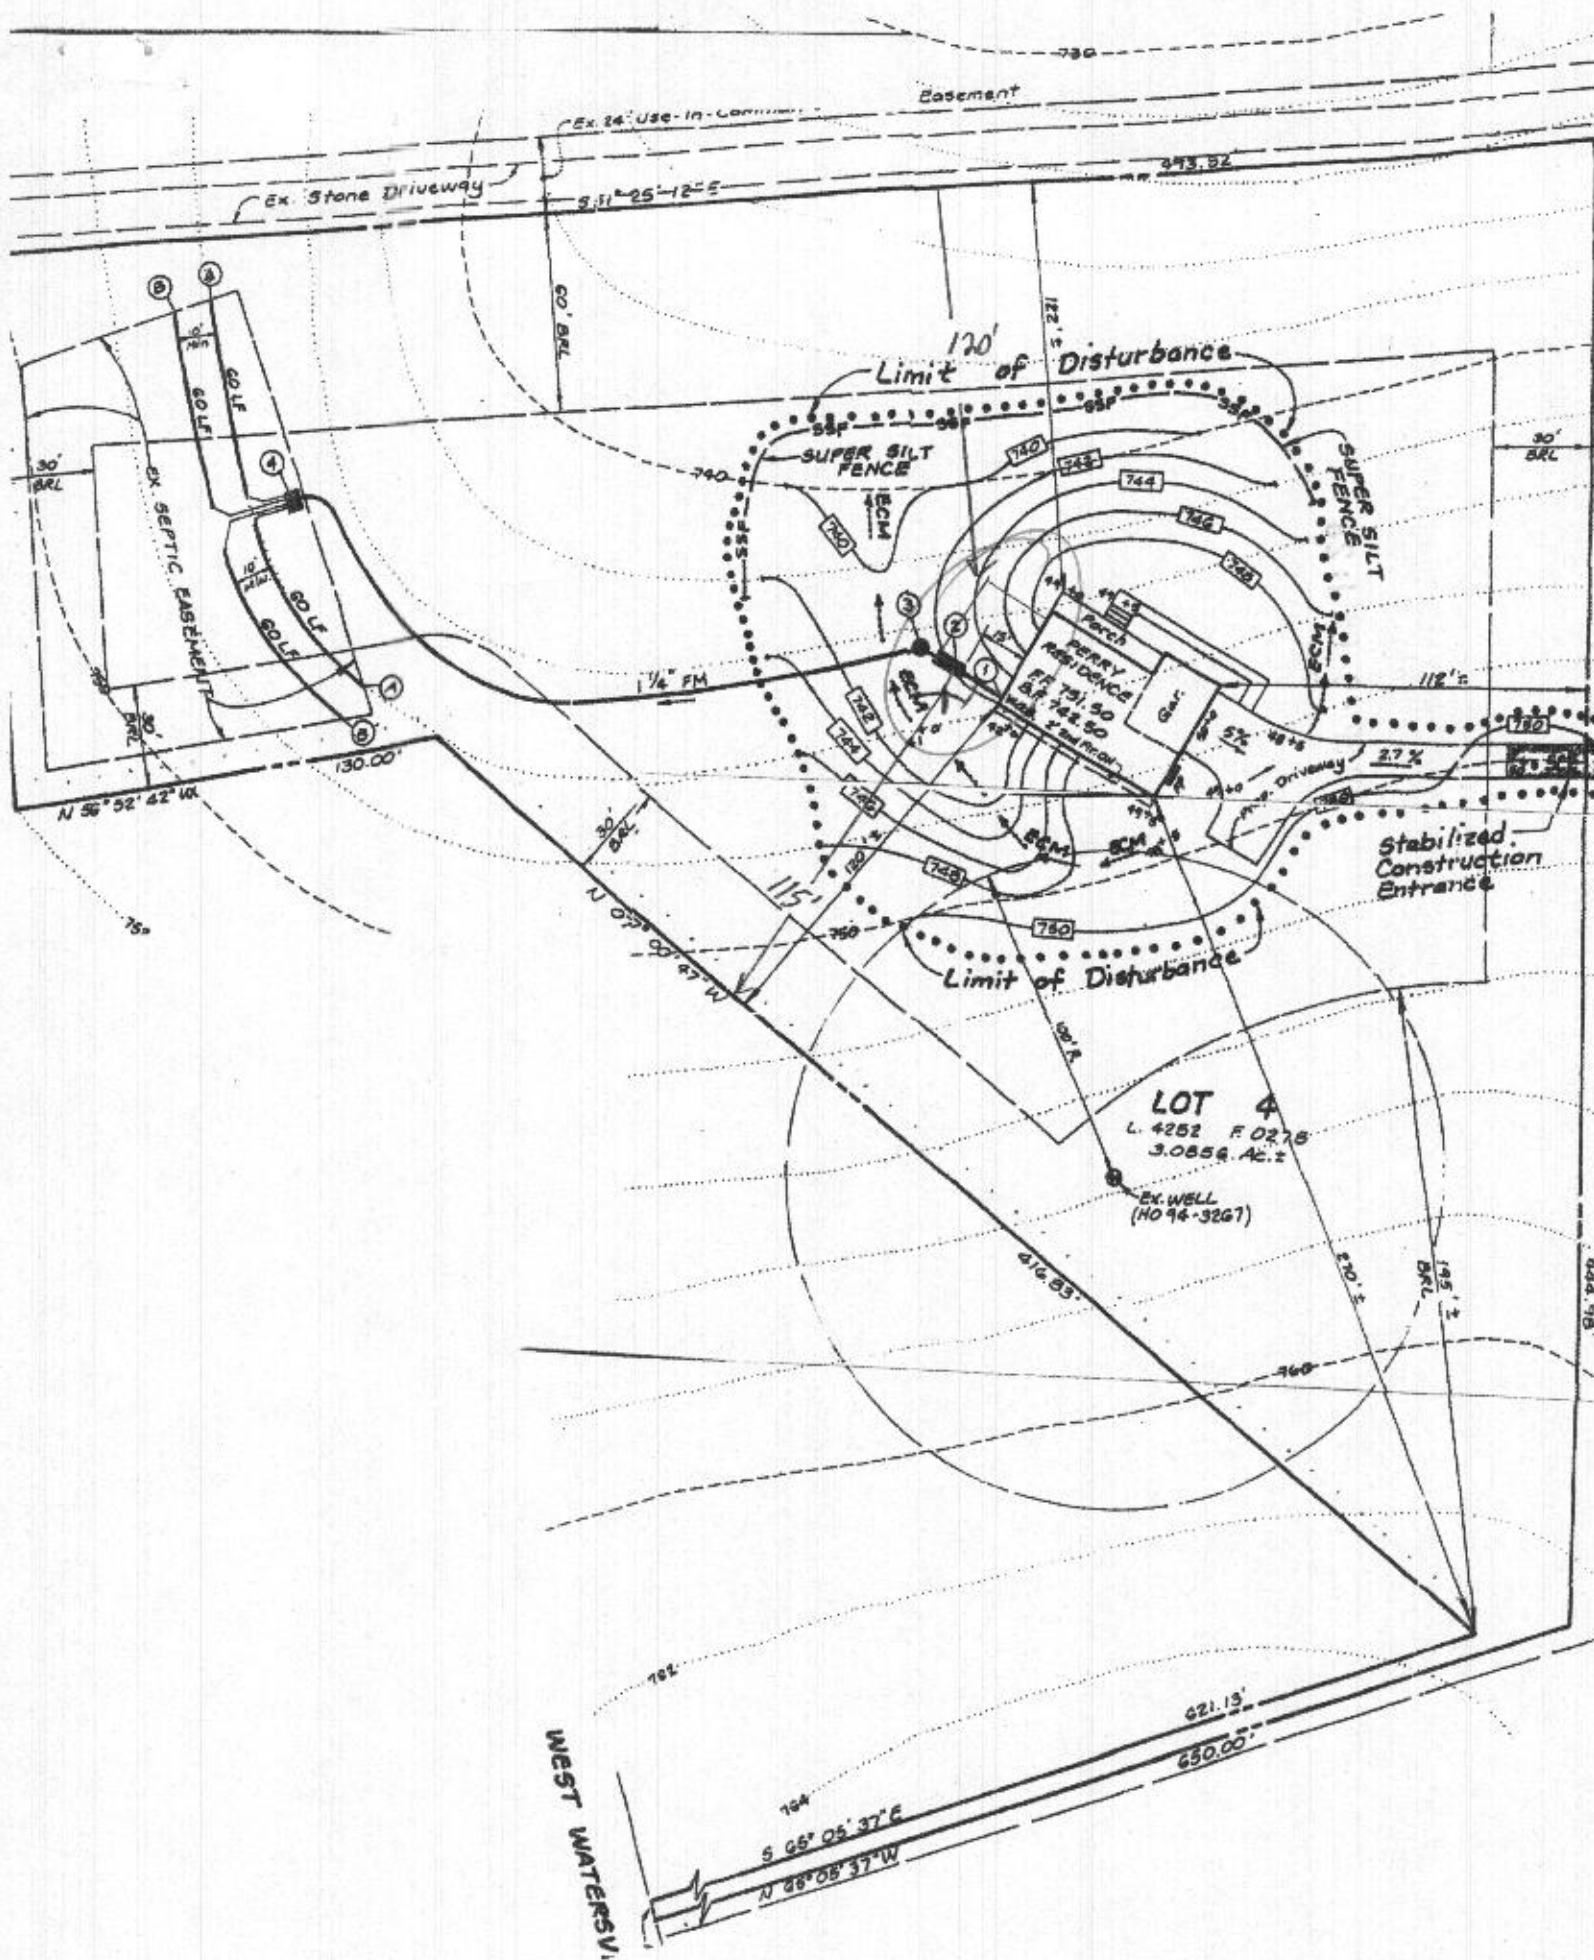



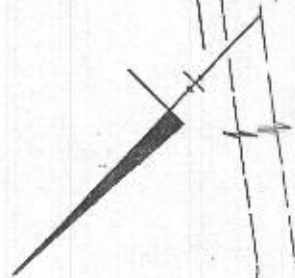

ROAD

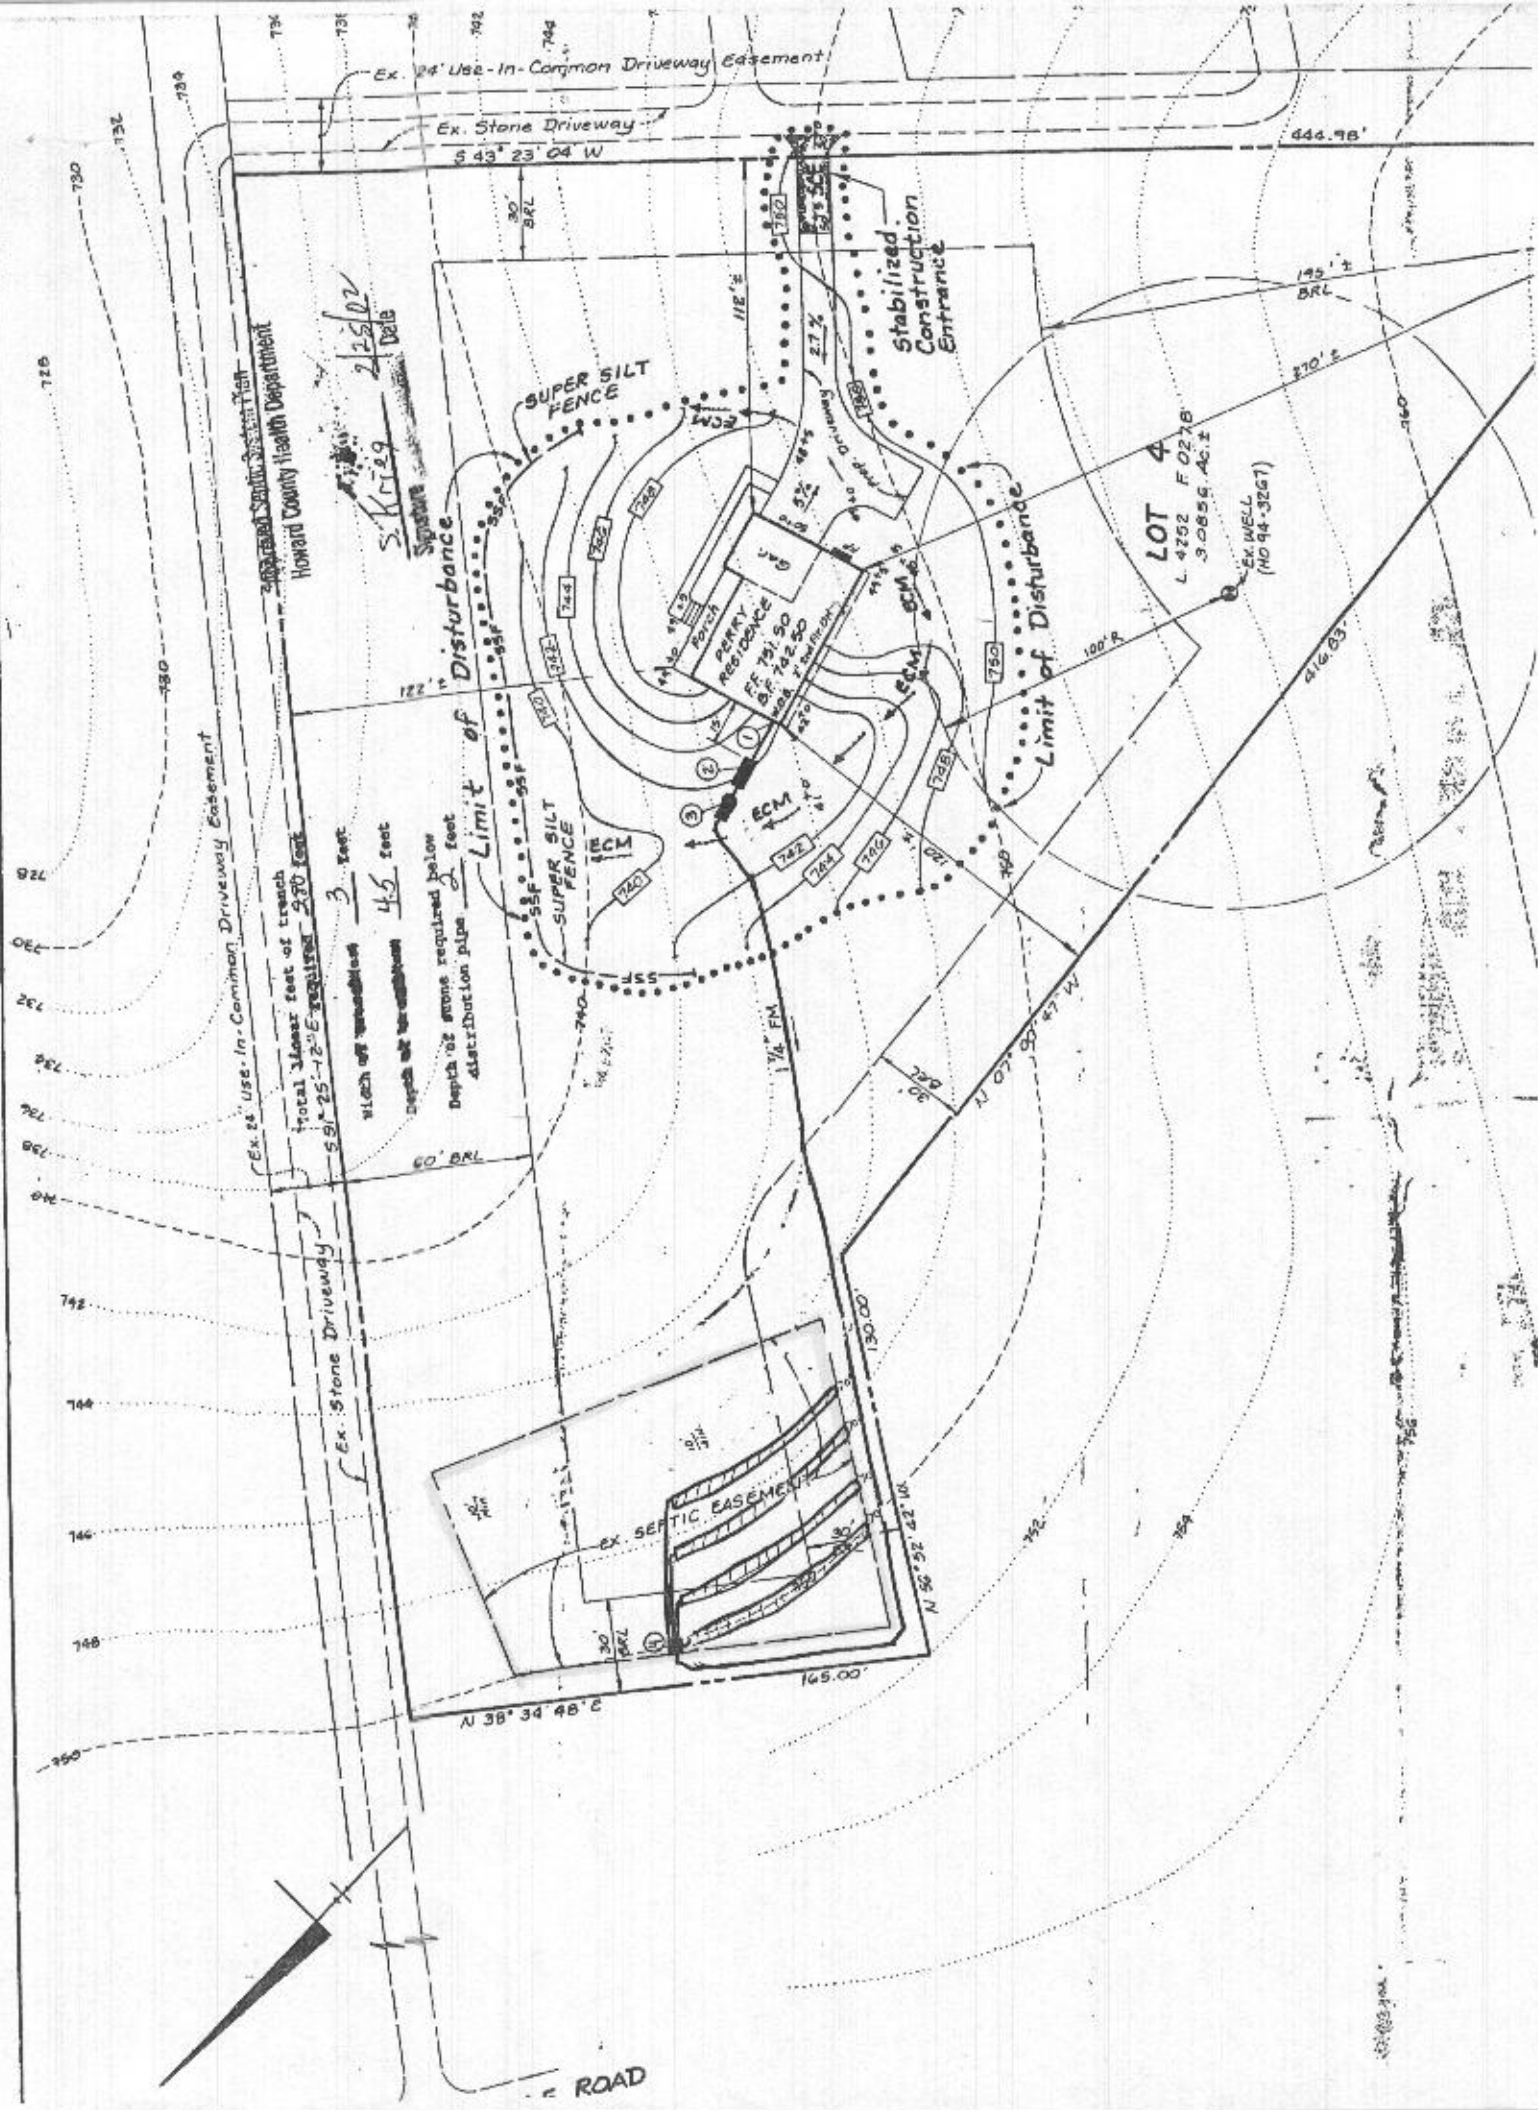

Approved: *[Signature]*  
Howard County Health Department

S. Krieger 2/25/02  
Date

Total linear feet of trench  
59' 12" - 12" E required 230 feet  
Width of trench 3 feet  
Depth of trench 4.5 feet  
Depth of stone required below  
distribution pipe 2 feet

