

APPLICATION

PERCOLATION TESTING

A _____

P _____

HOWARD COUNTY HEALTH DEPARTMENT

BUREAU OF ENVIRONMENTAL HEALTH

3525-H ELLICOTT MILLS DRIVE/ELLICOTT CITY, MARYLAND 21043
TELEPHONE: 313-2640

DISTRICT _____

DATE _____

TO: THE COUNTY HEALTH OFFICER
ELLICOTT CITY, MARYLAND

I HEREBY APPLY FOR THE NECESSARY TEST PRIOR TO APPLICATION FOR PERMIT TO CONSTRUCT (OR RECONSTRUCT) A SEWAGE DISPOSAL SYSTEM.

PROPERTY OWNER Debra and William Anderson
Brenda Tompkins-McDade
C/O Trinity Quality Homes Inc

ADDRESS 7320 George Drive PHONE (410) 531-6444
Columbia MD 21044

AGENT OR PROSPECTIVE BUYER Trinity Quality Homes Inc
7320 George Drive

ADDRESS Columbia MD 21044 PHONE (410) 531-6444

PROPERTY LOCATION: * THE PRESERVE AT WAVERLY WOODS
Subdivision on Shadow Shade Lots 1+2+ 7th Parcel

SUBDIVISION ad Highway at Greenwood Farm LOT NO. (4)

ROAD AND DESCRIPTION Windsor Road and Route 99 (Frederick Road)

TAX MAP 10 PARCEL # 36+102

SIZE OF LOT 1 ac TYPE BLDG. SFD
(SINGLE FAMILY DWELLING OR COMMERCIAL)

THE SYSTEM INSTALLED UNDER THIS APPLICATION IS ACCEPTABLE ONLY UNTIL PUBLIC FACILITIES BECOME AVAILABLE. I FULLY UNDERSTAND THE
FEE CONNECTED WITH THE FILING OF THIS PERC TEST APPLICATION IS NON-REFUNDABLE UNDER ANY CIRCUMSTANCES. I ALSO AGREE TO
COMPLY WITH ALL M.O.S.H.A. REQUIREMENTS IN TESTING THIS LOT.

[Signature]
(SIGNATURE OF APPLICANT)

APPROVED BY _____ FOR _____ DATE _____

DISAPPROVED BY _____ FOR _____ DATE _____

HOLD PENDING FURTHER TESTS _____

REASONS FOR REJECTION OR HOLDING _____

PERCOLATION TEST PLAT/PRELIMINARY PLAT - TITLE OR I.D. # _____ DATE _____

SITE DEVELOPMENT PLAN/FINAL PLAT - TITLE OR I.D. # _____ DATE _____

THIS IS NOT A PERMIT

COUNTY #

SOIL PROFILE

125/124

0' topsoil
org brn
clm
3' tan
sa mica
lm
15%
rock

123


0' topsoil
6" org brn
clm
3' tan
sa mica
lm
20-25%
rock

121

0' topsoil
1' org brn
clm
3' 1+ to
med
brn
sa mica
lm
5-10% rock
11' possible
mottles
14'

SOIL PROFILE

0'

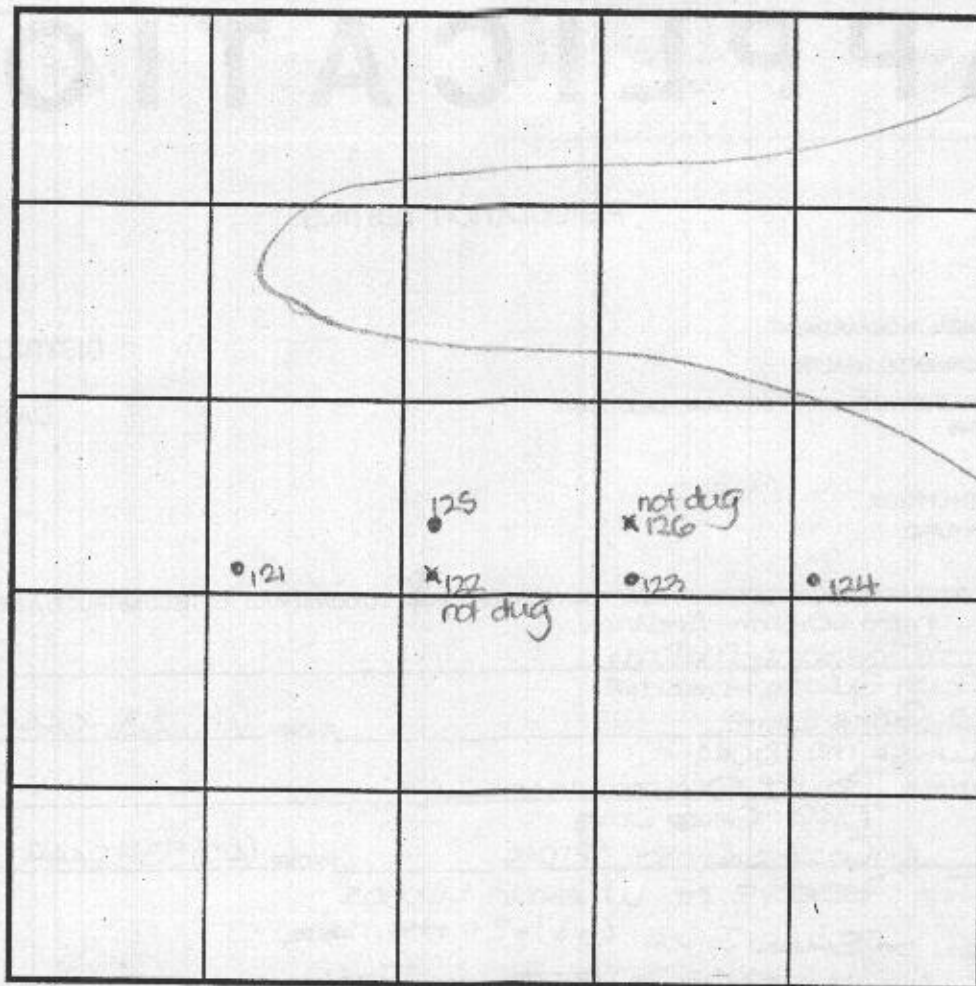

INDICATE NORTH - NAME ADJOINING ROADWAY AS BASE LINE.

Old Frederick Road

DATE	TEST NO.	DEPTH	PRE-WET		TEST - 1" DROP		TIME
			START	STOP	START	STOP	
1-4-01	125	3.0' S	10:23	10:24	10:24	10:27	3
		11.0' D	Visual - see profile				OK
	123	11.5' D	Visual - see profile				OK
	124	2.5' S	10:33	10:34	10:34	10:36	2
		12.5' D	Visual - see profile				OK
	121	14.0' D	Visual - see profile				OK

REMARKS

holes tested as staked

TYPE OF SOIL

TESTED BY

DKC

ALSO PRESENT

C. Zepp, T. Feaga

TRENCH DESIGN DATA: AVERAGE PERCOLATION TIME

TRENCH WIDTH

INLET DEPTH

MAXIMUM BOTTOM DEPTH

SQ. FT./BEDROOM

APPLICATION

PERCOLATION TESTING

A _____

P _____

HOWARD COUNTY HEALTH DEPARTMENT

BUREAU OF ENVIRONMENTAL HEALTH

3525-H ELLICOTT MILLS DRIVE/ELLICOTT CITY, MARYLAND 21043
TELEPHONE: 313-2640

DISTRICT _____

DATE _____

TO: THE COUNTY HEALTH OFFICER
ELLICOTT CITY, MARYLAND

I HEREBY APPLY FOR THE NECESSARY TEST PRIOR TO APPLICATION FOR PERMIT TO CONSTRUCT (OR RECONSTRUCT) A SEWAGE DISPOSAL SYSTEM.

PROPERTY OWNER Debra and William Anderson
Branda Tompkins-McDade
C/O TRIPLE QUALITY HOMES INC

ADDRESS 7320 Grace Drive PHONE (410) 531-6444
Columbia MD 21044

AGENT OR PROSPECTIVE BUYER TRIPLE QUALITY HOMES INC
7320 Grace Drive

ADDRESS Columbia MD 21044 PHONE (410) 531-6444

PROPERTY LOCATION: * THE PRESERVE AT WAVERLY WOODS
Subdivision on Shadow Shade Lots 1+2+ Pres. Parcel

SUBDIVISION AD HICHMONT AT BREEZEWOOD Farms LOT NO. (4)

ROAD AND DESCRIPTION WINDSOR ROAD AND ROUTE 99 (FREDERICK ROAD)

TAX MAP 10 PARCEL # 36+102

SIZE OF LOT 1 ac TYPE BLDG. SFD
(SINGLE FAMILY DWELLING OR COMMERCIAL)

THE SYSTEM INSTALLED UNDER THIS APPLICATION IS ACCEPTABLE ONLY UNTIL PUBLIC FACILITIES BECOME AVAILABLE. I FULLY UNDERSTAND THE
FEE CONNECTED WITH THE FILING OF THIS PERC TEST APPLICATION IS NON-REFUNDABLE UNDER ANY CIRCUMSTANCES. I ALSO AGREE TO
COMPLY WITH ALL M.O.S.H.A. REQUIREMENTS IN TESTING THIS LOT.

[Signature]
(SIGNATURE OF APPLICANT)

APPROVED BY _____ FOR _____ DATE _____

DISAPPROVED BY _____ FOR _____ DATE _____

HOLD PENDING FURTHER TESTS _____

REASONS FOR REJECTION OR HOLDING _____

PERCOLATION TEST PLAT/PRELIMINARY PLAT - TITLE OR I.D. # _____ DATE _____

SITE DEVELOPMENT PLAN/FINAL PLAT - TITLE OR I.D. # _____ DATE _____

THIS IS NOT A PERMIT

COUNTY #

SOIL PROFILE

0' 119
 1' topsoil
 org brn
 cl lm
 2' 2.5'
 1+ brn
 sa mica
 lm
 12' 15%
 rock

0' 130 (117)


1' topsoil
 org brn
 cl lm
 3' 1+ org
 brn
 ea mica
 lm
 12.5' 5-10%

0' 118

1' topsoil
 org brn
 cl lm
 3' 1+ brn
 sa mica
 lm
 12' 5-10%

SOIL PROFILE

0'

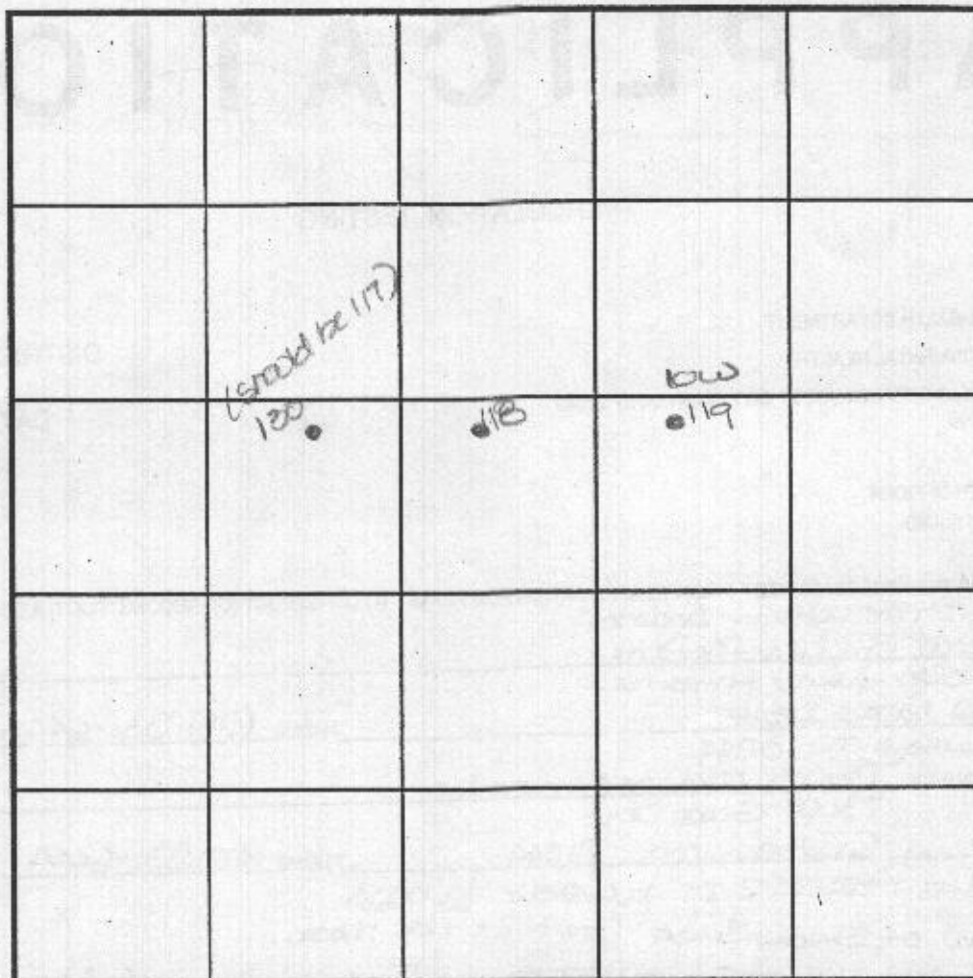

INDICATE NORTH - NAME ADJOINING ROADWAY AS BASE LINE.

DATE	TEST NO.	DEPTH	PRE-WET		TEST - 1" DROP		TIME
			START	STOP	START	STOP	
1-3-01	119	2.0'S	3:06	3:08	3:08	3:15	7
		12.0'D visual	-see profile				OK
	130 (117)	3.0'S	3:14	3:17	3:17	3:22	5
		12.5'D visual	-see profile				OK
	118	12.0'D visual	-see profile				OK

REMARKS holes tested as stated

TYPE OF SOIL _____

TESTED BY DKC ALSO PRESENT Czepp, T. Feaga

TRENCH DESIGN DATA: AVERAGE PERCOLATION TIME _____ TRENCH WIDTH _____

INLET DEPTH _____ MAXIMUM BOTTOM DEPTH _____ SQ. FT./BEDROOM _____

COUNTY #

SOIL PROFILE

0' 332

topsoil

org bmn
clm

2.5' H org
bmn
sa mica
lm

30%+
rock

11'

SOIL PROFILE

0'

INDICATE NORTH - NAME ADJOINING ROADWAY AS BASE LINE.

DATE	TEST NO.	DEPTH	PRE-WET		TEST - 1" DROP		TIME
			START	STOP	START	STOP	
5-15-01	332	3.0' S	11:01 ₃	11:02 ₃	11:02 ₃	11:04 ₃	1 1/2
			10:59 ₃	11:00 ₃	11:00 ₃	11:01 ₃	1
		11.0' D	Visual	-See profile			OK
	(Repair)	3.0' S	2:34 ₃	2:37 ₃	2:37 ₃	2:41 ₃	4
		7.0' M	2:28	2:31 ₃	2:31 ₃	2:34 ₃	3
	333	HOLE DATA NOT FOUND					

REMARKS hole tested as staked

TYPE OF SOIL _____

TESTED BY DWCALSO PRESENT C. Zapp, T. Feagya

TRENCH DESIGN DATA: AVERAGE PERCOLATION TIME _____

TRENCH WIDTH _____

INLET DEPTH _____

MAXIMUM BOTTOM DEPTH _____

SQ. FT./BEDROOM _____

OLD FREDERICK ROAD
ROUTE 99
(80' ROW)
MINOR ARTERIAL

EX ABANDONED WELL

EX ABANDONED WELL

LOT 11
66116 SF
65dbd LINE
UNUTILIZED
R=5430.46 L=801.77

LOT 12
43880 SF
EX WELLS TO
BE ABANDONED
253.56'

SWM FACILITY

LOT 10
52561 SF

LOT 4
51927 SF

LOT 15
49480 SF

LOT 14
44335 SF

LOT 13
57751 SF

PROP. PUBLIC ACCESS PLACE
40' R/W 18' PAVING

NON-BUILDABLE
PRESERVATION
PARCEL 'B'
179,897 SF

E STREAM

M1D2
M1D3

IN-COMMUNITY
EASTMAN
LOTS 3, 5, 6 AM
LOT 11

PROP 24 US

10' BRL

10' BRL

LOT 13
57751 SF

LOT 14
44335 SF

LOT 15
49480 SF

LOT 10
52561 SF

LOT 4
51927 SF

IN-COMMUNITY
EASTMAN
LOTS 3, 5, 6 AM
LOT 11

PROP 24 US

10' BRL

10' BRL

