


SITE INSPECTION SHEET

OWNER: _____ PHONE #: (410) 992-8105
 ADDRESS: 14049 Triadelphia Rd CONTRACTOR: _____
 Glenary MD 21737 WELL TAG #: _____
 SUBDIVISION: _____ LOT: 1 COUNTY #: _____
 PROPOSAL: Construct a Bed + Bath on existing house
 - unfinished Basement

LOCATION DIAGRAM

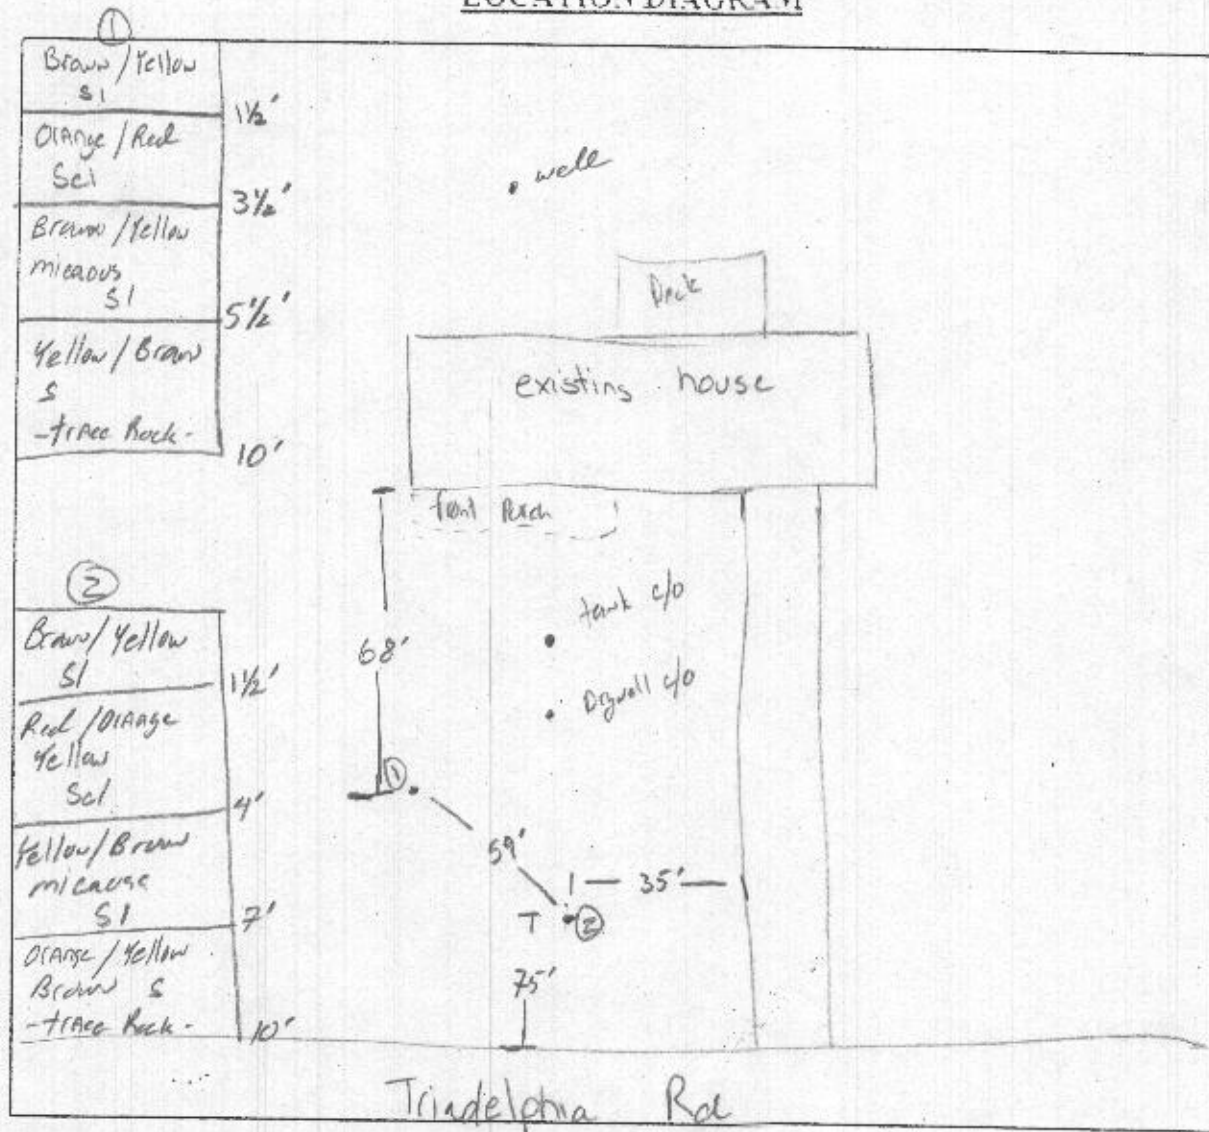

COMMENTS: Both the septic tank + Auger seem to be functioning OK. Aug (2) hand auger holes to identify soils for future.

DATE: 7/12/04

INSPECTOR: KJB