

PUB. SEWER STATUS VERIFIED BY _____

ISSUE DATE: 7/16/04

APPROVAL DATE: _____

PERMIT

P 520782

A UPGRADE

ON-SITE SEWAGE DISPOSAL SYSTEM HOWARD COUNTY HEALTH DEPARTMENT BUREAU OF ENVIRONMENTAL HEALTH

BRS Electrical Contractor, LLC IS PERMITTED TO INSTALL ☐ ALTER ☒

ADDRESS: 14049 Triadelphia Rd., Glenelg 21737 PHONE NUMBER: 410-992-8105

SUBDIVISION: _____ LOT NUMBER: _____

ADDRESS: 14049 Triadelphia Road PROPERTY OWNER: Bryan Sisk

SEPTIC TANK CAPACITY (GALLONS): 1000

PUMP CHAMBER CAPACITY (GALLONS): _____

NUMBER OF BEDROOMS: _____

SQUARE FEET PER BEDROOM: _____

LINEAR FEET OF TRENCH REQUIRED: _____

TRENCHES:	Trench to be _____ feet wide. Inlet _____ feet below original grade. Bottom maximum depth _____ feet below original grade. Effective area begins at _____ feet below original grade. _____ feet of stone below distribution pipe.
LOCATION:	
PURPOSE:	Adding a 1000 gallon tank to existing system. Call for inspection when ground is opened so sanitarian can recommend repair.

PLANS APPROVED: Keven J. Bell DATE: 7/12/04

NOTE: PERMIT VOID AFTER 2 YEARS

NOTE: CONTRACTOR RESPONSIBLE FOR SCHEDULING A PRE-CONSTRUCTION INSPECTION FOR ALL INSTALLATIONS


NOTE: WATERTIGHT SEPTIC TANKS REQUIRED

NOTE: ALL PARTS OF SEPTIC SYSTEM SHALL BE 100 FEET FROM ANY WATER WELL

NOTE: MANHOLE RISERS REQUIRED ON ALL SEPTIC TANKS AND PUMP CHAMBERS

**NEITHER THE HOWARD COUNTY COUNCIL OR THE HEALTH DEPARTMENT IS
RESPONSIBLE FOR THE SUCCESSFUL OPERATION OF ANY SYSTEM
PERMITTEE RESPONSIBLE FOR OBTAINING FINAL APPROVAL ON THIS PERMIT
CALL 410-313-2640 FOR INSPECTION OF SEPTIC SYSTEM**

NOT TO SCALE

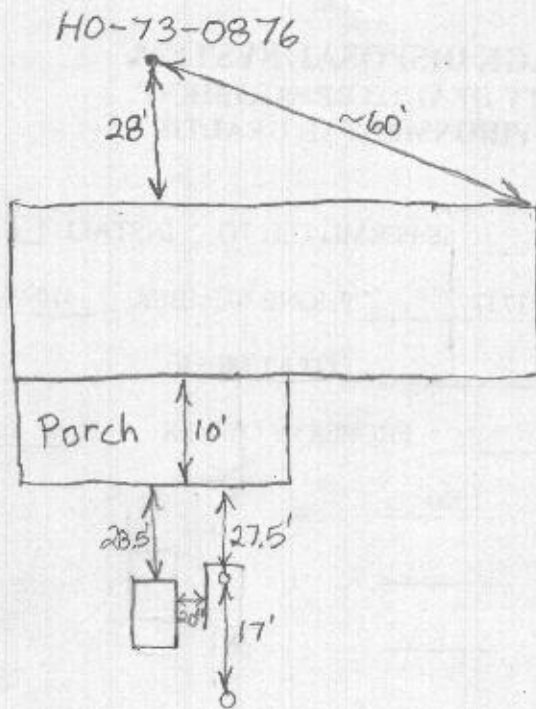

TRENCH/DRAINFIELD DATA		
WIDTH	INLET	BOTTOM
NUMBER OF TRENCHES		
TOTAL LENGTH		
ABSORPTION AREA		
DISTRIBUTION BOX LEVEL		
DISTRIBUTION BOX BAFFLE		
DISTRIBUTION BOX PORT		

SEPTIC TANK DATA	
SEPTIC TANK 1 LEVEL	✓
Traffic Capacity	1000 GAL
Bearing	Top
TANK LID DEPTH	2'-2.5'
BAFFLES	
BAFFLE FILTER	
MANHOLE LOC	
6" PORT LOC	
WATERTIGHT TEST	No
SEPTIC TANK 2 LEVEL	Existing
CAPACITY	
SEAM LOC	
TANK LID DEPTH	
BAFFLES	
BAFFLE FILTER	
MANHOLE LOC	None
6" PORT LOC	Front
WATERTIGHT TEST	No

PRE-CONSTRUCTION 7/20/04 A 1000 gallon traffic bearing Babylon septic tank was set next to the existing tank. The homeowner said that they will redirect the line from the house to the new tank and then from the new tank to the old tank. BB

FINAL INSPECTOR _____ DATE OF APPROVAL _____