

REVISED

Date: 3-22-72

Comments: Revise tank location


HOUSE SITE LOT 4

REZ PROPERTY,
LOTS 1 THRU 4

ZONING: CC-250 PARCEL: 75
TAX MAP 59 CSD 0209 BOARD COUNTY, INDIANA
1960 DISTRICT DATE: NOVEMBER, 2009
SCALE: 1"=60'

FISHER, COLLINS & CARTER, INC.
CIVIL ENGINEERING, SURVEYING & LAND SURVEILLANCE
14722 BARBERSBURG AVENUE, #100
MICHIGAN CITY, INDIANA 46360
(410) 431-2075

1" = 60'

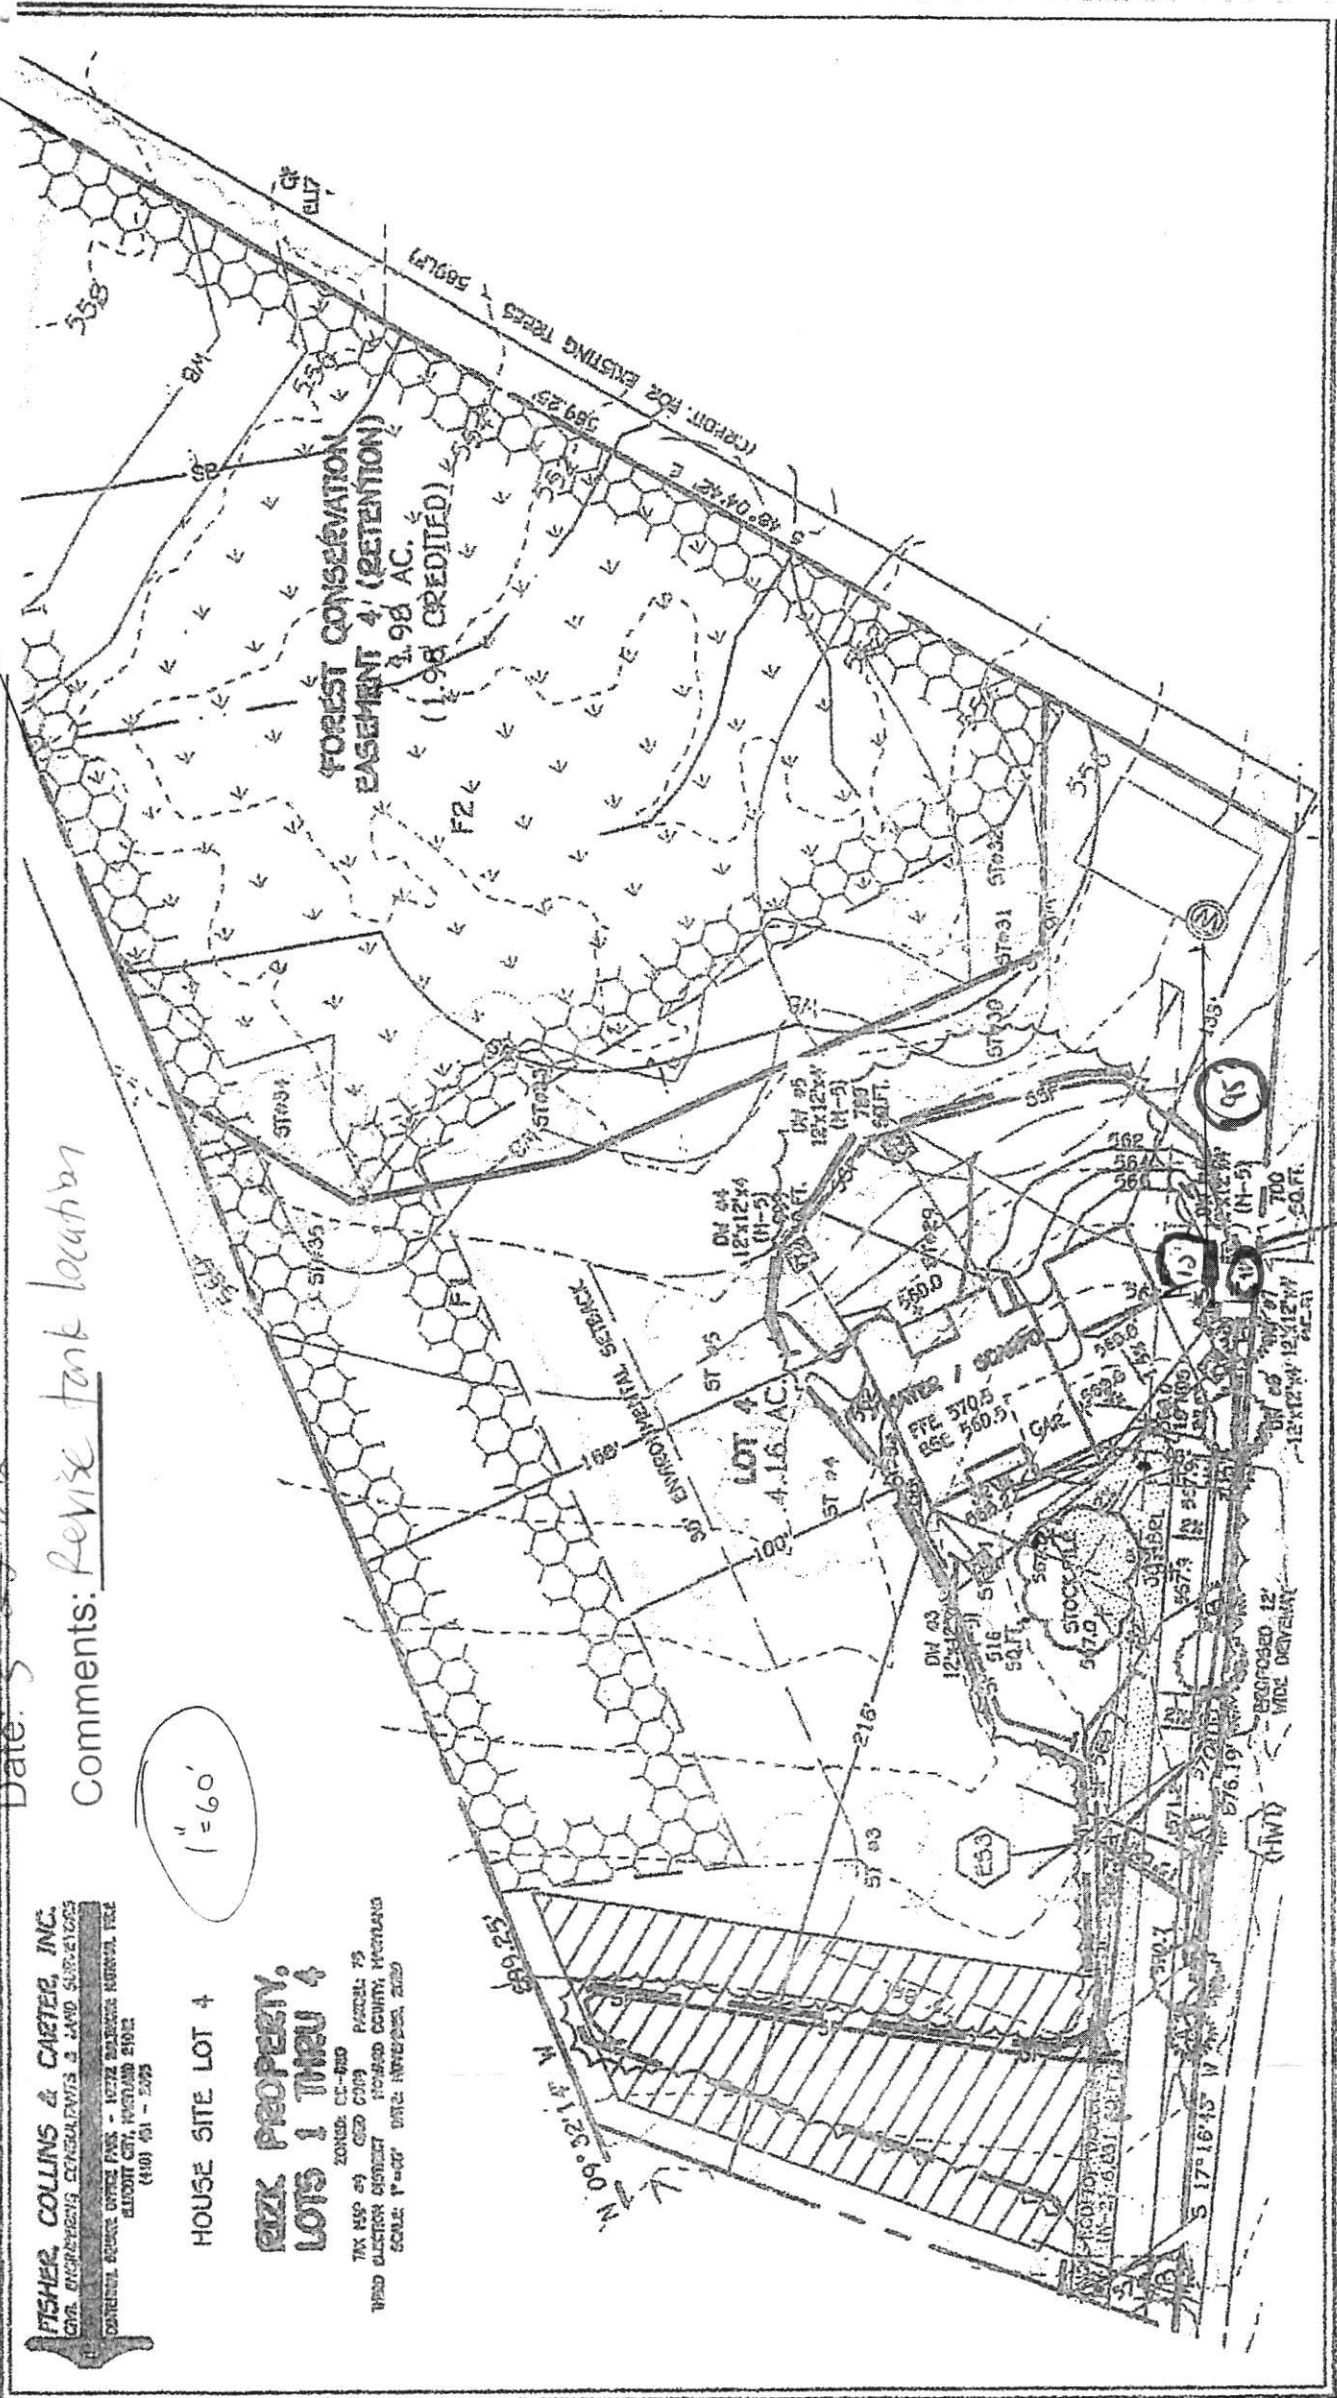

Menu Save Reset Cancel Help

Record Detail * (This section is required.)

| | | |
|--|---------------|-------------|
| Permit Type | Permit Number | Opened Date |
| Building/Residential/Misc/Tanks | B21004079 | 10/23/2021 |
| Description of Work | | |
| SFD/ INSTALL (1) 1,000 GALLON UNDERGROUND PROPANE TANK/ *3.22.22 AMENDMENT REQUEST TO RELOCATE TANK* | | |

[check spelling](#)

Address * (This section is required.)

Search Reset Clear Get Parcel & Owner

| | | | |
|------------|-------------|--------------|--------------|
| Street # | Street Name | Street Type | |
| 1433 | UNDERWOOD | RD | |
| Unit Type | Unit # | X Coordinate | Y Coordinate |
| --Select-- | | -76.97866 | 39.33637 |
| City | State | Zip Code | Primary |
| SYKESVILLE | MD | 21784 | Yes |

Parcel * (This section is required.)

Search Reset Clear Get Address & Owner

| | | | | | | | | | | | | |
|--|--|--|--|--|--|--|--------|-------------|------------|----------------|-----------------|-----------|
| GIS ID * | | | | | | | Parcel | Parcel Area | Land Value | Improved Value | Exemption Value | Plan Area |
| 11059408 | | | | | | | 75 | 4 | 207000 | 0 | 0 | RURAL |
| Legal Description | | | | | | | | | | | | |
| LOT 4 4 004 A []1433 UNDERWOOD RD[]RIZK PROPERTY | | | | | | | | | | | | |

[check spelling](#)

| | | | | | | | |
|---|-----------------|---|--------------|-----------------|-----------------|-------|----------|
| Block | Lot | Census Tract | Council Dist | Inspection Dist | Supervisor Dist | Map # | DAP Zone |
| | 4 | 603000 | 5 | | | | |
| Plan Area | State Tax Id | Subdivision Name | | | | | |
| | 1403601464 | Rizk Property | | | | | |
| Section | Area | Tax Map | | | | | |
| | | 9 | | | | | |
| Grid | Zoning District | ADC Map | | | | | |
| 9-9 | RC-DEO | 4693-D7 | | | | | |
| SDP No. | Final Plan No. | WP File No. | | | | | |
| | ECP-17-058 | | | | | | |
| Record Plat No. | WS Contract No. | FDP No. | Primary | | | | |
| 24871-2487 | | | Yes | | | | |
| Owner Occupied | Year Built | Historic District | | | | | |
| <input type="radio"/> Yes <input checked="" type="radio"/> No | | <input type="radio"/> Yes <input checked="" type="radio"/> No | | | | | |
| Historic District Registry No. | Stat Area | Flood Plain | | | | | |
| | 3-01 | <input type="radio"/> Yes <input checked="" type="radio"/> No | | | | | |
| Building No | | | | | | | |
| | | | | | | | |

Owner * (This section is required.)

Search Reset Clear

| | | |
|---------------------|------------|---------------|
| Name * | | |
| VIKING CUSTOM HOMES | | |
| Address Line 1 | | |
| 815 WINDRIVER DR | | |
| Address Line 2 | | |
| Address Line 3 | | |
| Mail City | Mail State | Mail Zip Code |
| SYKESVILLE | MD | 21784 |
| Phone | Primary | |
| 410-977-2188 | Yes | |
| E-mail | | |
| Cell Number | Fax Number | |
| | | |

Professionals (This section is not required.)

Search Reset Clear

| | | | |
|----------------|----------------------------|-------------|------------|
| License # * | Business Name | | |
| 2010060003 | THOMPSONGAS, LLC | | |
| License Type * | First Name | Middle Name | Last Name |
| Propane Gs | J RANDALL | | THOMPSON |
| Primary | Address Line 1 | | |
| Yes | 5260 WESTVIEW DR SUITE 200 | | |
| | Address Line 2 | | |
| | City | State | ZIP Code |
| | FREDERICK | MD | 21703 |
| | Phone 1 | Phone 2 | Fax |
| | 3013028054 | | 2402153272 |
| | E-mail | | |
| | LICENSE@THOMPSONGAS.COM | | |

Applicant (This section is not required.)

Search As Owner As Lic. Prof As Contact

| | | | |
|--------------|-------------------------------|-------|-----------|
| Type * | First Name | MI | Last Name |
| Applicant | Anthony | | Durso |
| Relationship | Full Name | | |
| Applicant | Anthony Durso | | |
| Primary | Organization Name | | |
| Yes | ThompsonGas | | |
| | Street Address | | |
| | 1800 Sparrows Point Boulevard | | |
| | Address Line 2 | | |
| | City | State | Zip Code |
| | Sparrows Point | MD | 21219 |
| | Phone | Cell | Fax |
| | 443-826-0506 | | |
| | E-mail * | | |
| | adurso@thompsongas.com | | |

Addtl Info

| | | | |
|-------------------------------------|-----------------|-----------------------|--------------|
| Est Construction Cost * | Housing Units * | Number of Buildings * | Public Owned |
| 7000 | 0 | 0 | No |
| Construction Type | | | |
| 101 - Single Family Houses Detached | | | |

TANK INFORMATION

RESIDENTIAL TANK INFORMATION

| | | | | |
|---|-----------------------------|---|---|------------------------|
| Capital Project-No Fee * | Capital Project Number | Fee Exempt * | Roadside Tree Project Permit * | Roadside Tree Permit # |
| <input type="radio"/> Yes <input checked="" type="radio"/> No | | <input type="radio"/> Yes <input checked="" type="radio"/> No | <input type="radio"/> Yes <input checked="" type="radio"/> No | |
| Existing Use | Number of Tanks Installed * | Number of Tanks Removed * | | |
| SFD | 1 | 0 | | |
| Water Supply | Sewage Disposal | Expiration Date | Relocate Existing Tank * | |
| Private | Private | 9/19/2022 | 0 | |

PAYMENT INFORMATION

| | | | | | |
|---------|---------|---------|---------|------------|-------------|
| Check 1 | Payee 1 | Check 2 | Payee 2 | SAP Doc No | SAP Entered |
| | | | | | |

Submit Cancel