


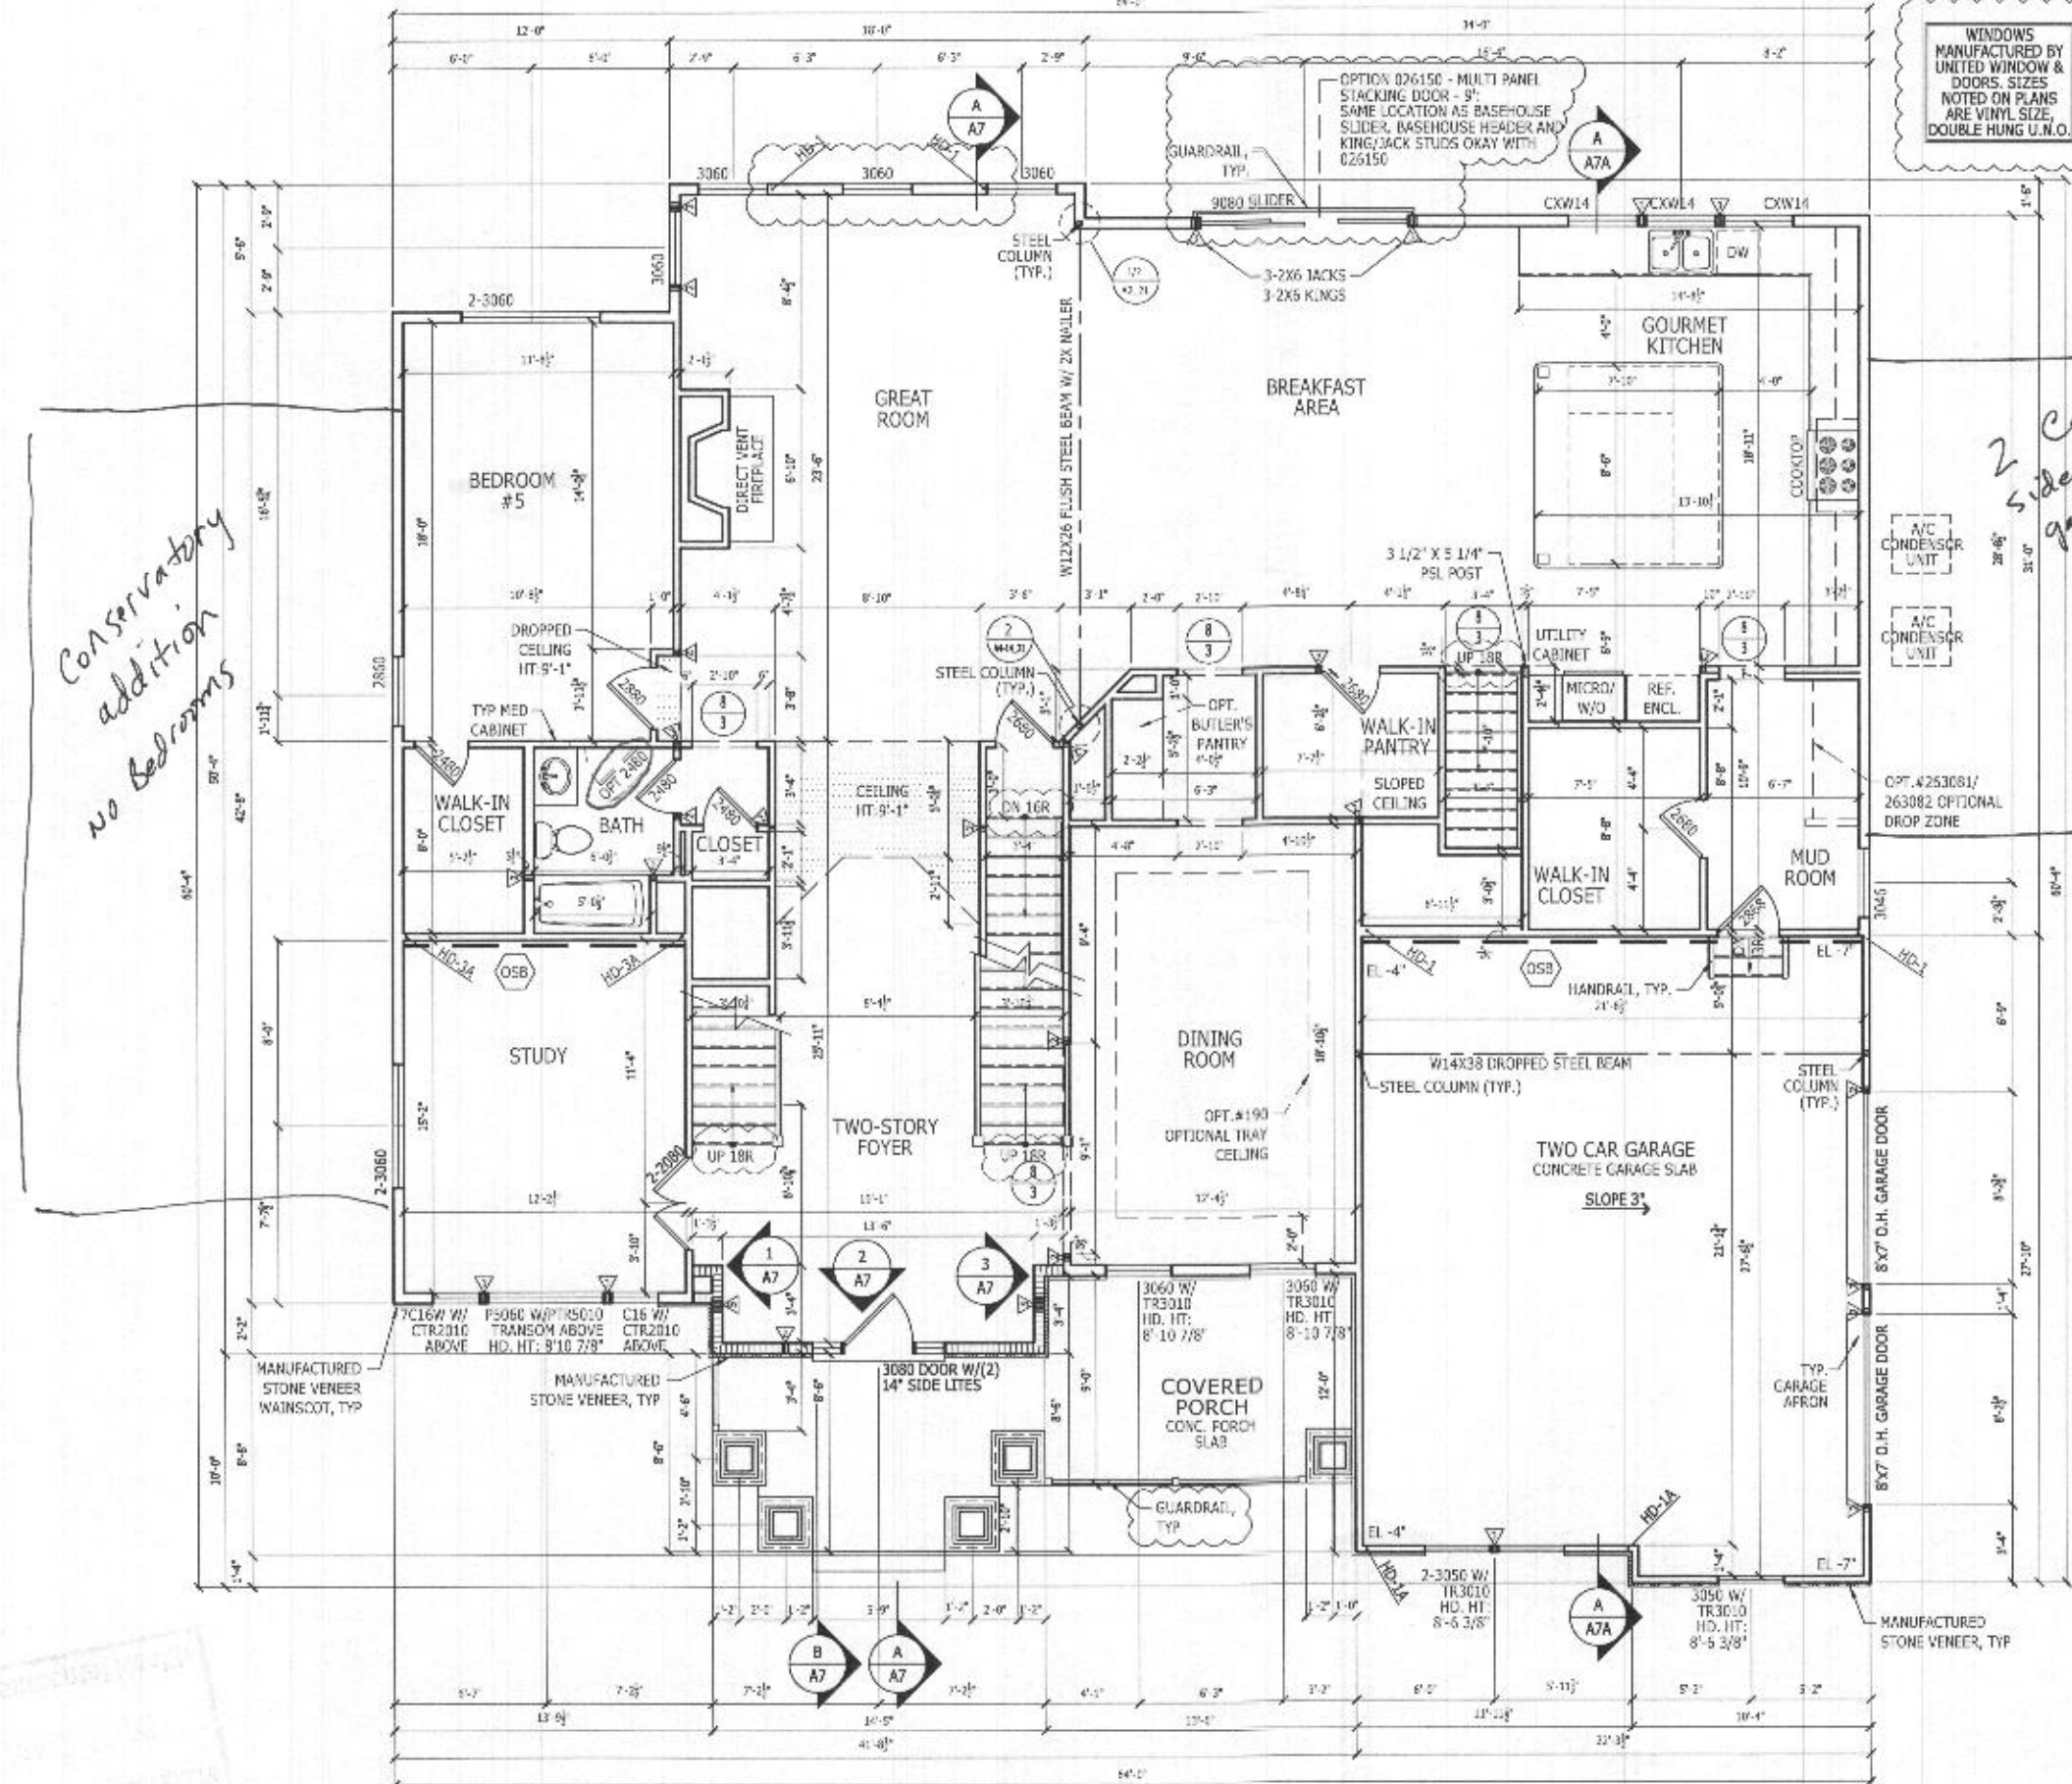

FIRST FLOOR PLAN

SCALE: 1/4" = 1'-0"

COUNTRY MANOR


LATERAL BRACING

THIS HOUSE HAS BEEN ENGINEERED TO RESIST ASCE 7-10 WIND LOADS USING AN ENGINEERED METHOD FOR 130 MPH BASIC WIND SPEED.

FOR OSB + DRYWALL ATTACHMENT
SEE A4L1 DETAIL SHEET


CORNER DETAIL

Scale: 1" = 1-0"

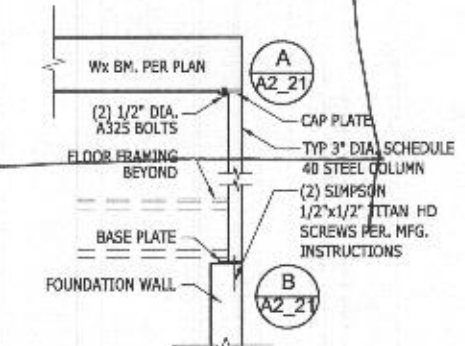


H.S.S. COLUMN DETAIL

1) Scale: 1/2" = 1'-0"

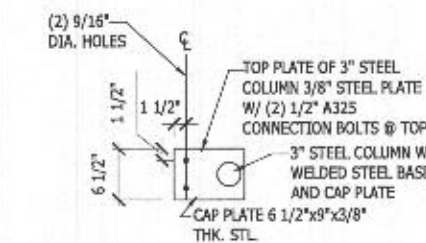

CAP PLATE DETAIL

Scale: 1" = 1'-0"

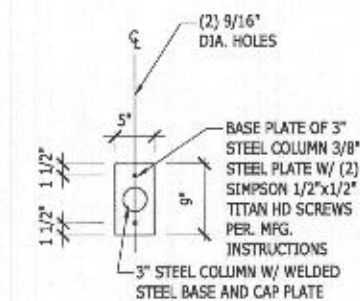

BASE PLATE DETAIL

Scale: 1" = 1'-0"

TOLLARCHITECTURE

PHILADELPHIA • ORLANDO
DALLAS • LOS ANGELES • SEATTLE

250 Gibraltar Road, Horsham, PA 1904
P 215-293-5300 | F 215-293-5314
A Division of Toll Brothers

SHEET REVISION INFO
AO 211064

PRODUCT LINE	ESTATE
MODEL/PROJECT NAME	RIDGEVIEW
ELEVATION NAME	COUNTRY MANOR

DRAWN BY - R. DAUTRICH
CHECKED BY - R. DASILVA
SHEET DATE - 05/08/17

SHEET DESCRIPTION
FIRST FLOOR PLAN (BASE HOUSE)


SHEET NUMBER	A2 21
-----------------	-------

1015.1

RIGHT HAND SET

ALL IDEAS, DESIGNS, ARRANGEMENTS AND PLANS INDICATED OR REPRESENTED BY THIS DRAWING ARE OWNED BY AND THE PROPERTY OF TOLL BROTHERS, INC. AND ARE COPYRIGHTED. THEY WERE CREATED, EVOLVED AND DEVELOPED FOR USE ON, AND IN CONNECTION WITH THE SPECIFIED PROJECT. NONE OF SUCH IDEAS, DESIGNS, ARRANGEMENTS OR PLANS SHALL BE USED BY OR DISCLOSED TO ANY PERSON, FIRM OR CORPORATION FOR ANY PURPOSE WHATSOEVER WITHOUT THE WRITTEN PERMISSION OF TOLL BROTHERS, INC. WRITTEN PERMISSIONS ON THESE DRAWINGS SHALL HAVE PRECEDENCE OVER SCALED DIMENSIONS CONTRACTORS SHALL VERIFY, AND BE RESPONSIBLE FOR ALL DIMENSIONS AND CONDITIONS ON THE JOB AND TOLL BROTHERS OFFICE MUST BE NOTIFIED OF ANY VARIATIONS FROM THE DIMENSIONS AND CONDITIONS SHOWN BY THESE DRAWINGS.

© TB Proprietary Corp.

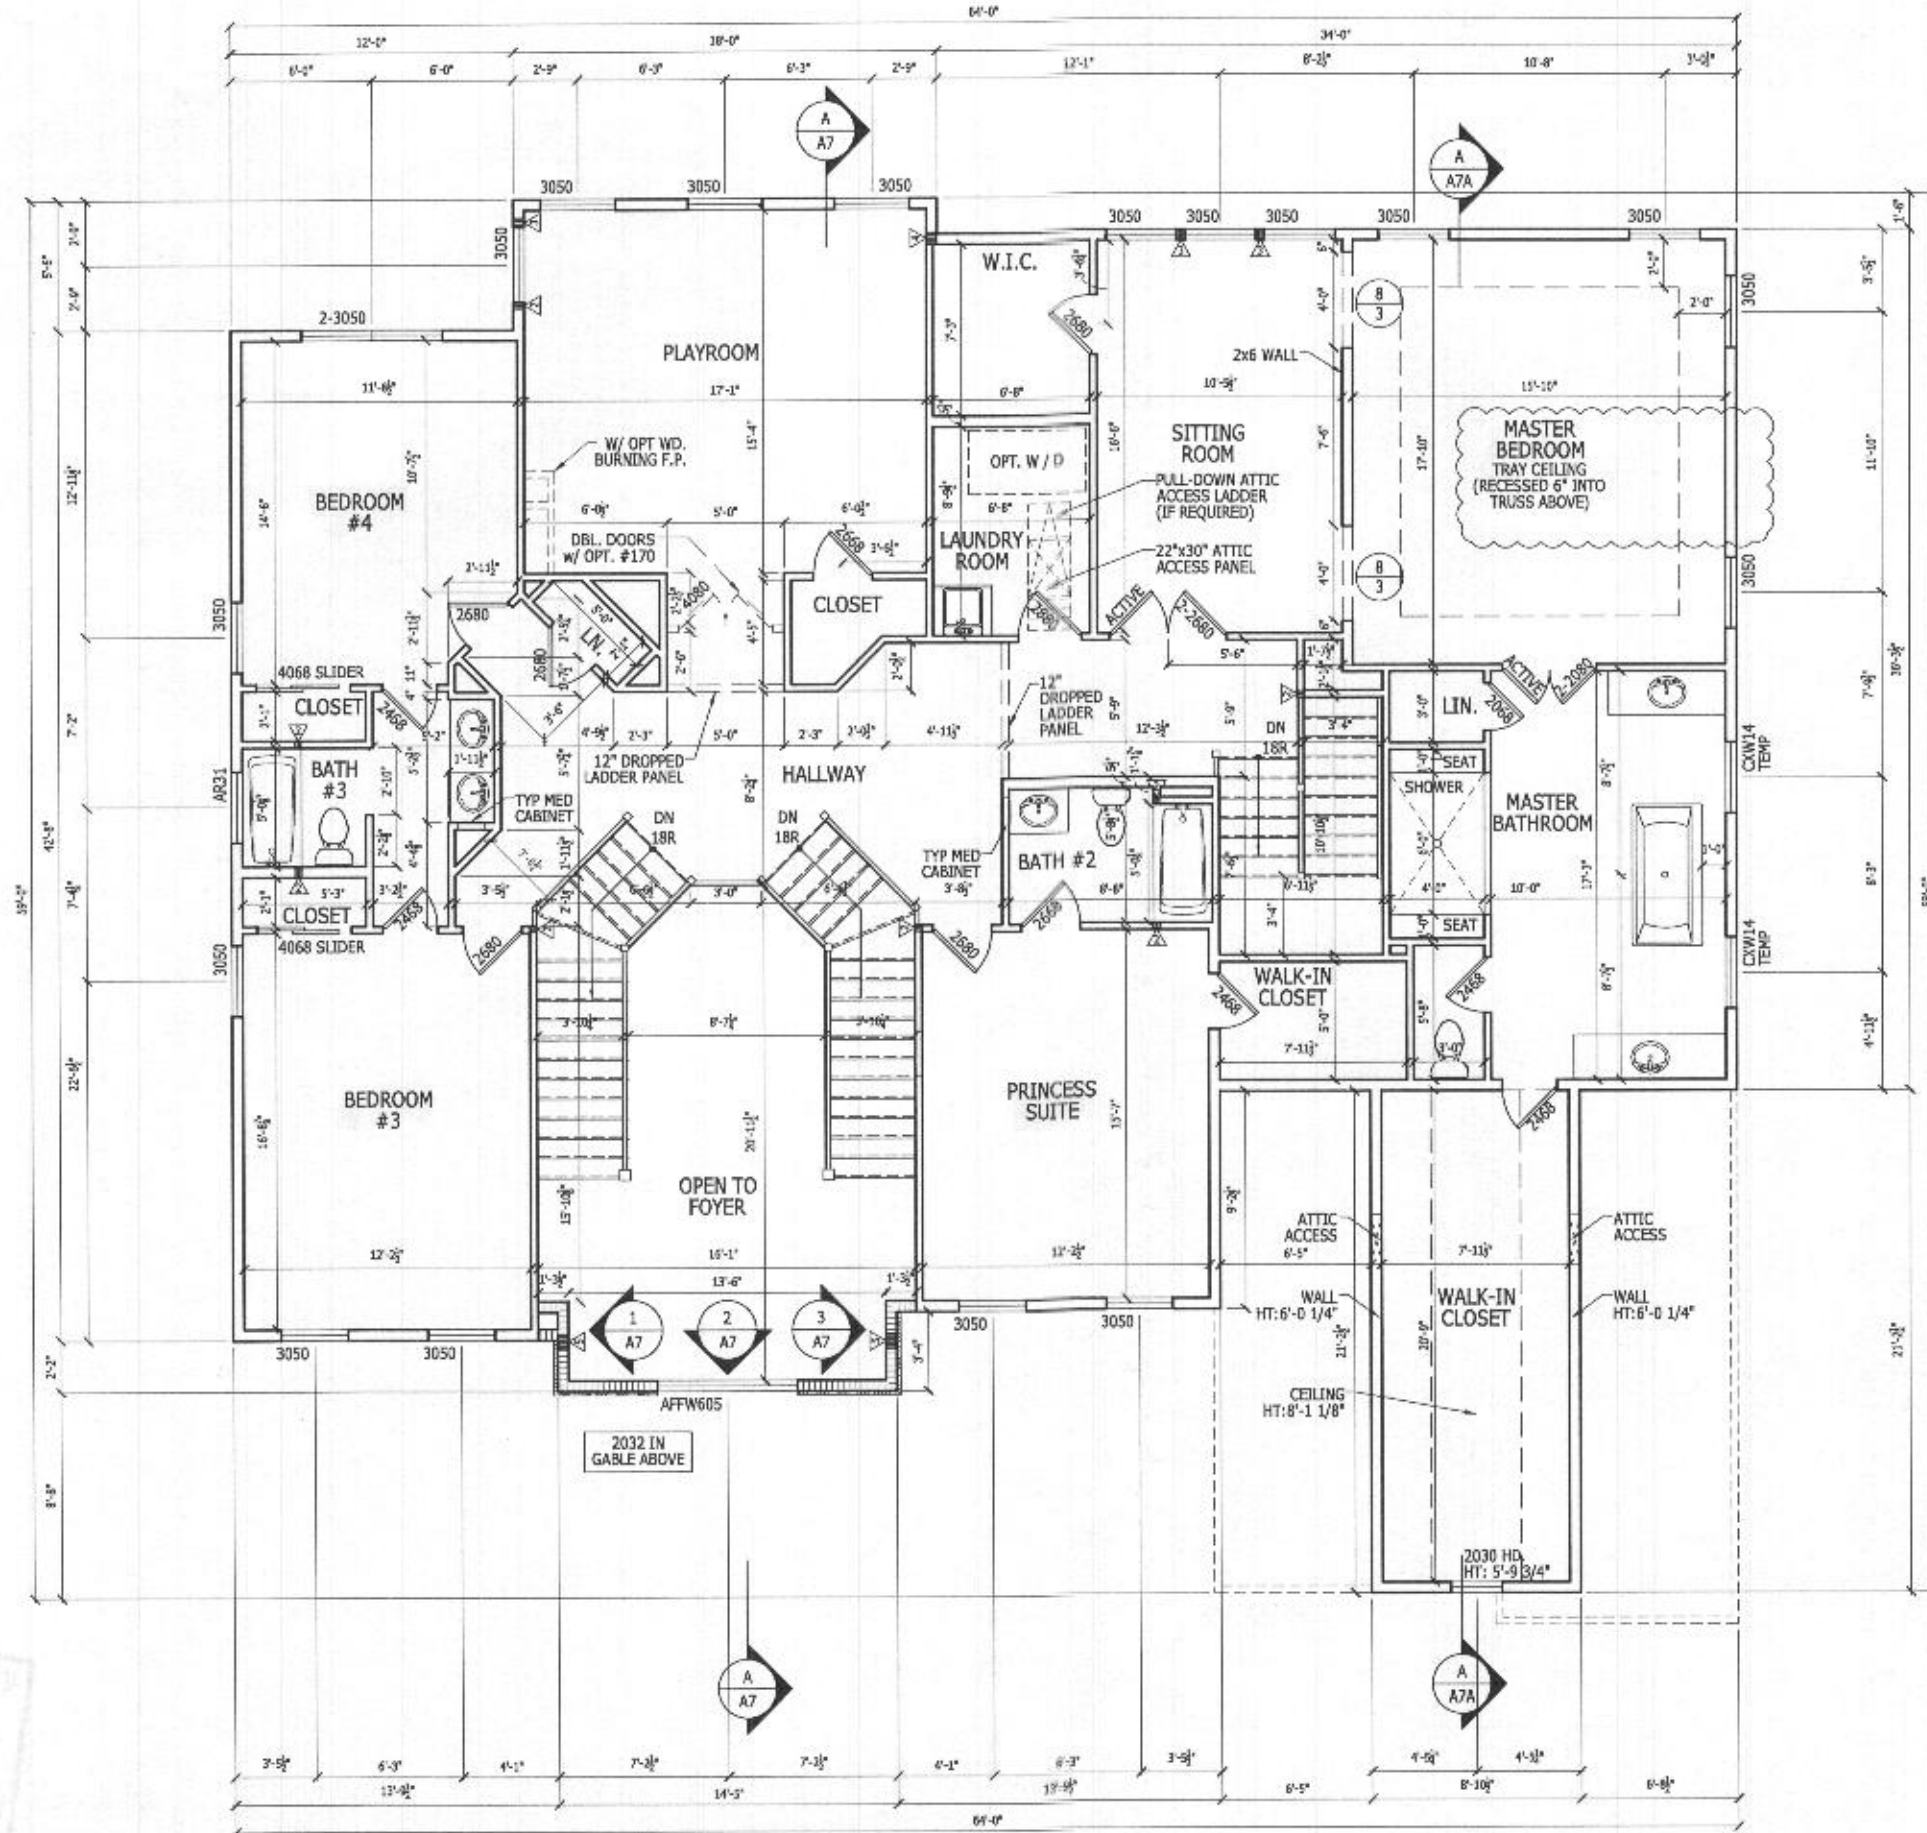

SECOND FLOOR PLAN

SCALE: 1/4" = 1'-0"

COUNTRY MANOR

LATERAL BRACING

THIS HOUSE HAS BEEN ENGINEERED TO RESIST ASCE 7-10 WIND LOAD USING AN ENGINEERED METHOD FOR 100 MPH BASIC (130 MPH ULTIMATE) WIND SPEED.

FOR OSB + DRYWALL ATTACHMENT SEE A4L1 DETAIL SHEET

RIGHT HAND SET

SHEET DESCRIPTION
SECOND FLOOR PLAN (BASE HOUSE)

DRAWN BY - R. DAUTRICH
CHECKED BY - R. DASILVA
SHEET DATE - 06/08/17

PRODUCT LINE
ESTATE
MODEL/PROJECT NAME
RIDGEVIEW
ELEVATION NAME
COUNTRY MANOR

SHEET REVISION INFO
AO 195844
AO 207155
AO 211064
AO 222351
SET REVISION INFO
ECR_166420 01/29/18
D.BUTARU/J.VOICHECK

TOLLARCHITECTURE

PHILADELPHIA · ORLANDO
DALLAS · LOS ANGELES · SEATTLE

250 Gibraltar Road, Horsham, PA 19044
P 215-293-5300 | F 215-293-5314

A Toll Brothers Company

A3_21


SHEET NUMBER
1015.1

LOT 2 Linden Grove

15609 Linden Grove Lane


Health Dept

B21000029

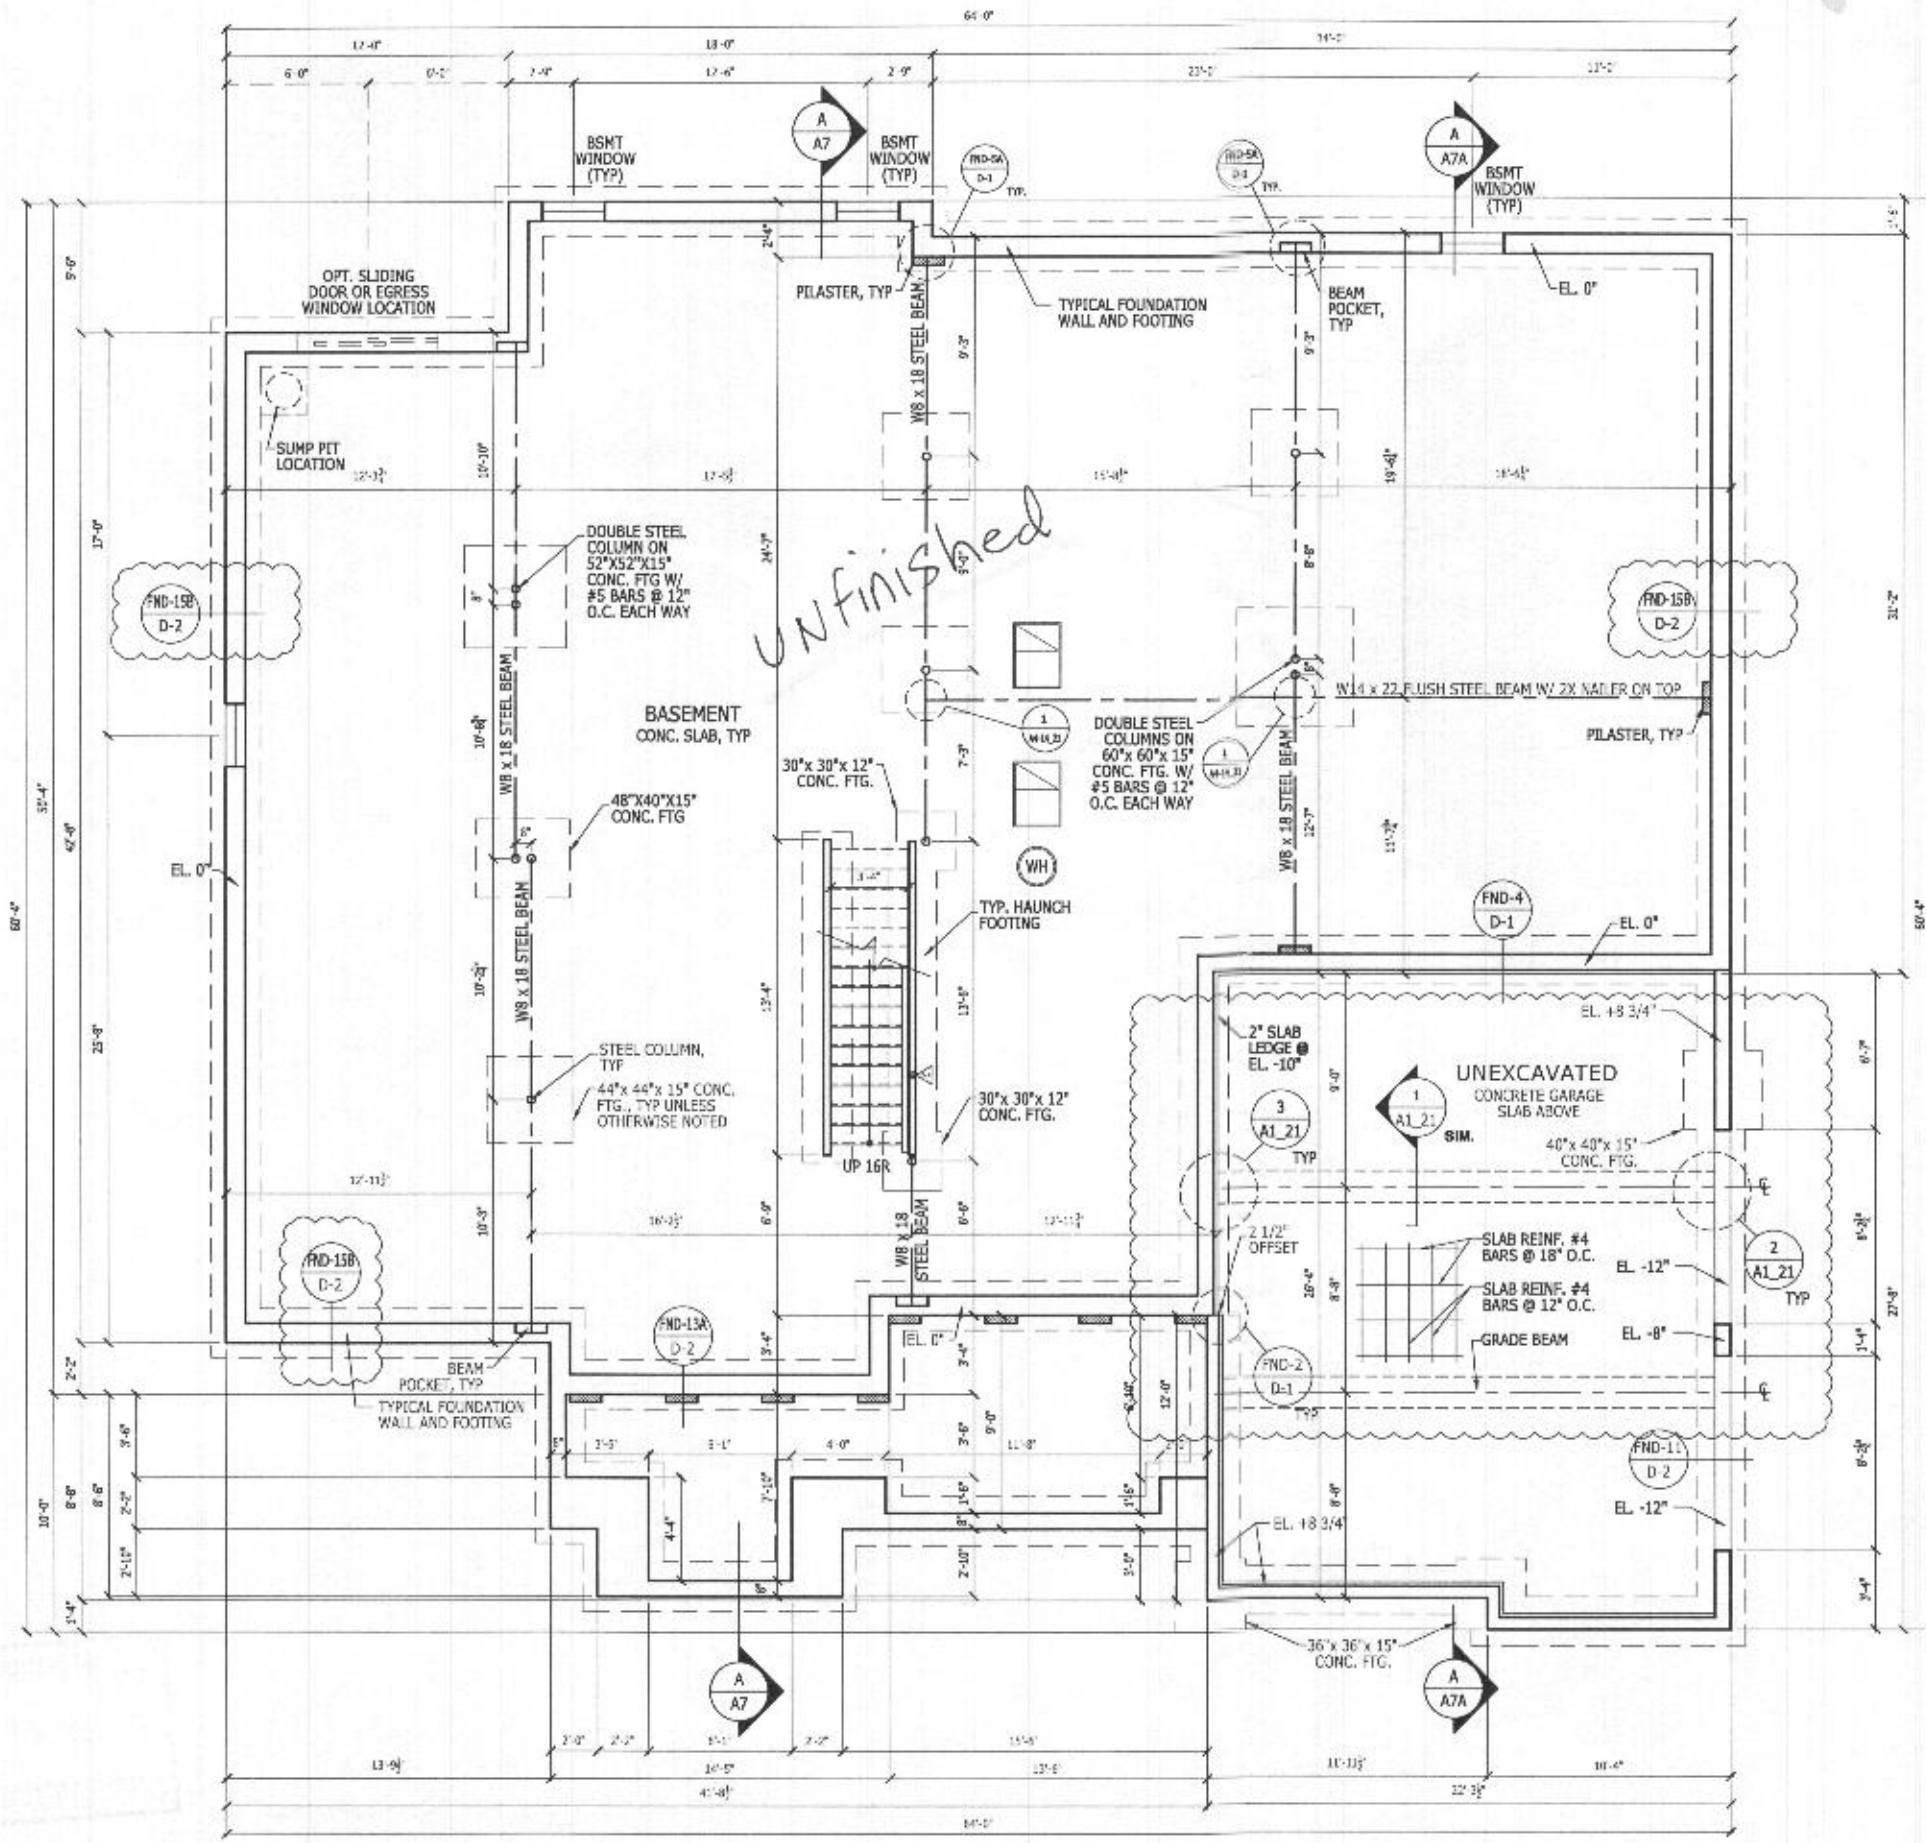

BASEMENT FOUNDATION PLAN
SCALE: 1/4" = 1'-0"

COUNTRY MANOR

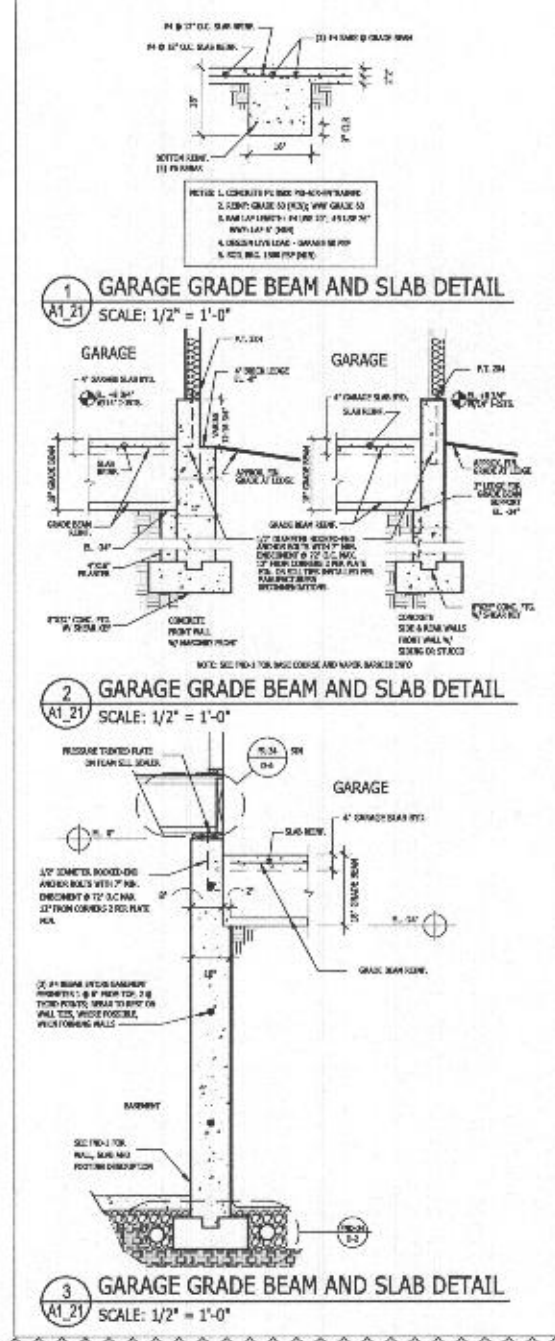


RIGHT HAND SET

TOLLARCHITECTURE		PHILADELPHIA - ORLANDO DALLAS - LOS ANGELES - SEATTLE	
SHEET REVISION INFO		SET REVISION INFO	
AO 211064		ECR 166420 01/29/18 D.BUTRARI/2.VOTCHECK	
PRODUCT LINE		ELEVATION NAME	
ESTATE		COUNTRY MANOR	
MODEL/PROJECT NAME		RIDGEVIEW	
DRAWN BY - R.DAURICH		SHEET DATE - 06/08/17	
CHECKED BY - R.DASILVA		SHEET NUMBER	
SHEET DESCRIPTION		1015.1	
BASEMENT FOUNDATION FLOOR PLAN (BASE HOUSE)		A1 21	

ALL IDEAS, DESIGNS, ARRANGEMENTS AND PLANS INDICATED OR REPRESENTED BY THIS DRAWING ARE OWNED BY AND THE PROPERTY OF TOLL BROTHERS, INC. AND ARE COPYRIGHTED. THEY WERE CREATED, EVOLVED AND DEVELOPED FOR USE ON, AND IN CONNECTION WITH THE SPECIFIED PROJECT. NONE OF SUCH IDEAS, DESIGNS, ARRANGEMENTS OR PLANS SHALL BE USED BY OR DISCLOSED TO ANY PERSON, FIRM OR CORPORATION FOR ANY PURPOSE WHATSOEVER WITHOUT THE WRITTEN PERMISSION OF TOLL BROTHERS, INC. WRITTEN DIMENSIONS ON THESE DRAWINGS SHALL HAVE PRECEDENCE OVER SCALED DIMENSIONS CONTRACTORS SHALL VERIFY, AND BE RESPONSIBLE FOR ALL DIMENSIONS AND CONDITIONS ON THE JOB AND TOLL BROTHERS OFFICE MUST BE NOTIFIED OF ANY VARIATIONS FROM THE DIMENSIONS AND CONDITIONS SHOWN BY THESE DRAWINGS.

© TB Proprietary Corp.

Conservatory
addition
No Bedrooms

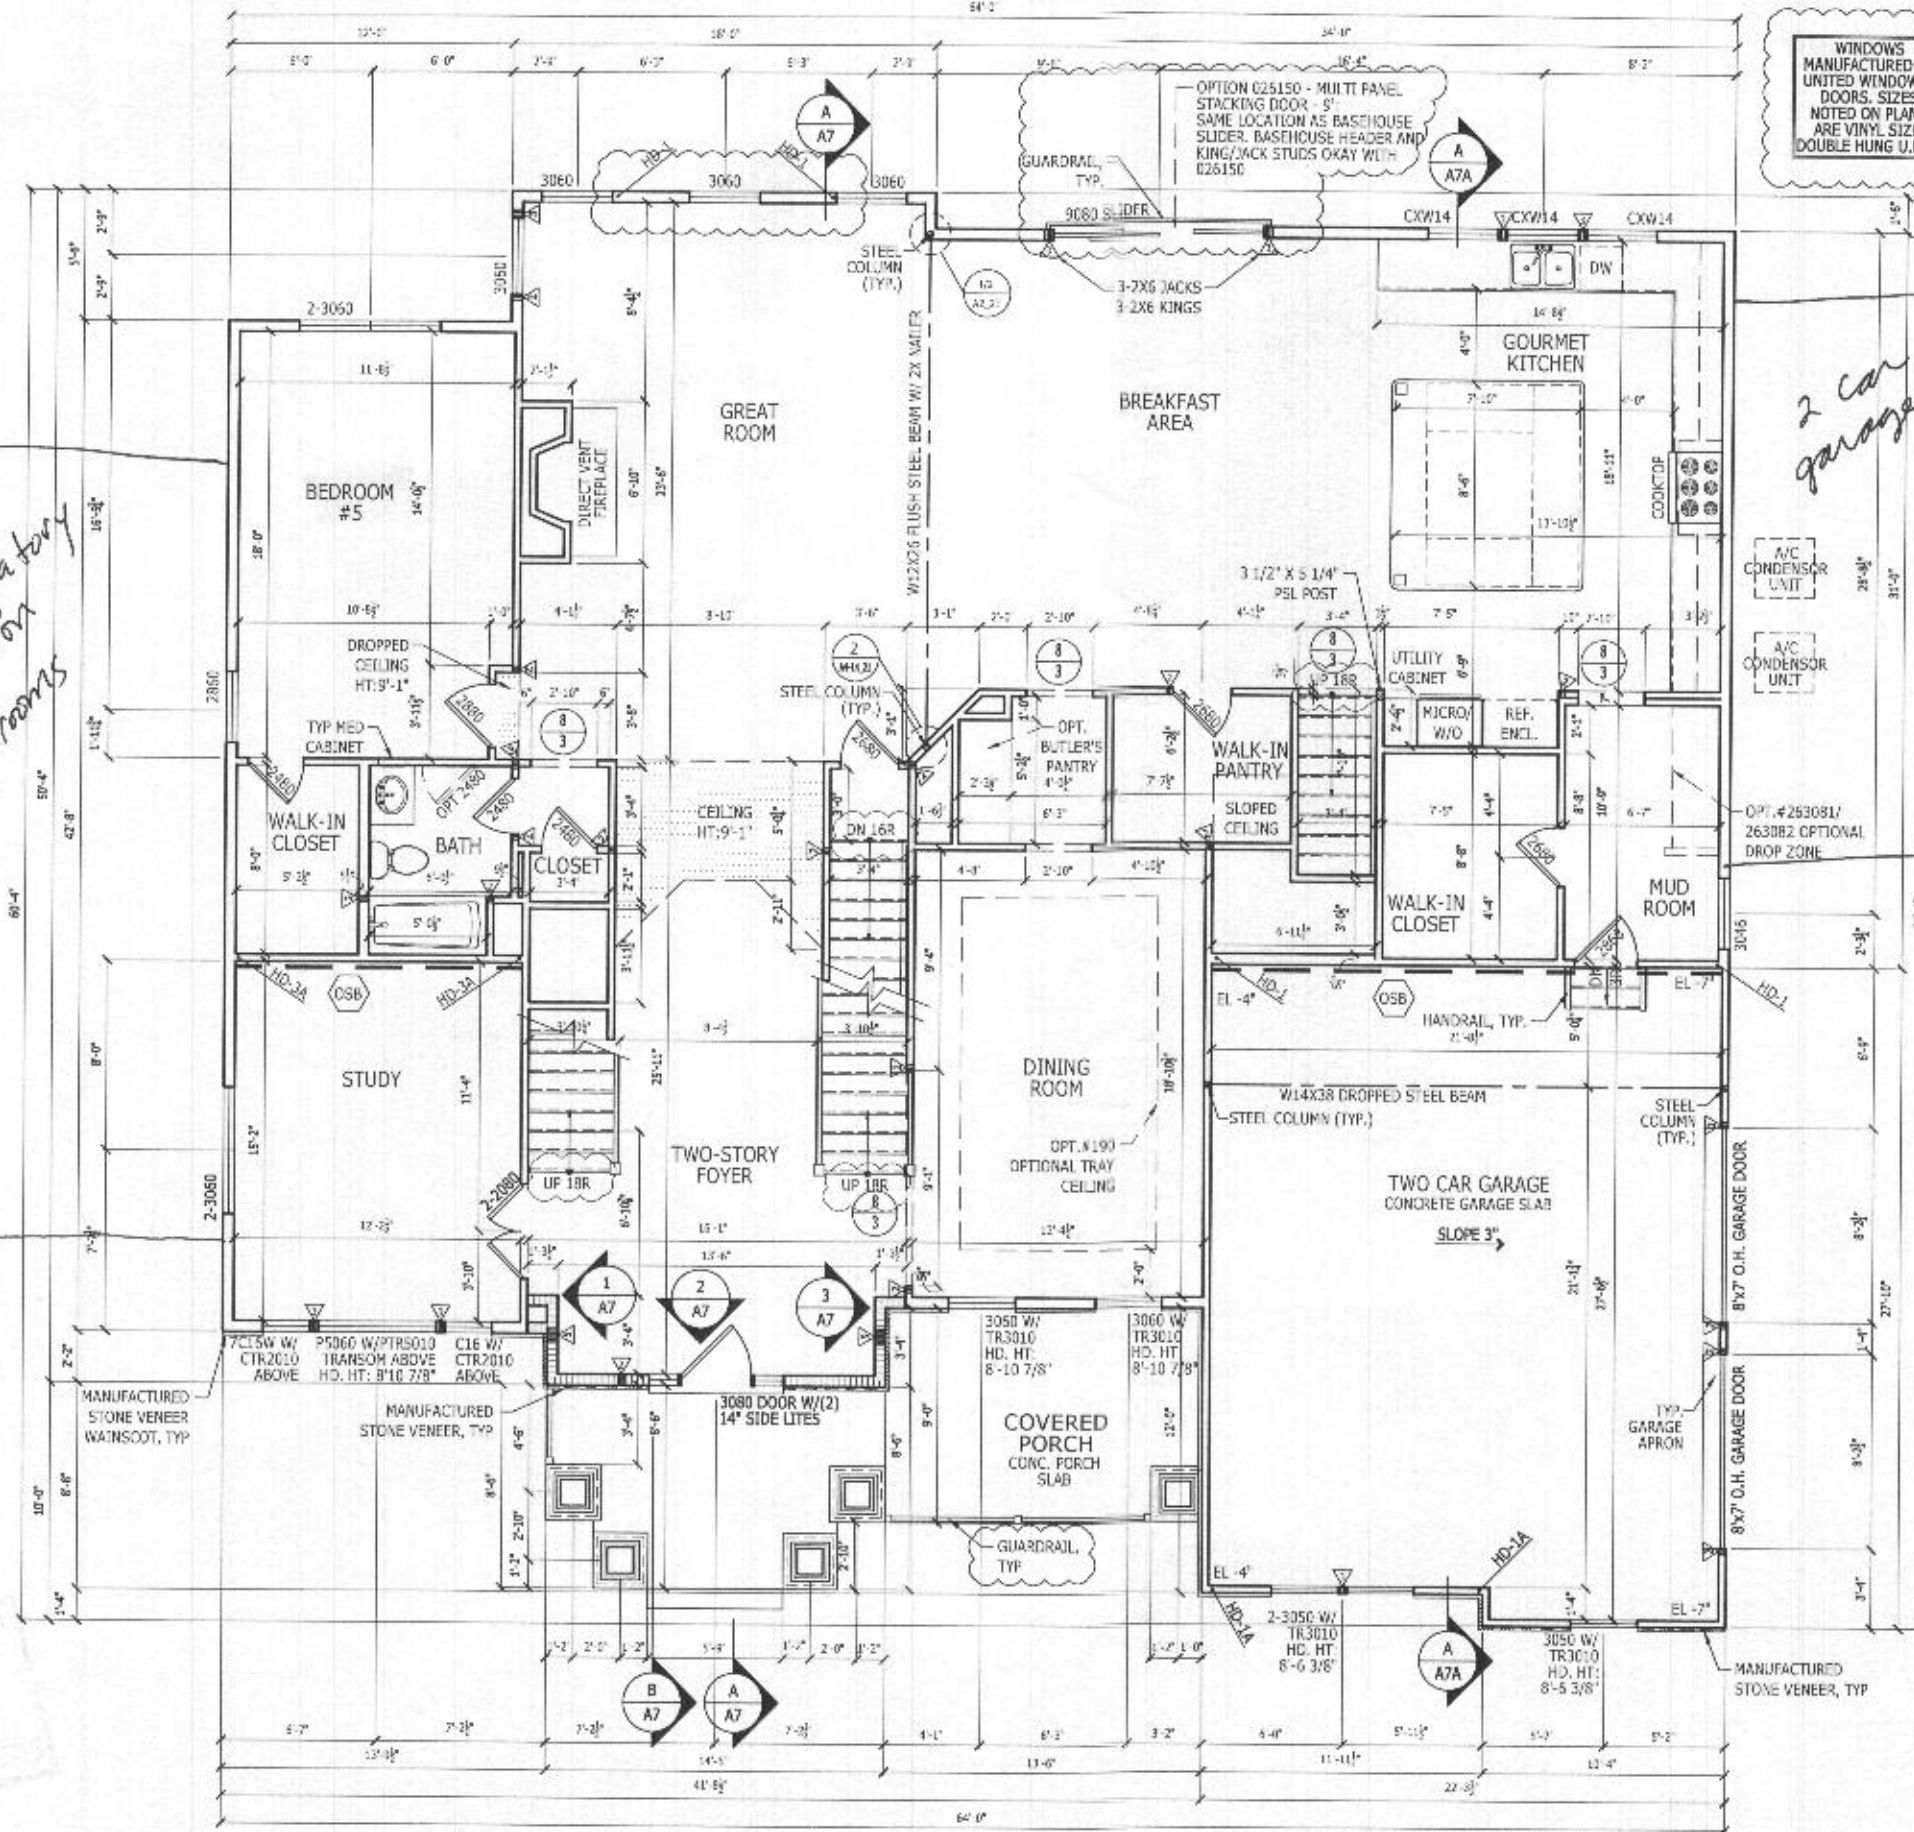

FIRST FLOOR PLAN

SCALE: 1/4" = 1'-0"

COUNTRY MANOR


LATERAL BRACING

THIS HOUSE HAS BEEN ENGINEERED TO RESIST ASCE 7-10 WIND LOADS USING AN ENGINEERED METHOD FOR 130 MPH BASIC WIND SPEED.
FOR OSB + DRYWALL ATTACHMENT SEE A411 DETAIL SHEET

WINDOWS MANUFACTURED BY UNITED WINDOW & DOORS. SIZES NOTED ON PLANS ARE VINYL SIZE, DOUBLE HUNG U.N.O.


1 CORNER DETAIL

A2_21 Scale: 1" = 1'-0"

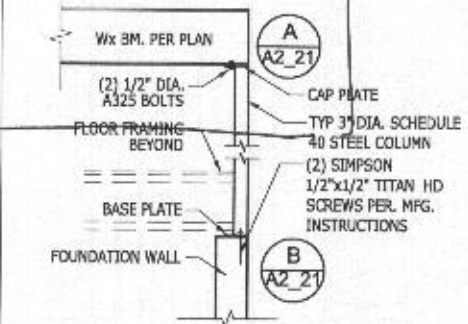


2 H.S.S. COLUMN DETAIL

A2_21 Scale: 1/2" = 1'-0"

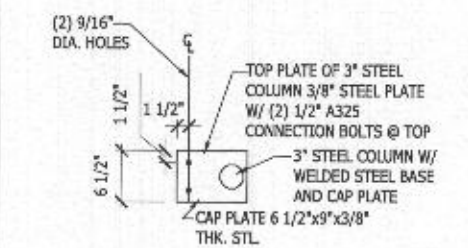

A CAP PLATE DETAIL

A2_21 Scale: 1" = 1'-0"

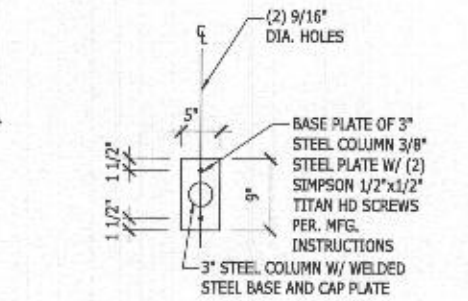

B BASE PLATE DETAIL

A2_21 Scale: 1" = 1'-0"

RIGHT HAND SET

TOLLARCHITECTURE

PHILADELPHIA - ORLANDO
DALLAS - LOS ANGELES - SEATTLE
250 Gibraltar Road, Hingham, PA 19044
P 215-293-5300 | F 215-293-5314
A Division of Toll Brothers

SHEET REVISION INFO

AO 211064

PRODUCT LINE

ESTATE

DRAWN BY -

R. DAUTRICH

CHECKED BY -

R. DASILVA

SHEET DATE -

06/08/17

SHEET DESCRIPTION

FIRST FLOOR PLAN (BASE HOUSE)


SERIAL NUMBER

1015.1

A2_21

© TB Proprietary Corp.

ALL IDEAS, DESIGNS, ARRANGEMENTS AND PLANS INDICATED OR REPRESENTED BY THIS DRAWING ARE OWNED BY AND THE PROPERTY OF TOLL BROTHERS, INC. AND ARE COPYRIGHTED. THEY WERE CREATED, EVOLVED AND DEVELOPED FOR USE ON, AND IN CONNECTION WITH THE SPECIFIED PROJECT. NONE OF SUCH IDEAS, DESIGNS, ARRANGEMENTS OR PLANS SHALL BE USED BY OR DISCLOSED TO ANY PERSON, FIRM OR CORPORATION FOR ANY PURPOSE WHATSOEVER WITHOUT THE WRITTEN PERMISSION OF TOLL BROTHERS, INC. WRITTEN PERMISSIONS ON THESE DRAWINGS SHALL HAVE PRECEDENCE OVER SCALED DIMENSIONS CONTRACTORS SHALL VERIFY, AND BE RESPONSIBLE FOR ALL DIMENSIONS AND CONDITIONS ON THE JOB AND TOLL BROTHERS OFFICE MUST BE NOTIFIED OF ANY VARIATIONS FROM THE DIMENSIONS AND CONDITIONS SHOWN BY THESE DRAWINGS.

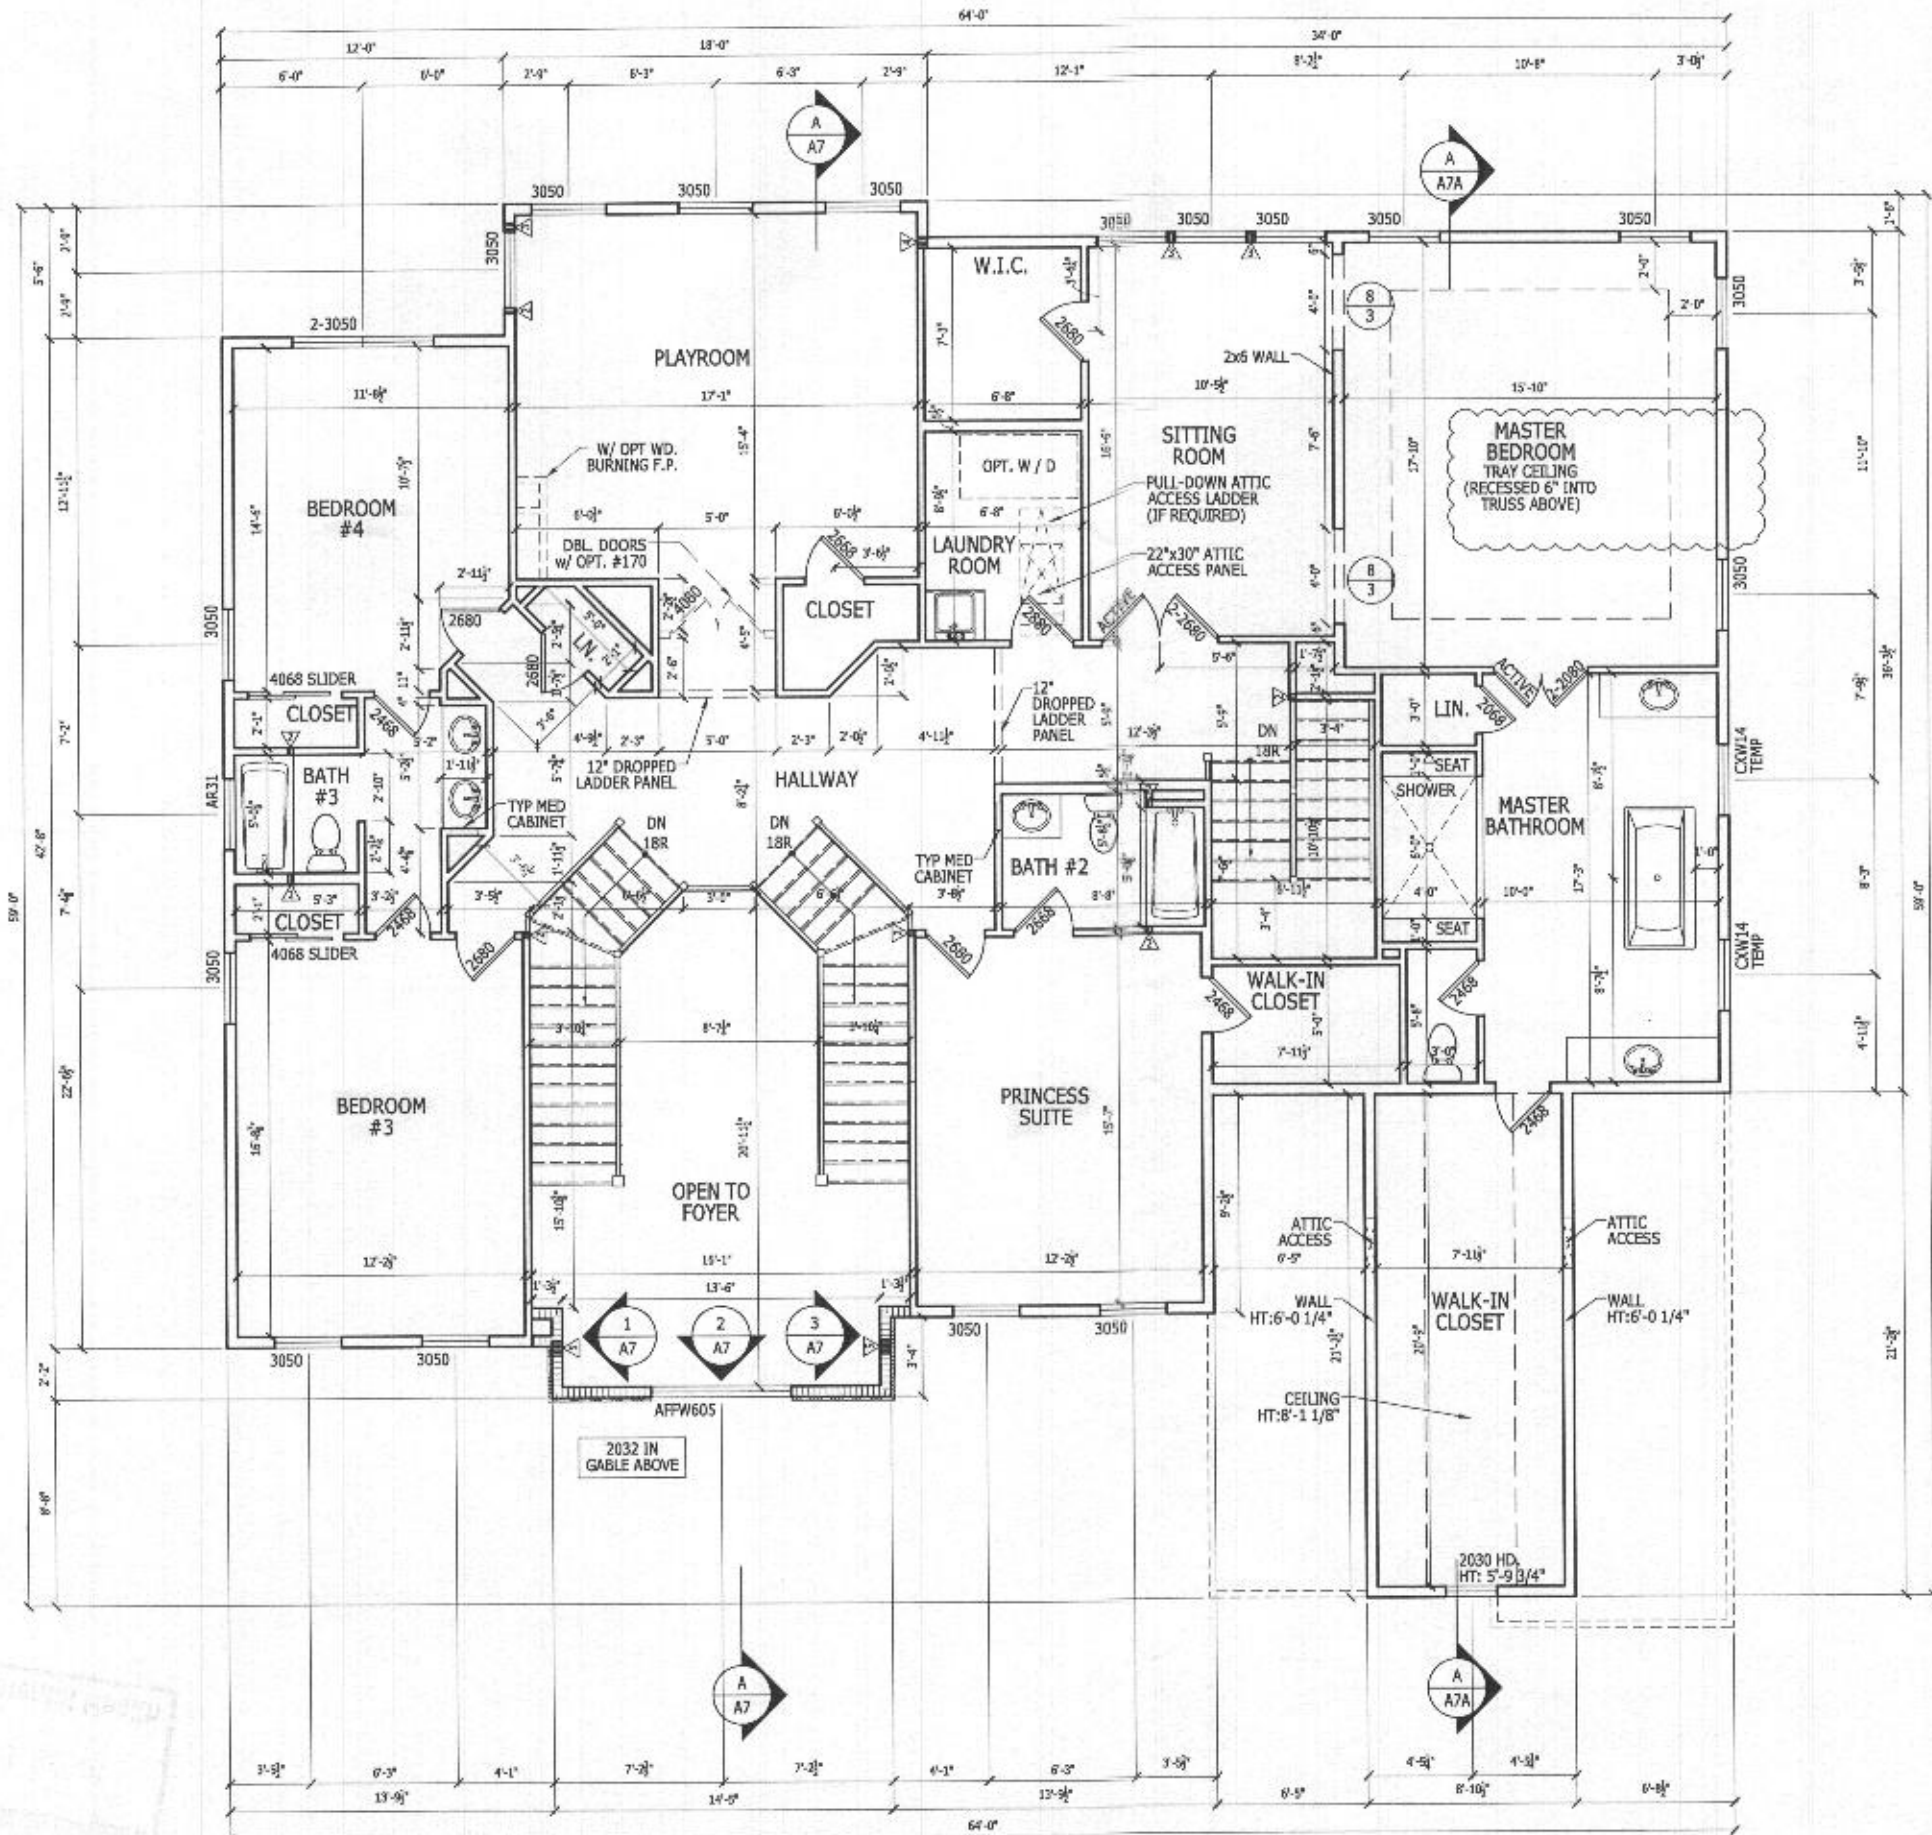

SECOND FLOOR PLAN
SCALE: 1/4" = 1'-0"

COUNTRY MANOR

LATERAL BRACING

THIS HOUSE HAS BEEN ENGINEERED TO RESIST ASCE 7-10 WIND LOAD USING AN ENGINEERED METHOD FOR 100 MPH BASIC (130 MPH ULTIMATE) WIND SPEED.

FOR CS6 + DRYWALL ATTACHMENT SEE A4.1 DETAIL SHEET

RIGHT HAND SET

TOLLARCHITECTURE		PHILADELPHIA - ORLANDO DALLAS - LOS ANGELES - SEATTLE		250 Gibraltar Road, Horsham, PA 19044 P 215-293-5300 F 215-293-5314 A Toll Brothers Company	
SHEET DESCRIPTION		SHEET REVISION INFO		PRODUCT LINE	
SECOND FLOOR PLAN (BASE HOUSE)		AO 195844 AO 207155 AO 211064 AO 222351		ESTATE	
SERIAL NUMBER		SET REVISION INFO		MODEL/PROJECT NAME	
1015.1		ECR 166420 01/29/18 D.BUTARU/VOICHECK		RIDGEVIEW	
A3 21		COUNTRY MANOR		ELEVATION NAME	