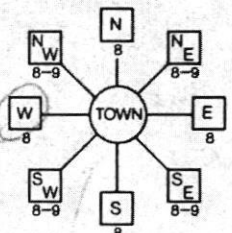
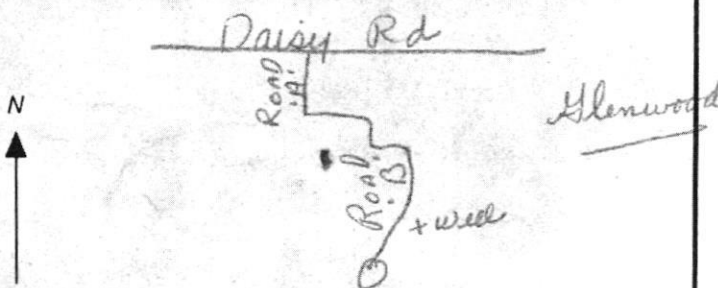


C1 14293 (MDE USE ONLY)		STATE OF MARYLAND WELL COMPLETION REPORT FILL IN THIS FORM COMPLETELY PLEASE TYPE		THIS REPORT MUST BE SUBMITTED WITHIN 45 DAYS AFTER WELL IS COMPLETED.	
(THIS NUMBER IS TO BE PUNCHED IN COLS. 3-6 ON ALL CARDS)				COUNTY NUMBER A515227-H	
ST/CO USE ONLY DATE RECEIVED 120202		DATE WELL COMPLETED MM DD YY 11 7 02		Depth of Well 127 02 OK SRK	
		PERMIT NO. FROM "PERMIT TO DRILL WELL" HO-74-3533			
OWNER GST TRUST + SISTERS TRUST		STREET OR RFD LAUREL DRIVE ROAD LAUREL		TOWN GLENWOOD	
SUBDIVISION WATERBURY FARMS		SECTION 9		LOT 9	

WELL LOG Not required for driven wells STATE THE KIND OF FORMATIONS PENETRATED, THEIR COLOR, DEPTH, THICKNESS AND IF WATER BEARING			GROUTING RECORD WELL HAS BEEN GROUTED (Circle Appropriate Box) TYPE OF GROUTING MATERIAL (Circle one) CEMENT (CM) BENTONITE CLAY (BC) NO. OF BAGS 23 NO. OF POUNDS 2162 GALLONS OF WATER 138 DEPTH OF GROUT SEAL (to nearest foot) from 0 ft. to 83 ft. (enter 0 if from surface)			C3 PUMPING TEST HOURS PUMPED (nearest hour) 3 PUMPING RATE (gal. per min.) 7.5 METHOD USED TO MEASURE PUMPING RATE Bucket WATER LEVEL (distance from land surface) BEFORE PUMPING 52 ft. WHEN PUMPING 172 ft. TYPE OF PUMP USED (for test) A air P piston T turbine C centrifugal R rotary O other (describe below) J jet S submersible					
DESCRIPTION (Use additional sheets if needed)			CASING RECORD casing types insert appropriate code below <table border="1" style="width:100%; text-align: center;"> <tr> <td>ST STEEL</td> <td>CO CONCRETE</td> </tr> <tr> <td>PL PLASTIC</td> <td>OT OTHER</td> </tr> </table> MAIN CASING TYPE ST Nominal diameter top (main) casing (nearest inch) 6 Total depth of main casing (nearest foot) 95 60 61 63 64 66 70			ST STEEL	CO CONCRETE	PL PLASTIC	OT OTHER		
ST STEEL	CO CONCRETE										
PL PLASTIC	OT OTHER										
Brown Shale 0 90 Gray Granite 90 300			OTHER CASING (if used) diameter inch depth (feet) from to EACH CASING								
NUMBER OF UNSUCCESSFUL WELLS: 0			C2 DEPTH (nearest ft.) HO 92 300 1 8 9 11 15 17 21 2 23 24 26 30 32 36 3 38 39 41 45 47 51 4 53 54 56 58 60 62 5 64 65 67 69 71 73 6 75 76 78 80 82 84 7 86 87 89 91 93 95								
WELL HYDROFRACTURED Y N			SCREEN RECORD screen type or open hole insert appropriate code below <table border="1" style="width:100%; text-align: center;"> <tr> <td>ST STEEL</td> <td>BR BRASS</td> <td>HO OPEN HOLE</td> </tr> <tr> <td>PL PLASTIC</td> <td>OT OTHER</td> <td></td> </tr> </table>			ST STEEL	BR BRASS	HO OPEN HOLE	PL PLASTIC	OT OTHER	
ST STEEL	BR BRASS	HO OPEN HOLE									
PL PLASTIC	OT OTHER										
CIRCLE APPROPRIATE LETTER A A WELL WAS ABANDONED AND SEALED WHEN THIS WELL WAS COMPLETED E ELECTRIC LOG OBTAINED P TEST WELL CONVERTED TO PRODUCTION WELL I HEREBY CERTIFY THAT THIS WELL HAS BEEN CONSTRUCTED IN ACCORDANCE WITH COMAR 26.04.04 "WELL CONSTRUCTION" AND IN CONFORMANCE WITH ALL CONDITIONS STATED IN THE ABOVE CAPTIONED PERMIT, AND THAT THE INFORMATION PRESENTED HEREIN IS ACCURATE AND COMPLETE TO THE BEST OF MY KNOWLEDGE.			PUMP INSTALLED DRILLER INSTALLED PUMP (CIRCLE) (YES or NO) YES N IF DRILLER INSTALLS PUMP, THIS SECTION MUST BE COMPLETED FOR ALL WELLS. TYPE OF PUMP INSTALLED PLACE (A,C,J,P,R,S,T,O) IN BOX 29. 29 CAPACITY: GALLONS PER MINUTE (to nearest gallon) 31 35 PUMP HORSE POWER 37 41 PUMP COLUMN LENGTH (nearest ft.) 43 47 CASING HEIGHT (circle appropriate box and enter casing height) + above LAND SURFACE - below 3 (nearest foot)								
DRILLERS LIC. NO. MSD024 Joseph L. Mayne DRILLERS SIGNATURE (MUST MATCH SIGNATURE ON APPLICATION) LIC. NO. D			LOCATION OF WELL ON LOT SHOW PERMANENT STRUCTURE SUCH AS BUILDING, SEPTIC TANKS, AND /OR LANDMARKS AND INDICATE NOT LESS THAN TWO DISTANCES (MEASUREMENTS TO WELL) 								
SITE SUPERVISOR (sign. of driller or journeyman responsible for sitework if different from permittee)			GRAVEL PACK IF WELL DRILLED WAS FLOWING WELL INSERT F IN BOX 68 68 MDE USE ONLY (NOT TO BE FILLED IN BY DRILLER) T (E.R.O.S.) W Q 70 72 74 75 76 TELESCOPE CASING LOG INDICATOR OTHER DATA								

B 1 1 2 3 6 6742	SEQUENCE NO. (MDE USE ONLY)	STATE OF MARYLAND APPLICATION FOR PERMIT TO DRILL WELL 517434 please type	STATE PERMIT NUMBER HO-94-3533 70 fill in this form completely 79
Date Received (APA) 08/22/02 8 MM DD YY 13 OWNER INFORMATION 15 Last Name Owner First Name 34 Gst Trust + Sisters Trust 36 3 Wyndam Ct. 55 Street or RFD Lutherville Md 21093 57 Town 70 State 72 Zip 76		B 3 LOCATION OF WELL 8 COUNTY Howard 21 23 SUBDIVISION Waterford Farms 42 SECTION 44 46 LOT 48 9 50 Glenwood 52 NEAREST TOWN 71 MILES FROM TOWN (enter 0 if in town) 4 1/2 M I 73 76 77 78	
DRILLER INFORMATION Driller's Name Joseph L. Mayne MS D 024 76 License No. 81 Firm Name Joseph L. Mayne Well Drilling Address 5512 Ridge Rd Mt. Airy Md 21771 Signature Joseph L. Mayne Date 8-23-02		B 4 1 2 DIRECTION OF WELL FROM TOWN (CIRCLE BOX)  11 NEAR WHAT ROAD 30 Road 'B' ON WHICH SIDE OF ROAD (CIRCLE APPROPRIATE BOX) NORTH N WEST W EAST E SOUTH S 34 20 37 DISTANCE FROM ROAD ENTER FT OR MI 38 39 ENTER 20 FT TAX MAP: 13 BLK: 24 PARCEL 13	
B 2 1 2 WELL INFORMATION APPROX. PUMPING RATE 5 GAL. PER MIN. 8 12 AVERAGE DAILY QUANTITY NEEDED 500 GAL. PER DAY 14 20		USE FOR WATER (CIRCLE APPROPRIATE BOX) <input checked="" type="radio"/> D DOMESTIC POTABLE SUPPLY & RESIDENTIAL IRRIGATION <input type="radio"/> F FARMING (LIVESTOCK WATERING & AGRICULTURAL IRRIGATION) <input type="radio"/> I INDUSTRIAL, COMMERCIAL, DEWATERING <input type="radio"/> P PUBLIC WATER SUPPLY WELL <input type="radio"/> T TEST, OBSERVATION, MONITORING <input type="radio"/> G GEO-THERMAL	
APPROXIMATE DEPTH OF WELL 260 FEET 24 28 APPROXIMATE DIAMETER OF WELL 6 INCH NEAREST INCH		NOT TO BE FILLED IN BY DRILLER HEALTH DEPARTMENT APPROVAL HOWARD COUNTY NAME A515227-H COUNTY NO. STATE SIGNATURE _____ INSERT S → DATE ISSUED 10-17-02 Steven R. Krieg 41 43 MM DD YY 48 CO SIGNATURE EXP. DATE NORTH GRID 520 0 0 0 EAST GRID 780 0 0 0 50 55 57 63	
METHOD OF DRILLING (circle one) BORED (or Augered) JETTED Jetted & DRIVEN 30 AIR-ROTARY AIR-PERCussion ROTARY (Hydraulic Rotary) 37 CABLE REVERSE-ROTARY Drive-POINT other _____		SHOW MAJOR FEATURES OF BOX & LOCATE WELL WITH AN X SOURCES OF DRILLING WATER 1. well 2. 3. WRITE THE BOX NUMBER FROM THE MAP HERE E 780 X 000 000 N 520 DRAW A SKETCH BELOW SHOWING LOCATION OF WELL IN RELATION TO NEARBY TOWNS AND ROADS AND GIVE DISTANCE FROM WELL TO NEAREST ROAD JUNCTION 	
REPLACEMENT OR DEEPENED WELLS (CIRCLE APPROPRIATE BOX) <input checked="" type="radio"/> N THIS WELL WILL NOT REPLACE AN EXISTING WELL <input type="radio"/> Y THIS WELL WILL REPLACE A WELL THAT WILL BE ABANDONED AND SEALED 39 <input type="radio"/> S THIS WELL WILL REPLACE A WELL THAT WILL BE USED AS A STANDBY-CONTACT LOCAL APPROVING AUTHORITY FOR POLICY ON STANDBY WELLS <input type="radio"/> D THIS WELL WILL DEEPEAN AN EXISTING WELL PERMIT NUMBER OF WELL TO BE REPLACED OR DEEPEANED (IF AVAILABLE) 41 _____ 52		Not to be filled in by driller (MDE OR COUNTY USE ONLY) APPROP. PERMIT NUMBER _____ G _____ PERMIT No. HO-94-3533 70 71 72 73 74 75 76 77 78 79	
SPECIAL CONDITIONS NOTE - APPROVING AUTHORITIES SHOULD USE SEPARATE SHEET IF NEEDED			

HOWARD COUNTY HEALTH DEPARTMENT
BUREAU OF ENVIRONMENTAL HEALTH
WATER AND SEWERAGE PROGRAM
TEL: (410)313-2640 FAX: (410)313-2648

TAL BEAS FAX

410-489-6293

Information Form for the Installation of the Well Pump, Pitless Adapter, and Supply Piping

NOTE: The installer is responsible for requesting an inspection prior to 9 am on the day of the desired inspection. No work is to be covered until approved by the Health Department. All installations must comply with the National Standard Plumbing Code (NSPC, as amended locally) and COMAR 26.04.04 MD Well Construction Regulations. Submission of a complete form is required prior to Use and Occupancy approval.

Company Name: Fogel's Well Drilling Telephone #: 410-795-5670
Address: 580 Obrecht rd
Cykesville id. 21789

(Must circle one) Licensed Plumber Licensed Well Driller Licensed Well Pump Installer

License # and name of individual responsible for the field installation:

Name (Print): Allen Lampton License# MSD 009

*A licensed individual must perform the actual installation. Apprentices must be under the direct supervision of a licensed journeyman or master plumber, pump installer or well driller. Licensee may be subjected to field verification.

Name of Property Owner: Toll Beathers Telephone #: _____
Subdivision: Cattail Trace Lot #: 9 Well Tag #: HO-94-5533
Site Address: 3163 Lantz Lane

Submersible Pump Data	Pitless Adapter	Well Cap and Electric Cond
Make: <u>Goulds</u>	Make: <u>Campbell</u>	Two piece watertight cap: <u>Y</u>
Model #: <u>F475B07422</u>	Model#: <u>NA</u>	Screened, vented well cap: <u>Y</u>
Pump Capacity <u>7</u> GPM	Depth: <u>36</u> " (36" min)	Cap secured to casing: <u>Y</u>
Well Yield: _____ GPM	NSF approved: <u>Y</u>	Conduit min 18" B.G.: <u>Y</u>
Depth of well encountered at time of pump installation: <u>36</u> (feet)		Conduit secured to well cap: <u>Y</u>
If pump capacity exceeds well yield, a low water cut off switch is required by NSPC 1990 Section 17.1		
Torque arrestors or Cable guards are required - Must circle one		
Safety rope, if used, attached to inside of well casing with eye bolt: <u>NO</u>		

Piping to house

Type: 1" Black Plastic
PSI: 160 (160 psi min)
Depth of supply line: 42" (36" min)

House Connection

PVC sleeved to undisturbed soil at wall penetration: Y
Approximate length of sleeve: 5'
Sleeve caulked and sealed properly: Y

The water supply line is required to be at least ten feet from the septic tank, pump chamber, sewerage piping, distribution box, drainfields, and sewage reserve area. If this cannot be accomplished, contact the Health Department office for approval prior to installation.


Signature of company representative responsible for installation

date

11-8-04

For Health Department Use Only - Not to be completed by Installer

Date Insp. Requested: 9/23/04 Date Insp. Approved: 9/24/04 (BB)
Inspection Data: Pitless adapter and water supply line at least 36" below grade ✓
Two piece cap installed and attached to casing securely ✓
Elec. conduit extends at least 18" below grade/attached to cap properly ✓
Safety rope installed inside of well casing ✓
Correct well tag attached properly and casing 8" above finished grade ✓
Water supply line sleeved adequately at house connection ✓
Adequate grout observed below pitless adapter ✓

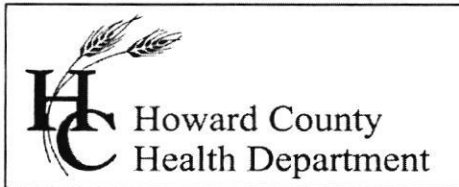

7178 Columbia Gateway Drive, Columbia MD 21046
(410) 313-2640 Fax (410) 313-2648
TDD (410) 313-2323 Toll Free 1-866-313-6300
website: www.hchealth.org

Penny E. Borenstein, M.D., M.P.H., Health Officer

November 8, 2004

Toll MD II Limited Partnership
7164 Columbia Gateway Drive, Suite #230
Columbia, MD 21046

SENT VIA FACSIMILE 410-489-6293

RE: Waterford Farms, Lot 9
31632 Lorenzo Lane
Woodbine, MD 21797
BP # B00146235
Well Permit # HO-94-3533

Dear Sir:

This is to advise you that the septic system for the above referenced property has been installed and inspected. **Final approval of the septic system was granted on 8/10/2004. Final approval of the well line connection to the dwelling was approved on 09/23/2004.**

The water sample results indicate that the water samples submitted for testing were free of coliform and fecal coliform bacteria at the time of sampling and are bacteriologically safe for drinking. The water sample results were found to be in compliance with COMAR water quality standards.

INTERIM CERTIFICATE OF POTABILITY

This certifies that the **initial** sampling requirements of COMAR 26.04.04 "Well Regulations" have been met for the water supply system installed under well permit #HO-94-3533. Although the submitted sample results are in compliance with COMAR standards, the Health Department does not guarantee water supplies. Based upon satisfactory investigation and evaluation, the Howard County Health Department, as authorized by the Maryland Department of the Environment accepts this well system as required by COMAR 26.04.04.

This certificate may become final upon completion of the second bacteriological test, which is to be taken by the county health department within six months of receipt of this letter. **Please contact (410) 313-1773 to schedule a final water sample appointment. Currently, there is no charge for this final sampling.**


Date of Water Sample: 11/02/2004
Date of Well Completion: 11/07/2002

Respectfully,

Kacie Noonan, R. S.
Well and Septic Program

Kn/sjn

cc: Building Inspector's Office
Community Services Program
File

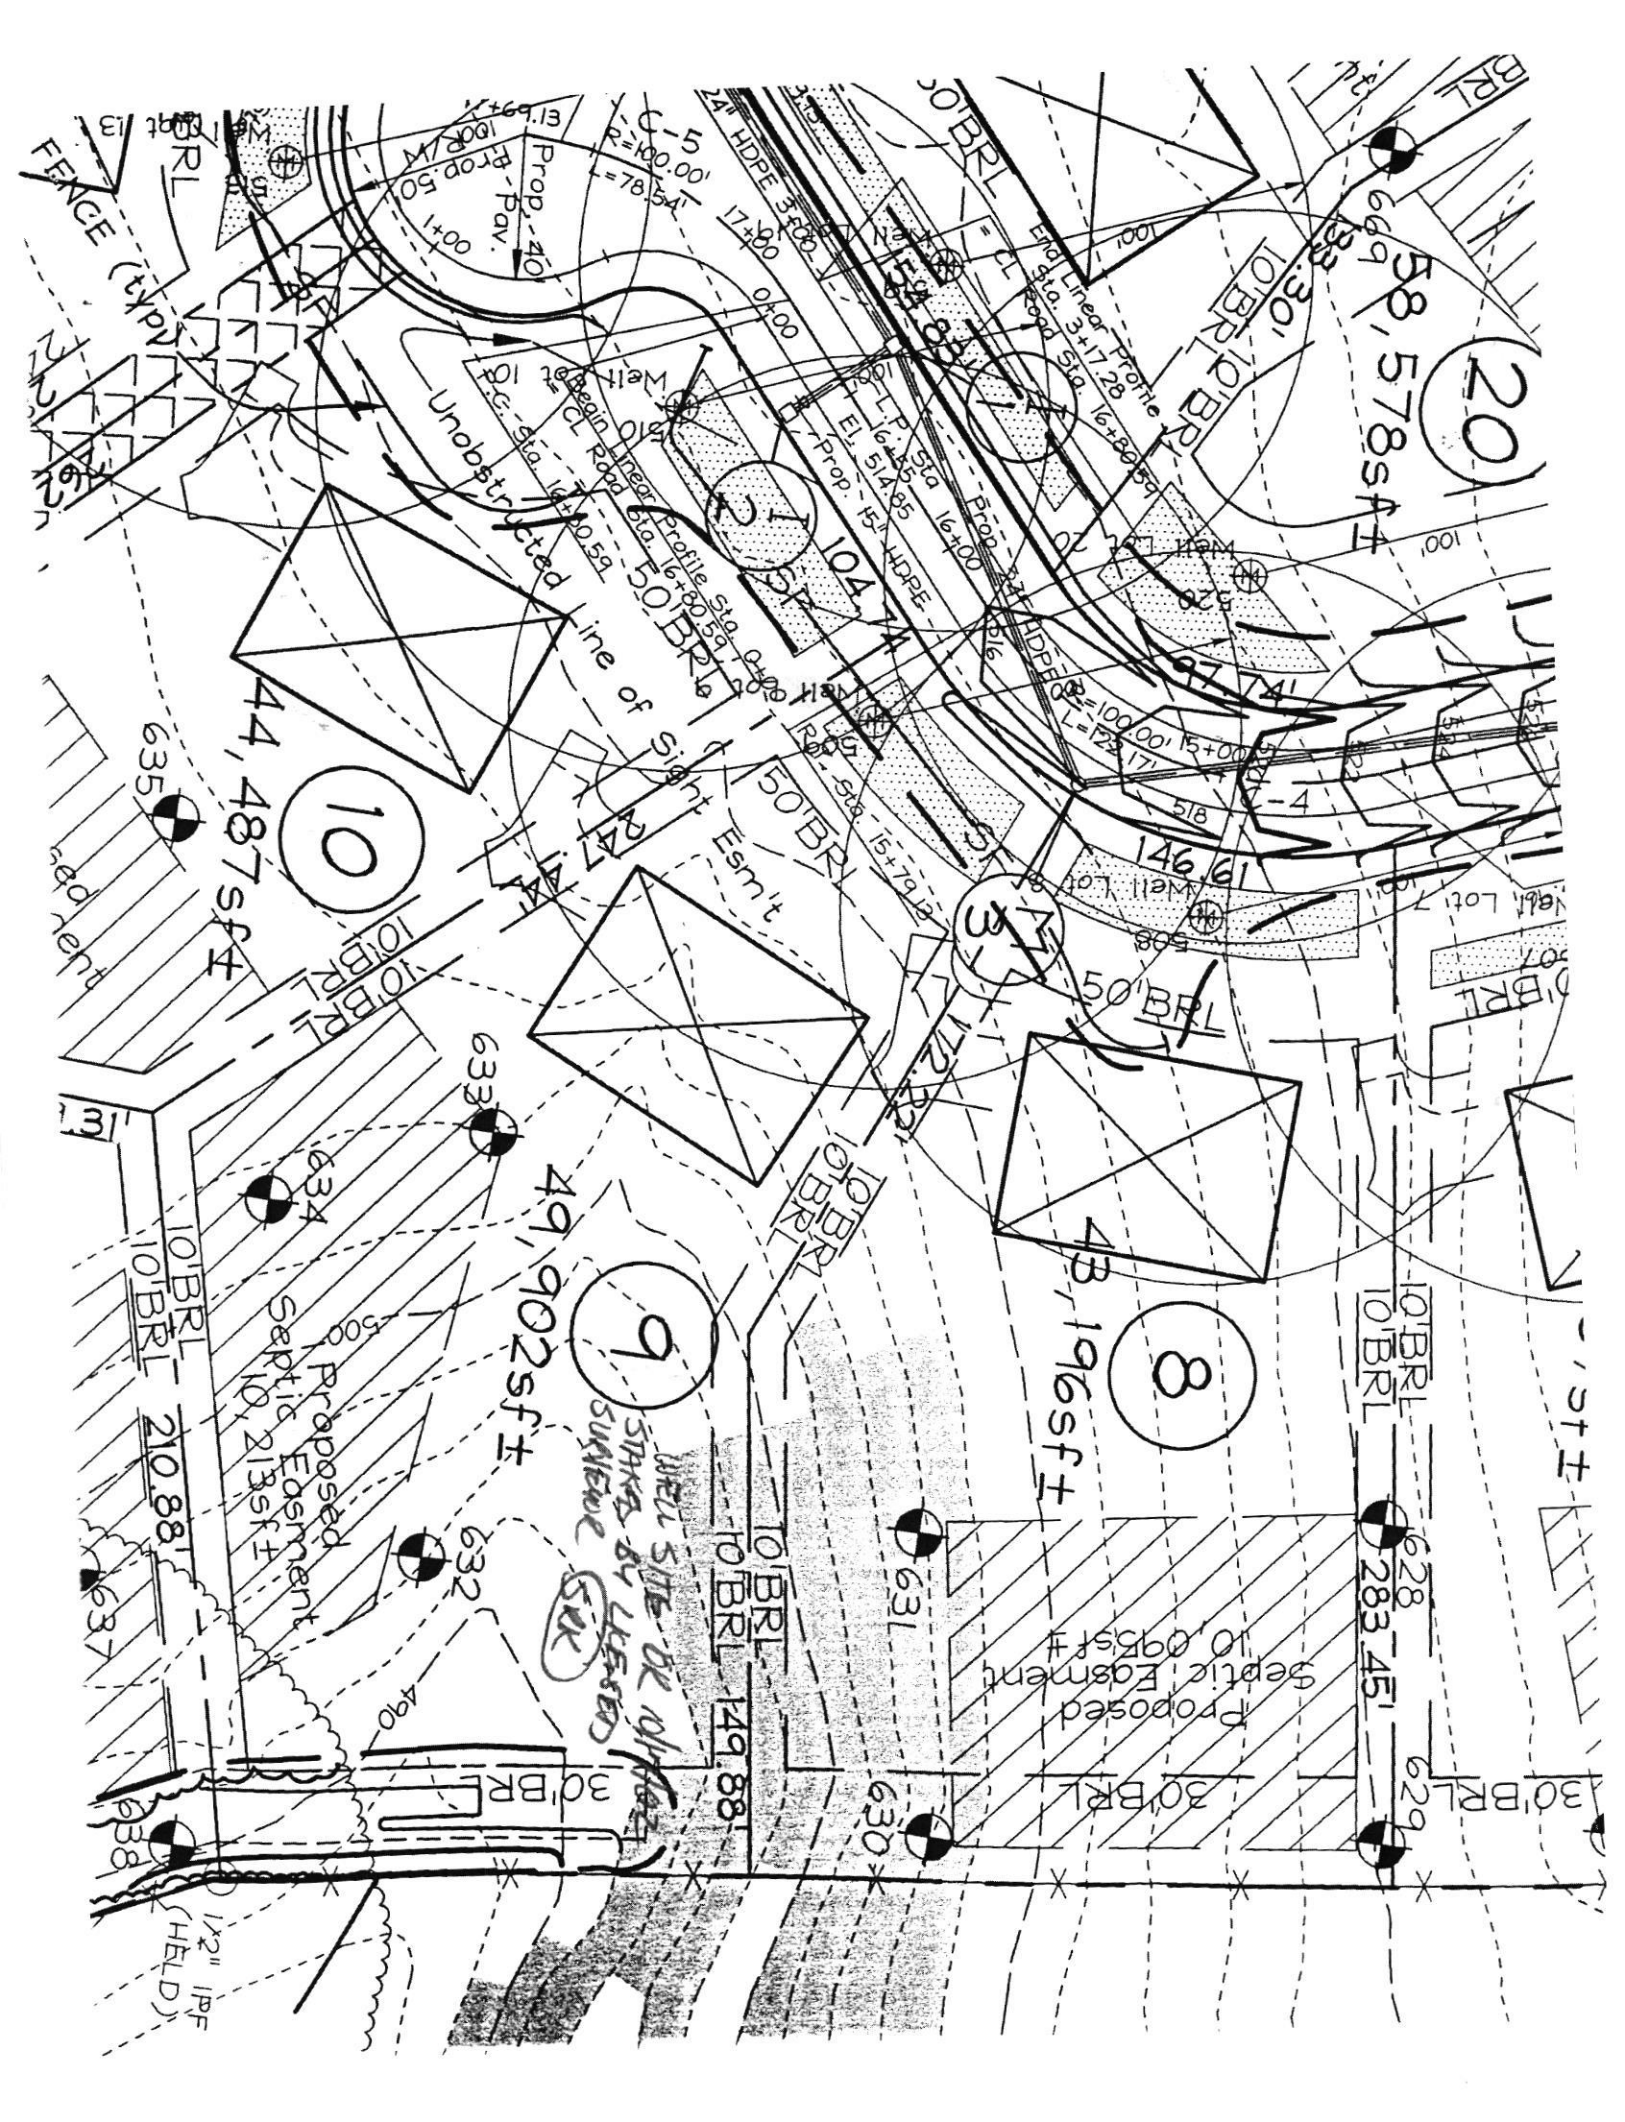



SEE
DETAIL

WELL
HO-94-3533

WELL
HD-9
L=56.57' 8.52'
R=120.00' S35:23:54"E
LORENZO LANE
(40' R/W)

TOP OF FOUNDATION WALL ELEVATION = 514.3'
OFFSET DIMENSIONS TO PROPERTY LINES ARE $\pm 0.1'$

I HEREBY CERTIFY TO THE BEST OF MY PROFESSIONAL KNOWLEDGE, INFORMATION AND BELIEF, THAT THE DIMENSIONS OF THE BUILDING WALLS SHOWN HEREON ARE CORRECT; THAT THEY ARE BASED ON A FIELD RUN SURVEY PERFORMED BY BENCHMARK ENGINEERING, INC. ON 06/14/04; AND THAT THE PROPERTY OUTLINE SHOWN HEREON IS BASED ON THE PLAT PREPARED BY FSH ASSOCIATES, INC. ENTITLED " WATERFORD FARMS LOTS 1 THRU 45 ", AND RECORDED AMONG THE LAND RECORDS OF HOWARD COUNTY AS PLAT No.161164

POURED
CONCRETE
FOUNDATION