



Bureau of Environmental Health

8930 Stanford Boulevard, Columbia, MD 21045

Phone: 410-313-2323 Fax: 410-313-2643
TDD 410-313-2323 | Toll Free 1-866-313-6300

www.hchealth.org

Facebook: www.facebook.com/hchohealth

Twitter: @HowardCoHealthDep

Maura J. Rossman, M.D., Health Officer

APPLICATION

FOR PERCOLATION TESTING AND SITE EVALUATION

PROPERTY LOCATION

SUBDIVISION/PROPERTY NAME

Waterford Farms

PROPERTY ADDRESS

3163 Lorenzo Lane

Woodbine

21797

TAX ACCOUNT #

36773

TAX MAP

20

GRID

12

PARCEL

139

LOT NO.

9

PROPOSED LOT

SIZE (ACRES)

11.146 AC

ZONING CATEGORY

TIER

PROPERTY OWNER(S)

Jeff Baehr

DAYTIME PHONE

410-596-1970

CELL

EMAIL

Jeff.baehr1@gmail.com

MAILING ADDRESS

3163 Lorenzo Lane

Woodbine

21797

APPLICANT

Fogle's Septic

RELATIONSHIP TO OWNER

contractor

DAYTIME PHONE

410-795-5670

CELL

EMAIL

Rim@foglesinc.com

MAILING ADDRESS

580 Obrecht Rd

Sikesville

21784

I HEREBY APPLY FOR THE NECESSARY TESTING/EVALUATION PRIOR TO ISSUANCE OF SEWAGE DISPOSAL SYSTEM PERMIT(S):

PROPERTY:

☐

SUBDIVISION: NUMBER OF LOTS INCLUDING RESIDUE

SUBDIVISION CLASSIFICATION (PER DEPT. OF PLANNING AND ZONING)

☐ MAJOR

☐ MINOR

☐

CONSTRUCT NEW OSDS ON UNDEVELOPED LOT

☒

REPAIR OR REPLACE FAILING OSDS

☐

UPGRADE EXISTING OSDS

BUILDING:

☒

RESIDENTIAL WITH 4 EXISTING OR PROPOSED BEDROOMS IN THE COMPLETED STRUCTURE

☐

COMMERCIAL (PROVIDE DETAIL OF TYPE OF USE AND NUMBERS OF EMPLOYEES/CUSTOMERS ON ACCOMPANYING PLAN)

IS THE PROPERTY WITHIN 2500 FEET OF ANY RESERVOIR?

☐ YES

☒ NO

AS APPLICANT, I UNDERSTAND THE FOLLOWING:

- THIS APPLICATION IS VALID FOR TWO (2) YEARS FROM DATE OF FEE PAYMENT AND APPROVAL IS BASED UPON HEALTH OFFICER SIGNATURE OF A PERC CERTIFICATION PLAN PRIOR TO EXPIRATION OF THIS PERMIT.
- THE APPLICATION FEE IS NON-REFUNDABLE
- THIS APPLICATION MUST BE ACCOMPANIED BY ALL APPLICABLE FEES AND A SUITABLE SITE PLAN IN ORDER TO BE PROCESSED
- THIS IS A PUBLIC DOCUMENT

I declare and affirm that to the best of my knowledge, the information contained herein is correct. I declare that I am the owner of the property or duly authorized to make this application on behalf of the owner. I agree to comply with all applicable state and county regulations.

By signature of this application, I hereby grant Howard County Health Department officials the right to enter onto the property for the purpose of inspecting the property as directly related to the requested permit/service.

SIGNATURE OF APPLICANT

DATE



Bureau of Environmental Health
8930 Stanford Blvd | Columbia, MD 21045
410.313.2640 - Voice/Relay
410.313.2648 - Fax
1.866.313.6300 - Toll Free

Maura J. Rossman, M.D., Health Officer

INFORMATION FORM - SEPTIC SYSTEM REPAIR/UPGRADE

Reason for Request:

- ☒ Failing System
☐ System relocation for proposed addition
☐ System upgrade for proposed addition
☐ Inadequate treatment zone
☐ Collapsed septic tank
☐ Collapsed drywell

Existing system design

- ☐ Drywell
☒ Trench
☐ Mound
☐ Unknown
☐ Other: _____

Is discharge surfacing on the ground?

☒ Yes
☐ No

Additional Comments:

Has the septic tank been pumped within the last month?

☒ Yes Date pumped: 4/1/22
☐ No

Was a visual inspection of the septic tank and/or drain fields conducted?

☒ Yes Explain observation: full trenches
☐ No

Was a visual inspection of the sewage line conducted?

☒ Yes
☐ No

Blockage Leading to the field

☐ Yes Explain _____
☒ No

*For REPAIRS, are the owners proposing, or do they plan to add in the future any additions or modifications to the property, i.e. pools, living space additions, garages, etc? This information must be disclosed at the time of this application. The Health Department will not be able to accommodate requests in the field for property modifications unrelated to the repair request. Such requests may require an additional fee, testing, and submittal of a Percolation Certification Plan, if the property does not meet current Code and Regulations.

Septic Contractor: Pool's Septic
Contractor's Address: 580 Obrecht Rd
Property Address: 3163 Lorenzo Lane
Subdivision: Waterford Farms
Owner's Name: Jeff Baehr
Name of previous owners: _____

Contractor's Phone: 410.795.5670
Syracuse 21784
County File: 367723
Lot: 9 Year Built: 2005
Existing bedrooms: 4
Existing bedrooms: _____
Proposed bedrooms: _____

*A Sanitarian will be in contact within three business days, depending upon the urgency of the situation, to coordinate the scheduling/review of the repair or upgrade.

Prior to scheduling inspections, scaled plans should be submitted to clarify the nature of the addition.

Print out a copy of Real Property Data via Dept. of Taxation website _____ Indexed file found _____

If soil/site conditions are limited and sewer and/or Metro District status is not conducive to connection, the Sanitarian may recommend pursuit of Emergency Sewer Extension or Emergency Metro District Inclusion. The Owner should contact the Bureau of Utilities for details.

No permit is to be issued nor inspection to be scheduled without prior fee collection at the office unless an emergency exists.

The contractor is to notify the office of the emergency as soon as possible.

2/2020


1: Br Rd L
WK Co SEK,
Friedla

2
ii Br / Red C
M COSPK
10% rx.
15% separation

51 1: Br/Y FSL
Wk & 30K,
micaceous

8. BC/R/YFSL
wk & pl.
Highly nervous
10% subset

151

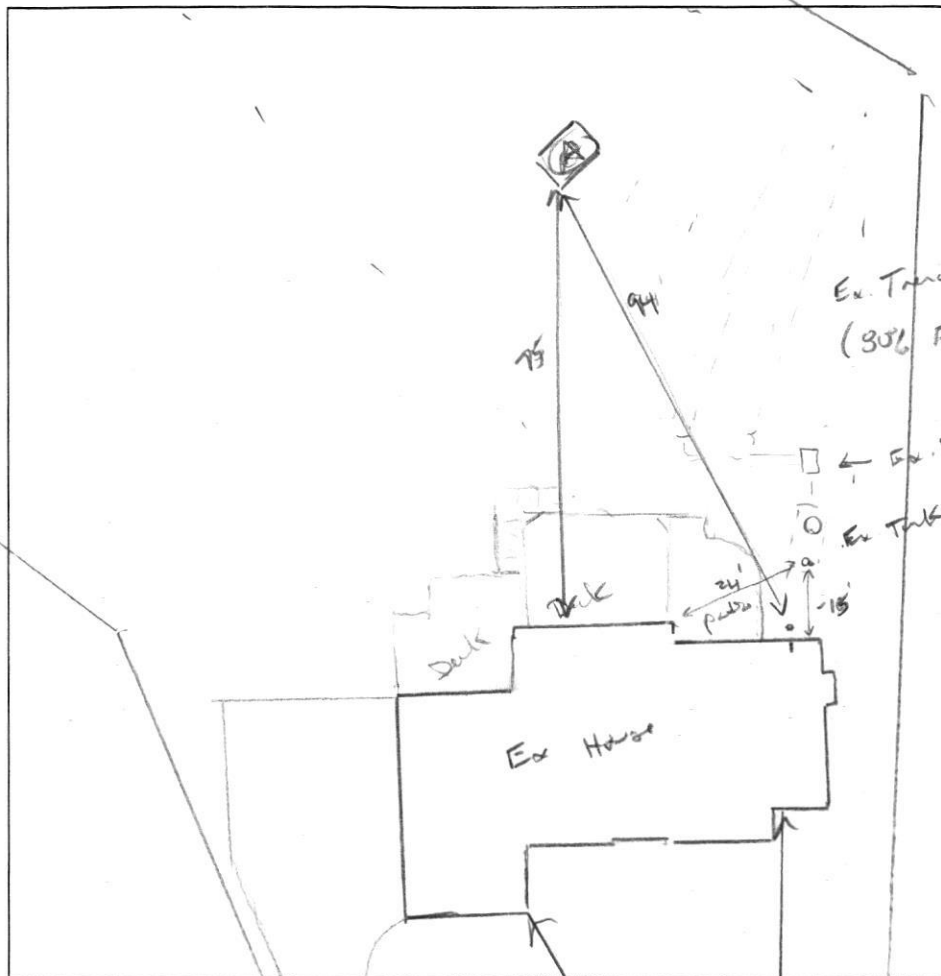

DATE	TEST #	DEPTH	START	BREAK 1" DROP	STOP 2" DROP	TIME OF 2ND INCH	P/F/H
						JV	
						H0-94-3-	
4/27/22	(A)	5' / 14 3"	00:10	00:17	00:30	13	P
		H ₂ O poured @ 14'			—	~ 10 mi.	

REMARKS Ex. trends exposed

SANITARIAN K. Wolf BACKHOE Smiley = Fyles OTHERS home owners

TEST HOLES USED IN SDA _____ AVG. PERC TIME _____ SQ. FT/BR _____

TRENCH WIDTH 3 INLET DEPTH 3 MAX. BOT DEPTH 8 EFFECTIVE SW 5'-8" (.59)

$$SBR = \frac{750}{0.8} - 937.5 \div 3 = 312 (1.50) = 156.25$$

RECEIPT

Howard County, MD
HOWARD COUNTY HEALTH DEPARTMENT
ASCEND ONE BUILDING
Columbia, MD 21045
8930 STANFORD BLVD

Application: WS-PT-22-01140

Application Type: EnvHealth/Well and Septic/Percolation Test/Application

Address: 3163 Lorenze LN,

Receipt No.	3630					
Payment Method	Ref Number	Amount Paid	Payment Date	Cashier ID	Received	Comments
Check	75496	\$165.00	04/21/2022	JUKING		Perc/Repair 3163 Lorenze Lane

Work Description: Perc/Repair 3163 Lorenze Lane

APPLICATION

PERCOLATION TESTING

A 514952

P _____

HOWARD COUNTY HEALTH DEPARTMENT

BUREAU OF ENVIRONMENTAL HEALTH

3525-H ELLICOTT MILLS DRIVE/ELLICOTT CITY, MARYLAND 21043
TELEPHONE: 313-2640

DISTRICT _____

DATE 2/28/01

TO: THE COUNTY HEALTH OFFICER
ELLICOTT CITY, MARYLAND

I HEREBY APPLY FOR THE NECESSARY TEST PRIOR TO APPLICATION FOR PERMIT TO CONSTRUCT (OR RECONSTRUCT) A SEWAGE DISPOSAL SYSTEM.

PROPERTY OWNER Waterford Farm Joint Venture

ADDRESS 4003 Jennings Chapel Rd PHONE _____
Brookville MD 20833

AGENT OR PROSPECTIVE BUYER _____

ADDRESS _____ PHONE _____

PROPERTY LOCATION:

SUBDIVISION Waterford Property LOT NO. 9

ROAD AND DESCRIPTION Daisy Road

TAX MAP 13, 14, 20, 21 PARCEL # 20

SIZE OF LOT _____ TYPE BLDG. SFD
(SINGLE FAMILY DWELLING OR COMMERCIAL)

THE SYSTEM INSTALLED UNDER THIS APPLICATION IS ACCEPTABLE ONLY UNTIL PUBLIC FACILITIES BECOME AVAILABLE. I FULLY UNDERSTAND THE FEE CONNECTED WITH THE FILING OF THIS PERC TEST APPLICATION IS NON-REFUNDABLE UNDER ANY CIRCUMSTANCES. I ALSO AGREE TO COMPLY WITH ALL M.O.S.H.A. REQUIREMENTS IN TESTING THIS LOT.

Charles A. Shinn
(SIGNATURE OF APPLICANT)

APPROVED BY _____ FOR _____ DATE _____

DISAPPROVED BY _____ FOR _____ DATE _____


HOLD PENDING FURTHER TESTS _____

REASONS FOR REJECTION OR HOLDING _____

PERCOLATION TEST PLAT/PRELIMINARY PLAT - TITLE OR I.D. # _____ DATE _____

SITE DEVELOPMENT PLAN/FINAL PLAT - TITLE OR I.D. # _____ DATE _____

THIS IS NOT A PERMIT

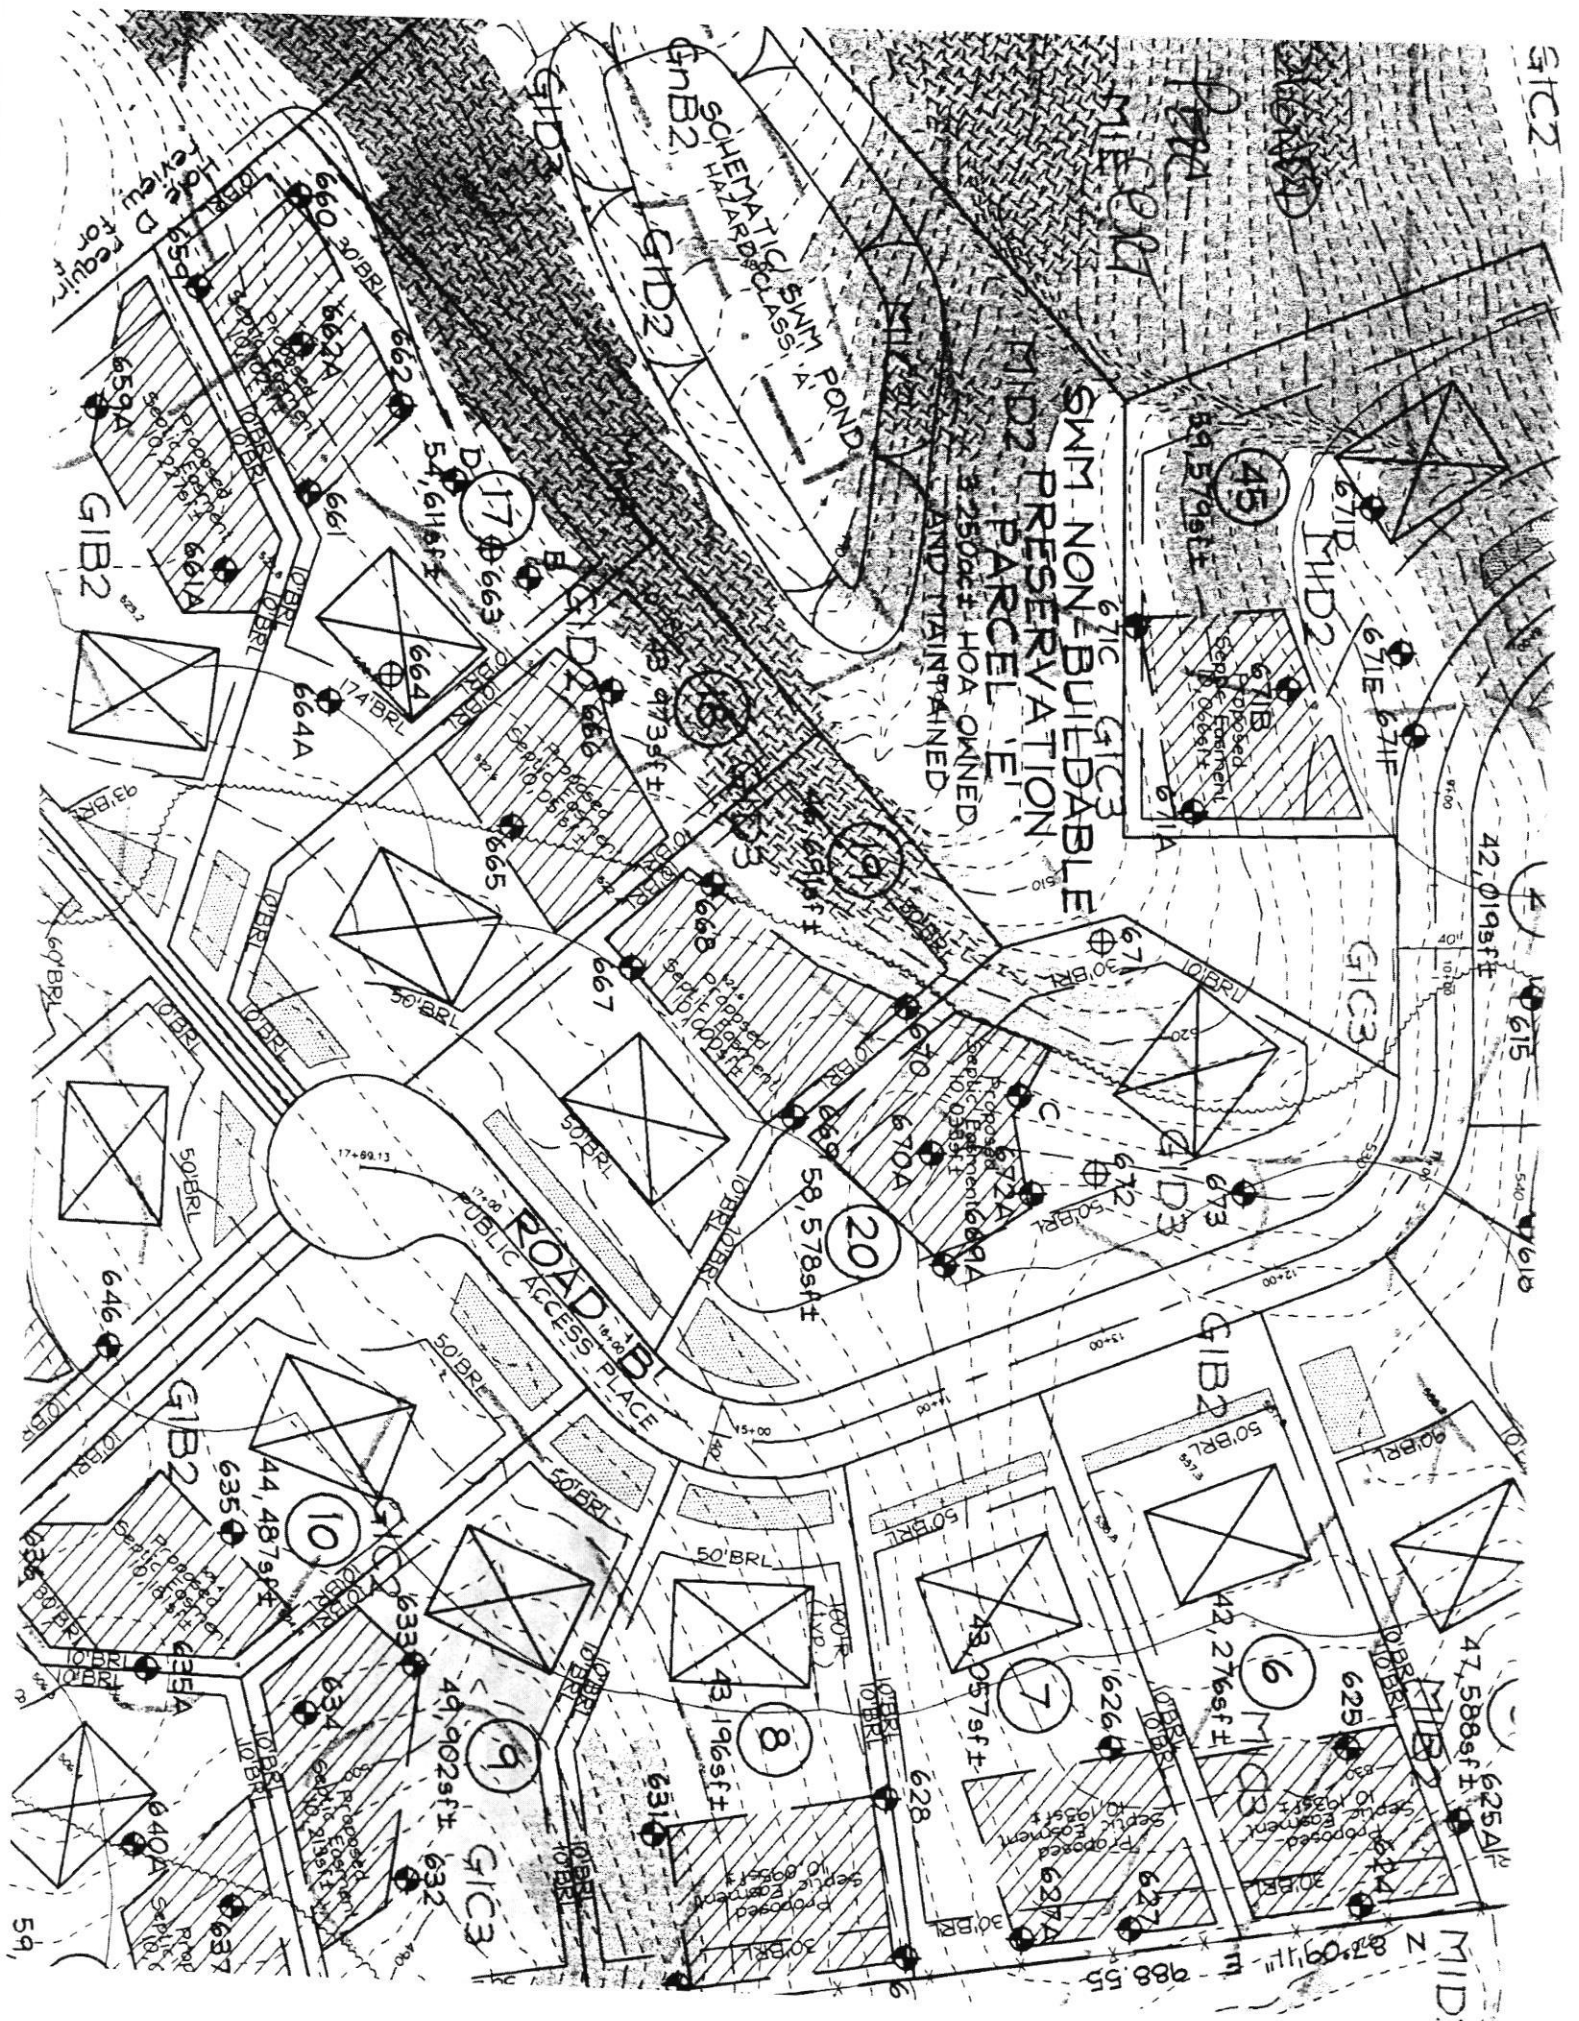

15152 FH
COUNTY #

Lot 9

SOIL PROFILE

0' 632/633/634


4'6"
red-brown clay loam
tan-fine sandy loam
20-30% mica schist
13'

638

6'1"
brown topsoil
red-brown clay loam
2'
tan fine-sandy loam
0-5% mica schist
12'

639/640

4'
red-brown clay loam
orange-brown silty clay loam
35-45% frags
13'

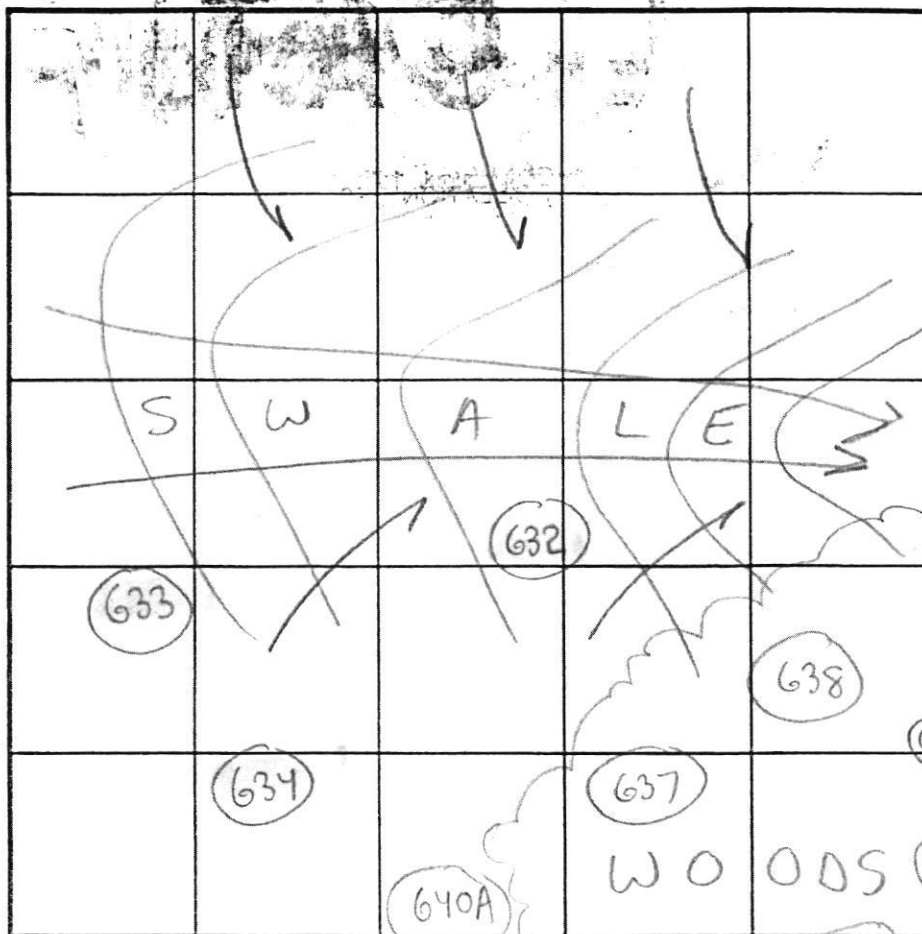

INDICATE NORTH - NAME ADJOINING ROADWAY AS BASE LINE.

SOIL PROFILE

0' 637

3'
red-brown clay loam
tan fine-sandy loam
0-5% mica schist
12'

639A/640A

orange-brown clay loam
tan-orange silt loam
20-30% Rx
4 1/2'

DATE	TEST NO.	DEPTH	PRE-WET START	PRE-WET STOP	TEST - 1" DROP START	TEST - 1" DROP STOP	TIME	
6/4/01	632	5'T / 13'V	3:42pm	3:44pm	3:44pm	3:54pm	10 min	OK
	633	13'V	(VISUAL OK)		SEE	SOIL PROFILE)		OK
	634	3'5" T / 13'V	4:09pm	4:13pm	4:13pm	4:25pm	12 min	OK
	638	12'V	(VISUAL OK)		SEE	SOIL PROFILE)		OK
	639	3'T / 12'V	3:52am	4:07am	4:07am	4:20am	13 min	HOLD
	(HOLD	FOR RE-EVALUATION OF ROCK CONTENT)						
	640	3'T / 12'V	4:23am	4:35am	4:35am	4:51am	16 min	HOLD
	637	12'V	(VISUAL OK)		SEE	SOIL PROFILE)		OK
8/6/01	639A	14'V	(VISUAL OK)		SEE	SOIL PROFILE)		OK
	640A	4'T / 14'V	12:38pm	12:41pm	12:41pm	12:44pm	3 min	OK

REMARKS Potential Adjustment of SDA for proposed Lot 16 may be necessary

TYPE OF SOIL Glenelg

TESTED BY SRN

Jeff Allen = Backhoe
Chuck Sharp

ALSO PRESENT Francois

TRENCH DESIGN DATA: AVERAGE PERCOLATION TIME 3 min

TRENCH WIDTH 3'

INLET DEPTH 3'

MAXIMUM BOTTOM DEPTH 5'

SO FT/BEDROOM 180-210

LINE	LENGTH	BEARING
F1	32.57	S84°24'24"W
F2	70.67	N68°21'13"W
F3	57.03	N49°44'30"W
F4	66.88	N60°25'45"W
F5	81.22	N71°43'16"W
F6	106.13	N56°07'04"W

