

C 1- 9294

SEQUENCE NO.
(WRA USE ONLY)

STATE OF MARYLAND
WATER RESOURCES ADMINISTRATION
TAWES STATE OFFICE BLDG., ANNAPOLIS, MD. 21401
WELL COMPLETION REPORT

THIS REPORT MUST BE SUBMITTED WITH-
IN 30 DAYS AFTER WELL COMPLETION

FILL IN THIS FORM COMPLETELY

COUNTY
NUMBER A23987DATE RECEIVED
(WRA USE ONLY)

DATE WELL COMPLETED

DEPTH OF WELL

22 (TO NEAREST FOOT) 26

PERMIT NO. FROM "PERMIT TO DRILL WELL"

28 29 30 31 32 33 34 35 36 37

DRILLERS IDENTIFICATION NO.

OWNER

LAST NAME

FIRST NAME

STREET OR RFD

POST OFFICE

WELL DESCRIPTION

WELL LOG

STATE THE KIND OF FORMATIONS PENETRATED, THEIR
COLOR, DEPTH, THICKNESS AND IF WATER BEARINGDESCRIPTION
(USE ADDITIONAL SHEETS
IF NECESSARY)

FEET

FROM

TO

CHECK IF
WATER
BEARING

GROUTING RECORD

WELL HAS BEEN GROUTED
(CIRCLE APPROPRIATE BOX)

YES

NO

Y

N

TYPE OF GROUTING MATERIAL (CIRCLE BOX)

CEMENT

BENTONITE CLAY

NO. OF BAGS

NO. OF POUNDS

GALLONS OF WATER

DEPTH OF GROUT SEAL (TO NEAREST FOOT)

FROM 48 FT. TO 54 FT.
(ENTER 0 IF FROM SURFACE)

CASING RECORD

CASING
TYPESINSERT
APPROPRIATE
CODE
BELOW

S T

C O

STEEL

CONCRETE

P L

O T

PLASTIC

OTHER

MAIN
CASING
TYPENOMINAL DIAMETER
TOP (MAIN) CASING
(NEAREST INCH)TOTAL DEPTH
OF MAIN CASING
(NEAREST FOOT)

60 61

63 64 65

70

OTHER CASING (IF USED)

DIAMETER
(INCH)DEPTH (FEET)
FROM TOSCREEN TYPE
OR OPEN HOLE

SCREEN RECORD

INSERT
APPROPRIATE
CODE
BELOW

S T

B R

H O

STEEL

BRASS
OR BRONZE

OPEN HOLE

P L

O T

PLASTIC

OTHER

C 2

(SEQ. NO.) 6

DEPTH (NEAREST WHOLE FOOT)

EACH
SCREEN

1 2 3

8 9 11 15 17 21

23 24 26 30 32 36

38 39 41 45 47 51

SLOTSIZE 1. 2. 3.

DIAMETER OF SCREEN

56 60 (NEAREST INCH)

FROM TO

GRAVEL PACK

IF WELL DRILLED WAS A
FLOWING WELL CIRCLE BOX

68 F

WRA USE ONLY (NOT TO BE FILLED IN BY DRILLER)

(E.R.O.S.)

W Q

70 72 74 75 76

TELESCOPE
CASINGLOG
INDICATOROTHER DATA
AVAILABLE

PUMPING TEST

HOURS PUMPED (TO NEAREST HOUR)

PUMPING RATE
(GALLONS PER MINUTE TO NEAREST GALLON)METHOD USED TO
MEASURE PUMPING RATE

WATER LEVEL: (DISTANCE FROM LAND SURFACE)

BEFORE
PUMPINGWHEN
PUMPINGTYPE OF PUMPED USED (CIRCLE APPROPRIATE BOX)
(FOR PUMPING TEST)

A AIR

P PISTON

T TURBINE

C CENTRIFUGAL

R ROTARY

O OTHER
(DESCRIBE
BELOW)

J JET

S SUBMERSIBLE

PUMP INSTALLED

TYPE OF PUMP (WRITE APPROPRIATE LETTER IN
BOX - SEE ABOVE: A, C, J, P, R, S, T, O)DRILLER WILL INSTALL PUMP
(CIRCLE APPROPRIATE BOX)

CAPACITY:

GALLONS PER MINUTE
(TO NEAREST GALLON)

PUMP HORSE POWER

PUMP COLUMN LENGTH
(NEAREST FOOT)CASING HEIGHT (CIRCLE APPROPRIATE BOX
AND ENTER CASING HEIGHT)

+ ABOVE

- BELOW

LAND SURFACE

(NEAREST
FOOT)

LOCATION OF WELL ON LOT

SHOW PERMANENT STRUCTURE SUCH AS BUILDINGS,
SEPTIC TANKS, AND/OR OTHER LAND MARKS AND
INDICATE NOT LESS THAN TWO DISTANCES
(MEASUREMENTS TO WELL).

CIRCLE APPROPRIATE BOXES

A A WELL WAS ABANDONED AND SEALED WHEN THIS
WELL WAS COMPLETED

E ELECTRIC LOG OBTAINED

P TEST WELL CONVERTED TO PRODUCTION WELL

I HEREBY CERTIFY THAT I HAVE COMPLIED WITH ALL
CONDITIONS STATED ON THE ABOVE-CAPTIONED "PERMIT
TO DRILL WELL", AND THAT INFORMATION CONTAINED
IN THIS REPORT IS TRUE, ACCURATE, AND COMPLETE
TO THE BEST OF MY KNOWLEDGE, INFORMATION AND
BELIEF.

DRILLERS NAME

(PLEASE
PRINT)

SIGNATURE

RECEIVED

JAN 9 9 32 AM '78
HOWARD COUNTY
HEALTH DEPT.
ELLCOTT CITY, MD.

A23987

30

18" drainage pipe at 1' below O.G.
this line is 4-5' below O.G.
LOT 31
RIP RAP
DRAINAGE EASEMENT

- (1) well site relocated
- (2) house site questionable?
- (3) trench needed to composite for drywell "damage"


approximate location of system on A3 6 June 79
(64)

COPY OF
SIGNED
PLAT

LAND AREA = 1.4285 ac.

ISLE OF SKYE DRIVE

HOLLY LOCH LANE

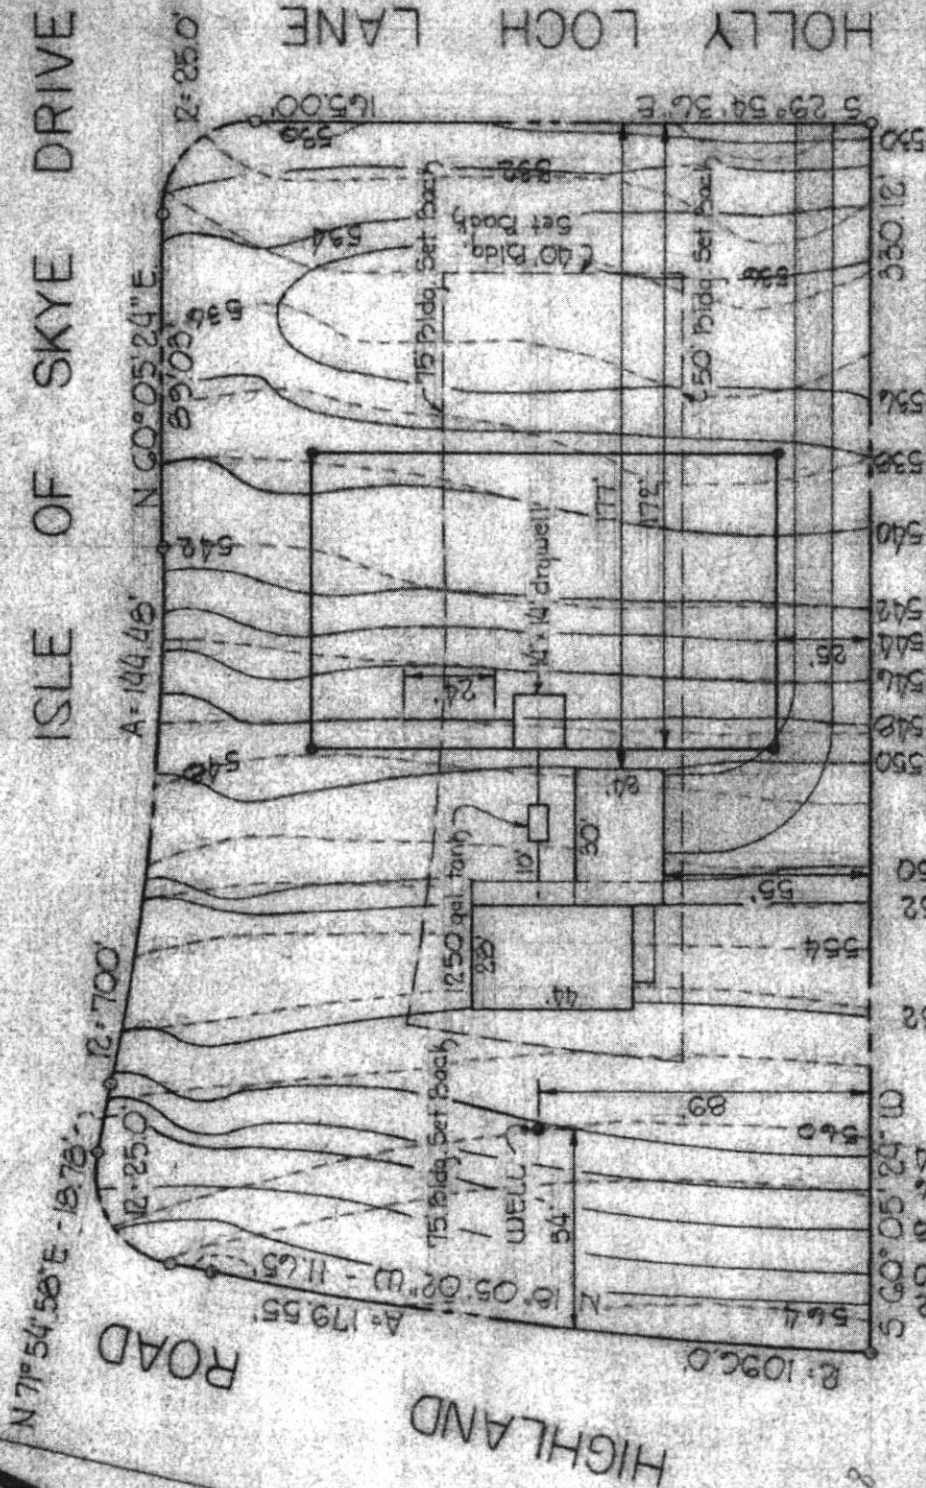

COSTELLO BUILDERS CORP.

DESIGNED BY	Wm. Young
LOT NUMBER	24
DATE	
SCALE	1" = 50'
APPROVED BY	
SITE PLAN	
13120 Holly Loch Lane	
HIGHLAND LAKE - SECTION I	
DEALING NUMBER	5P-1

DRYWELL DATA

Inv. in drupwell	543.00
Inv. out septic tank	545.21
Inv. in septic tank	543.46
Inv. out of dwelling	543.63
Trench inlet	542.00
Basement elevation	544.75
First floor elevation	553.50
Well	560.00

Handwritten notes:
 11/1/78
 W. Young
 D.W. and family
 purchased

A23987

24

2-26-80

Handwritten note, possibly "Handwritten"

15' →



C.O. 30" long