**Bureau of Environmental Health**

8930 Stanford Boulevard, Columbia, MD 21045

Main: 410-313-2640 | Fax: 410-313-2648

TDD 410-313-2323 | Toll Free 1-866-313-6300

www.hchealth.orgFacebook: www.facebook.com/hocohealth

Maura J. Rossman, M.D., Health Officer

| | | |
|--|--------------------------------------|--------------------------|
| RECEIPT DATE: <u>6/24/2022</u> | ONSITE SEWAGE DISPOSAL SYSTEM | P |
| APPROVAL DATE: <u>6/29/22</u> (S) | PERMIT: REPAIR | A Repair |
| PROPERTY ADDRESS: <u>12357 Scaggsville Road</u> | | |
| SUBDIVISION: <u>n/a</u> | LOT: _____ | TAX ID: <u>05-348633</u> |
| CONTRACTOR: <u>Tolley Enterprises Inc</u> | EMAIL: _____ | |
| CONTRACTOR ADDRESS: <u>11920 Lynn Crest Road, Monrovia, MD 21770</u> | PHONE: <u>301-831-6037</u> | |
| PROPERTY OWNER: <u>Esteban Pizarro</u> | EMAIL: <u>estpig@hotmail.com</u> | |
| OWNER ADDRESS: _____ | PHONE: <u>703-470-5540</u> | |
| SEPTIC TANK SIZE: <u>1500</u> | PUMP TANK CAPACITY: <u>1250</u> | PUMP SIZE: <u>1/3hp</u> |

DISTRIBUTION SYSTEM: ☒ GRAVITY ☐ PRESSURE DOSED BEDROOMS: 3 APPLICATION RATE: 0.8

| | | |
|-----------|--|--|
| TRENCHES: | LINEAR FEET REQUIRED: <u>80</u> | INLET DEPTH: <u>2</u> |
| | TRENCH WIDTH: <u>3</u> | MAXIMUM BOTTOM DEPTH: <u>9</u> |
| | MINIMUM SPACE BETWEEN TRENCHES: <u>n/a</u> | EFFECTIVE AREA BEGINNING DEPTH: <u>5</u> |
| LOCATION: | TO BE STAKED BY SANITARIAN DURING PRE-CONSTRUCTION INSPECTION. | |
| NOTES: | System is to be designed above perc test B. Install new septic tank just beyond 100ft well radius. Set new pump tank just beyond septic tank. Install 1 x 80 ft trench on contour. Currently the house is a 3 bedroom. Electrical permit is required for the pump. | |

ISSUED BY: K. Wolf, L.E.H.S. ISSUE DATE: 6/24/2022 EXPIRATION DATE: 6/24/2023


- NOTE: CONTRACTOR MUST SCHEDULE A PRE-CONSTRUCTION INSPECTION PRIOR TO BEGINNING ANY INSTALLATION
- NOTE: CONTRACTOR MUST SCHEDULE AN INSPECTION AND GAIN APPROVAL OF ALL COMPONENTS PRIOR TO COVERING
- NOTE: STONE MUST BE APPROVED BY HEALTH DEPARTMENT AND GRAVEL TICKET MUST BE AVAILABLE FOR REVIEW.
- NOTE: WATERTIGHT SEPTIC TANKS REQUIRED
- NOTE: ALL PARTS OF SEPTIC SYSTEM SHALL BE AT LEAST 100 FEET DOWNGRADIENT FROM ANY WATER WELL
- NOTE: MANHOLE RISERS REQUIRED ON ALL SEPTIC TANKS AND PUMP CHAMBERS
- NOTE: AN ELECTRICAL PERMIT IS REQUIRED FOR INSTALLATION OF ANY ELECTRICAL COMPONENTS OF THE SYSTEM
- ☒ ELECTRICAL PERMIT ISSUED E _____
- NOTE: THE HCHD DOES NOT WARRANTY ANY SYSTEM AND CANNOT GUARANTEE THE PERFORMANCE OF THIS SYSTEM AS DESIGNED. BY ACCEPTING THIS PERMIT, THE OWNER AND/OR APPLICANT ACKNOWLEDGE THAT THE SPECIFICATIONS DETAILED IN THIS DESIGN ARE ONE POSSIBLE OPTION AND THAT THE HCHD WILL REVIEW OTHER PROPOSALS. YOU HAVE THE OPTION TO SEEK THE ADVICE OF A QUALIFIED DESIGN CONSULTANT OR PROFESSIONAL ENGINEER FOR FURTHER GUIDANCE.
- NOTE: AN INDIVIDUAL CERTIFIED BY MDE AND THE MANUFACTURER FOR BAT INSTALLATION MUST BE PRESENT AT ALL TIMES DURING BAT INSTALLATION.
- NOTE: MDE RECOMMENDS SEPTIC TANKS, BAT, AND OTHER PRETREATMENT UNITS BE PUMPED AT A FREQUENCY ADEQUATE TO ENSURE THAT SOLIDS ARE NOT DISCHARGED TO THE DISPOSAL AREA

NEITHER THE HOWARD COUNTY COUNCIL NOR THE HEALTH DEPARTMENT IS RESPONSIBLE FOR THE
SUCCESSFUL OPERATION OF ANY SYSTEM.

PERMITTEE RESPONSIBLE FOR OBTAINING FINAL APPROVAL ON THIS PERMIT.

CALL 410-313-1771 TO SCHEDULE INSPECTIONS.

NOT TO SCALE

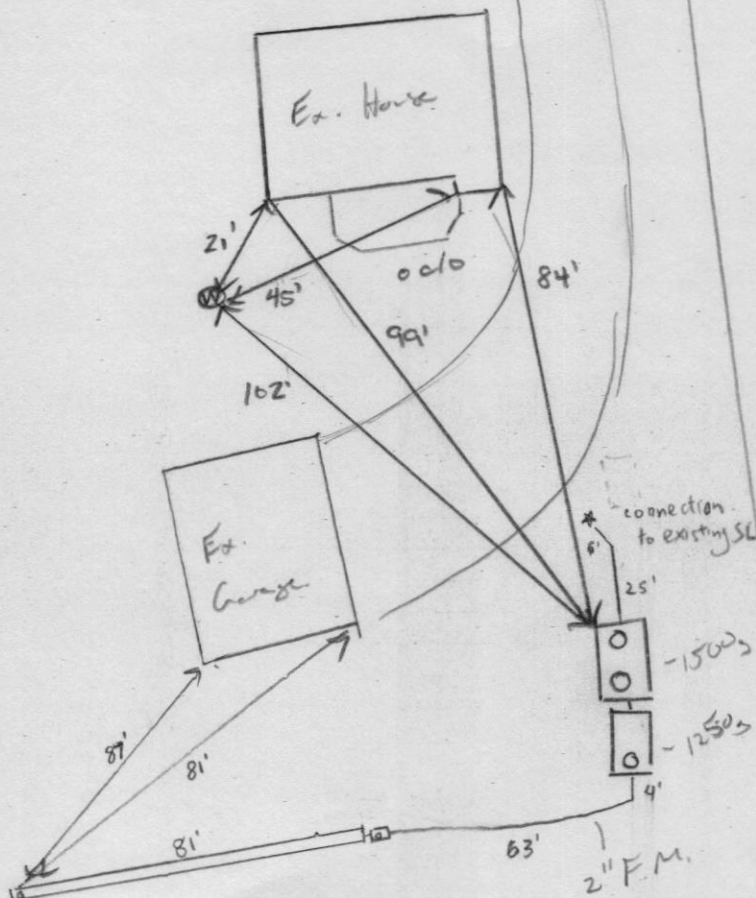

ROAD NAME

TRENCH/DRAINFIELD DATA

WIDTH 3' INLET 2.5' BOTTOM 9'

NUMBER OF TRENCHES 1

TOTAL LENGTH 81'

ABSORPTION AREA 243 sq ft + side wall

DISTRIBUTION BOX LEVEL N/A

DISTRIBUTION BOX BAFFLE Cement

DISTRIBUTION BOX PORT PVC

SEPTIC TANK DATA

SEPTIC TANK 1 LEVEL YES

MANUFACTURER BABYLON

CAPACITY 1500 GAL

SEAM LOC TOP

TANK LID DEPTH 2'

BAFFLES inlet + outlet

BAFFLE FILTER -

MANHOLE LOC FRONT/BACK

6" PORT LOC -

WATERTIGHT TEST -

SLOTTED YES

DATE ON LID 05/10/2022

PUMP/SEPTIC TANK LEVEL YES

MANUFACTURER BABYLON

CAPACITY 1250 GAL

SEAM LOC TOP

TANK LID DEPTH -

BAFFLES -

BAFFLE FILTER -

MANHOLE LOC BACK

6" PORT LOC -

WATERTIGHT TEST -

SLOTTED -

DATE ON LID 11/09/2021

PRE-CONSTRUCTION:

6/24/22 met w/ new contractor to go over install. Set new tanks outside 100' well aris. Install new D-box @ start of trench. Trench staked out in field. Contour previously shot @ time of pre. Must pull electrical permit (RM)

INSTALLATION: 06/28/2022 EX CINDERBLOCK SEPTIC PUMPED AND COLLAPSED.

NEW TANKS INSTALLED. OUTLET BAFFLE INSTALLED. 6/29/22 FM installed, d-box set and 1x81' trench installed. Inlet baffle installed. Front line installed and connected to existing SL. Pump shown to function with water flowing in d-box. Alarm observed to function located on side of garage. Alarm and pump on separate circuits. (SB)

FINAL INSPECTOR

Susan Thomas

DATE OF APPROVAL

6/29/22



RECEIPT

Howard County, MD
HOWARD COUNTY HEALTH DEPARTMENT
ASCEND ONE BUILDING
Columbia, MD 21045
8930 STANFORD BLVD

Application: WS-SP-APP-22-00153
Application Type: EnvHealth/Well and Septic/Sewage Disposal System/Application
Address: 12357 SCAGGSVILLE RD, FULTON, MD 20759

| | | | | | | |
|-------------------|---|-------------|--------------|------------|----------|----------|
| Receipt No. | 4316 | | | | | |
| Payment Method | Ref Number | Amount Paid | Payment Date | Cashier ID | Received | Comments |
| Credit Card | | \$165.00 | 06/24/2022 | VDEKRONEY | | |
| Owner Info.: | ESTEBAN PIZZARO 12357 SCAGGSVILLE ROAD FULTON, MD 20759 | | | | | |
| Work Description: | | | | | | |