



1111 South Pleasant Valley Road  
Westminster, MD 21158  
410-848-2534 410-876-3535  
FAX 410-848-1490  
[www.gallagherpools.com](http://www.gallagherpools.com)

Howard County Health Department  
Bureau of Environmental Health  
7178 Columbia Gateway Drive  
Columbia, MD 21046  
Attn: Gabriel Creighton

308000524

RE: Variance of Perc. Cert. Drawing

Dear Mr. Creighton,  
I am writing to request an approval from your office to request a variance from the Howard County Code that requires a scale drawing showing placement of the proposed site for replacement well and septic on the property listed below.

Property Owners: Jim & Karen Heinz  
Address: 15490 Union Chapel Road  
Woodbine, MD 21797

Our company has been contracted by the owner to install an Inground swimming pool. When I visited your office yesterday we both discovered that the only plot plan either of us has is very old and at that time did not require such replacements to be shown. The property is approximately 19 acres, and there should be no problem with finding a suitable replacement site for both well and septic.

I appreciate you taking the time to consider my request and will work with you in any way possible to see that this matter gets taken care of as soon as possible. My clients are eager for this project to get started.

Respectfully,


  
Debbie Gist  
410-876-3535  
[Debbie@gallagherpools.com](mailto:Debbie@gallagherpools.com)

  
Jim Heinz

SITE INSPECTION SHEET

OWNER: \_\_\_\_\_ PHONE #: \_\_\_\_\_  
ADDRESS: 15490 Union Chapel Rd. CONTRACTOR: \_\_\_\_\_  
WELL TAG #: \_\_\_\_\_  
SUBDIVISION: \_\_\_\_\_ LOT: \_\_\_\_\_ COUNTY #: \_\_\_\_\_  
PROPOSAL: In-ground swimming pool

LOCATION DIAGRAM

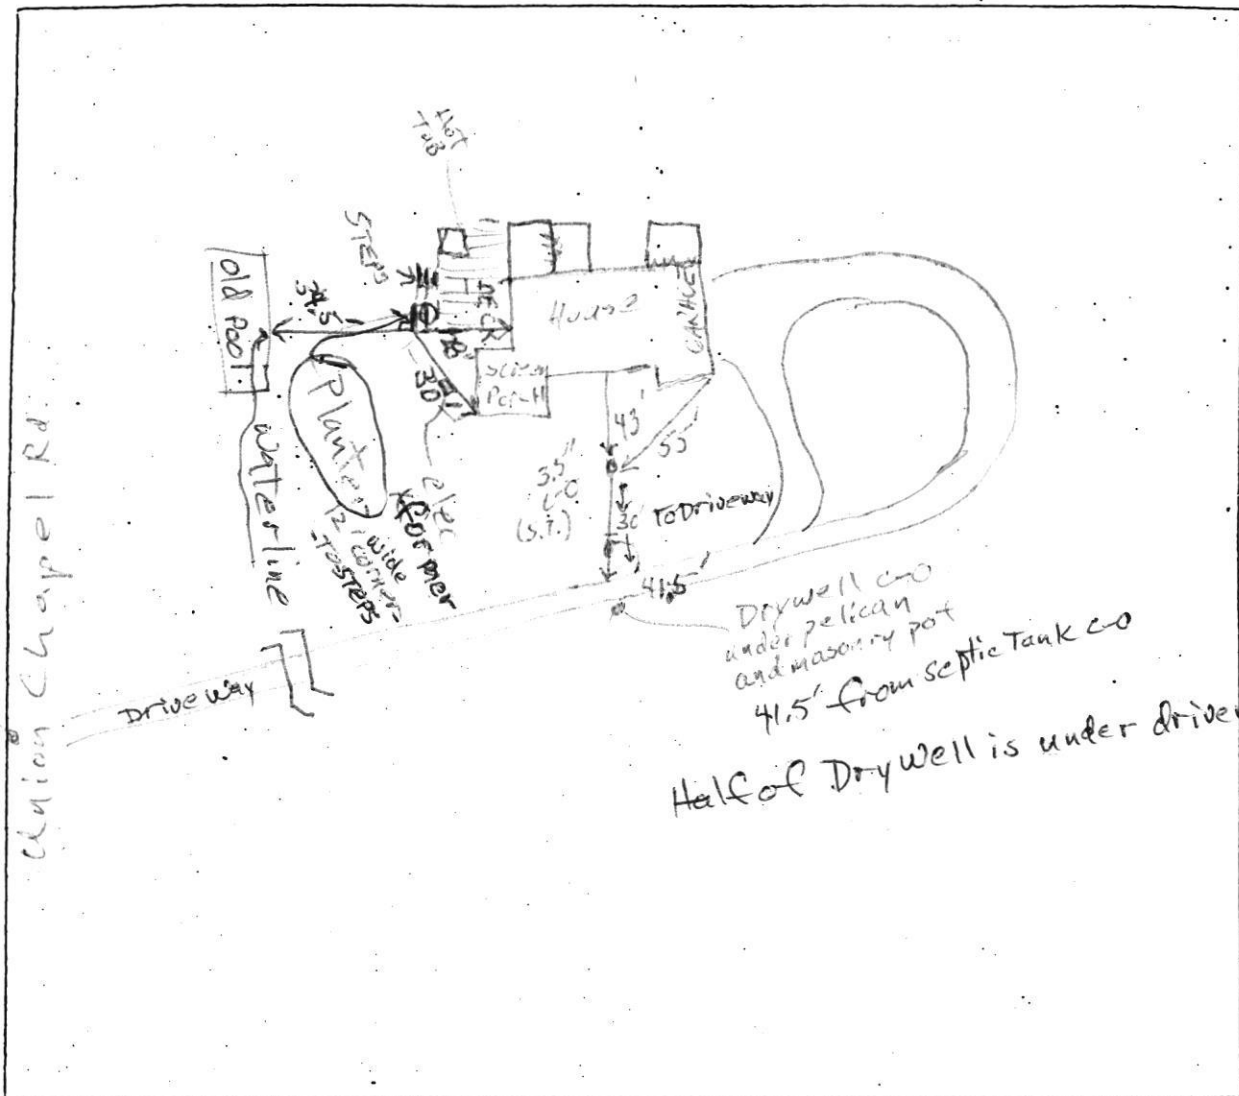

COMMENTS: Plaster corner to waterline of old pool is 34.5'  
Robert B



