


SITE INSPECTION SHEET

OWNER: Robert & Hiranya Patterson PHONE #: _____
ADDRESS: 1124 Taylor Park CONTRACTOR: _____
Sykesville 21784 WELL TAG #: _____
SUBDIVISION: _____ LOT: _____ COUNTY #: _____
PROPOSAL: Screen enclosure for patio, well is 7' from patio.

LOCATION DIAGRAM

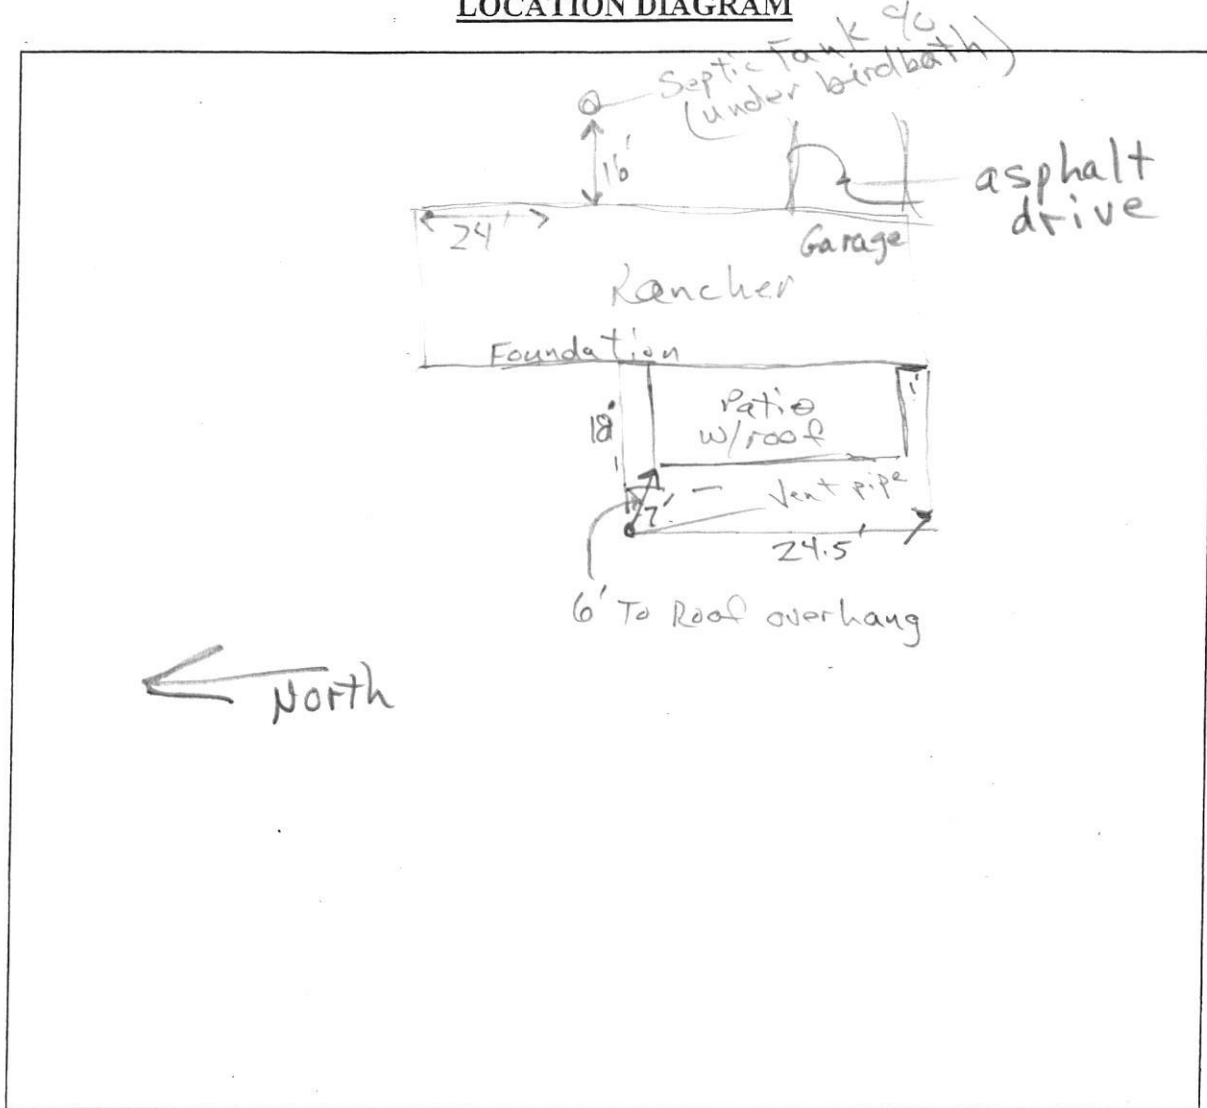

COMMENTS: Well upgrade is required, as it appears
to be buried. Vent pipe extends approx. 1' foot above soil.

DATE: 6/10/13 INSPECTOR: R. Bricker

NO APPLICATION.