

# APPLICATION

*Retest*

SEWAGE DISPOSAL TESTING

STATE OF MARYLAND - DEPARTMENT OF HEALTH AND MENTAL HYGIENE

HOWARD COUNTY HEALTH DEPARTMENT  
ENVIRONMENTAL HEALTH SERVICES  
P.O. BOX 476 ELLICOTT, MARYLAND 21043  
TELEPHONE: 992-2330

A 29553

P

DISTRICT 5th

DATE 3/8/79

TO: THE COUNTY HEALTH OFFICER  
ELLICOTT CITY, MARYLAND

I, HEREBY APPLY FOR THE NECESSARY TEST IN ORDER TO CONSTRUCT (OR RECONSTRUCT) A SEWAGE DISPOSAL SYSTEM.

PROPERTY OWNER Michael MacMurray

ADDRESS 6814 Lenbern Road, Woodlawn, Md. PHONE 265-8769  
21207

PROPERTY LOCATION

SUBDIVISION \_\_\_\_\_ LOT NO. 14

ROAD AND DESCRIPTION 4670 Ten Oaks Road, Dayton, Md. (see attached for directions).

SIZE OF LOT 5 acres TYPE BLDG 3 or 4 bedrooms

THE SYSTEM INSTALLED UNDER THIS APPLICATION IS ACCEPTABLE ONLY UNTIL PUBLIC FACILITIES BECOME AVAILABLE.

I FULLY UNDERSTAND THE FEE CONNECTED WITH THE FILING OF THIS PERC TEST APPLICATION IS NON-REFUNDABLE UNDER ANY CIRCUMSTANCES.

SIGNATURE OF APPLICANT /s/ Michael MacMurray

APPROVED BY [Signature] FOR [Signature] DATE 4/2/79


REJECTED BY \_\_\_\_\_ FOR \_\_\_\_\_ DATE \_\_\_\_\_

HOLD PENDING FURTHER TESTS \_\_\_\_\_ DATE \_\_\_\_\_

REASONS FOR REJECTION OR HOLDING \_\_\_\_\_

## THIS IS NOT A PERMIT

0-13  
sandy brown,  
near,  
little clay

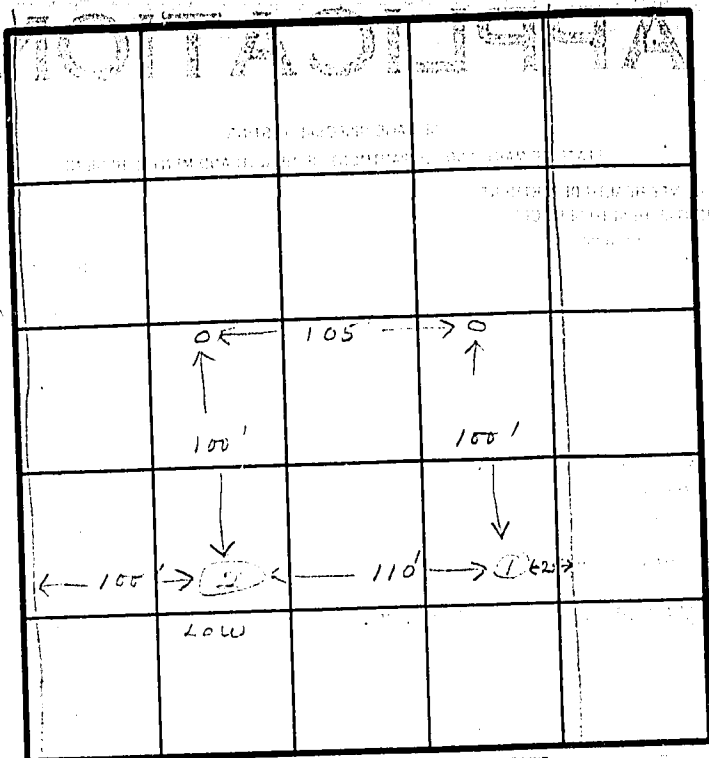

INDICATE NORTH - NAME ADJOINING ROADWAY AS BASE LINE.

TEN OAKS

[illegible]

REMARKS USE OLD LOW Holes FROM PREVIOUS PERC AS  
HIGH Holes

TYPE OF SOIL

TESTED BY

ALSO PRESENT GEO. CLINGERMAN