

APPLICATION

PERCOLATION TESTING

A 42231

P _____

HOWARD COUNTY HEALTH DEPARTMENT
BUREAU OF ENVIRONMENTAL HEALTH
P.O. BOX 476 ELLICOTT CITY, MARYLAND 21043
TELEPHONE: 461-9933

DISTRICT 5TH

DATE MAY 1988

TO: THE COUNTY HEALTH OFFICER
ELLICOTT CITY, MARYLAND

I, HEREBY, APPLY FOR THE NECESSARY TEST IN ORDER TO CONSTRUCT (OR RECONSTRUCT) A SEWAGE DISPOSAL SYSTEM.

PROPERTY OWNER GARY + KATHLEEN KING
BAC - HP DEVELOPMENT LIMITED PARTNERSHIP

ADDRESS C/O H.P. ASSOCIATES
3901 NATIONAL DRIVE SUITE 100 PHONE 421-1700
BURTONSVILLE, MARYLAND 20866

PROSPECTIVE BUYER _____

ADDRESS _____ PHONE _____

PROPERTY LOCATION:

SUBDIVISION ADAMS REACH Sec. 2 LOT NO Lot 12 Prelim 18

ROAD AND DESCRIPTION (5505 Ten Oaks Road)
LOCATED ON THE NORTH AND SOUTH SIDES OF

MD. ROUTE 32, WEST OF RTE 108, NORTH OF TEN OAKS ROAD

TAX MAP 28 PARCEL # 240

SIZE OF LOT ± 3.0 AC. TYPE BLDG SFD - 3 Bm
(SINGLE FAMILY DWELLING OR COMMERCIAL)

BLDG. PERMIT SIGNED
AND RETURNED 8/30/96

Sealed # B70101989

THE SYSTEM INSTALLED UNDER THIS APPLICATION IS ACCEPTABLE ONLY UNTIL PUBLIC FACILITIES BECOME AVAILABLE. I FULLY UNDERSTAND THE

FEE CONNECTED WITH THE FILING OF THIS PERC TEST APPLICATION IS NON-REFUNDABLE UNDER ANY CIRCUMSTANCES. I ALSO AGREE TO COMPLY

WITH ALL M.O.S.H.A. REQUIREMENTS IN TESTING THIS LOT. RAK VP
(SIGNATURE OF APPLICANT)

APPROVED BY _____ FOR _____ DATE _____

REJECTED BY _____ FOR _____ DATE _____

HOLD PENDING FURTHER TESTS _____ DATE _____

REASONS FOR REJECTION OR HOLDING 9-22-88 Perc Satisfactory - Hold for PLAT - Adjust

Perc per reverse. S. And

THIS IS NOT A PERMIT


A-42231

LOT 18

A-D

SOIL PROFILE

0	AP
	REDBN Silty clay loam small AMTS OF QUARTZITE 10-15%
3.5	Yellow Red (Pink) Silt loam Highly micaceous
13	

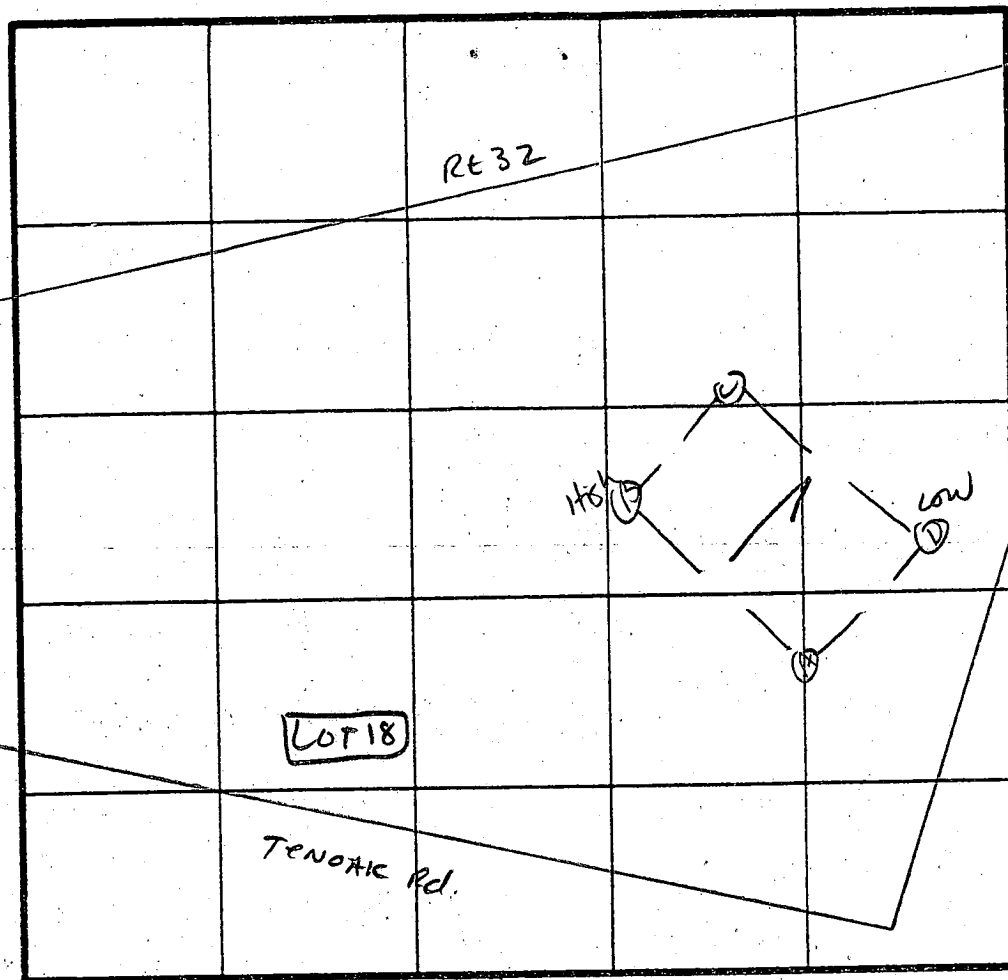

INDICATE NORTH - NAME ADJOINING ROADWAY AS BASE LINE.

DATE	TEST NO.	DEPTH	PRE-WET		TEST - 1" DROP		TIME
			START	STOP	START	STOP	
9/22/88	✓ AV	12.5'	UNIFORM Soil below		3.0-35'	25-30% QUARTZITE	AT 2-4'
	✓ B S	4.0'	10:12	10:13	10:13	10:15	2 min
	✓ B M	8.0'	10:12	10:13	10:13	10:15	2 min
	✓ BV	13'	Typical for series - see Profile				
	✓ CS	4.5'	10:13	10:14	10:14	10:16	2 min
	✓ CV	13'	SAME AS Be				
	✓ DV	13'	10:17	10:22	10:22	10:31	9 min
			SIMILAR TO Hole A - very gravelly.				

REMARKS Holes Dug Per PLAT - Slight Swail near Holes A+D SHIRT

TYPE OF SOIL AREA TO LEFT OF Hole B+C
CHESTER Gravelly loam

TESTED BY S. Auld

ALSO PRESENT Fyock & Co. Wayne

EH-12-1079