


SITE INSPECTION SHEET

P24322

OWNER: _____ PHONE #: _____
 ADDRESS: 2604 Thompson Drive CONTRACTOR: _____
 SUBDIVISION: Sines Property LOT: 1 WELL TAG #: band is present, no tag
 PROPOSAL: Lot has COUNTY #: _____

LOCATION DIAGRAM

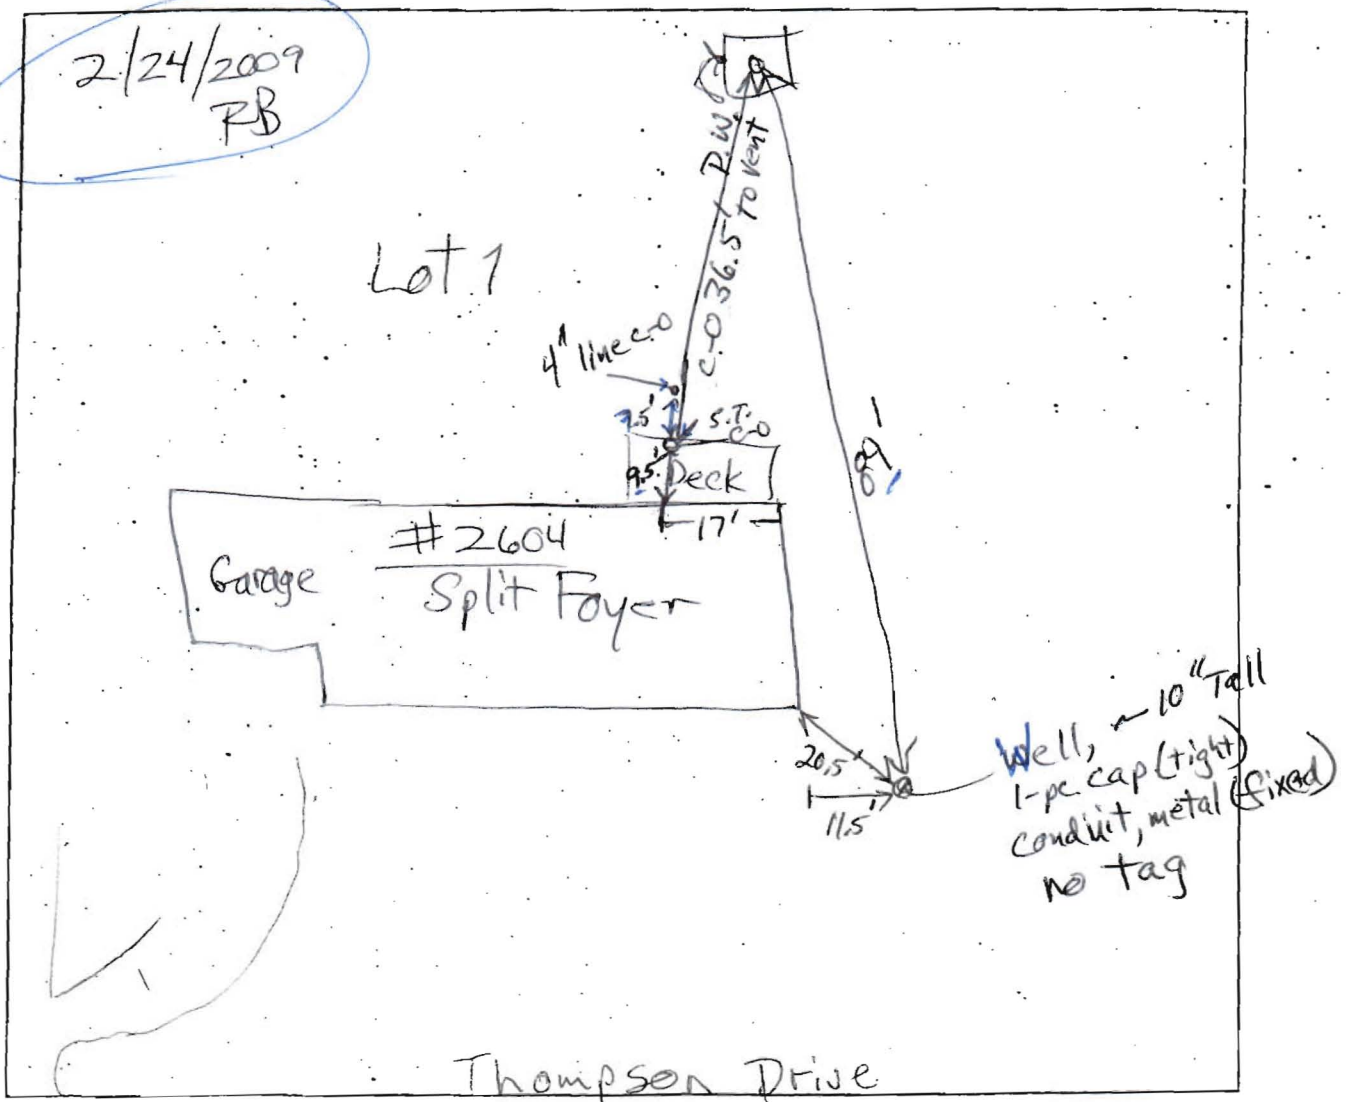

COMMENTS: Site visit to confirm address for
Health Department record.
This is 'Lot 1' of 4-lot subdivision

