

B21003055
10/26/21 - Site plan
approved - H.O.

5126 Honey Locust Court

REVISED

REVISED


10-22-21

APPROVAL LETTER FOR ENCROACHMENT
INTO PRIVATE EASEMENT

008 48' X 23' 43,125 GALLONS
REGULATED GROUND SWIMMING POOL

MINIMUM FENCE
CONSTRUCTION BUILT
LINE

WELL CERTIFICATION
FISHER COLLINS & CARTER, INC.
WELL INSTALLATION, REPAIRS & MAINTENANCE
1000 W. 10TH ST. SUITE 100
DENVER, CO 80202
303.733.1111

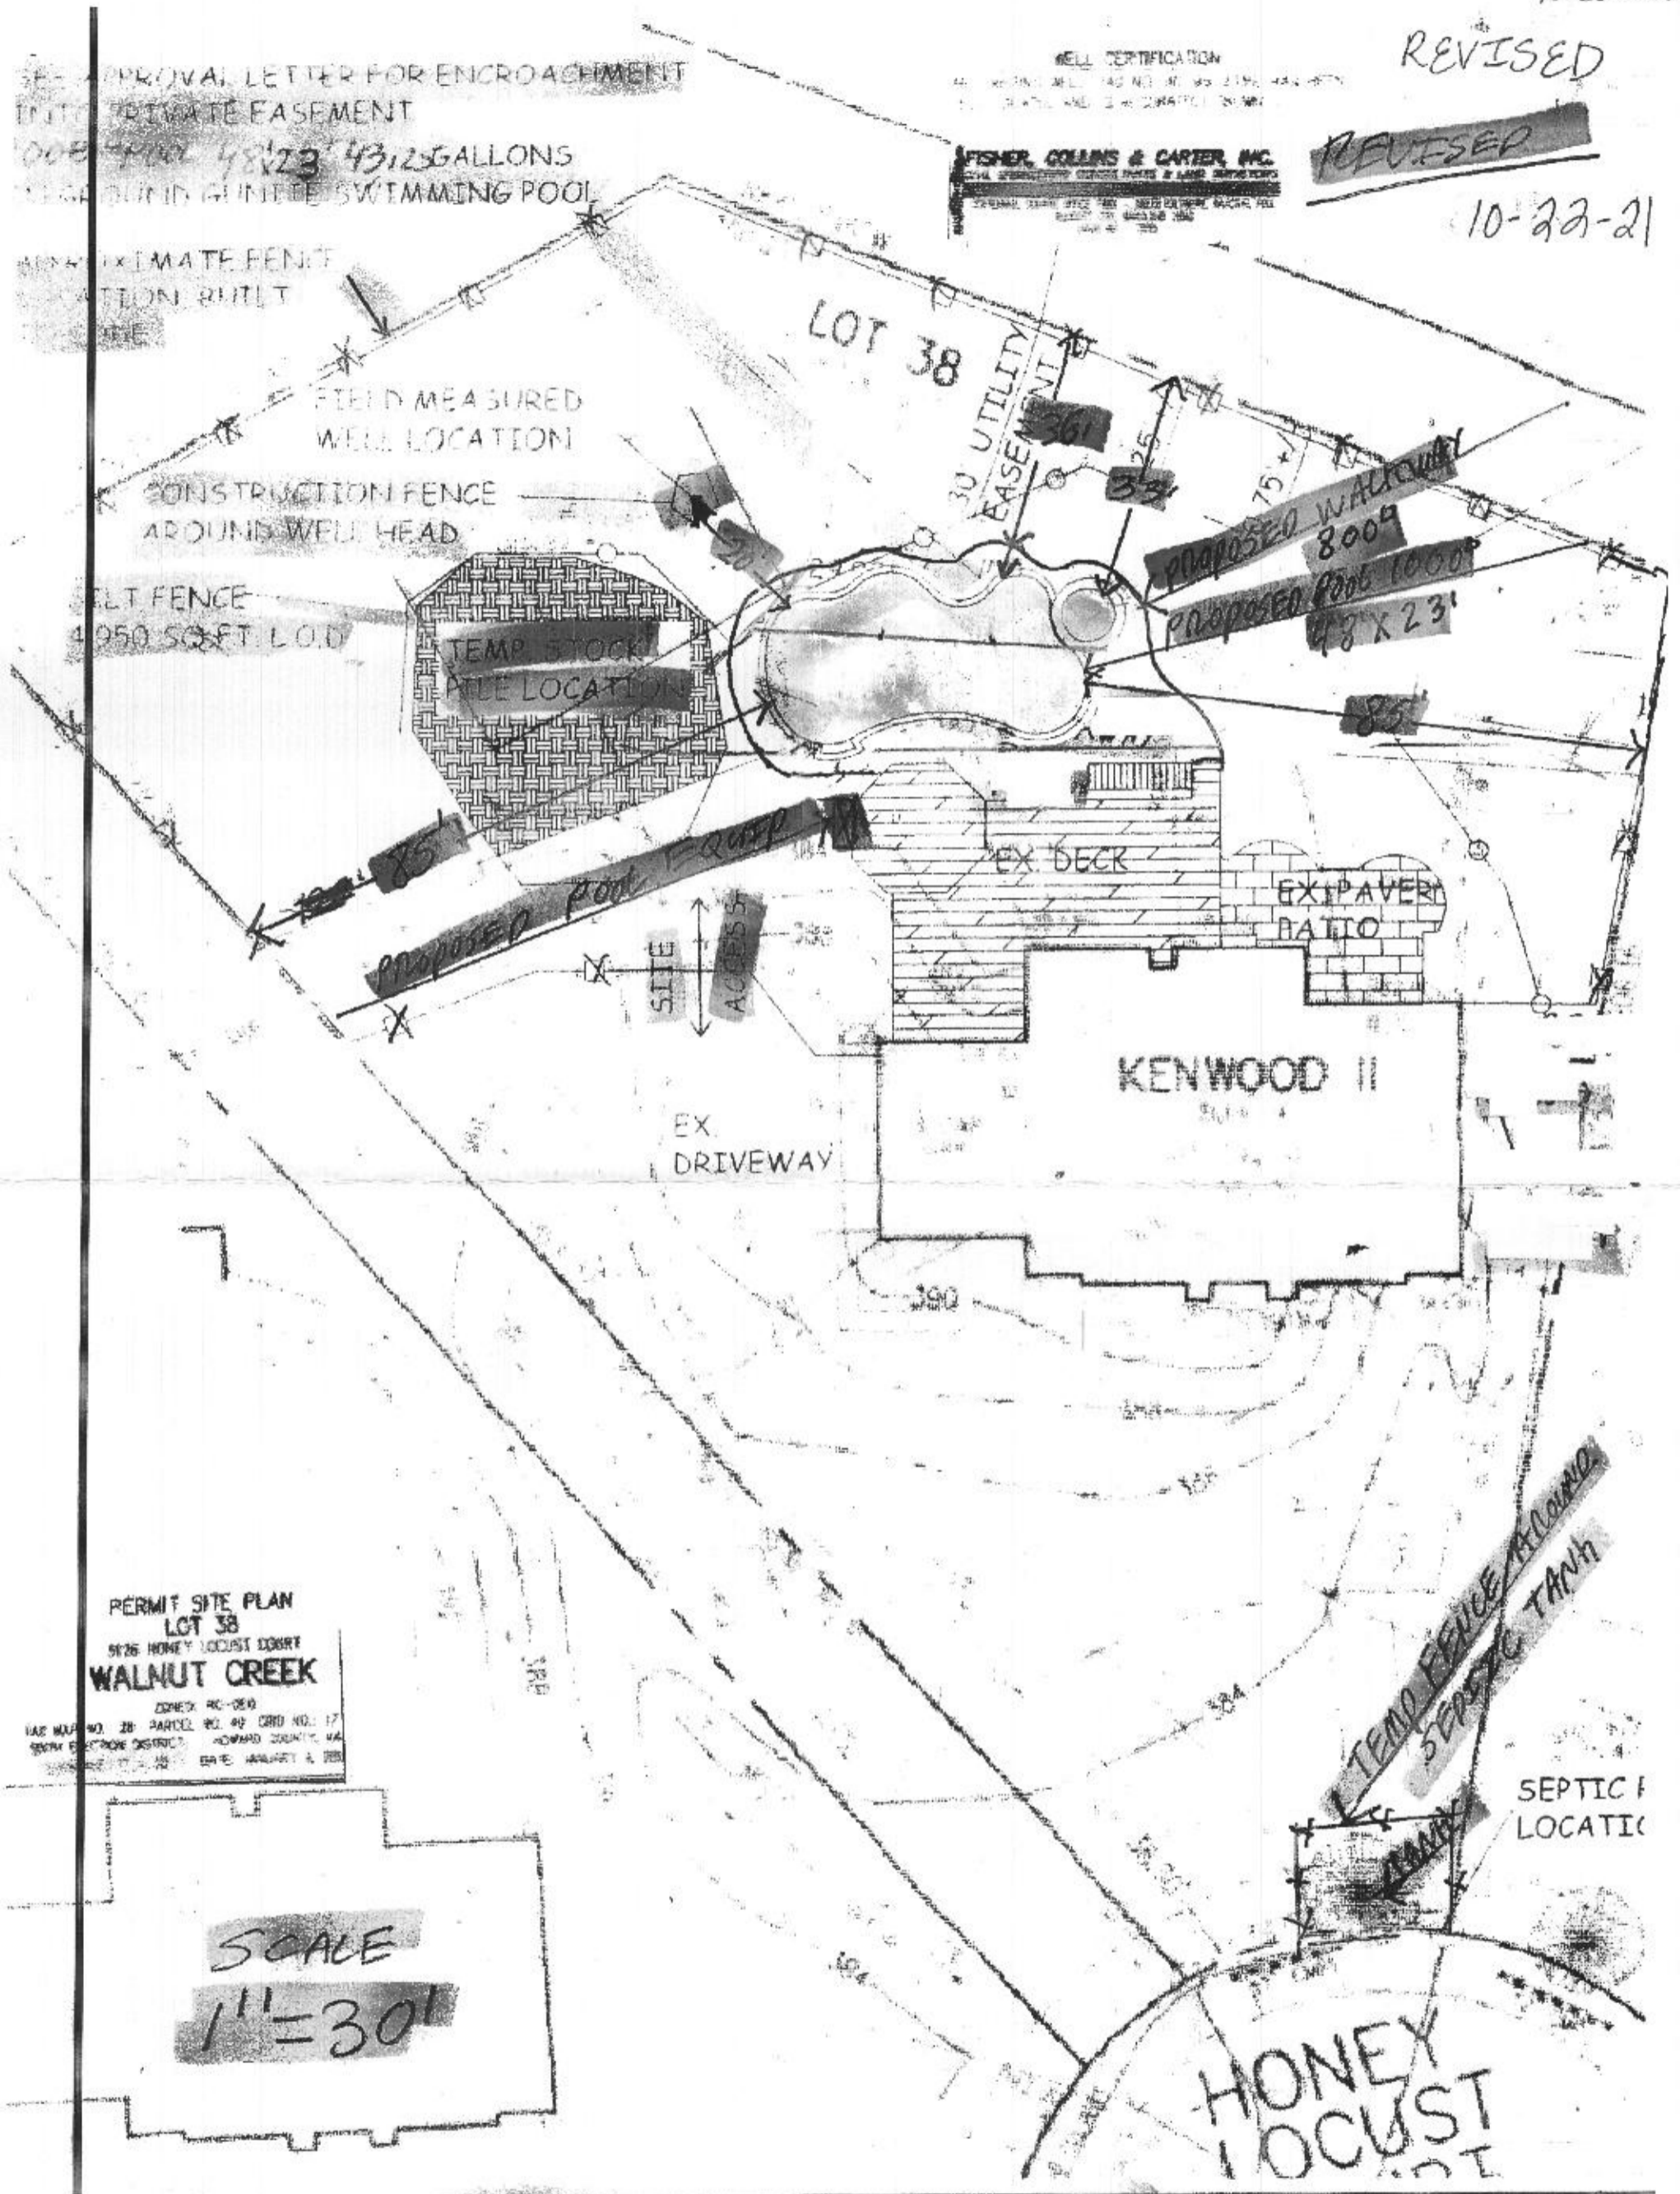

PERMIT SITE PLAN
LOT 38
5126 HONEY LOCUST COURT
WALNUT CREEK

ZONING RC-050
TAX MAP NO. 28 PARCEL NO. 49 GRID NO. 17
SEWER DISTRICT HOWARD COUNTY, VA
DATE: JANUARY 4, 2021

SCALE
1" = 30'

HONEY
LOCUST
COURT