

PERMIT NUMBER: B 21002215

DATE ACCEPTED:

RECEIVED

JUN 14 2021

LICENSES & PERMITS DIVISION



RESIDENTIAL BUILDING PERMIT APPLICATION

HOWARD COUNTY DEPARTMENT OF INSPECTIONS, LICENSES, AND PERMITS

3430 COURT HOUSE DRIVE, ELLICOTT CITY, MD 21043 - PHONE: (410) 313-2455 OPTION #4

www.howardcountymd.gov

BUILDING SITE ADDRESS REQUIRED

Street Address: 855 WINDRIVER DRIVE		Unit:
City: SYKEVILLE	State: MD	Zip Code: 21784
Subdivision/Village/Complex Name: BERNDT ESTATES		SDP/WP/BA #:
Lot: 13	Tax Map:	Parcel:
		Grading Permit #:

DESCRIPTION OF WORK REQUIRED

Existing Use:	Proposed Use:	Estimated Cost: \$
Trade Work to Be Completed (Separate Permits Required): ☐ Mechanical (HVACR) ☒ Electrical ☐ Plumbing ☐ None		
Free standing deck w/ pavilion - 12x14 22x12		

PROPERTY OWNER INFORMATION REQUIRED

Owner(s) Name(s) (As it appears on tax records): STEVEN & YVONNE KAWLEGAH		Primary Residence: ☒ Yes ☐ No
Owner's Street Address: 855 WINDRIVER DR.		
City: SYKEVILLE	State: MD	Zip Code: 21784
Phone: 443-690-3263	Email: STRAWLEIGH@GMAIL.COM	

APPLICANT NAME REQUIRED - INDIVIDUAL WHO SIGNS THIS APPLICATION

Business Name: SELF	Contact Name:
Street Address:	
City:	State:
Phone:	Email:

CONTRACTOR INFORMATION REQUIRED

Business Name: SELF	License #:
Street Address:	
City:	State:
Phone:	Email:

ARCHITECT/ENGINEER INFORMATION INDIVIDUAL WHO SIGNED PLANS, IF APPLICABLE

Business Name: N/A	Name:
Street Address:	
City:	State:
Phone:	Email:

BUILDING CHARACTERISTICS REQUIRED

Primary Structure: ☒ SF Dwelling ☐ SF Townhouse ☐ SF Duplex ☐ Mobile Home ☐ Multi-Family Dwelling (MF*)	Condo: ☐ Yes ☒ No
Utilities: ☒ Electric ☐ Gas	Water Supply: ☐ Public ☒ Private (Well)
Heating System: ☒ Electric ☐ Natural Gas ☐ Propane ☐ Other:	Roadside Tree Project: ☒ No ☐ Yes: #
Sprinkler System: ☐ NFPA 13 ☐ NFPA 13R ☐ NFPA 13D ☒ None	Fire Alarm System: ☐ Yes ☒ No ☐ Voice Evac

ADDITIONAL RESIDENTIAL INFORMATION (PLEASE SELECT/COMPLETE ALL THAT APPLY)

Model Name & Options:				
# of Bedrooms (SF): 4	# of efficiency units (MF*):	# of 1 BR (MF*):	# of 2 BR (MF*):	# of 3 BR (MF*):
# Rooms: 6	# Full Baths: 3	# Half Baths: 1	# Fireplaces: 1	
Garage/Carport Info: ☒ Attached Garage ☐ Detached Garage ☐ Integral Garage ☐ Carport ☐ None				
Basement/Foundation Info: ☐ Slab on Grade ☐ Post & Pier ☐ Unfinished Basement ☒ Finished Basement: ☐ Full or ☐ Partial				
1st Fl Width: 46	1st Fl Depth: 28	2nd Fl Width: 46	2nd Fl Depth: 28	Bsmt Width: 46 Bsmt Depth: 28
Energy Method: ☐ Prescriptive ☐ Performance ☐ UA Alternative ☐ ERI		Gross Area: 2540 sq ft	Occupiable Area: 3760 sq ft	

AGREEMENT/ DISCALIMER REQUIRED

THE UNDERSIGNED HEREBY CERTIFIES AND AGREES AS FOLLOWS: (1) THAT HE/SHE IS AUTHORIZED TO MAKE THIS APPLICATION; (2) THAT THE INFORMATION IS CORRECT; (3) THAT HE/SHE WILL COMPLY WITH ALL REGULATIONS OF HOWARD COUNTY WHICH ARE APPLICABLE THERETO; (4) THAT HE/SHE WILL PERFORM NO WORK ON THE ABOVE REFERENCED PROPERTY NOT SPECIFICALLY DESCRIBED IN THIS APPLICATION; (5) THAT HE/SHE GRANTS COUNTY OFFICIALS THE RIGHT TO ENTER ONTO THIS PROPERTY FOR THE PURPOSE OF INSPECTING THE WORK PERMITTED AND POSTING NOTICES.

APPLICANT'S ORIGINAL SIGNATURE: [Signature] DATE SIGNED: 6/14/21


FOR OFFICE USE ONLY

CHECKS PAYABLE TO: DIRECTOR OF FINANCE OF HOWARD COUNTY

AGENCIES REQUIRED/APPROVALS:				
☒ PR	☐ DPZ	☒ DED	☒ Health	☐ SHA
SUBMITTAL FEES: [Signature]		PAYMENT: NO check		ACCEPTED BY: [Signature]

SCALE: 1cm = 50ft

8. Sketch Area: Please show existing and proposed locations of utilities. You may also submit photos of your project.

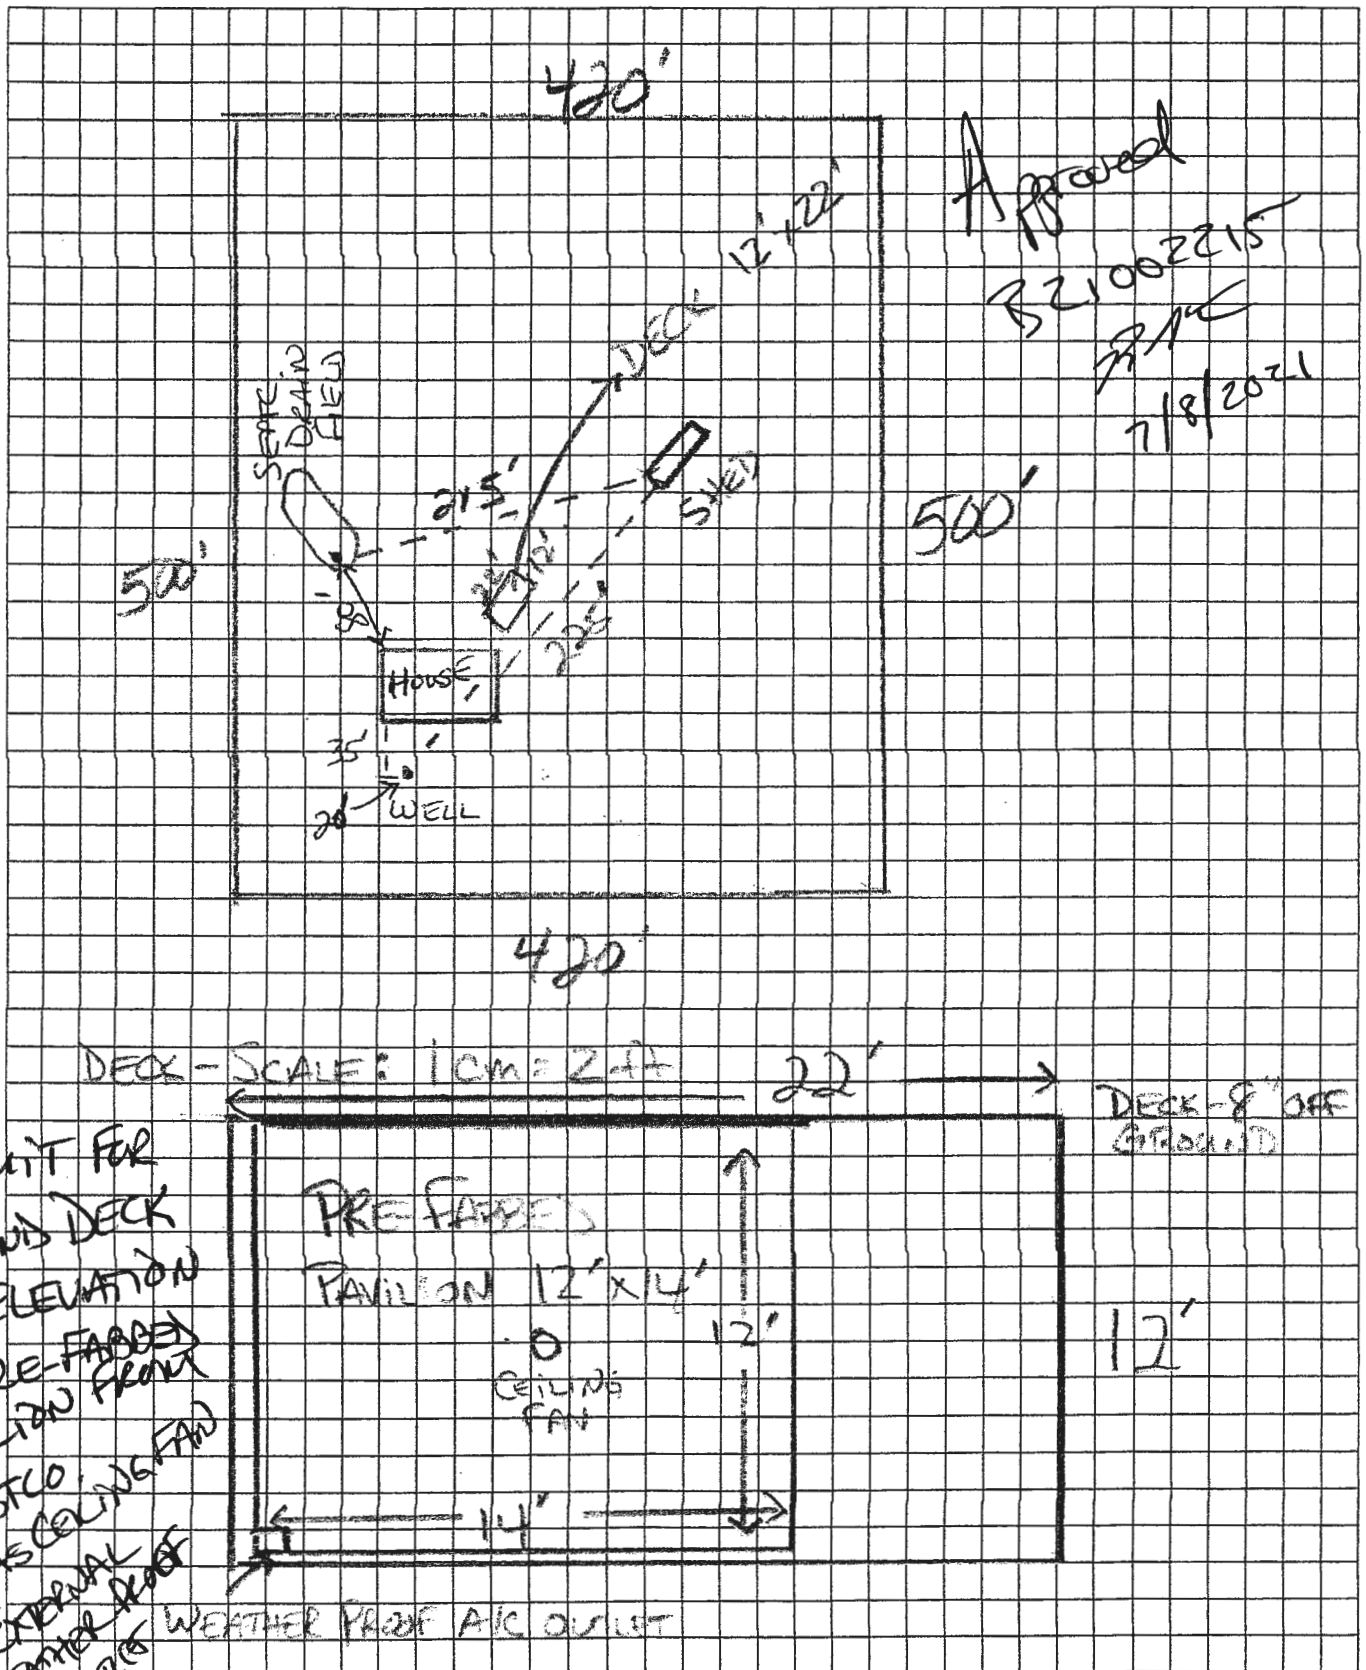

Process for obtaining land plat to include house, well and septic. Information gathered is attached for reference. For all dimension locations, measurement tool on Google Earth was used.

1. Howard County Permits – person at counter pulled up property on computer at counter. Showed only subdivision of community with lot numbers. No house or well/septic locations.
2. I was sent to the Health Department from person working at Permit counter after they could not find any well/septic details. House was built in 1978. There were no records in the Health Department. Suggested using well tag number for State of Maryland records.
3. Well Tag Number HO-73-2224, provided Well Completion Report from State of Maryland records attached. No property drawing. Only well location relative to house.

C 1	7494	SEQUENCE NO. (PLEASE USE ONLY)	STATE OF MARYLAND WATER RESOURCES ADMINISTRATION TAWES STATE OFFICE BLDG., ANNAPOLIS, MD. 21401 WELL COMPLETION REPORT	THIS REPORT MUST BE SUBMITTED WITHIN 30 DAYS AFTER WELL COMPLETION FILL IN THIS FORM COMPLETELY COUNTY NUMBER PERMIT NO. (FROM "PERMIT TO DRILL") 73-2224 28 29 30 31 32 33 34 35 36 37
THIS NUMBER IS TO BE FURNISHED IN COPIES 1-6 ON ALL CARDS		DATE RECEIVED (WRA USE ONLY) 8/3/77	DEPTH OF WELL 140 22 (TO NEAREST FOOT) 28	DRILLER'S IDENTIFICATION NO. 42
OWNER: <u>Roy BENNETT INC.</u> LAST NAME FIRST NAME STREET OR RFD <u>5626 SOUTHWESTERN DR.</u> POST OFFICE <u>Arbutus Md.</u>		DATE WELL COMPLETED 08/03/77		

WELL LOG STATE THE KIND OF FORMATIONS PENETRATED, THEIR COLOR, DEPTH, THICKNESS AND IF WATER BEARING DESCRIPTION (USE ADDITIONAL SHEETS IF NECESSARY)	FEET FROM TO	CHIEF OF WATER BEARING	GROUTING RECORD WELL HAD BEEN GROUTED (CIRCLE APPROPRIATE BOX) YES ☒ NO ☐ TYPE OF GROUTING MATERIAL (CIRCLE BOX) CEMENT ☒ BENTONITE CLAY ☐ NO. OF BAGS 5 NO. OF POUNDS 500 GALLONS OF WATER 25 DEPTH OF GROUT SEAL (TO NEAREST FOOT) FROM 0 FT. TO 19 FT. (ENTER 0 IF FROM SURFACE)	C 3 1 2 3 (SEQ. NO.) 6 PUMPING TEST HOURS PUMPED (TO NEAREST HOUR) 2 PUMPING RATE (GALLONS PER MINUTE TO NEAREST GALLON) 10 METHOD USED TO MEASURE PUMPING RATE <u>BUCKET</u> WATER LEVEL (DISTANCE FROM LAND SURFACE) BEFORE PUMPING 40 (NEAREST FOOT) WHEN PUMPING 140 (NEAREST FOOT) TYPE OF PUMP USED (CIRCLE APPROPRIATE BOX) (FOR PUMPING TEST) ☒ AIR ☐ PISTON ☐ TURBINE ☐ CENTRIFUGAL ☐ ROTARY ☐ OTHER (DESCRIBE BELOW) ☐ JET ☐ SUBMERSIBLE
Top Soil SHALE GRANITE	0 2 2 15 15 140		Casing Types INSERT APPROPRIATE CODE BELOW STEEL ☐ CONCRETE ☐ PLASTIC ☐ OTHER ☐ MAIN CASING TYPE ☒ ST NOMINAL DIAMETER TOP (MAIN) CASING (NEAREST INCH) 6 TOTAL DEPTH OF MAIN CASING (NEAREST FOOT) 21	TYPE OF PUMP (WRITE APPROPRIATE LETTER IN BOX - SEE ABOVE: A, C, J, P, R, S, T, O) DRILLER WILL INSTALL PUMP (CIRCLE APPROPRIATE BOX) YES ☐ NO ☒ CAPACITY: GALLONS PER MINUTE (TO NEAREST GALLON) 31 38 PUMP HORSE POWER 37 41 PUMP COLUMN LENGTH (NEAREST FOOT) 43 47
SCREEN RECORD SCREEN TYPE OR OPEN HOLE INSERT APPROPRIATE CODE BELOW STEEL ☐ BRASS ☐ OPEN HOLE ☐ PLASTIC ☐ OTHER ☐ C 2 1 2 3 (SEQ. NO.) 6 DEPTH (NEAREST WHOLE FOOT) 1 H.O. 77 140 2 23 24 28 30 32 36 3 38 39 41 45 47 51 SLOT SIZE 1, 2, 3			Casing Height (CIRCLE APPROPRIATE BOX AND ENTER CASING HEIGHT) ☒ ABOVE ☐ BELOW LAND SURFACE 2 (NEAREST FOOT) 49 50 51	

CIRCLE APPROPRIATE BOXES ☐ A WELL WAS ABANDONED AND SEALED WHEN THIS WELL WAS COMPLETED ☐ E ELECTRIC LOG OBTAINED ☐ F TEST WELL CONVERTED TO PRODUCTION WELL	I HEREBY CERTIFY THAT I HAVE COMPLIED WITH ALL CONDITIONS STATED ON THE ABOVE-CAPTIONED "PERMIT TO DRILL WELL," AND THAT INFORMATION CONTAINED IN THIS REPORT IS TRUE, ACCURATE, AND COMPLETE TO THE BEST OF MY KNOWLEDGE, INFORMATION AND BELIEF. DRILLER'S NAME (PLEASE PRINT) <u>L. F. EASTERDAY</u> SIGNATURE <u>L. F. Easterday</u>
DIAMETER OF SCREEN 56 (NEAREST INCH) FROM TO GRAVEL PACK IF WELL DRILLED WAS A FLOWING WELL CIRCLE BOX ☐ F	
WRA USE ONLY (NOT TO BE FILLED IN BY DRILLER) (E.R.O.S.) T 70 ☐ 72 ☐ TELESCOPE CASING LOG INDICATOR W. O. 74 75 76 OTHER DATA AVAILABLE	

1713 STATE OF MARYLAND WATER RESOURCES ADMINISTRATION TAWES STATE OFFICE BLDG., ANNAPOLIS, MARYLAND 21401 APPLICATION FOR PERMIT TO DRILL WELL WRA PERMIT NUMBER 40-73-2224

DATE RECEIVED (WRA USE ONLY) 07.19.77

OWNER BONNETT, ROY, JR. 5626 Southwestern Blvd. Annapolis, Md 21407

DATE 7/6/77 LICENSE NUMBER 42

FIRST NAME L. F. LAST NAME E. E. SIGNATURE L. F. E. E.

WELL INFORMATION MAXIMUM PUMPING RATE (GALLONS PER MINUTE) 6 AVERAGE DAILY QUANTITY NEEDED (GALLONS PER DAY) 500

USE FOR WATER (CIRCLE APPROPRIATE BOX) D HOME (SINGLE OR DOUBLE HOUSEHOLD UNIT ONLY) F FARMING, AGRICULTURE, IRRIGATION I INDUSTRIAL, COMMERCIAL, STATE AND FEDERAL GOVERNMENT M MUNICIPAL WATER SUPPLY P PRIVATE WATER COMPANY T TEST

APPROXIMATE DEPTH OF WELL 150 FEET APPROXIMATE DIAMETER OF WELL 6 INCHES

METHOD OF DRILLING USED (CIRCLE APPROPRIATE METHOD) BORED (AIR-ROTARY) JETTED DRIVEN

REPLACEMENT OR DEEPEMED WELLS (CIRCLE APPROPRIATE BOX) N THIS WELL WILL NOT REPLACE AN EXISTING WELL Y THIS WELL WILL REPLACE A WELL THAT WILL BE ABANDONED AND SEALED S THIS WELL WILL REPLACE A WELL THAT WILL BE USED AS A STANDBY D THIS WELL WILL DEEPEN AN EXISTING WELL

NOT TO BE FILLED IN BY DRILLER (WRA USE ONLY) APPROPRIATION PERMIT NUMBER FORCE WRITE INITIALS CONDITIONS

HEALTH DEPARTMENT APPROVAL HOWARD W26421 DATE 7.18.77 DONALD W. MONAGHAN, SANITARIAN

LOCATION OF WELL COUNTY HOWARD SUBDIVISION BRINDILL ESTATES SECTION 44 LOT 13 NEAREST TOWN SYKEVILLE MILES FROM TOWN 3

DIRECTION FROM TOWN (CIRCLE APPROPRIATE BOX) N NORTH E EAST NE NORTHEAST SE SOUTHEAST S SOUTH W WEST NW NORTHWEST SW SOUTHWEST

NEAR WHAT ROAD ON WHICH SIDE OF ROAD (CIRCLE APPROPRIATE BOX) N NORTH S SOUTH E EAST W WEST

DISTANCE FROM ROAD (ENTER DISTANCE AND CIRCLE APPROPRIATE BOX) 1000

DRAW A SKETCH BELOW SHOWING LOCATION OF WELL IN RELATION TO NEARBY TOWNS, ROADS, AND STREAMS WITH NORTH IN THE DIRECTION OF THE ARROW, AND GIVE DISTANCE FROM WELL TO NEAREST ROAD JUNCTION OR STREAM CROSSING SHOWN ON THE SKETCH. ALSO SHOW, BY MEANS OF AN "X", THE WELL LOCATION IN THE BOX BELOW AND THE BOX NUMBER FROM THE WELL LOCATION MAP.

Sketch showing location of well in relation to Sykesville, Howard, and River Rd. Box number 815/550.

North coordinate 550000 East coordinate 0810000 Elevation at well head (feet) 55

C 1 7494

SEQUENCE NO.
(WRA USE ONLY)STATE OF MARYLAND
WATER RESOURCES ADMINISTRATION
TAWES STATE OFFICE BLDG., ANNAPOLIS, MD. 21401
WELL COMPLETION REPORTTHIS REPORT MUST BE SUBMITTED WITHIN
30 DAYS AFTER WELL COMPLETION

FILL IN THIS FORM COMPLETELY

THIS NUMBER IS TO BE PUNCHED
IN COLD. 3-5 ON ALL CARDSDATE RECEIVED
(WRA USE ONLY)

DATE WELL COMPLETED

DEPTH OF WELL

140

22 (TO NEAREST FOOT) 26

COUNTY
NUMBER
PERMIT NO. 73-2224
17A-17A-2467
28 29 30 31 32 33 34 35 36 37

DRILLER IDENTIFICATION NO. 1

OWNER: Roy BENNETT INC.

STREET OR RFD 5626 SOUTHWESTERN DR.

POST OFFICE Abbotus Md

WELL LOG

STATE THE KIND OF FORMATIONS PENETRATED, THEIR
COLOR, DEPTH, THICKNESS AND IF WATER BEARINGDESCRIPTION
(USE ADDITIONAL SHEETS
IF NECESSARY)

FEET

FROM

TO

CHECK IF
WATER BEARING

Top Soil 0 2

SHALE 2 15

GRANITE 15 140

WELL DESCRIPTION

GROUTING RECORD

WELL HAS BEEN GROUTED
(CIRCLE APPROPRIATE BOX)

YES

NO

TYPE OF GROUTING MATERIAL (CIRCLE BOX)

CEMENT

BENTONITE CLAY

NO. OF BAGS 5

NO. OF POUNDS 500

GALLONS OF WATER 25

DEPTH OF GROUT SEAL (TO NEAREST FOOT)

FROM 0 FT. TO 19 FT.
(ENTER 0 IF FROM SURFACE)

CASING

TYPES

INSERT

APPROPRIATE

CODE

BELOW

CASING RECORD

STEEL

CONCRETE

PLASTIC

OTHER

MAIN

CASING

TYPE

ST

NOMINAL DIAMETER

TOP (MAIN) CASING

(NEAREST INCH)

6

TOTAL DEPTH

OF MAIN CASING

(NEAREST FOOT)

21

EACH CASING

OTHER CASING (IF USED)

DIAMETER

(INCH)

DEPTH (FEET)

FROM

TO

SCREEN TYPE

OR OPEN HOLE

INSERT

APPROPRIATE

CODE

BELOW

SCREEN RECORD

STEEL

BRASS

H.D.

OR BRONZE

PLASTIC

OTHER

C 2

1 2 3 (SEQ. NO.)

DEPTH (NEAREST WHOLE FOOT)

H.D.

79

140

23 24 28 30 32 36

38 39 41 43 45 47 51

SLOTSIZE 1, 2, 3,

DIAMETER OF SCREEN 56 (NEAREST INCH)

FROM TO

GRAVEL PACK

IF WELL DRILLED WAS A

FLOWING WELL CIRCLE BOX

70

TELESCOPE

CASING

LOG

INDICATOR

72

74 75 76

OTHER DATA

AVAILABLE

W.O.

(E.R.O.S.)

W.O.

(E.R.O.S.)

CIRCLE APPROPRIATE BOXES

A WELL WAS ABANDONED AND SEALED WHEN THIS
WELL WAS COMPLETED

E ELECTRIC LOG OBTAINED

P TEST WELL CONVERTED TO PRODUCTION WELL

I HEREBY CERTIFY THAT I HAVE COMPLIED WITH ALL
CONDITIONS STATED ON THE ABOVE-CAPTIONED "PERMIT
TO DRILL WELL", AND THAT INFORMATION CONTAINED
IN THIS REPORT IS TRUE, ACCURATE, AND COMPLETE
TO THE BEST OF MY KNOWLEDGE, INFORMATION AND
BELIEF.

DRILLER'S NAME

(PLEASE PRINT) L. F. EASTERDAY

SIGNATURE L. F. Easterday

PUMPING TEST

HOURS PUMPED (TO NEAREST HOUR) 2

PUMPING RATE
(GALLONS PER MINUTE TO NEAREST GALLON) 10METHOD USED TO
MEASURE PUMPING RATE BUCKET

WATER LEVEL: (DISTANCE FROM LAND SURFACE)

BEFORE PUMPING 40 (NEAREST FOOT)

WHEN PUMPING 140 (NEAREST FOOT)

TYPE OF PUMP USED (CIRCLE APPROPRIATE BOX)
(FOR PUMPING TEST)

AIR

PISTON

TURBINE

CENTRIFUGAL

ROTARY

OTHER

JET

SUBMERSIBLE

PUMP INSTALLED

TYPE OF PUMP (WRITE APPROPRIATE LETTER IN
BOX - SEE ABOVE: A, C, J, P, R, S, T, O)DRILLER WILL INSTALL PUMP
(CIRCLE APPROPRIATE BOX)

CAPACITY:

GALLONS PER MINUTE
(TO NEAREST GALLON)

PUMP HORSE POWER

PUMP COLUMN LENGTH
(NEAREST FOOT)CASING HEIGHT (CIRCLE APPROPRIATE BOX
AND ENTER CASING HEIGHT)

ABOVE

LAND SURFACE

BELOW

2 (NEAREST FOOT)

LOCATION OF WELL ON LOT

SHOW PERMANENT STRUCTURE SUCH AS BUILDINGS,
SEPTIC TANKS, AND/OR OTHER LAND MARKS AND
INDICATE NOT LESS THAN TWO DISTANCES
(MEASUREMENTS TO WELL).

HOUSE

35
20
WELL

Red

ORIGINAL

STATE OF MARYLAND WATER RESOURCES ADMINISTRATION TAKES STATE OFFICE BLDG., ANNAPOLIS, MARYLAND 21401 APPLICATION FOR PERMIT TO DRILL WELL		WRA PERMIT NUMBER HD-73-2224 FILL IN THIS FORM COMPLETELY	
1 1713 1 2 3 (SEQ. NO.) THIS NUMBER IS TO BE PRINTED IN COLUMNS ON ALL CARDS		DATE RECEIVED (WRA USE ONLY) 07.19.77	
OWNER BONNETT, RAY, JR. COL 18 LAST NAME		FIRST NAME COL. 34	
STREET OR RFD 5626 Southwestern Blvd. COL. 35		POST OFFICE Ardenurs, Md 21227 COL. 76	
DRILLER INFORMATION DATE 7/6/77 LICENSE NUMBER 42 L. F. Easterday FIRST NAME DRILLER LAST NAME SIGNATURE <i>L. F. Easterday</i>		LOCATION OF WELL COUNTY Howard DO NOT ABBREVIATE COUNTY NAME SUBDIVISION Burdell Estates SECTION 13 NEAREST TOWN Sykesville MILES FROM TOWN (ENTER 0 IF IN TOWN) 3	
WELL INFORMATION MAXIMUM PUMPING RATE (GALLONS PER MINUTE) 6 AVERAGE DAILY QUANTITY NEEDED (GALLONS PER DAY) 500 USE FOR WATER (CIRCLE APPROPRIATE BOX) ☒ HOME (SINGLE OR DOUBLE HOUSEHOLD UNIT ONLY) ☐ FARMING, AGRICULTURE, IRRIGATION ☐ INDUSTRIAL, COMMERCIAL, STATE AND FEDERAL GOVERNMENT ☐ MUNICIPAL WATER SUPPLY ☐ PRIVATE WATER COMPANY ☐ TEST MUST HAVE STATE HEALTH DEPT. APPROVAL		DIRECTION FROM TOWN (CIRCLE APPROPRIATE BOX) ☐ NORTH ☐ EAST ☐ NORTHWEST ☒ SOUTHEAST ☐ SOUTH ☐ WEST ☐ SOUTHWEST NEAR WHAT ROAD River Rd. ON WHICH SIDE OF ROAD (CIRCLE APPROPRIATE BOX) ☒ NORTH ☐ SOUTH ☐ EAST ☐ WEST DISTANCE FROM ROAD (ENTER DISTANCE AND CIRCLE APPROPRIATE BOX) 1000	
APPROXIMATE DEPTH OF WELL 150 FEET APPROXIMATE DIAMETER OF WELL 6 in (NEAREST INCH) METHOD OF DRILLING USED (CIRCLE APPROPRIATE METHOD) ☒ BORED (OR AUGERED) ☐ JETTED ☐ DRIVEN ☒ AIR-ROTARY ☐ AIR-PERCUSSION ☐ ROTARY (HYDRAULIC ROTARY) ☐ CABLE ☐ REVERSE-ROTARY ☐ DRIVE POINT OTHER (DESCRIBE)		DRAW A SKETCH BELOW SHOWING LOCATION OF WELL IN RELATION TO NEARBY TOWNS, ROADS AND STREAMS WITH NORTH IN THE DIRECTION OF THE ARROW, AND GIVE DISTANCE FROM WELL TO NEAREST ROAD JUNCTION OR STREAM CROSSING SHOWN ON THE SKETCH. ALSO SHOW, BY MEANS OF AN "X", THE WELL LOCATION IN THE BOX BELOW AND THE BOX NUMBER FROM THE WELL LOCATION MAP. 	
REPLACEMENT OR DEEPENED WELLS (CIRCLE APPROPRIATE BOX) ☒ THIS WELL WILL NOT REPLACE AN EXISTING WELL ☐ THIS WELL WILL REPLACE A WELL THAT WILL BE ABANDONED AND SEALED ☐ THIS WELL WILL REPLACE A WELL THAT WILL BE USED AS A STANDBY ☐ THIS WELL WILL DEEPEAN AN EXISTING WELL PERMIT NUMBER OF WELL TO BE REPLACED OR DEEPEENED (IF AVAILABLE)		NOT TO BE FILLED IN BY DRILLER (WRA USE ONLY) APPROPRIATION PERMIT NUMBER ENGINEER REVIEW DISTRICT NO. FORCE WRITE INITIALS IN BOX CONDITIONS	
HEALTH DEPARTMENT APPROVAL DATE 7.18.77 STATE HEALTH HOWARD W26421 APPROVED BY <i>Donald W. Monaghan</i> Donald W. Monaghan, Sanitarian		BOX NUMBER 815 NORTH COORDINATE 550000 EAST COORDINATE 0810000 ELEVATION AT WELL HEAD (FEET)	
SPECIAL CONDITIONS (WRA USE ONLY)		ORIGINAL	

STATE OF MARYLAND
DEPARTMENT OF NATURAL RESOURCES
WATER RESOURCES ADMINISTRATION
TAWES OFFICE BUILDING, ANNAPOLIS, MARYLAND



PERMIT TO DRILL WELL

ISSUE DATE- 01/19/77
40 DA YR

PERMIT NUMBER- 50-78-2224

ISSUED TO DRILLER-

EASTERDAY, LOUIS F
RFD 3
MT AIRY MD 21771

DRILLER

ID. NUMBER- 42

THE ABOVE NAMED DRILLER IS HEREBY AUTHORIZED TO DRILL A WELL
TO BE OWNED BY-

ROY BENNETT INC
5626 SOUTHWESTERN BV
ARBUTUS MD

THIS WELL IS TO BE LOCATED IN HOWARD COUNTY,
BERNDELL ESTATES SUBDIVISION, SECTION- , LOT- 13 ,
NEAR THE TOWN OF SYKESVILLE

THE WATER IS TO BE USED FOR A DOMESTIC SUPPLY.

THIS WELL WILL NOT REPLACE ANOTHER WELL.

SPECIAL CONDITIONS

FAILURE TO COMPLY WITH THE FOLLOWING CONDITIONS WILL CAUSE THIS PERMIT TO BECOME NULL AND VOID.

1. A TAP FOR RAW WATER SAMPLES MUST BE PLACED BEFORE WATER ENTERS A TREATMENT FACILITY, PRESSURE OR STORAGE TANK.
2. NOTIFY COUNTY HEALTH DEPT. 24 HOURS BEFORE GROUTING WELL.

THE ABOVE CONDITIONS FROM CODES ON APPLICATION

THIS PERMIT IS VALID UNTIL
01/19/78. A WELL COMPLETION
REPORT MUST BE SUBMITTED TO
THE ADMINISTRATION WITHIN 30 DAYS
AFTER COMPLETION OF THE WELL.

HERBERT M. SACHS
DIRECTOR, MARYLAND
WATER RESOURCES
ADMINISTRATION