

Was changed to Lot 19 - 17480 Timberleigh

8/27/73 started 11/1/73 for 2/1/74
Amount not if possible
8/27/73
8/27/73
8/27/73

PERMIT
SEWAGE DISPOSAL SYSTEM
MARYLAND STATE DEPARTMENT OF HEALTH
INDEXED

HOWARD COUNTY
ELLICOTT CITY
DISTRICT 4th
DATE 6/12/75
A 17832

William Hopkins IS PERMITTED TO INSTALL ☒ ALTER _____
ADDRESS Jennings Chapel Road, Woodbine, Md. 21797 PHONE 489-4711
A SEWAGE DISPOSAL SYSTEM LOCATED AT _____
SUBDIVISION Timberleigh Village ROAD Route 94 LOT 17, Sec. 1
PROPERTY OWNER William B. Martin & Wife
ADDRESS Route 94, Woodbine, Maryland
SPECIFICATIONS 4 bedrooms
DRAIN FIELD _____ DEPTH _____ FEET, BOTTOM AREA _____ SQ. FT.
SEEPAGE PITS _____ ABSORBENT SIDE-WALL AREA _____ SQ. FT.
SEPTIC TANK CAPACITY 1800 GALLONS
FOR GARBAGE GRINDER, INCREASE DISPOSAL AREA 22% & TANK CAPACITY 50%.
OTHER DRY WELL - To have 190 sq. ft. sq. ft. effective absorbent sidewall area per bedroom below first 4 1/2 ft. of original grade. Inlet can come in at 3 ft. below original grade and maximum depth 11 1/2 ft. Locate dry well 115 ft. from Timberleigh Way and 120 ft. from Route 94.
155' on E end of lot - must call for map of trench before trench is installed.
NOTE: ALL PIPE FROM HOUSE TO DISPOSAL AREA MUST BE CAST IRON.
PERMIT VOID AFTER THREE YEARS.
NOTE: INSTALL STAND PIPE ON SEPTIC TANK AND DRY WELL. STAND PIPES MUST BE 6 INCHES IN DIAMETER. CAST IRON, CONCRETE OR TERRA COTTA ACCEPTED.

PLANS APPROVED BY Charles B. Streaker DATE 9/19/73
FILL SEPTIC TANK AND DISTRIBUTION BOX WITH WATER BEFORE CALLING FOR AN INSPECTION. COVER NO WORK UNTIL INSPECTED AND APPROVED.
NEITHER THE HOWARD COUNTY COMMISSIONERS NOR THE HEALTH DEPARTMENT IS RESPONSIBLE FOR THE SUCCESSFUL OPERATION OF ANY SYSTEM.

A 17832

May - need to be converted in scanned files

PERMIT

SEWAGE DISPOSAL SYSTEM

MARYLAND STATE DEPARTMENT OF HEALTH

HOWARD COUNTY

INDEXED

ELLICOTT CITY

DISTRICT 4th

DATE 6/12/75

A 17832

William Hopkins

IS PERMITTED TO INSTALL ☒ ALTER

ADDRESS Jennings Chapel Road, Woodbine, Md. 21797

PHONE 489-4711

A SEWAGE DISPOSAL SYSTEM LOCATED AT

SUBDIVISION Timberleigh Village

ROAD Route 94

LOT 17, Sec. 1

PROPERTY OWNER William B. Martin & Wife

ADDRESS Route 94, Woodbine, Maryland

SPECIFICATIONS 4 bedrooms

DRAIN FIELD DEPTH FEET, BOTTOM AREA SQ. FT.

SEEPAGE PITS ABSORBENT SIDE-WALL AREA SQ. FT.

SEPTIC TANK CAPACITY 1800 GALLONS

FOR GARBAGE GRINDER, INCREASE DISPOSAL AREA 22% & TANK CAPACITY 50%.

OTHER DRY WELL - To have 190 sq. ft. sq. ft. effective absorbent sidewall area per bedroom below first 4 1/2 ft. of original grade. Inlet can come in at 3 ft. below original grade and maximum depth 11 1/2 ft. Locate dry well 115 ft. from Timberleigh way and 130 ft. from Route 94.

NOTE: ALL PIPE FROM HOUSE TO DISPOSAL AREA MUST BE CAST IRON. *155' ok to use 15" & trench - must call for map of trench before trench is installed.*

PERMIT VOID AFTER THREE YEARS.

NOTE: INSTALL STAND PIPE ON SEPTIC TANK AND DRY WELL. STAND PIPES MUST BE 6 INCHES IN DIAMETER. CAST IRON, CONCRETE OR TERRA COTTA ACCEPTED.


PLANS APPROVED BY Charles B. Streaker

DATE 9/19/73

FILL SEPTIC TANK AND DISTRIBUTION BOX WITH WATER BEFORE CALLING FOR AN INSPECTION. COVER NO WORK UNTIL INSPECTED AND APPROVED.

NEITHER THE HOWARD COUNTY COMMISSIONERS NOR THE HEALTH DEPARTMENT IS RESPONSIBLE FOR THE SUCCESSFUL OPERATION OF ANY SYSTEM.

A 17832

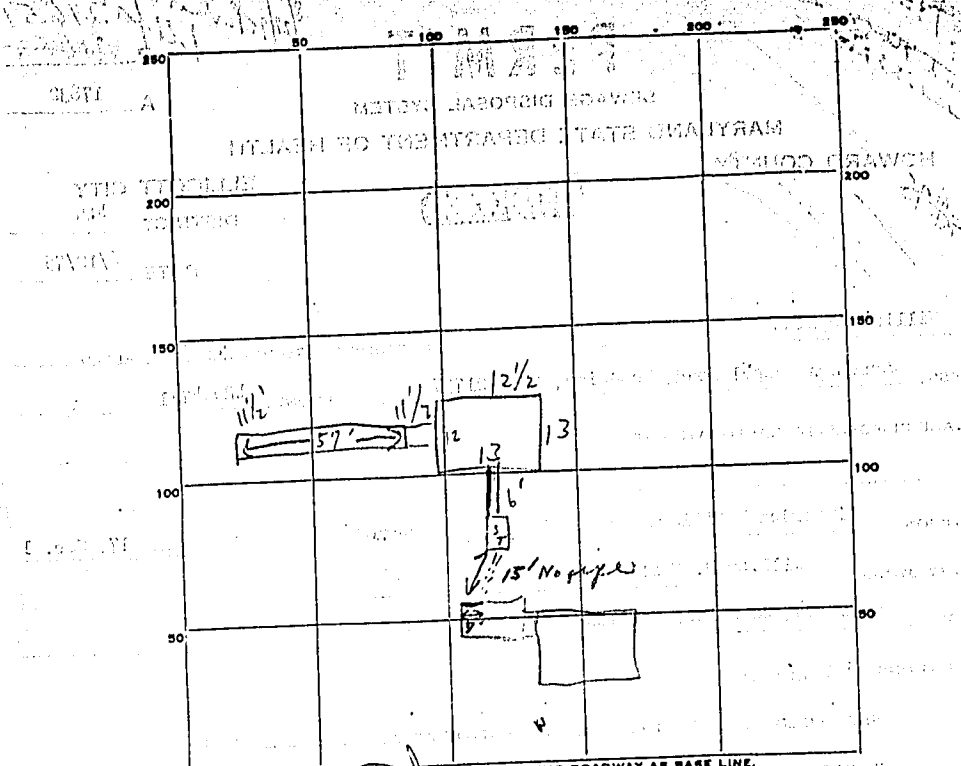

PERMIT CARD Yes partial on Trac
 SEPTIC TANK, LEVEL Yes, on CLEANOUTS No S.T. | D.V.
 DISTRIBUTION BOX, LEVEL Yes 1/27 Yes 4/27 Yes
 TILE FIELD, DEPTH 7 FT. TRENCH WIDTH 57 FT.
 ① GRAVEL DEPTH 7 IN. TOTAL LENGTH 57 FT. 319
 NUMBER OF TRENCHES 1 TOTAL BOTTOM AREA 395
 SEEPAGE PITS, INSIDE DIAMETER 1 FT. DEPTH BELOW INLET 7 1/2 FT. 714
 ABSORBENT AREA 777 1/2 SQ. FT.

REMARKS 8/26/75 Pipes not in at same of in section
1/27/95 8' C.O. no pipe 15' to septic tank!! Hold for
call in house connection!! 10/17/75 Check!!
on on-track filled - located septic tanks close and
Moore and then - left after in middle!!

DATE SYSTEM APPROVED _____ INSPECTOR _____