DEPARTMENT OF INSPECTIONS, LICENSES AND PERMITS 3430 COURT HOUSE DRIVE ELLICOTT CITY, MD 21043 PERMITS (410) 313-2458 INSPECTIONS (410) 313-1810 AUTOMATED INFORMATION (410) 313-3800

Distribution of Copies-

T:Worms\PERMIT.FRM

White: Building Official

Green: LDD, DPZ

Yellow: DED, DPZ

Pinic Health


Gold: SHA

Rev. 11/4//04

## HOWARD COUNTY PERMIT APPLICATION

PERMIT NUMBER

		1 210/111011	200		
Building Address 10925 Tompkins WAY		Property Owner's Name TRINITY QUALITY Homes			
WOODStock MA 3/163		Address			
Suite/Apt. #: SDP/WP/Petition #:		3675 OARK AUE Ellicott City 21043			
Census Tract 60300 Subdivision	Preserve at Waverly Gle	OCitySta	ate Zip C	ode	
Section Area Lot <u>5</u>		Home Phone Work Phone			
Tax Map 31 Parcel 226 Grid		Applicant's Name & Mailing Address, (	if other than stat	ed hereon):	
Zoning RCD Eliap Coordinates 6812		Phone Fax	1/14 21	9Ø777	
Existing Use SFN UNDER Construction		Phone Fax 4/10 - 3/3 - 8 7 3 /  Contractor Company			
Proposed Use DECK					
Estimated Construction Cost \$		Contact Person			
Description of Work 18' X 14' DECK_ W/SHERS		Address			
		City State	e Zip (		
		License No. 699 Phone Fax			
Occupant or Tenant		Engineer or Architect Company SAINE			
Contact Name		Contact Person			
Address					
City State Zip Code		Address	Address		
Phone Fax		City Stat	te Zip	Code	
		Phone Fa	ne Fax		
BUILDING DESCRIPTION - COMMERCIAL		BUILDING DESCRIPTION - RESIDENTIAL			
<b>Building Characteristics</b>	<u>Utilities</u>	Building Characteristics		<u>Utilities</u>	
Height:	Water Supply: Public	SF Dwelling SF Townhouse Depth Width	Water Su		
No. of stories;	Private Sewage Disposal:	1st floor:	Priv		
Gross area, sq. ft. per floor:	Public Private	Basement:	Pul Priv	olic	
Gross area, sq. n. per noor.		Finished Basement ☐ Unfinished Basemer Crawl space ☐ Slab on Grade ☐	nt[]	Yes)2⊠ No 🗆	
Use group:	Electric Yes □ No □ Gas Yes □ No □	No. of Bedrooms	Gas	Yes M No □	
	Heating System:	Multi-family dwellings:  No. of efficiency units:  No. of 1 BR units:	Heating :	System: )xoli □	
Construction type: Reinforced Concrete	Electric □ Oil □   Natural Gas □	No. of 2 BR units:  No. of 3 BR units:	Natural (	Sas 1Sa∵	
Structural Steel	Propane Gas □		Propane		
Masonry Wood Frame	Sprinkler system: N/A □	Other Structure: DECK Dimensions: /8 x /4 u)/5 kps Footings:	Sprinkler system: N/A		
_	Full Partial	Roof Height:		FPA #13R ther:	
State Certified Modular	Other Suppression # of Heads	State Certified Modular Manufactured Home			
THE UNDERSIGNED HEREBY CERTIFIES AND AGREES AS FOLLOWS: HOWARD COUNTY WHICH ARE APPLICABLE THERETO; (4) THAT HE	SHE WILL PERFORM NO WORK ON THE ABOVE REFI	PLICATION; (2) THAT THE INFORMATION IS CORRECT; (3) THAT HERECORRECT HOLD THIS APPRIES OF THE PROPERTY NOT SPECIFICALLY DESCRIBED IN THIS APPRIES OF THE PROPERTY NOT SPECIFICALLY DESCRIBED IN THIS APPRIES.	HE/SHE WILL COMPLY W PPLICATION; (5) THAT HE	ITH ALL REGULATIONS OF EASHE GRANTS COUNTY OFFICIA	
THE RIGHT TO ENTER ONTO THIS PROPERTY FOR THE PURPOSE OF	INSPECTING THE WORK PERMITTED AND POSTING	NOTICES.			
Applicant's Signature	·	SALLY HOL Print Name 12/13/06	- Iu/		
V.P. OPERATIONS - T.	RINITY	/2//3/06 Date			
	** PLEASE WRITE N	F FINANCE OF HOWARD COUNTY EATLY AND LEGIBLY. **			
AGENCY DATE	- FOR OFFI	CE USE ONLY - DPZ SETBACK INFORMATION	N	PROPERTY ID#:	
Land Development, DPZ		Front:	Filling fee	\$	
State Highways		Rear:	Permit fee	\$	
Building Official  Dev. Engineering, DPZ  /	0167	Side:	Excise tax Add'l per. fee	\$ \$	
Health 12/13/06 that the		All minimum setbacks met?	TOTAL FEES		
Fire Protection		YES D NO D	Sub-total paid	STATE	
Is Sediment Control approval required prior to issuance?		Is Entrance Permit required?	Balance due	\$	
YES D NO D		YES NO D	Check		
CONTINGENCY CONSTRUCTION START:		Historic District?	Validation		
ONE STOP SHOP:	NOIAKI. LI	YES NO L			
ONE STOP SHOP.		SDP/Red-line approval data		Accepted by	

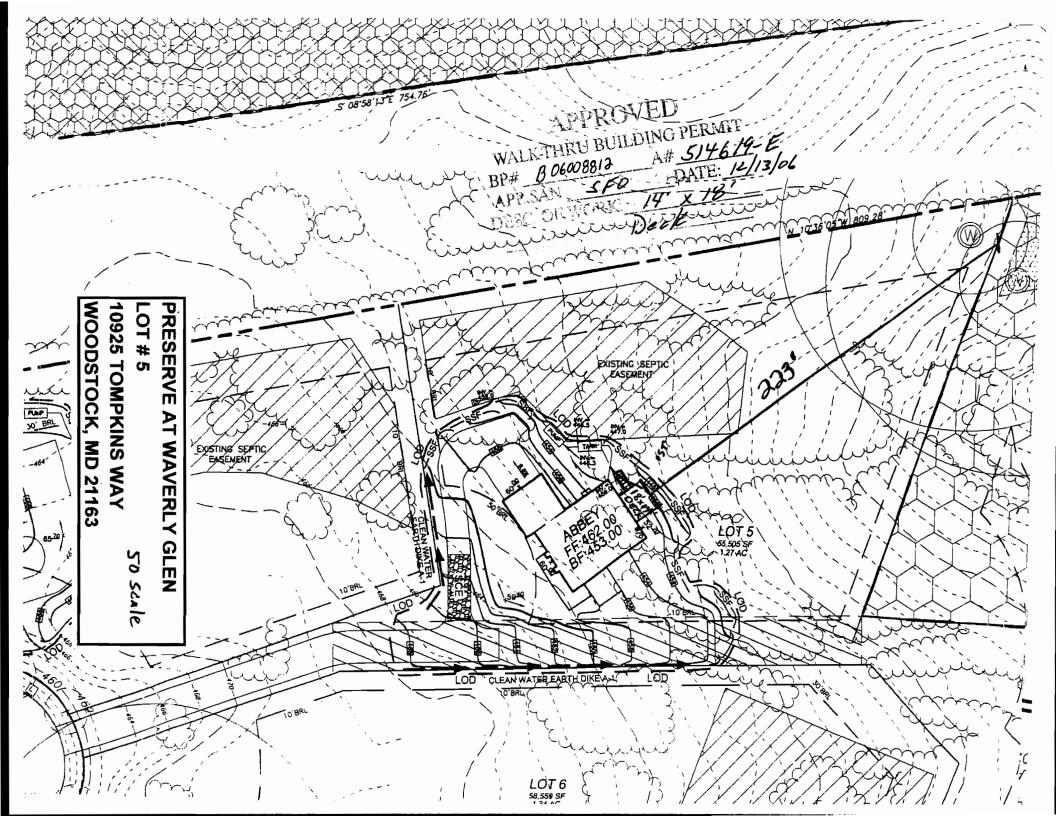

LAYOUT	INSP 4			
INSP 2	INSP 5			
INSP 3	INSP 6			
ISSUE DATE: <u>5/11/06</u>	DEDMIT	P 524463		
APPROVAL DATE: 11/28/	PERMIT	A 514619-E		
ON-SITE SEWAGE DISPOSAL SYSTEM HOWARD COUNTY HEALTH DEPARTMENT BUREAU OF ENVIRONMENTAL HEALTH				
S& K Plumbing & Heating, Inc.	IS PERMITTED TO INS	TALL 🛭 ALTER 🗌		
ADDRESS: 1220 FSK Hwy, Keymar 21757 PHONE NUMBER: 410-775-0562				
SUBDIVISION: Preserve @ Wave	erly Woods LOT NUMBER:	5		
ADDRESS: 10925 Tompkins Way PROPERTY OWNER: Trinity Quality Homes				
SEPTIC TANK CAPACITY (GALLONS): 1500 OUTLET BAFFLE FILTER REQUIRED				
PUMP CHAMBER CAPACITY (GALLONS): 1500 COMPARTMENTED TANK REQUIRED				
NUMBER OF BEDROOMS:	5 BUILDING P	PERMIT SIGNED		
SQUARE FEET PER BEDROOM:	IXO	ETURNED 1814 Occ4		
LINEAR FEET OF TRENCH REQUI		•		

TRENCHES:	Trench to be 3.0 feet wide. Inlet 3.0 feet below original grade. Bottom maximum depth 5.0 feet below original grade. Effective area begins at 3.0 feet below original grade. 2.0 feet of stone below distribution pipe.			
LOCATION:	Place the distribution box as shown on the approved septic plan.			
NOTES:				

DATE:

2/22/06

NOTE: PERMIT VOID AFTER 2 YEARS

PLANS APPROVED:

NOTE: CONTRACTOR RESPONSIBLE FOR SCHEDULING A PRE-CONSTRUCTION INSPECTION FOR ALL INSTALLATIONS

NOTE: WATERTIGHT SEPTIC TANKS REQUIRED

NOTE: ALL PARTS OF SEPTIC SYSTEM SHALL BE 100 FEET FROM ANY WATER WELL

Sara Fegel

NOTE: MANHOLE RISERS REQUIRED ON ALL SEPTIC TANKS AND PUMP CHAMBERS UNLESS SPECIFICALLY AUTHORIZED

NEITHER THE HOWARD COUNTY COUNCIL NOR THE HEALTH DEPARTMENT IS RESPONSIBLE FOR THE SUCCESSFUL OPERATION OF ANY SYSTEM PERMITTEE RESPONSIBLE FOR OBTAINING FINAL APPROVAL ON THIS PERMIT CALL 410-313-2640 FOR INSPECTION OF SEPTIC SYSTEM