

APPLICATION

SEWAGE DISPOSAL TESTING

MARYLAND STATE DEPARTMENT OF HEALTH

HOWARD COUNTY

ELLICOTT CITY

DISTRICT 3

DATE 9/6/66

2 HOLE CONFIRMATION PENC REQ'D.

OWNER ADVISED 6/12/89,

SEE PLAT FOR LOCATION,

C. Williams

TO: THE COUNTY HEALTH OFFICER
ELLICOTT CITY, MARYLAND

I, HEREBY, APPLY FOR THE NECESSARY TESTS IN ORDER TO CONSTRUCT (OR RECONSTRUCT) A SEWAGE DISPOSAL SYSTEM.

PROPERTY OWNER Emilie H. Wolfe (Mrs. Walter J.)

ADDRESS Rt. 2 - Triadelphia Rd., Ellicott City, Md. PHONE KE 1-5262

PROPERTY LOCATION:

SUBDIVISION 11900 LOT NO. B

ROAD AND DESCRIPTION Triadelphia Rd. - across from Evergreen Valley Estates

right hand side - just before Green Henge (5/10 mile in)

OCCUPANT _____ PHONE _____

PERSON TO CONSTRUCT SYSTEM _____

ADDRESS _____ PHONE _____

SIZE OF LOT 1.290 acres TYPE BLDG. 3 or 4

NUMBER OF BEDROOMS

IF NOT SINGLE RESIDENCE DESCRIBE _____

SIGNATURE OF APPLICANT *June W. Ridgely*

APPROVED BY _____ FOR _____ DATE _____

(KIND OF SYSTEM)


REJECTED BY _____ FOR _____ DATE _____

(KIND OF SYSTEM)

HOLD PENDING FURTHER TESTS RH DATE 9/7/66

REASONS FOR REJECTION OR HOLDING 9/7/66 - Hold for Final Plat

THIS IS NOT A PERMIT

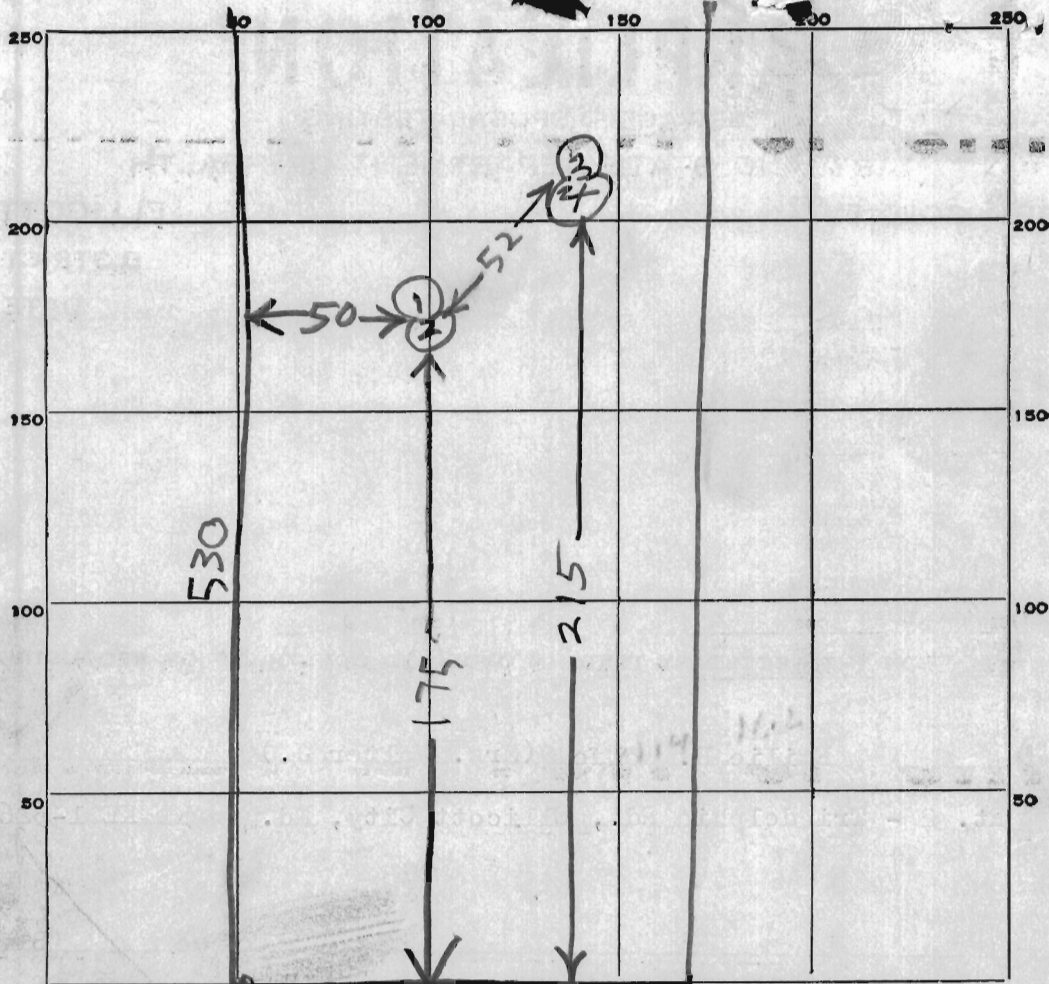

INDICATE NORTH. - NAME ADJOINING ROADWAY AS BASE LINE.

TRIDELPHIA RD

DATE	TEST NO.	DEPTH	PRE-WET		TEST - 1" DROP		TIME
			START	STOP	START	STOP	
9/7/66	1	9 1/2	1032	1034	1034	1036	2
9/7/66	2	5	1032	1036	1036	1040	4
9/7/66	3	9	1038	1039	1039	1041	2
9/7/66	4	5	1038	1110	1st inch 32 min		


SOIL AUGER FINDING

TESTED BY

REMARKS

R. Hodges
J. L. Fiergo

59652
149 KLL
164

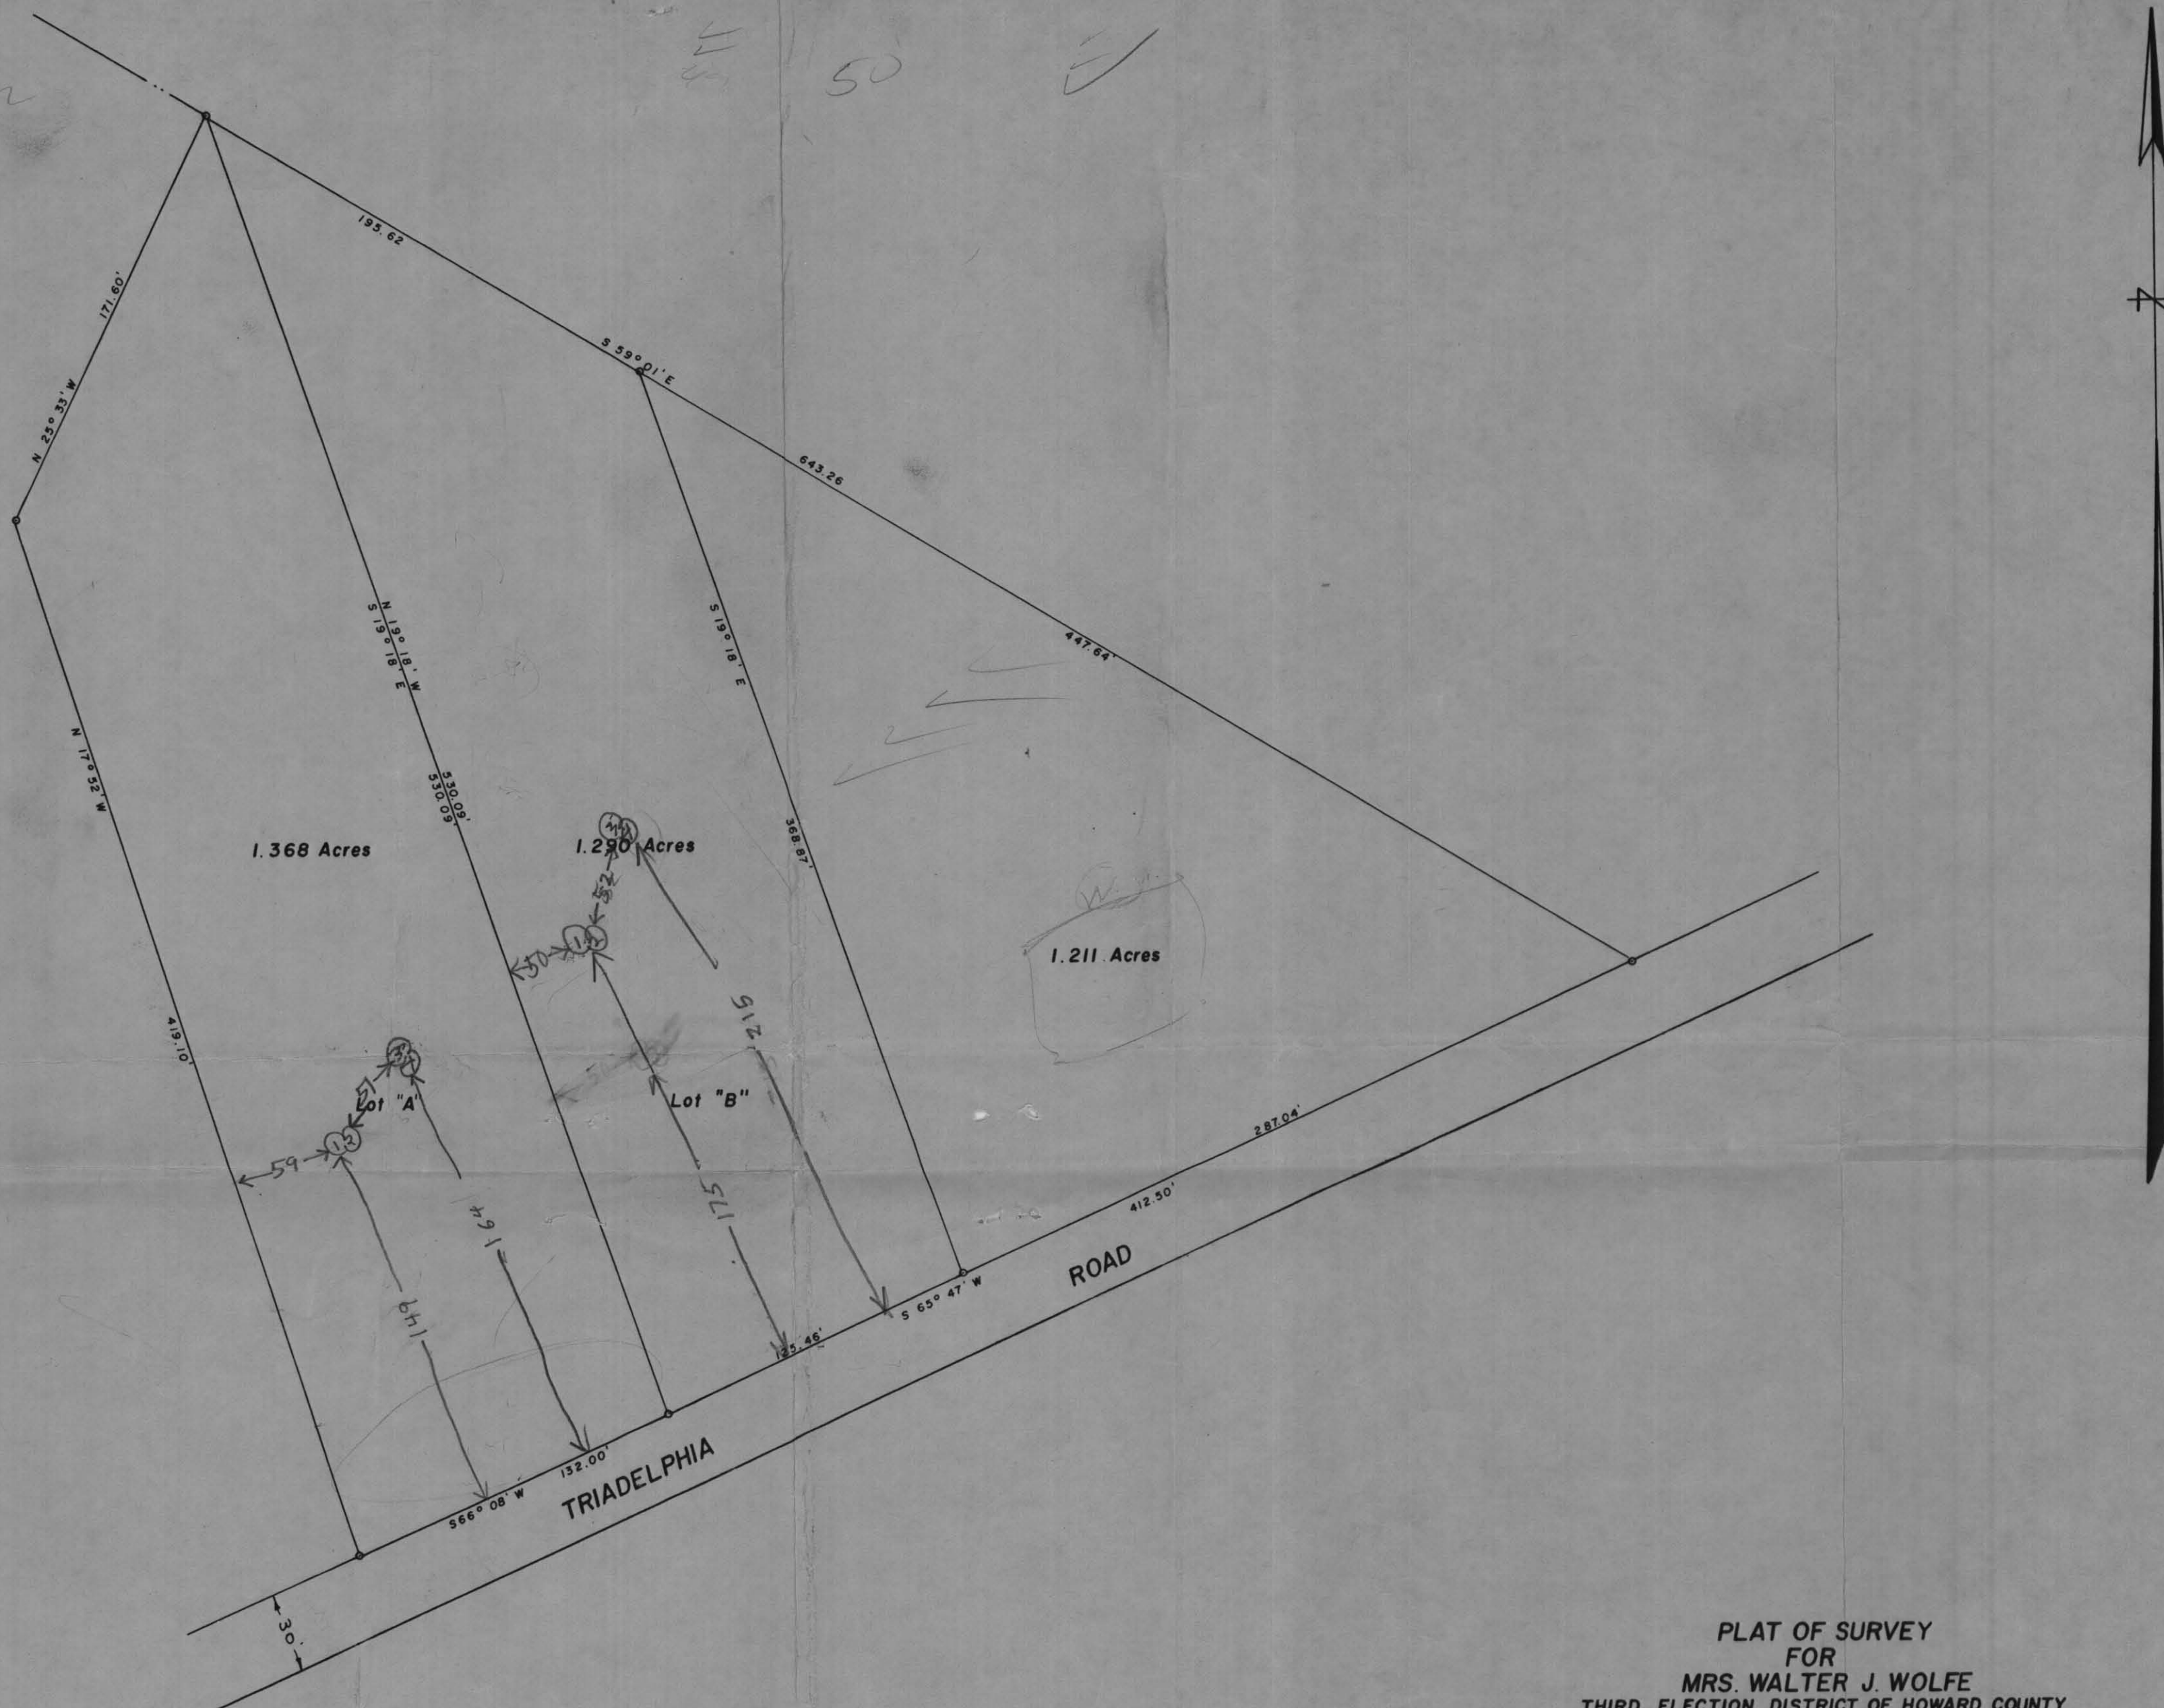

PLAT OF SURVEY
FOR
MRS. WALTER J. WOLFE
THIRD ELECTION DISTRICT OF HOWARD COUNTY
ELLCOTT CITY, MARYLAND
SCALE: 1 IN. = 50 FT. AUGUST 24, 1966

Claude M. Skinner Jr.
Claude M. Skinner Jr. Reg. Eng. & Land Surveyor No. 2237

