

5/9/85
ASAP AM

PERMIT

SEWAGE DISPOSAL SYSTEM

MARYLAND STATE DEPARTMENT OF HEALTH*

HOWARD COUNTY
BUREAU OF ENVIRONMENTAL HEALTH
992-2330

INDEXED

ELLICOTT CITY

DISTRICT 3rd

DATE 5/7/85

Jack Fyock

IS PERMITTED TO INSTALL _____ ALTER X

ADDRESS 11375 Triadelphia Road, Glenelg, Md. 21737 PHONE 988-9270

SUBDIVISION _____ ROAD 11900 Triadelphia RD. LOT _____

PROPERTY OWNER Kirk A. Mercer

ADDRESS 11900 Triadelphia Road, Ellicott City, Md. 21043 Phone: 988-9676

IF GARBAGE GRINDER IS USED INCREASE SEPTIC TANK CAPACITY BY 50% AND ABSORPTION AREA BY 22%.

GARBAGE GRINDER? YES _____ NO X

SEPTIC TANK CAPACITY _____ GALLONS NUMBER OF BEDROOMS 3

REPAIR - Call for an appointment when ground is opened up and Sanitation will
recommend the repair system.

NO COMPLAINT

PURPOSE OF REPAIR

STRAIGHT PIPE TO FIELD
OVERFLOW

PLANS APPROVED BY Craig Williams DATE 5/7/85

COVER NO WORK UNTIL INSPECTED AND APPROVED

NEITHER THE HOWARD COUNTY COUNCIL NOR THE HEALTH DEPARTMENT IS RESPONSIBLE FOR THE SUCCESSFUL OPERATION OF ANY SYSTEM.

NOTE: IF TRENCH IS USED CALL FOR INSPECTION BEFORE AND AFTER PLACING GRAVEL IN TRENCH.

NOTE: NO DRY WELL SHALL EXCEED 15 FOOT IN DIAMETER. NO ABSORPTION TRENCH TO EXCEED 100 FEET IN LENGTH.

NOTE: ALL PIPE FROM HOUSE TO SEPTIC TANK MUST BE CAST IRON OR SCHEDULE 40 PVC OR ABS.

PERMIT VOID AFTER THREE YEARS.

NOTE: INSTALL STAND PIPE ON SEPTIC TANK AND DRY WELL. STAND PIPES MUST BE 6 INCHES IN DIAMETER. CAST IRON, CONCRETE OR TERRA COTTA. OR
PVC OR ABS ACCEPTED. IF TOP OF SEPTIC TANK IS DEEPER THAN 3 FEET MANHOLE TO GRADE REQUIRED.


*INSTALLER IS RESPONSIBLE FOR OBTAINING FINAL APPROVAL ON THIS PERMIT

*CALL 992-2330 FOR INSPECTION OF SEPTIC SYSTEMS.

EH 2-1082

APPROVED
5/9/85
RH P 35440
A Repair

35440
A

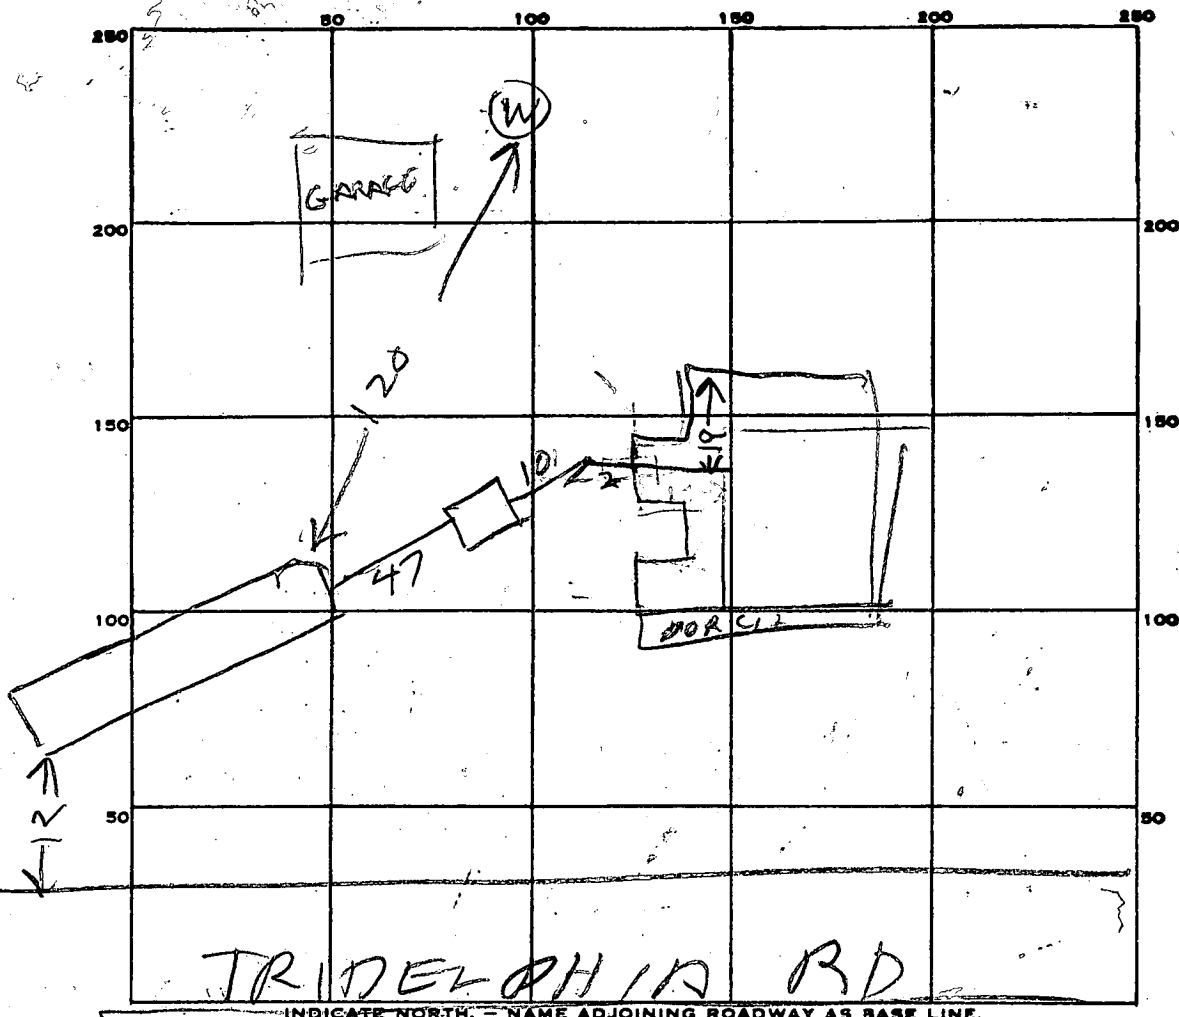

@ into
 9:20
 C.R.
 (stop 12
 on total
 44 76
 7
 522

PERMIT CARD _____

SEPTIC TANK, LEVEL 1000

CLEANOUTS ST
OK

DISTRIBUTION BOX, LEVEL _____

TILE FIELD, DEPTH 4 FT. TRENCH WIDTH 7 FT.

GRAVEL DEPTH 2 IN. TOTAL LENGTH 76 FT.

NUMBER OF TRENCHES _____ TOTAL BOTTOM AREA 522

SEEPAGE PITS, INSIDE DIAMETER _____ FT. DEPTH BELOW INLET _____ FT.

ABSORBENT AREA _____ SQ. FT.

REMARKS 5/9/85 - SOIL LOOKS SANDY ROCK AT 9 FT PER SKIP

DATE SYSTEM APPROVED _____ INSPECTOR _____