


THOMPSON

DRIVE

N 22° 00' 00"E

131.00'

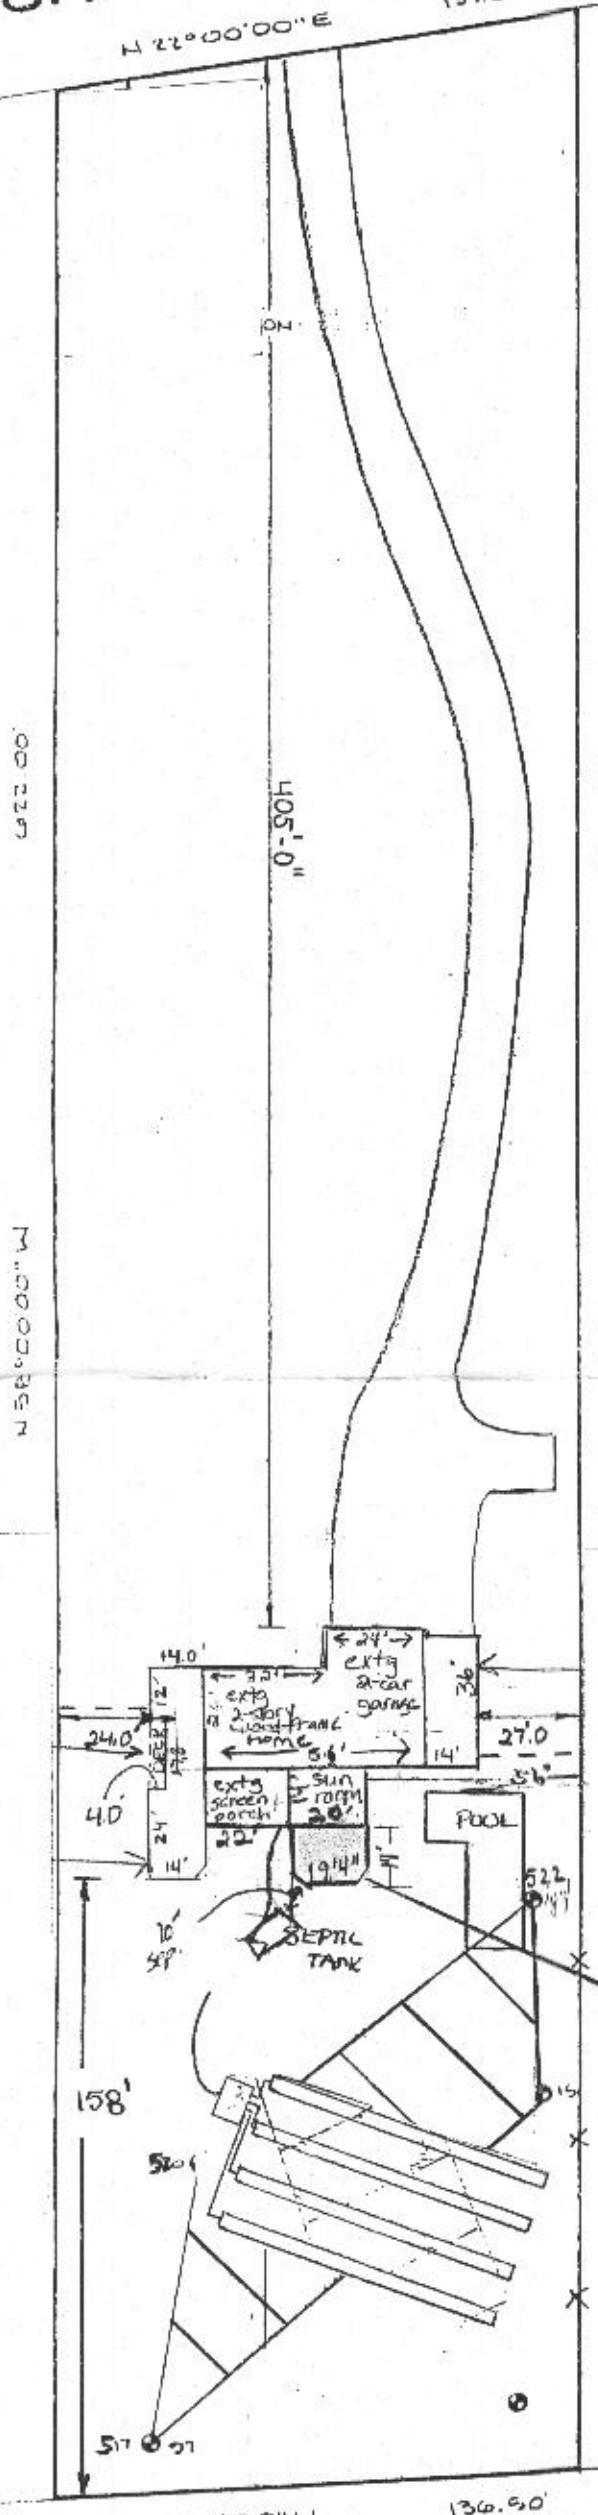

PERCOLATION TEST PLOT

LOT #
2029 THOMPSON DRIVE
TAX MAP 10
DEED REF. L-684 / R-248

SCALE: 1" = 30' DATE: 5/9/87

NOTES:

1. THIS AREA INDICATES A PRIVATE SEWAGE EASEMENT OF APPROXIMATELY 10,000 SQ. FT. AS REQUIRED BY THE MARYLAND STATE DEPARTMENT OF MENTAL HEALTH AND HYGIENE FOR INDIVIDUAL SEWAGE DISPOSAL. IMPROVEMENTS OF ANY NATURE IN THIS AREA ARE RESTRICTED UNTIL PUBLIC SEWERAGE IS AVAILABLE AND SERVICING ANY RESIDENTIAL STRUCTURES CONSTRUCTED ON THIS SITE. THIS EASEMENT SHALL BECOME NULL AND VOID UPON CONNECT TO A PUBLIC SEWERAGE SYSTEM. PERCOLATION TEST HOLES HAVE BEEN FIELD LOCATED AND INDICATED AS .
2. THE LOT SHOWN HEREON COMPLIES WITH THE MINIMUM OWNERSHIP WIDTH AND DIMS AS REQUIRED BY THE MARYLAND STATE DEPARTMENT OF MENTAL HEALTH AND HYGIENE.

APPROVED: FOR PRIVATE WATER AND PRIVATE SEWERAGE SYSTEMS.

COUNTY HEALTH OFFICE

DATE

HUDKINS ASSOCIATES INC.

SUITE 231, HARPERS CHOICE VIL. CTA.
3489 HARPERS FARM ROAD
COLUMBIA, MARYLAND 21044

APPROVED

WALK-THRU BUILDING PERMIT

BP# B00158432 # 14 ~~14~~ 516876-A

APP. SAN 628 DATE: 3/8/00

DESC. OF WORK: 19'4" x 14"

Rick

NOTE WALL BRACING

This plan has been reviewed under the 2003 IRC Code. Check to make sure your wall sheathing is in compliance with Section R602.1

Proposed New
Screened-In Porch
(19'4" x 14")

