

9/30/66
Landy

PERMIT

SEWAGE DISPOSAL SYSTEM

P 12199

A 10134

MARYLAND STATE DEPARTMENT OF HEALTH

HOWARD COUNTY

INDEXED

ELLICOTT CITY

DISTRICT 3

DATE 9/19/66

Excavating Contractors, Inc. IS PERMITTED TO INSTALL X ALTER

ADDRESS 10 Autumn Hill Drive, Ellicott City, Md. PHONE HO 5-3849

A SEWAGE DISPOSAL SYSTEM LOCATED AT

SUBDIVISION Green Henge ROAD Triadelphia Rd. LOT 2

PROPERTY OWNER Carwell, Inc.

ADDRESS

SPECIFICATIONS - 3 bedrooms

DRAIN FIELD DEPTH FEET, BOTTOM AREA SQ. FT.

SEEPAGE PITS ABSORBENT SIDE-WALL AREA SQ. FT.

SEPTIC TANK CAPACITY 750 GALLONS

FOR GARBAGE GRINDER, INCREASE DISPOSAL AREA 22% & TANK CAPACITY 50%.

OTHER Dry well - 300 sq. ft. absorbent sidewall area below the inlet pipe located 138 ft. from front lot line and 35 ft. from right side lot line as seen when facing lot from Triadelphia Rd.

PLANS APPROVED BY J. H. Kilmore DATE 3/9/66


FILL SEPTIC TANK AND DISTRIBUTION BOX WITH WATER BEFORE CALLING FOR AN INSPECTION. COVER NO WORK UNTIL INSPECTED AND APPROVED.

NEITHER THE HOWARD COUNTY COMMISSIONERS NOR THE HEALTH DEPARTMENT IS RESPONSIBLE FOR THE SUCCESSFUL OPERATION OF ANY SYSTEM.

NOTIFY THE HEALTH DEPARTMENT 48 HOURS
BEFORE EXCAVATIONS ARE TO BE BACK FILLED.

2 10134

A 10134

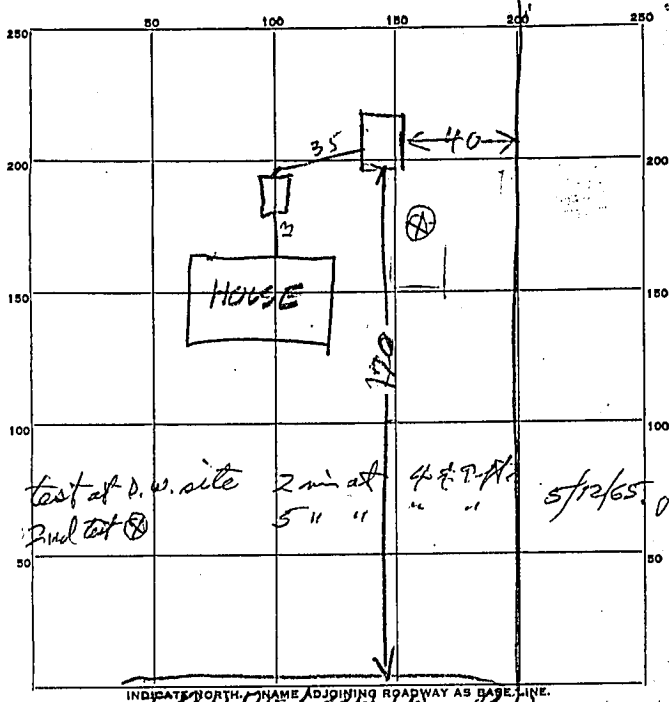

test at d.v. site 2 in at 4 ft. 5/12/65 JHK
 2nd test 5 " " " " " "

well hunt
 #67-W-128

PERMIT CARD

YES

SEPTIC TANK, LEVEL OK concide 1000CLEANOUTS OK

DISTRIBUTION BOX, LEVEL _____

TILE FIELD, DEPTH _____ FT. TRENCH WIDTH _____ FT.

GRAVEL DEPTH _____ IN. TOTAL LENGTH _____ FT.

NUMBER OF TRENCHES _____ TOTAL BOTTOM AREA _____

SEEPAGE PITS, INSIDE DIAMETER 12 FT. DEPTH BELOW INLET 9 1/2 FT.ABSORBENT AREA 496 SQ. FT.counting stone
 not counting stoneREMARKS: 9/30/65 PW Dry Well Inlet is 7-8 FT below grade

Perimeter of Dry Well = 52 FT $52 \times 9.5 = 496$ counting
 stone 3 BEDROOMS - 300 sq ft max

Dry Well installed too deep Retest Needed

5 OCT 66 - P.W. inspected system & decided to approve
 it without retest because Maximum Depth of system not over 10
 ft in future All Max Depth to be

DATE SYSTEM APPROVED 5 OCT 66INSPECTOR P.W.