

APPLICATION

A 08518

SEWAGE DISPOSAL TESTING

P _____

MARYLAND STATE DEPARTMENT OF HEALTH

HOWARD COUNTY

ELLICOTT CITY

DISTRICT 3

DATE 6/2/64

*Dry well 11 ft in dia by 11 1/2 ft. deep
below the inlet located 175 ft. from
the front property line and 41 ft. off
the left side property line as seen when facing
lot from Triadelphia Rd. Inlet at 3 FT below
original grade.*

*750 gal septic
Tank.*

TO: THE COUNTY HEALTH OFFICER
ELLICOTT CITY, MARYLAND

I, HEREBY, APPLY FOR THE NECESSARY TESTS IN ORDER TO CONSTRUCT (OR RECONSTRUCT) A SEWAGE DISPOSAL SYSTEM.

PROPERTY OWNER William Adams

ADDRESS Rt. 40 - Ellicott City, Maryland PHONE _____

PROPERTY LOCATION:

SUBDIVISION Old House LOT NO. _____

ROAD AND DESCRIPTION Triadelphia Road - approx. 1 mi. off Rt. 144 -
right hand side.

OCCUPANT _____ PHONE _____

PERSON TO CONSTRUCT SYSTEM _____

ADDRESS _____ PHONE _____

SIZE OF LOT 1 acre TYPE BLDG. 3

NUMBER OF BEDROOMS

IF NOT SINGLE RESIDENCE DESCRIBE _____

SIGNATURE OF APPLICANT James E. Hennigan


APPROVED BY James E. Hennigan FOR Dry Well DATE 6-4-64

REJECTED BY _____ FOR _____ DATE _____

HOLD PENDING FURTHER TESTS _____ DATE _____

REASONS FOR REJECTION OR HOLDING _____

THIS IS NOT A PERMIT

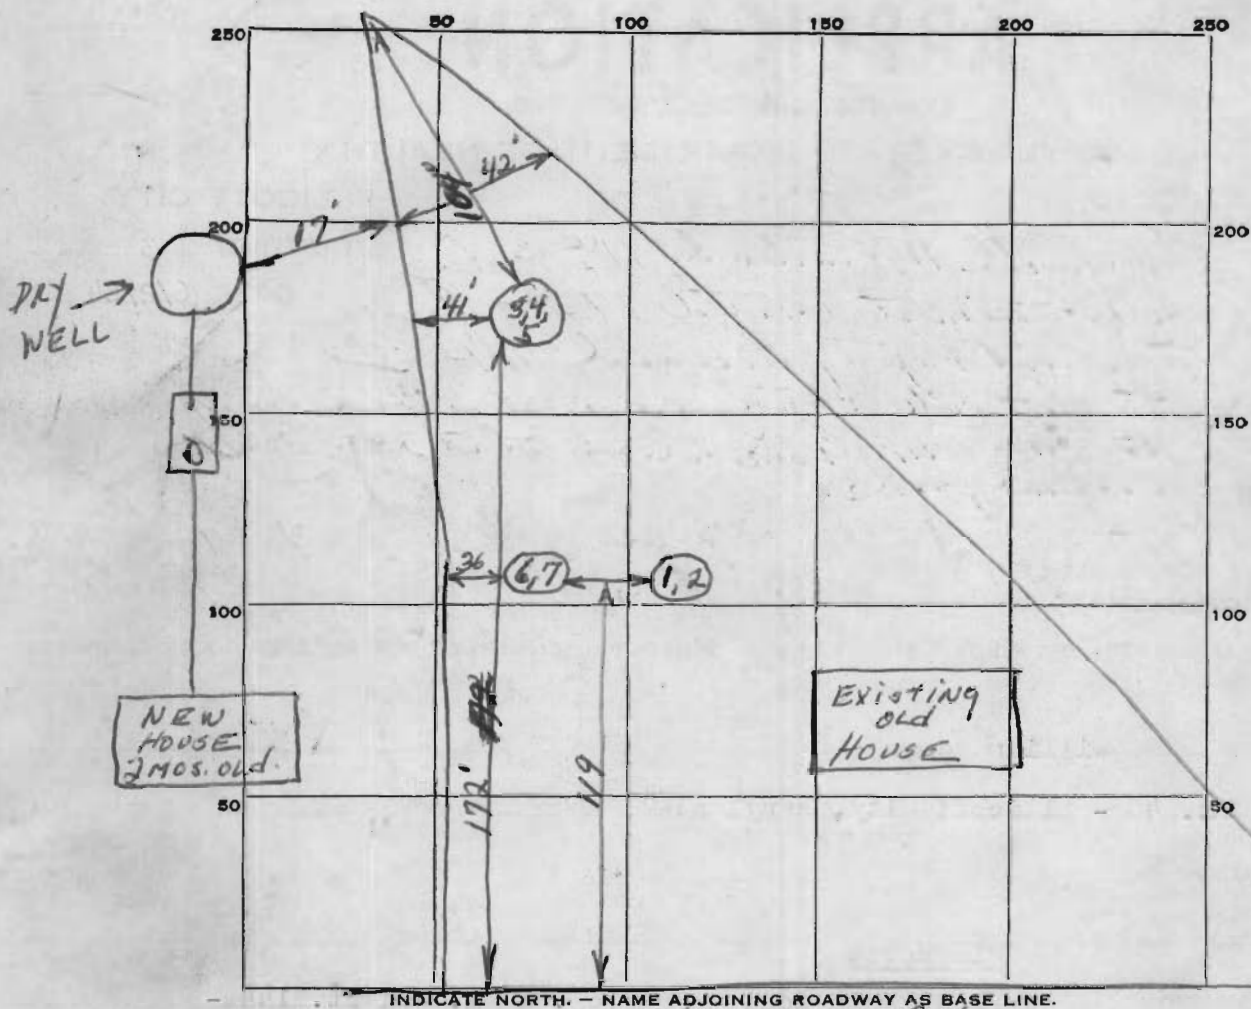

TRIDELPHIA Rd.

DATE	TEST NO.	DEPTH	PRE-WET		TEST - 1" DROP		TIME
			START	STOP	START	STOP	
6-4-64	1 Same	9 1/2'	9:46	9:48	9:48	9:52	4 min.
	2 Pit	5'	9:50	overtime - but ground looked good.			
	3	9'	10:48	10:49	10:49	10:52	3 min.
	4 Same test hole but 1/2' deeper	10 1/2'	10:53	slow	22 min 1/2 unit		
	5	5 1/2'	11:23	11:31	11:31	11:43	12 min.
	6 Same		12:07	1/2"	35 min		
	7 Pit	10 1/2'	12:15	3/4"	27 min		

SOIL AUGER FINDING

TESTED BY

REMARKS

ALSO PRESENT

LOT NO.