

APPLICATION

PERCOLATION TESTING

- WET SEASON -

HOWARD COUNTY, HEALTH DEPARTMENT
BUREAU OF ENVIRONMENTAL HEALTH
P.O. BOX 476 ELLICOTT CITY, MARYLAND 21043
TELEPHONE: 461-9933

A 42830
P _____
DISTRICT 3
DATE 9/14/88

EXISTING HOUSE UPHILL AND
REMOTE ADDITIONAL TEST NOT
REQUIRED SA

Get NAME OF PREVIOUS OWNER TO HELP
LOCATE FILES.

TO: THE COUNTY HEALTH OFFICER
ELLICOTT CITY, MARYLAND

I, HEREBY, APPLY FOR THE NECESSARY TEST IN ORDER TO CONSTRUCT (OR RECONSTRUCT) A SEWAGE DISPOSAL SYSTEM.

* PROPERTY OWNER Charles and Joan Rapp David Moymihan
ADDRESS 12195 Triadelphia Rd. E.C. MD. 21043 PHONE 410-531-6982
PROSPECTIVE BUYER Larry & Diana White and Robert Johansen - owner
ADDRESS 9540 Saddlebag Row Columbia MD. 21045 PHONE 740-5379
6162 Clear Smoke Ct. Columbia MD. 21045
PROPERTY LOCATION: 12195 Triadelphia Rd. E.C., MD. 21045
SUBDIVISION N/A LOT NO. _____
ROAD AND DESCRIPTION 12195 Triadelphia Rd. Ellicott City, MD. 21043

TAX MAP _____ PARCEL # _____
SIZE OF LOT 8.1 Acres TYPE BLDG. SFH
(SINGLE FAMILY DWELLING OR COMMERCIAL)

THE SYSTEM INSTALLED UNDER THIS APPLICATION IS ACCEPTABLE ONLY UNTIL PUBLIC FACILITIES BECOME AVAILABLE. I FULLY UNDERSTAND THE
FEE CONNECTED WITH THE FILING OF THIS PERC TEST APPLICATION IS NON-REFUNDABLE UNDER ANY CIRCUMSTANCES. I ALSO AGREE TO COMPLY
WITH ALL M.O.S.H.A. REQUIREMENTS IN TESTING THIS LOT. Diana Hepta-White
(SIGNATURE OF APPLICANT)

APPROVED BY _____ FOR _____ DATE _____
REJECTED BY _____ FOR _____ DATE _____
HOLD PENDING FURTHER TESTS _____ DATE _____

REASONS FOR REJECTION OR HOLDING _____

BLDG. PERMIT SIGNED
AND RETURNED 9/14/88
Serial # 47361 - SFH
3 Bedrooms




THIS IS NOT A PERMIT

381-4288

ANY PROBLEMS CALL DAVE WDESSNER 4651121

A 42830

SOIL PROFILE

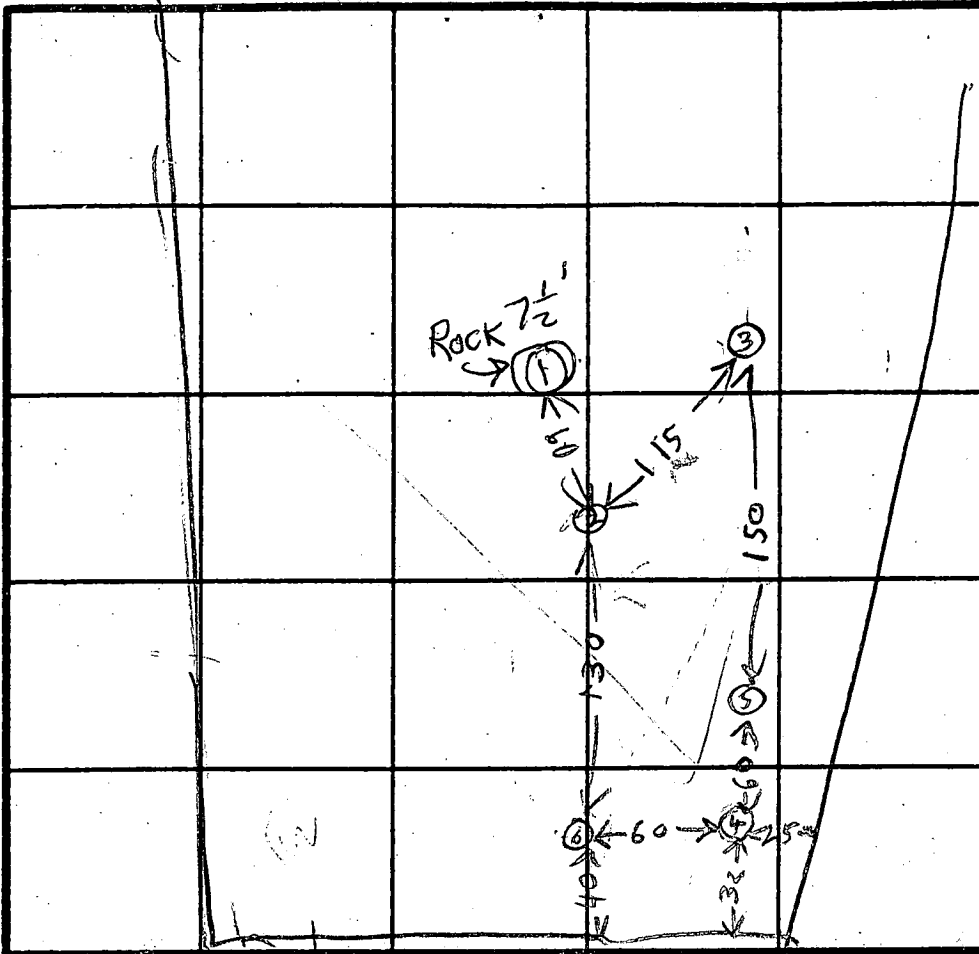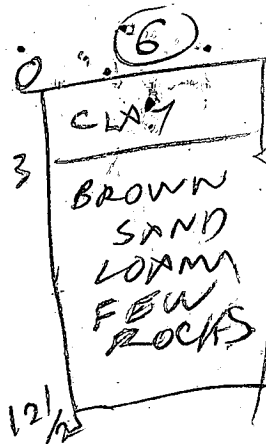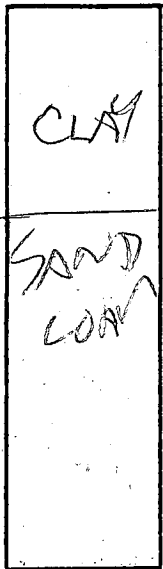

$\bar{x} = 10$
210 ABR
Inlet 4.5'
Bottom 8.5'

INDICATE NORTH - NAME ADJOINING ROADWAY AS BASE LINE.

TRIDELPHIA RD

DATE	TEST NO.	DEPTH	PREWET		TEST - 1" DROP		TIME
			START	STOP	START	STOP	
3/17/89	1V	7 1/2	ROCK	BOTTOM	FAIL		
	2V	5	153	201	201	222	21
	3V	11	OK				
	3S	5.5	203	210	210	216	6
	4S	15	OK				
	4V	5	216	217	217	218	2
	5V	13	OK				
	6V	12	OK				
	6V	4	225	229	229	245	13
	6V	12 1/2	OK				

REMARKS

TYPE OF SOIL

TESTED BY

R HODGES

ALSO PRESENT

DAVE WESSEREN
DILANA
JACK FYOCK
JACK KAMER
ROCKY

