


*Paid \$330.00
Repair Permit
+ 11 per*

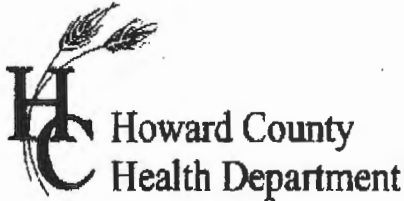

APPLICATION

FOR PERCOLATION TESTING AND SITE EVALUATION

TEST DATE(S) _____ TEST TIME _____ (AP) 523587
AGENCY REVIEW: _____ DATE 11/1/05

DO NOT WRITE ABOVE THIS LINE

I HEREBY APPLY FOR THE NECESSARY TESTING/EVALUATION PRIOR TO ISSUANCE OF SEWAGE DISPOSAL SYSTEM PERMIT(S) TO:

CHECK AS NEEDED:

- CONSTRUCT NEW SEPTIC SYSTEM(S)
- REPAIR/ADD TO AN EXISTING SEPTIC SYSTEM
- REPLACE AN EXISTING SEPTIC SYSTEM

CHECK AS NEEDED:

- NEW STRUCTURE(S)
- ADDITION TO AN EXISTING STRUCTURE
- REPLACE AN EXISTING STRUCTURE

CHECK ONE:

- CREATE NEW LOT(S)
- BUILD ON AN EXISTING LOT IN A SUBDIVISION
- BUILD ON AN EXISTING PARCEL OF RECORD

IS THE PROPERTY WITHIN 2500' OF ANY RESERVOIR?

- YES
- NO

THE TYPE OF STRUCTURE IS:

- RESIDENTIAL WITH 3 PROPOSED BEDROOMS IN THE COMPLETED STRUCTURE (NOTE UNKNOWN IF APPROPRIATE)
- COMMERCIAL (PROVIDE DETAIL OF NUMBERS AND TYPES OF EMPLOYEES/ CUSTOMERS ON ACCOMPANYING PLAN)
- INSTITUTIONAL/GOVERNMENT (PROVIDE DETAIL OF NUMBERS AND TYPES OF EMPLOYEES/USERS ON ACCOMPANYING PLAN)

PROPERTY OWNER(S) Belean

DAYTIME PHONE (410) 531-7619 CELL _____ FAX _____

MAILING ADDRESS 12256 Woodspurge Ct Ellicott City Md
STREET CITY/TOWN STATE ZIP

APPLICANT Fyock septic service

DAYTIME PHONE 410-988-9270 CELL 240-882-4025 FAX _____

MAILING ADDRESS po Box 89 Glennville Md 21737
STREET CITY/TOWN STATE ZIP

APPLICANT'S ROLE: DEVELOPER BUILDER BUYER RELATIVE/FRIEND REALTOR CONSULTANT

PROPERTY LOCATION
SUBDIVISION/PROPERTY NAME Woodmark LOT NO. _____

PROPERTY ADDRESS 12256 Woodspurge Ct
STREET TOWN/POST OFFICE

TAX MAP PAGE(S) _____ GRID _____ PARCEL(S) _____ PROPOSED LOT SIZE _____

AS APPLICANT, I UNDERSTAND THE FOLLOWING: THE SYSTEM INSTALLED SUBSEQUENT TO THIS APPLICATION IS ACCEPTABLE ONLY UNTIL PUBLIC SEWERAGE IS AVAILABLE. THIS APPLICATION IS COMPLETE WHEN ALL APPLICABLE FEES AND A SUITABLE SITE PLAN HAVE BEEN RECEIVED. I ACCEPT THE RESPONSIBILITY FOR COMPLIANCE WITH ALL M.O.S.H.A. AND "MISS UTILITY" REQUIREMENTS. APPROVAL IS BASED UPON SATISFACTORY REVIEW OF A PERC CERTIFICATION PLAN.

TEST RESULTS WILL BE MAILED TO APPLICANT. Robert Fyock
SIGNATURE OF APPLICANT

HOWARD COUNTY HEALTH DEPARTMENT, BUREAU OF ENVIRONMENTAL HEALTH, WELL AND SEPTIC PROGRAM
3525-H ELLICOTT MILLS DRIVE, ELLICOTT CITY, MARYLAND 21043-4544 (410) 313-1771 FAX (410) 313-2648
TDD (410) 313-2323 TOLL FREE 1-877-4MD-DHMH

APPLICATION

PERCOLATION TESTING

A 523587

P 523587

HOWARD COUNTY HEALTH DEPARTMENT
BUREAU OF ENVIRONMENTAL HEALTH
3525-H ELLICOTT MILLS DRIVE/ELLICOTT CITY, MARYLAND 21043
TELEPHONE: 313-2640

DISTRICT _____

DATE _____

TO: THE COUNTY HEALTH OFFICER
ELLICOTT CITY, MARYLAND

I HEREBY APPLY FOR THE NECESSARY TEST PRIOR TO APPLICATION FOR PERMIT TO CONSTRUCT (OR RECONSTRUCT) A SEWAGE DISPOSAL SYSTEM.

~~PROPERTY OWNER _____~~

~~ADDRESS _____ PHONE _____~~

~~AGENT OR PROSPECTIVE BUYER _____~~

~~ADDRESS _____ PHONE _____~~

PROPERTY LOCATION:

SUBDIVISION Woodmark LOT NO. 3, Block B

ROAD AND DESCRIPTION 12256 Woodspurge Court

TAX MAP 22 PARCEL # 167, Block 6

SIZE OF LOT _____ TYPE BLDG. _____
(SINGLE FAMILY DWELLING OR COMMERCIAL)

THE SYSTEM INSTALLED UNDER THIS APPLICATION IS ACCEPTABLE ONLY UNTIL PUBLIC FACILITIES BECOME AVAILABLE. I FULLY UNDERSTAND THE FEE CONNECTED WITH THE FILING OF THIS PERC TEST APPLICATION IS NON-REFUNDABLE UNDER ANY CIRCUMSTANCES. I ALSO AGREE TO COMPLY WITH ALL M.O.S.H.A. REQUIREMENTS IN TESTING THIS LOT.

(SIGNATURE OF APPLICANT)

APPROVED BY _____ FOR _____ DATE _____

DISAPPROVED BY _____ FOR _____ DATE _____

HOLD PENDING FURTHER TESTS _____

REASONS FOR REJECTION OR HOLDING _____

PERCOLATION TEST PLAT/PRELIMINARY PLAT - TITLE OR I.D. # _____ DATE _____

SITE DEVELOPMENT PLAN/FINAL PLAT - TITLE OR I.D. # _____ DATE _____

THIS IS NOT A PERMIT

COUNTY #

SOIL PROFILE

0'

Red Br
Cl Loam
~5% Rock

2'

Red Br
Sa Cl Loam
Trace Rock


4'-4.5'

Red, Or
and Tan
Sa Loams
~15% Rock
and
Saprolite

15.5'

SOIL PROFILE

0'

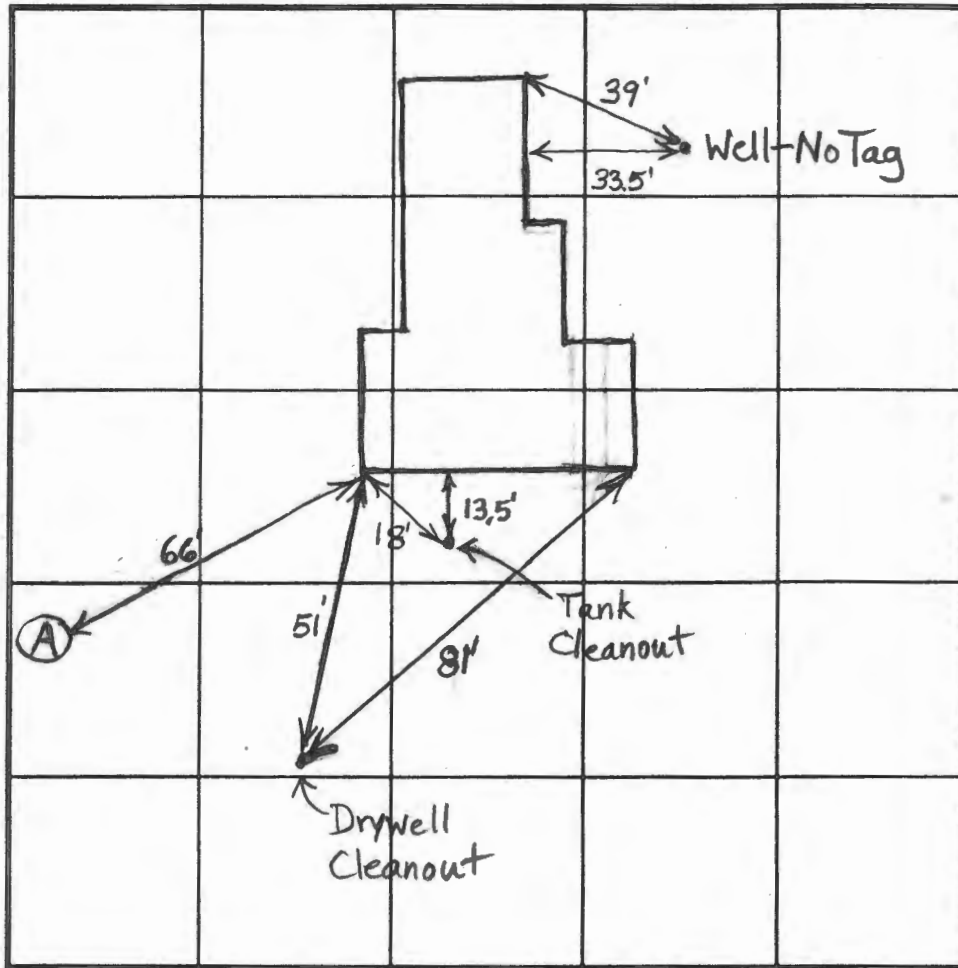

INDICATE NORTH - NAME ADJOINING ROADWAY AS BASE LINE.

Carroll Mill Road

| DATE | TEST NO. | DEPTH | PRE-WET | | TEST - 1" DROP | | TIME |
|----------|----------|------------|---------|----------|----------------|------|------|
| | | | START | STOP | START | STOP | |
| 11/30/05 | A | 5.5'/15.5' | 12:42 | 12:52:30 | 1:16:30 | 18 | P |
| | | 6.5' | 1:25:30 | 1:30 | 1:42 | 12 | P |
| | | | | | | | |
| | | | | | | | |
REMARKS

TYPE OF SOIL

TESTED BY B. Baker

ALSO PRESENT Robert Fyock

TRENCH DESIGN DATA: AVERAGE PERCOLATION TIME 15

TRENCH WIDTH 2'

INLET DEPTH 5'

MAXIMUM BOTTOM DEPTH 11'

SQ. FT./BEDROOM 210

| COORDINATE TABLE | | |
|------------------|------------|------------|
| No. | NORTH | EAST |
| 29 | 525394.456 | 816210.083 |
| 30 | 525521.561 | 815910.245 |
| 66 | 526032.558 | 815780.404 |
| 67 | 525899.896 | 815524.299 |
| 68 | 525877.627 | 815388.540 |
| 80 | 525619.703 | 816312.675 |
| 93 | 525871.514 | 815317.280 |
| 129 | 525945.269 | 816492.505 |
| 130 | 526344.236 | 816087.234 |
| 411 | 525683.683 | 815406.630 |
| 1561 | 525394.081 | 815385.559 |

| CURVE DATA | | | | | | |
|------------|---------|---------|-----------|---------|-------------|----------------------|
| No. - No. | RADIUS | ARC | DELTA | TANGENT | CHORD | BEARING AND DISTANCE |
| 66 - 67 | 465.00' | 293.26' | 36°08'05" | 151.69' | 552°36'57"W | 288.43' |
| 93 - 68 | 465.00' | 71.59' | 08°49'17" | 35.87' | N85°05'49"E | 71.52' |

| MINIMUM LOT AREA TABULATION | | | | | | |
|-----------------------------|------------|----------------|----------------|---------------------|------------|------------------|
| LOT No. | GROSS AREA | PIPE STEM AREA | REMAINING AREA | 100 YEAR FLOODPLAIN | 25% SLOPES | MINIMUM LOT SIZE |
| 7 | 4.439 AC. | 0.000 AC. | 4.439 AC. | 1.223 AC. | 0.000 AC. | 3.216 AC. |
| 8 | 4.185 AC. | 0.000 AC. | 4.185 AC. | 0.638 AC. | 0.000 AC. | 3.547 AC. |
| 9 | 5.749 AC. | 0.000 AC. | 5.749 AC. | 0.962 AC. | 0.212 AC. | 4.575 AC. |

VEHICULAR INGRESS & EGRESS IS RESTRICTED



Existing 100 Year Floodplain & Drainage Easement Plat Nos. 4097 And 11086

LOT 10 WOODMARK SECTION 13, AREA 1 PLAT No. 11086

The Requirements §3-106, The Real Property Article, Annotated Code of Maryland, 1988 Replacement Volume, As Supplemented As Far As They Relate To The Making Of This Plat And The Setting Of Markers Have Been Complied With

Terrill A. Fisher 8/20/99 Date
John F. Brinker 8/30/99 Date
Mary K. Brinker 8/30/99 Date
 Mary K. Brinker, Owner

| PRIVATE 30' ACCESS EASEMENT METES AND BOUNDS CHART | | |
|--|----------------------|--|
| SYM | BEARING AND DISTANCE | |
| A | R=93.35' L=34.85' | |
| B | S24°03'43"E 196.68' | |
| C | R=500.00' L=67.29' | |
| D | S16°21'05"E 69.20' | |
| E | R=100.00' L=88.29' | |
| F | S34°13'58"W 173.32' | |
| G | R=220.00' L=133.97' | |
| H | R=465.00' L=154.34' | |
| I | S88°09'55"W 238.68' | |
| J | R=150.00' L=63.79' | |
| K | S63°48'00"W 32.39' | |
| L | R=150.00' L=72.53' | |

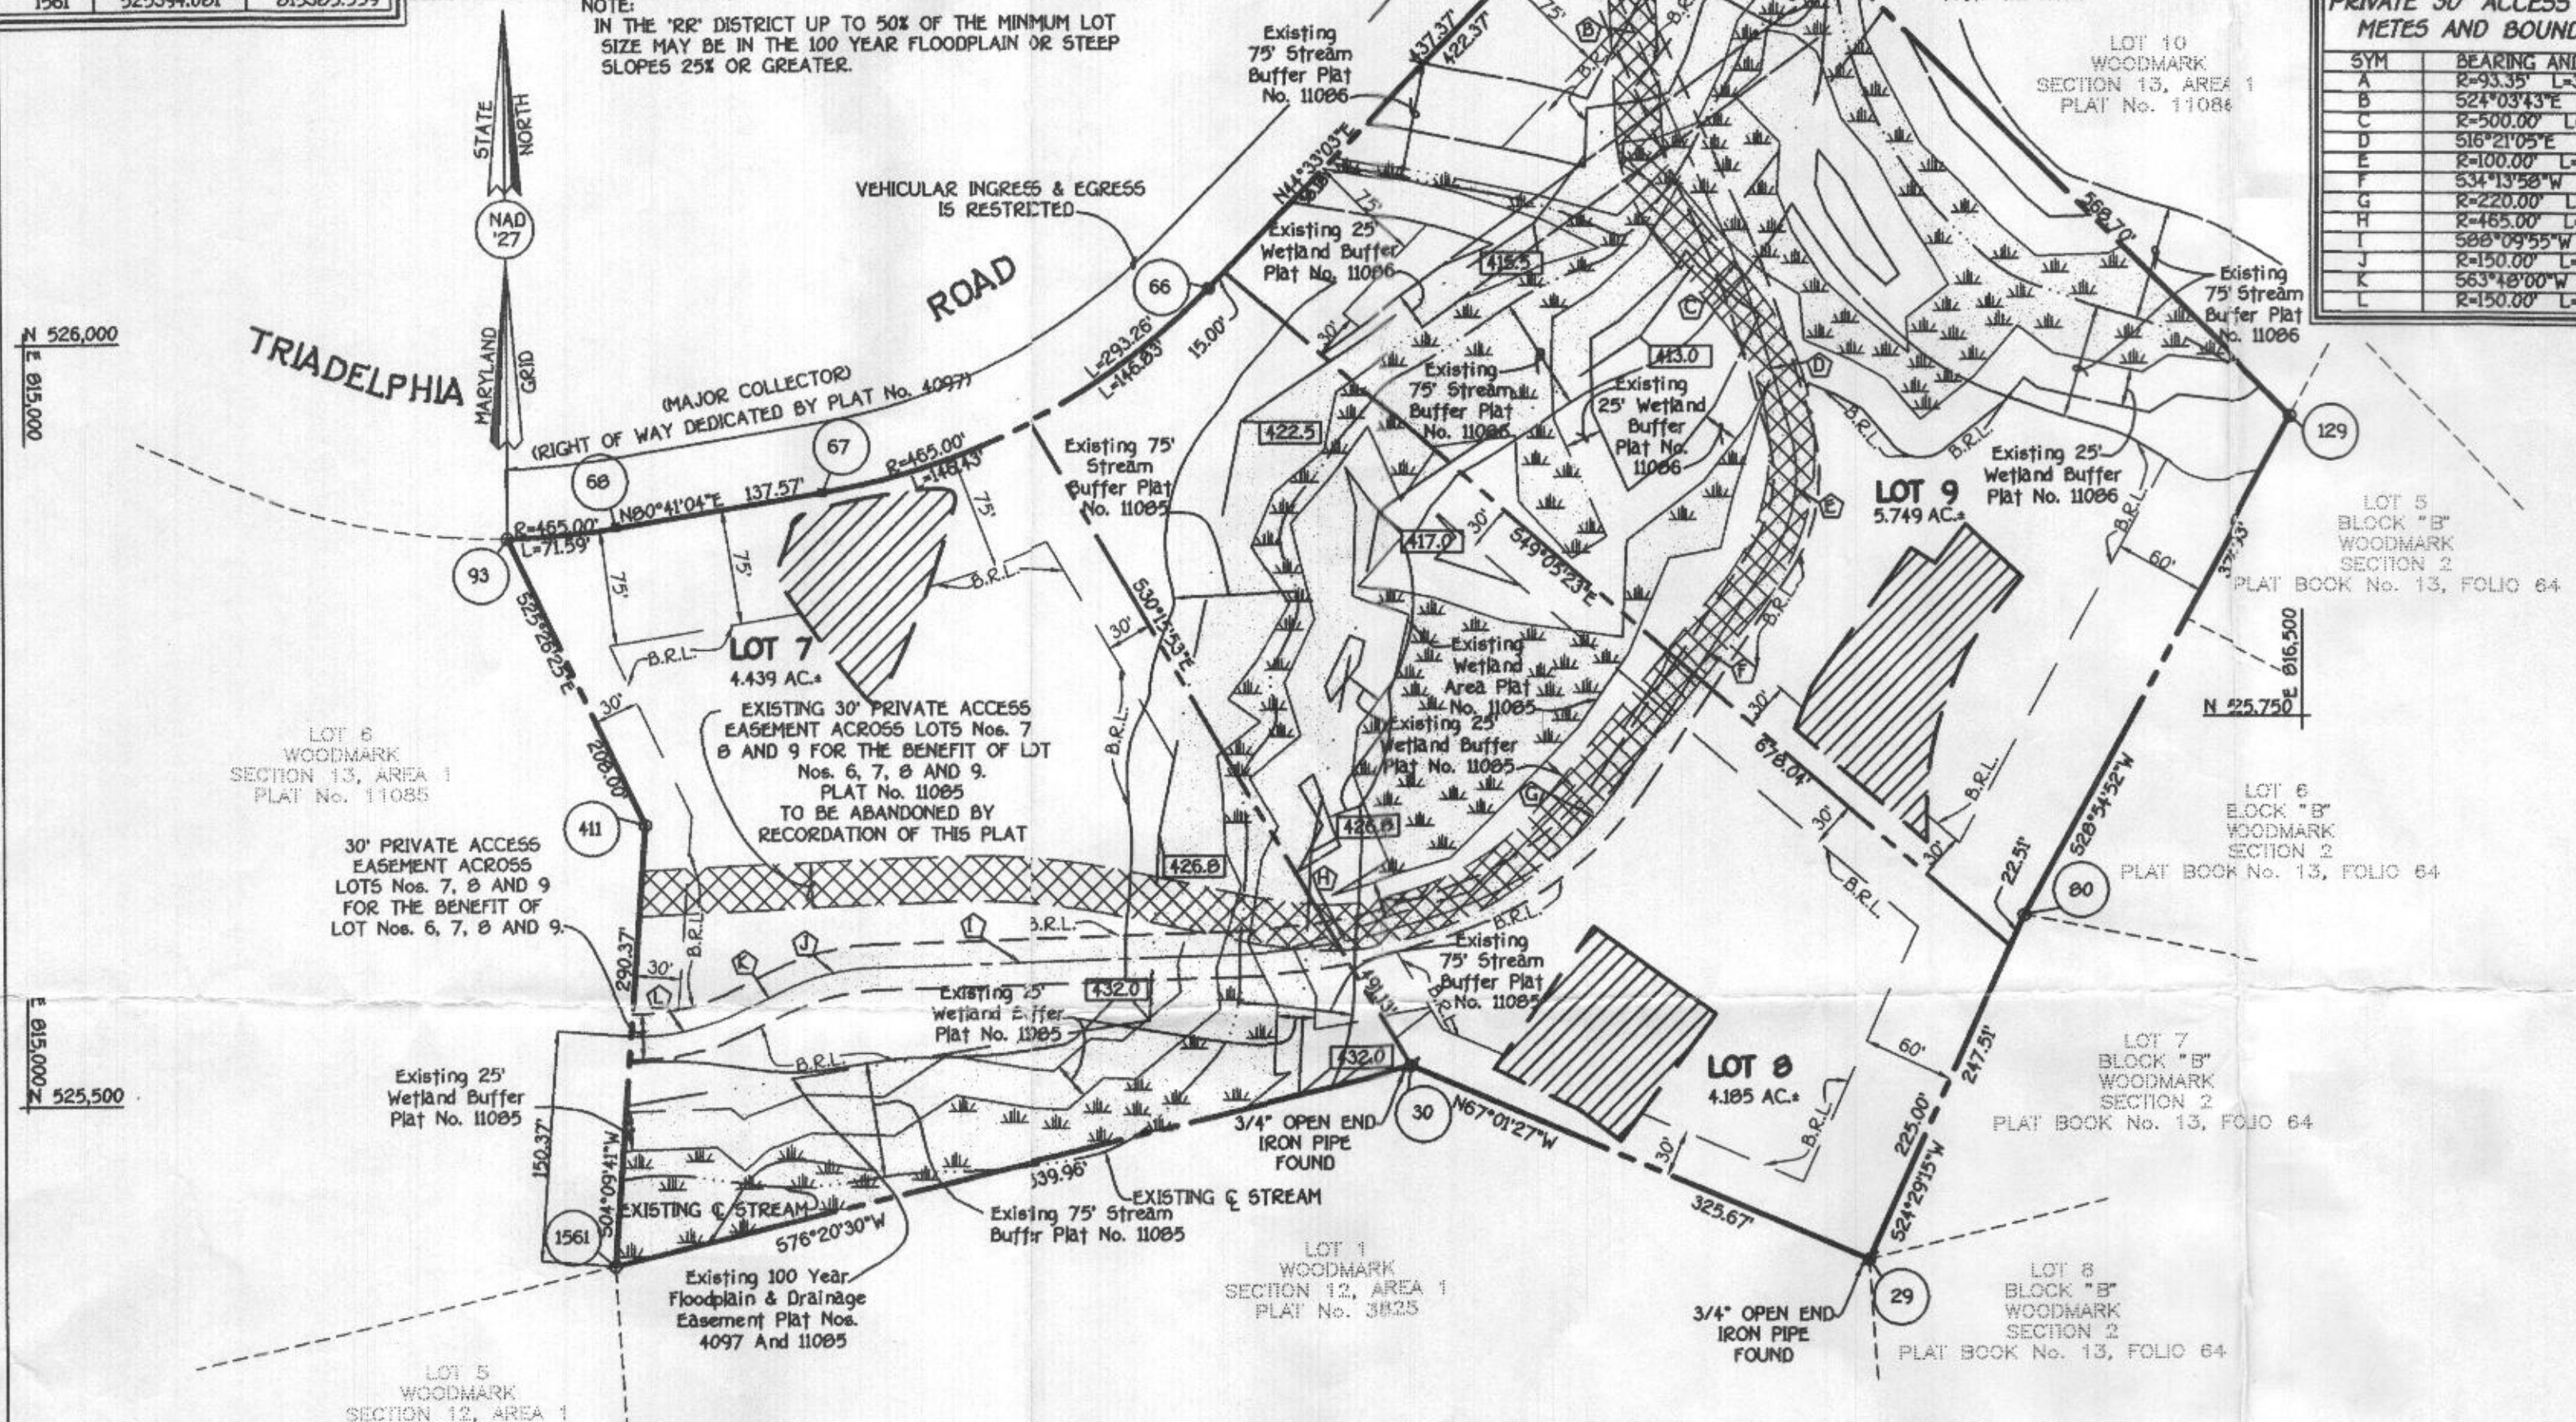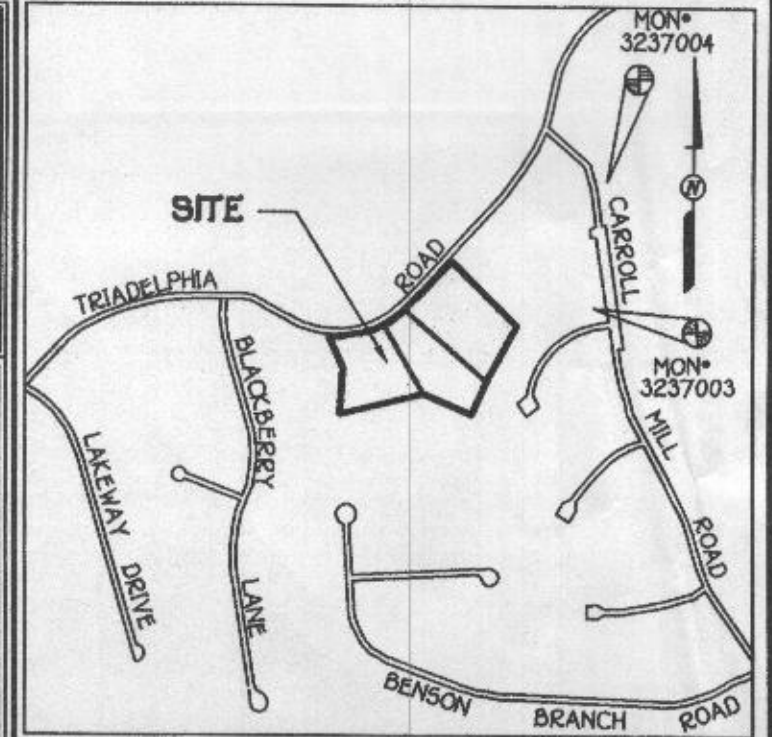

- GENERAL NOTES:** SCALE: 1"=1200'
- THIS AREA DESIGNATES A PRIVATE SEWERAGE EASEMENT OF 10,000 SQUARE FEET AS REQUIRED BY THE MARYLAND STATE DEPARTMENT OF THE ENVIRONMENT FOR INDIVIDUAL SEWAGE DISPOSAL IMPROVEMENTS OF ANY NATURE BY THIS AREA ARE RESTRICTED UNTIL PUBLIC SEWERAGE IS AVAILABLE. THESE EASEMENT SHALL BECOME NULL AND VOID UPON CONNECTION TO A PUBLIC SEWERAGE SYSTEM. THE COUNTY HEALTH OFFICER SHALL HAVE THE AUTHORITY TO GRANT VARIANCES FOR ENCROACHMENTS INTO THE PRIVATE SEWERAGE EASEMENT. RECORDATION OF A MODIFIED EASEMENT SHALL NOT BE NECESSARY.
 - THE LOTS SHOWN HEREON COMPLY WITH THE MINIMUM OWNERSHIP WIDTH AND LOT AREA AS REQUIRED BY THE MARYLAND STATE DEPARTMENT OF THE ENVIRONMENT.
 - PROPERTY IS ZONED "RR-DEO" PER THE COMPREHENSIVE ZONING PLAN DATED OCTOBER 18, 1993.
 - COORDINATES BASED ON NAD '87, MARYLAND COORDINATE SYSTEM AS PROJECTED BY HOWARD COUNTY GEODETIC CONTROL STATIONS No. 3237003 AND No. 3237004.
 STA. No. 3237003 N 526288.368 E 817035.048
 STA. No. 3237004 N 526949.344 E 816924.527
 - THIS PLAT IS BASED ON FIELD RUN MONUMENTED BOUNDARY SURVEY PERFORMED ON OR ABOUT JUNE 22, 1992, BY FISHER, COLLINS AND CARTER, INC.
 - B.R.L. DENOTES BUILDING RESTRICTION LINE.
 - ⊙ DENOTES IRON PIN SET CAPPED "F.C.C. 10692".
 - ⊙ DENOTES IRON PIPE OR IRON BAR FOUND.
 - ⊙ DENOTES ANGULAR CHANGE IN BEARING OF BOUNDARY OR RIGHTS-OF-WAY.
 - ⊙ DENOTES CONCRETE MONUMENT SET WITH ALUMINUM PLATE "F.C.C. 10692".
 - ⊙ DENOTES STONE OR CONCRETE MONUMENT FOUND.
 - FOR FLAG OR PIPE STEM LOTS, REFUSE COLLECTION, SNOW REMOVAL AND ROAD MAINTENANCE TO BE PROVIDED AT THE JUNCTION OF FLAG OR PIPE STEM AND THE ROAD R/W AND NOT ONTO THE FLAG OR PIPE STEM DRIVEWAY.
 - ⊙ DENOTES WETLAND AREAS.
 - [Hatched] DENOTES ELEVATION OF 100 YEAR FLOODPLAIN.
 - COMMON DRIVEWAY FOR LOTS 6, 7, 8 AND 9 SHALL BE PROVIDED PRIOR TO ISSUANCE OF A USE AND OCCUPANCY PERMIT TO ENSURE SAFE ACCESS FOR FIRE AND EMERGENCY VEHICLES PER THE FOLLOWING MINIMUM REQUIREMENTS:
 a) WIDTH - 12 FEET; (1/4 FEET SERVING MORE THAN ONE RESIDENCE)
 b) SURFACE - SIX (6") INCHES OF COMPACTED CRUSHER RUN BASE WITH TAR AND CHIP COATING (1/2" MIN);
 c) GEOMETRY - MAXIMUM 15% GRADE, MAXIMUM 10% GRADE CHANGE AND MINIMUM OF 45-FOOT TURNING RADIUS;
 d) STRUCTURE CLEARANCES - MINIMUM 12 FEET;
 e) MAINTENANCE - SUFFICIENT TO INSURE ALL WEATHER USE;
 f) STRUCTURES (CULVERTS/BRIDGES) - CAPABLE OF SUPPORTING 25 GROSS TONS (125 LOADS);
 g) DRAINAGE ELEMENTS - CAPABLE OF SAFELY PASSING 100 YEAR FLOOD WITH NO MORE THAN 1 FOOT DEPTH OVER DRIVEWAY SURFACE.
 - NO GRADING, CLEARING OR REMOVAL OF VEGETATION IS PERMITTED WITHIN THE WETLAND BUFFER AREAS, EXCEPT AS PERMITTED IN GENERAL NOTE 17 OR WP91-17L.
 - PLAT IS SUBJECT TO WP-91-171 WHICH GRANTED APPROVAL ON JULY 12, 1991 TO WAIVE (1) SECTION 16.119 AND 16.120 REQUIRING SUBMISSION OF SKETCH AND PRELIMINARY PLANS, (2) SECTION 16.116.2.J TO ALLOW GRADING IN THE 100 YEAR FLOODPLAIN FOR THE USE-IN-COMMON DRIVEWAY CONSTRUCTION, (3) SECTION 16.116.6 TO ALLOW GRADING WITHIN THE 25 FOOT WETLANDS AND 75 FOOT STREAM BUFFERS FOR THE CONSTRUCTION OF THE USE-IN-COMMON DRIVEWAY, (4) SECTION 16.115.c.4 TO ALLOW ACCESS ONTO A MAJOR COLLECTOR ROADWAY (TRIADDELPHIA ROAD) FOR THE USE-IN-COMMON DRIVEWAY AND (5) SECTION 16.134 TO WAIVE PUBLIC ROAD IMPROVEMENT ALONG TRIADDELPHIA ROAD WAS NOT APPROVED.
 - PLAT SUBJECT TO PRIOR DEPARTMENT OF PLANNING AND ZONING FILE No. F93-02 AND WP91-17L.

| TOTAL SHEET AREA TABULATION | |
|---|------------|
| TOTAL NUMBER OF BUILDABLE LOTS TO BE RECORDED. | 3 |
| TOTAL NUMBER OF OPEN SPACE LOTS TO BE RECORDED. | 0 |
| TOTAL NUMBER OF LOTS TO BE RECORDED. | 3 |
| TOTAL AREA OF BUILDABLE LOTS TO BE RECORDED. | 14.373 AC. |
| TOTAL AREA OF OPEN SPACE LOTS TO BE RECORDED. | 0.000 AC. |
| TOTAL AREA OF LOTS TO BE RECORDED. | 14.373 AC. |
| TOTAL AREA OF ROADWAY TO BE RECORDED. | 0.000 AC. |
| TOTAL AREA TO BE RECORDED. | 14.373 AC. |

FISHER, COLLINS & CARTER, INC.
 CIVIL ENGINEERING CONSULTANTS & LAND SURVEYORS
 CENTENNIAL SQUARE OFFICE PARK - 10272 BALTIMORE NATIONAL PIKE
 ELLICOTT CITY, MARYLAND 21114
 (410) 461-2955

RESERVATION OF PUBLIC UTILITY AND FOREST CONSERVATION EASEMENTS
 Developer Reserves Unto Itself, Its Successors And Assigns, All Easements Shown On This Plan For Water, Sewer, Storm Drainage, Other Public Utilities And Forest Conservation (Designated As "Forest Conservation Area"). Located In, On, Over, And Through Lots 7 Through 9, Any Conveyances Of The Aforesaid Lots Shall Be Subject To The Easements Herein Reserved, Whether Or Not Expressly Stated In The Deed(s) Conveying Said Lot(s). Developer Shall Execute And Deliver Deeds For The Easements Herein Reserved To Howard County, With A Metes And Bounds Description Of The Forest Conservation Area. Upon Completion Of The Public Utilities And Their Acceptance By Howard County, And, In The Case Of The Forest Conservation Easement(s), Upon Completion Of The Developer's Obligations Under The Forest Conservation Installation And Maintenance Agreement Executed By Developer And The County, And The Release Of Developer's Surety Posted With Said Agreement, The County Shall Accept The Easements And Record The Deed(s) Of Easement In The Land Records Of Howard County."

Denotes Existing Private 30' Access Easement Across Lots 7, 8 And 9 To Be Abandoned.

OWNER AND DEVELOPER
 MR. & MRS. JOHN F. BRINKER
 12275 CARROLL MILL ROAD
 ELLICOTT CITY, MARYLAND 21042

Purpose Note:
 The Purpose Of This Plat Is To Abandon The Existing 30' Private Access Easement Across Lots Nos. 7, 8 And 9 For The Benefit Of Lots Nos. 6, 7, 8 And 9, Recorded On A Plat Entitled, "Woodmark, Section 13, Area 1", Plat Nos. 11085 And 11086, And Create A New Access Easement Across Lots Nos. 7, 8 And 9 For The Benefit Of Lots Nos. 6, 7, 8 And 9.

Approved: For Private Water And Private Sewerage Systems, Howard County Health Department.

Dina M. [Signature] 9/10/99 Date
 Howard County Health Officer

OWNER'S CERTIFICATE
 John F. Brinker And Mary K. Brinker, His Wife, Owners Of The Property Shown And Described Hereon, Hereby Adopt This Plan Of Subdivision, And In Consideration Of The Approval Of This Plat By The Department Of Planning And Zoning Establish The Minimum Building Restriction Lines. All Easements Of Rights-Of-Way Affecting The Property Are Included In The Plan Of Subdivision, Witness My Hand This 30th Day Of August, 1999.

John F. Brinker
Mary K. Brinker

SURVEYOR'S CERTIFICATE
 I Herby Certify That The Final Plat Shown Hereon Is Correct; That It Is A Subdivision Of All Of The Lands Conveyed By Woodmark, Inc. To John F. Brinker And Mary K. Brinker, His Wife, By Deed Dated October 25, 1978 And Recorded In The Land Records Of Howard County, Maryland In Liber No. 910 At Folio 274, And That All Monuments Are In Place Or Will Be In Place Prior To Acceptance Of The Streets In The Subdivision By Howard County, Maryland As Shown, In Accordance With The Annotated Code Of Maryland, As Amended, And Monumentation Is In Accordance With The Howard County Subdivision Regulations.

Terrill A. Fisher 8/20/99 Date
 Terrill A. Fisher, Professional Land Surveyor No. 10692

Recorded As Plat No. 13935 On 9/22/99 Among The Land Records Of Howard County, Maryland.

Approved: Howard County Department Of Planning And Zoning.

John [Signature] 9/20/99 Date
 Chief, Development Engineering Division

[Signature] 9/21/99 Date
 Director

John F. Brinker
Mary K. Brinker

Richard Y. Fisch
Richard Y. Fisch

REVISION PLAT
WOODMARK
 LOTS 7, 8 AND 9
 SECTION 13, AREA 1
 ZONED: RR-DEO
 TAX MAP No. 22 Part Of PARCEL *521 GRID No. 6
 THIRD ELECTION DISTRICT
 HOWARD COUNTY, MARYLAND

Scale: 1" = 100'
 DATE: AUGUST 19, 1999
 SHEET 1 OF 1
 F00-