

APPLICATION

SEWAGE DISPOSAL TESTING

STATE OF MARYLAND - DEPARTMENT OF HEALTH AND MENTAL HYGIENE

HOWARD COUNTY HEALTH DEPARTMENT
ENVIRONMENTAL HEALTH SERVICES

P. O. BOX 476 ELLICOTT CITY, MARYLAND 21043
TELEPHONE: 992-2330

A 32227

P _____

DISTRICT _____

DATE 10/6/82

TO: THE COUNTY HEALTH OFFICER
ELLICOTT CITY, MARYLAND

I, HEREBY, APPLY FOR THE NECESSARY TEST IN ORDER TO CONSTRUCT (OR RECONSTRUCT) A SEWAGE DISPOSAL SYSTEM.

PROPERTY OWNER JOHN F. & Phyllis K. BRINKER
ADDRESS 12275 CARROLL MILL RD. PHONE 988-9513
ELLICOTT CITY, MD.
PROPERTY LOCATION: WOODMARK LOT NO. Lot 4 Resubdivision of LOT 6
ROAD AND DESCRIPTION TRADEPEDIA RD & CARROLL MILL RD.
RESUBDIVISION OF LOT 4
SIZE OF LOT APPROX 5 1/2 AC TYPE BLDG. Homes (4)
(NUMBER OF BEDROOMS)

THE SYSTEM INSTALLED UNDER THIS APPLICATION IS ACCEPTABLE ONLY UNTIL PUBLIC FACILITIES BECOME AVAILABLE. I FULLY UNDERSTAND THE
FEE CONNECTED WITH THE FILING OF THIS PERC TEST APPLICATION IS NON-REFUNDABLE UNDER ANY CIRCUMSTANCES. I ALSO AGREE TO COMPLY
WITH ALL M.O.S.H.A. REQUIREMENTS IN TESTING THIS LOT.

(SIGNATURE OF APPLICANT)

APPROVED BY _____ FOR _____ DATE _____

REJECTED BY _____ FOR _____ DATE _____

HOLD PENDING FURTHER TESTS _____ DATE _____

REASONS FOR REJECTION OR HOLDING 10/21/82 PERC & WATER 100

OK HOLD FOR RECERTIFIED HOLD


PLAT R/H

THIS IS NOT A PERMIT

823.32

SOIL PROFILE

①
BROWN
& PINK
SAND

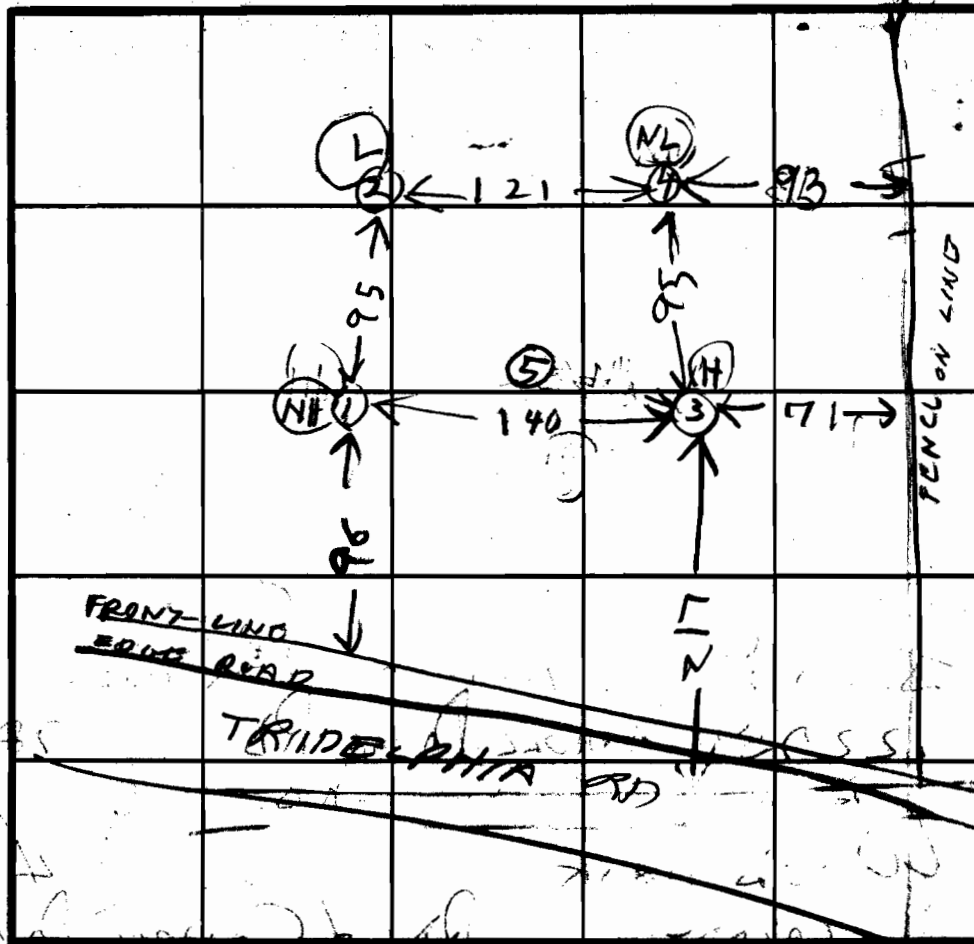

INDICATE NORTH - NAME ADJOINING ROADWAY AS BASE LINE.

SEE
PLAT
FOR
LOCATION
OF HOLES

HOLE
ELEVATION

③ = HIGHEST
① = NEXT
⑤ = HIGHEST
② = LOWEST
④ = NEXT
LOWEST

②
BROWN CLAY
PINK
BROWN
WHITE
SAND

③
REDDISH
BROWN
CLAY
BROWN
SAND

TAN
SAND

⑤
BROWN
CLAY
WHITE
SAND
BROWN
SAND

DATE	TEST NO.	DEPTH	PRE-WET		TEST - 1" DROP		TIME
			START	STOP	START	STOP	
10/14/82	1 S	3 1/2	1148	1148	1148	1252	4
10/14/82	1 D	12	LOOKS	OK	SEE SOIL	PROFILE	
	2 S	3 1/2	1152	1200	1200	1205	
	2 D	13	LOOKS	OK	SEE SOIL	PROFILE	
	3 S	4	1208	1208	1208	1215	8
	3 D	13					
	4 S	3 1/2	1218	1232	1232	LITTLE PERC	
	4 D	13	LOOKS	OK	SEE SOIL	PROFILE	
10/14/82	4 M	4 1/2	126	129	129	137	8
10/14/82	5 V	12	LOOKS	OK	SEE SOIL	PROFILE	

10/14/82 PERC OK EXISTING HOUSE SYSTEM

REMARKS OK BUT COULD NOT RUN WATER TEST

10/21/82 WATER TEST RUN & IS OK RH


TYPE OF SOIL

TESTED BY B Hodges


ALSO PRESENT

EPBAGA
J. BRINKER

EH-12-1079

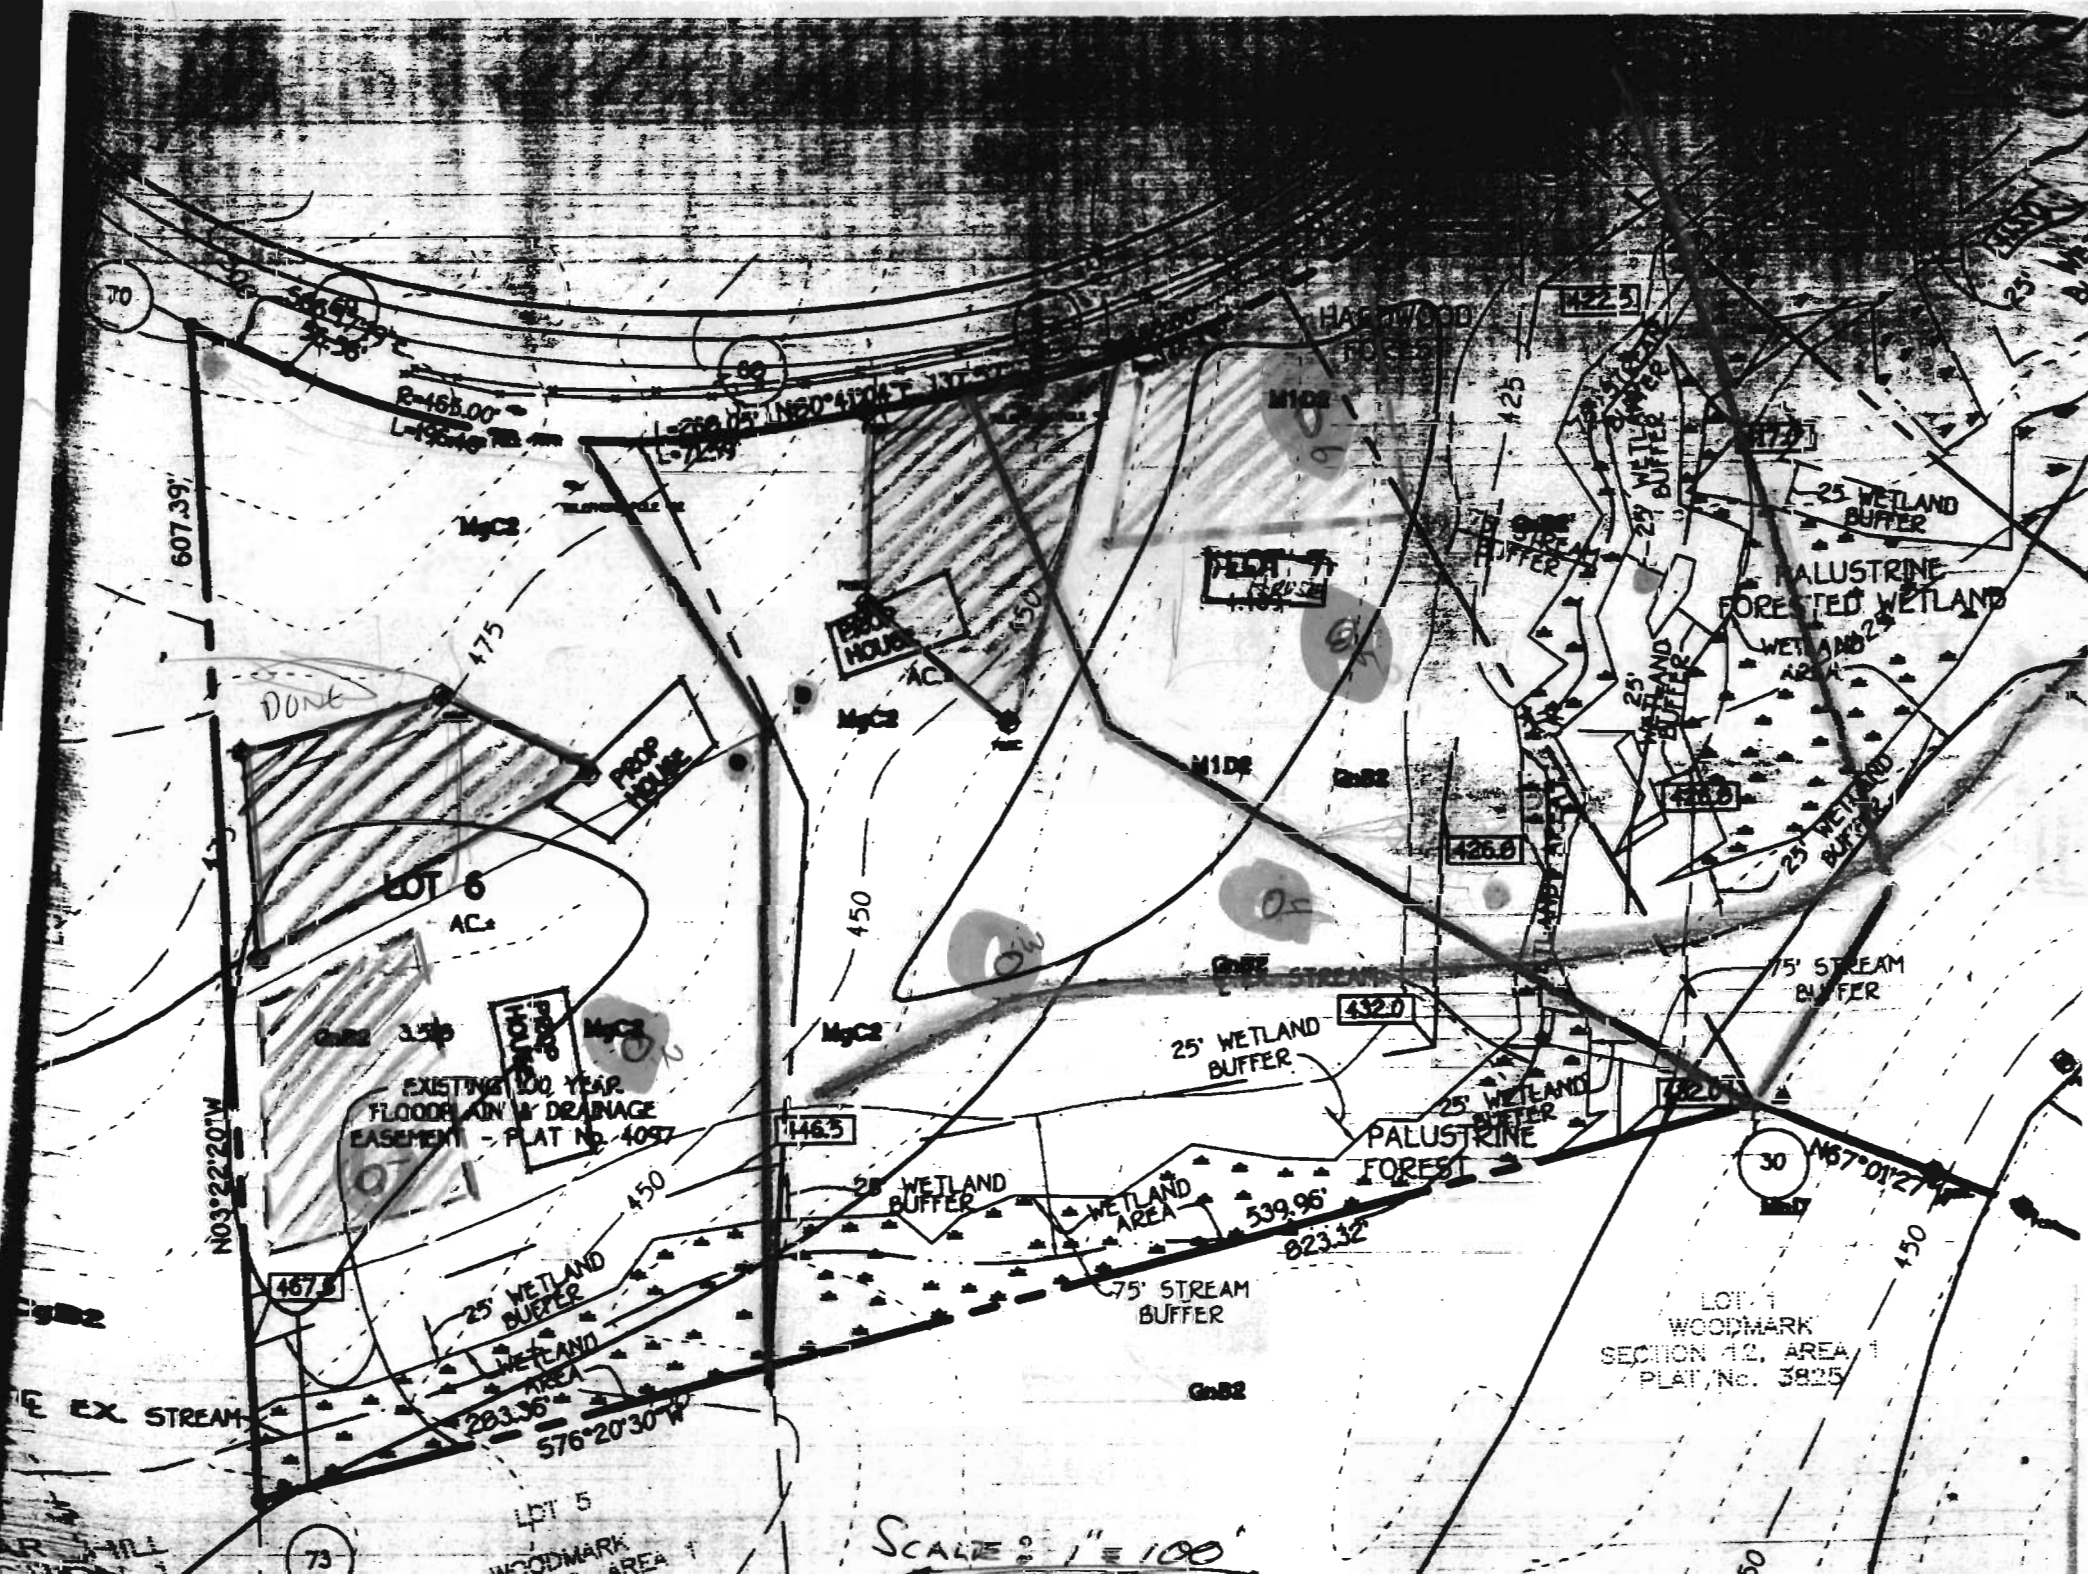

Re-sub of Lot 4

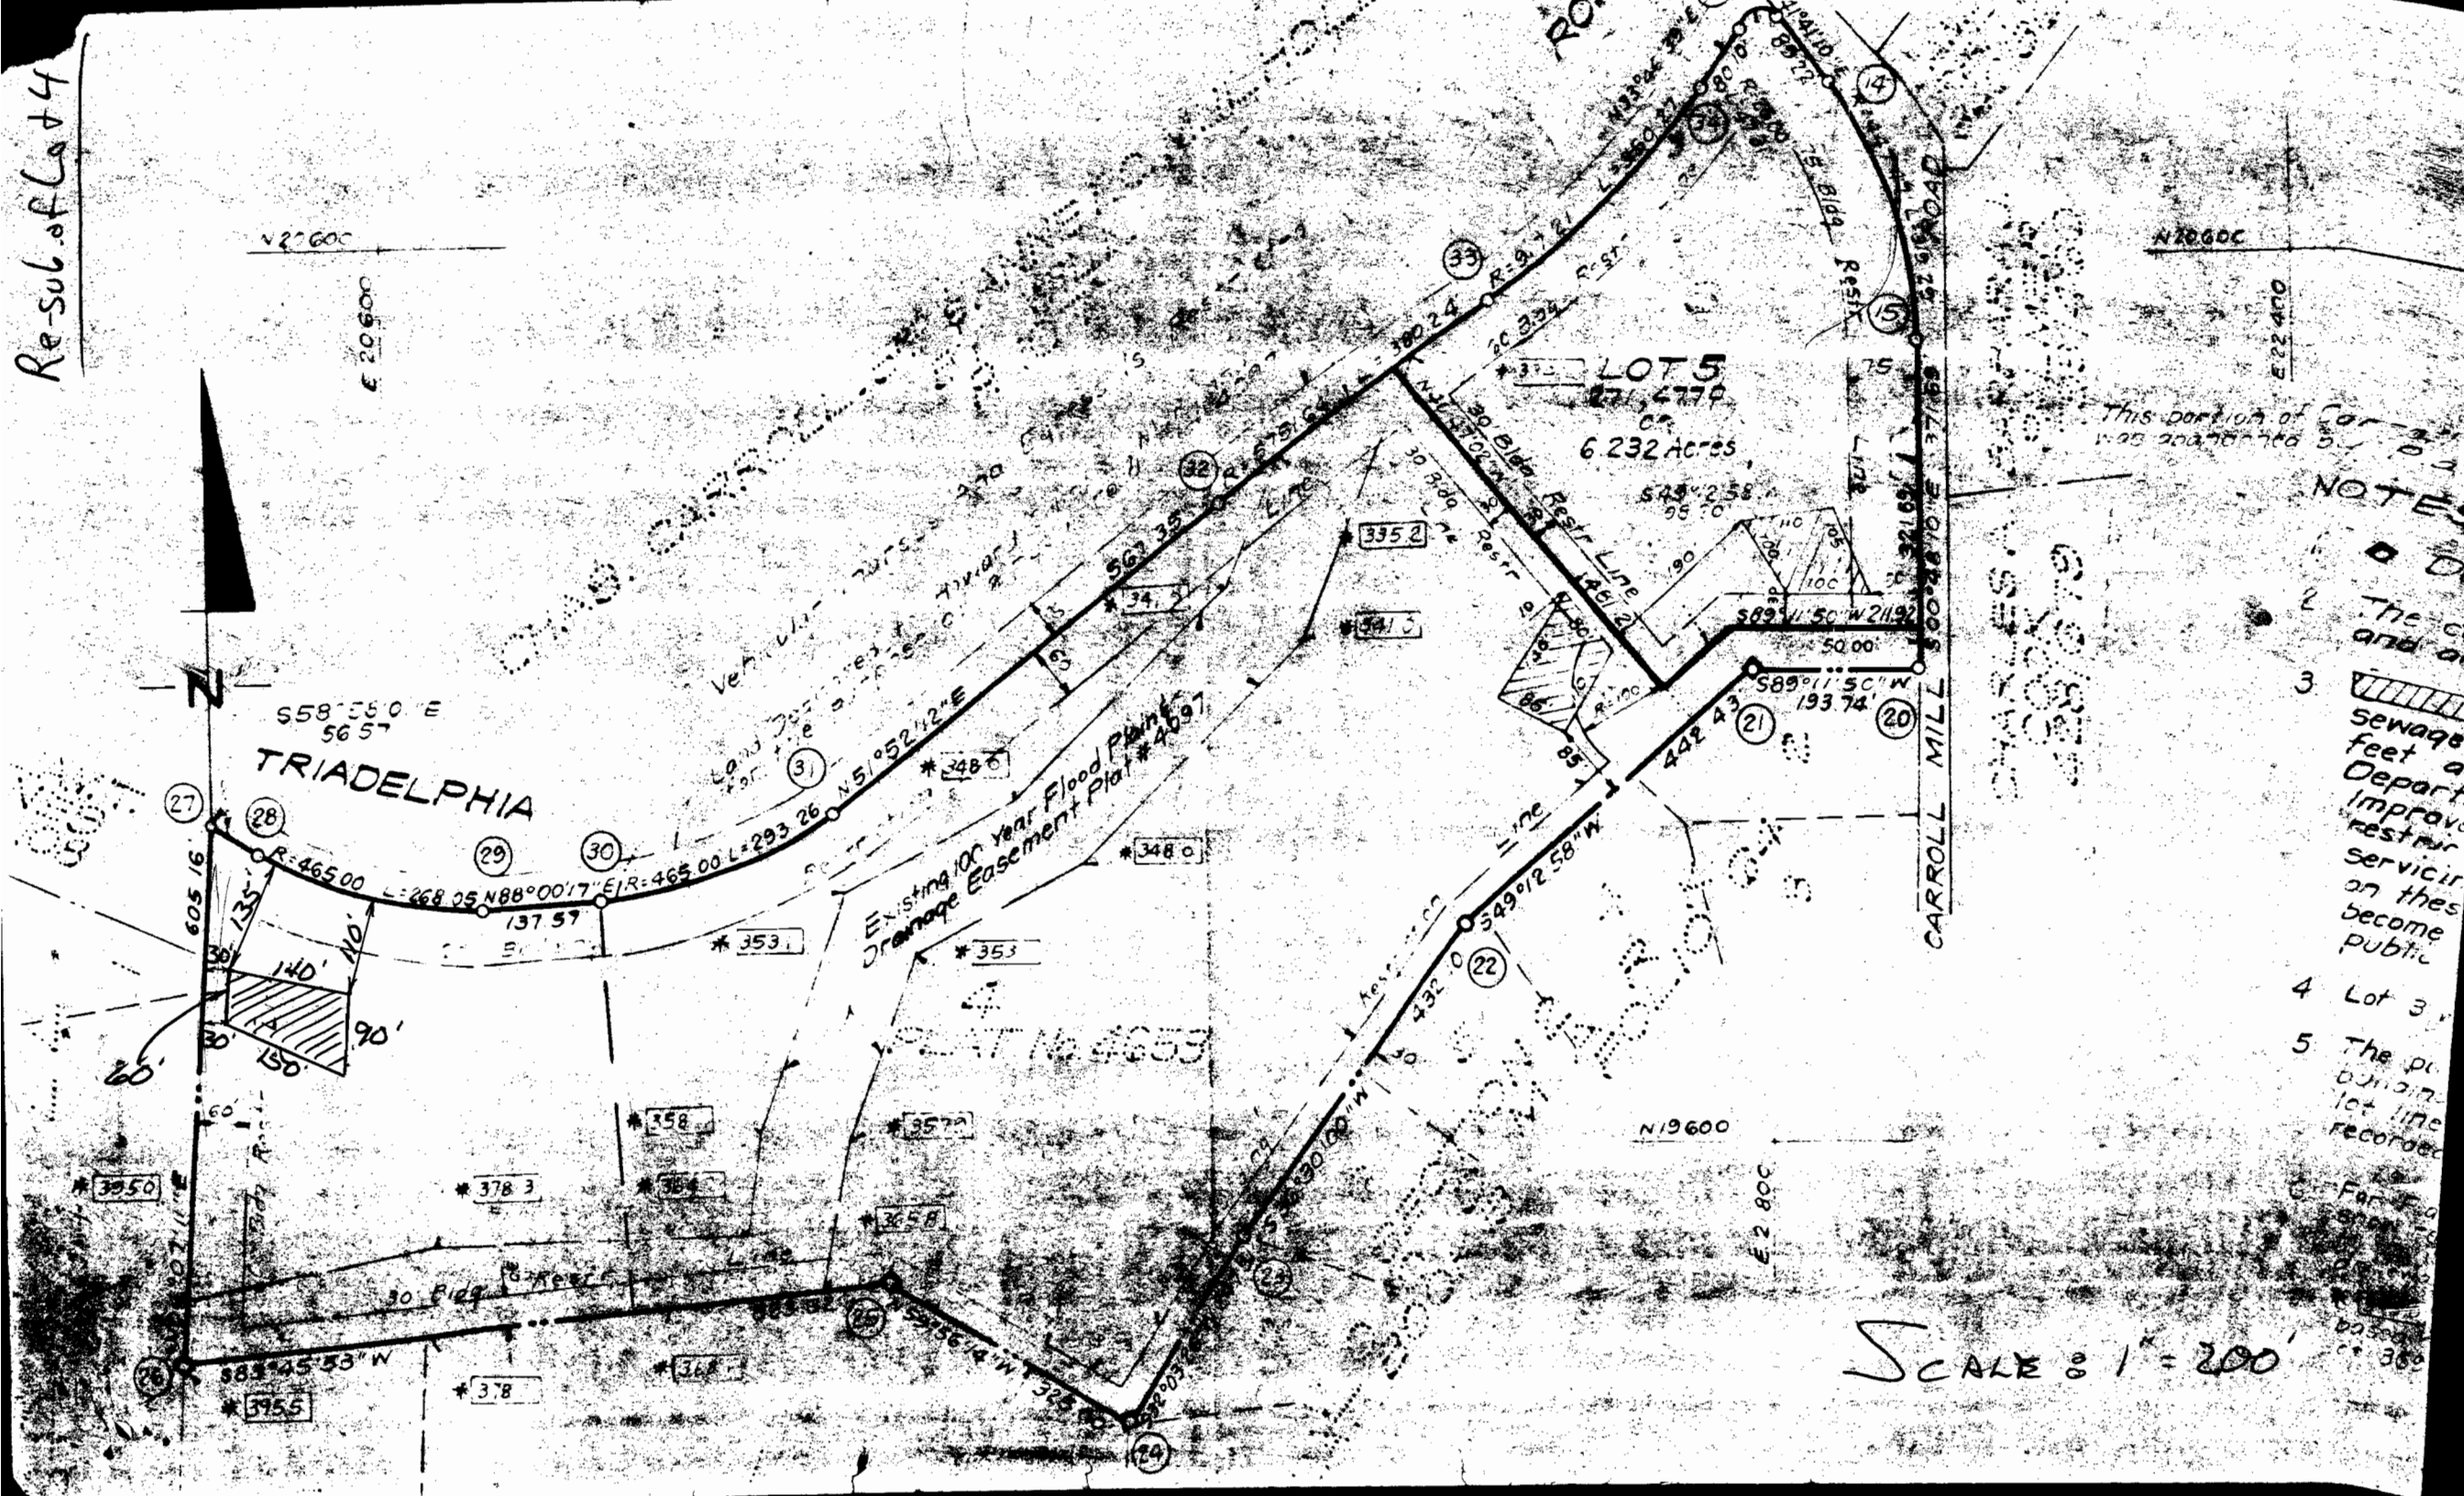


This portion of Carroll Mill Road was abandoned by...

- NOTES
1. The...
 2. The...
 3. The...
 4. Lot 3...
 5. The...

SCALE = 1" = 200'

Re-sub. of Cat 4

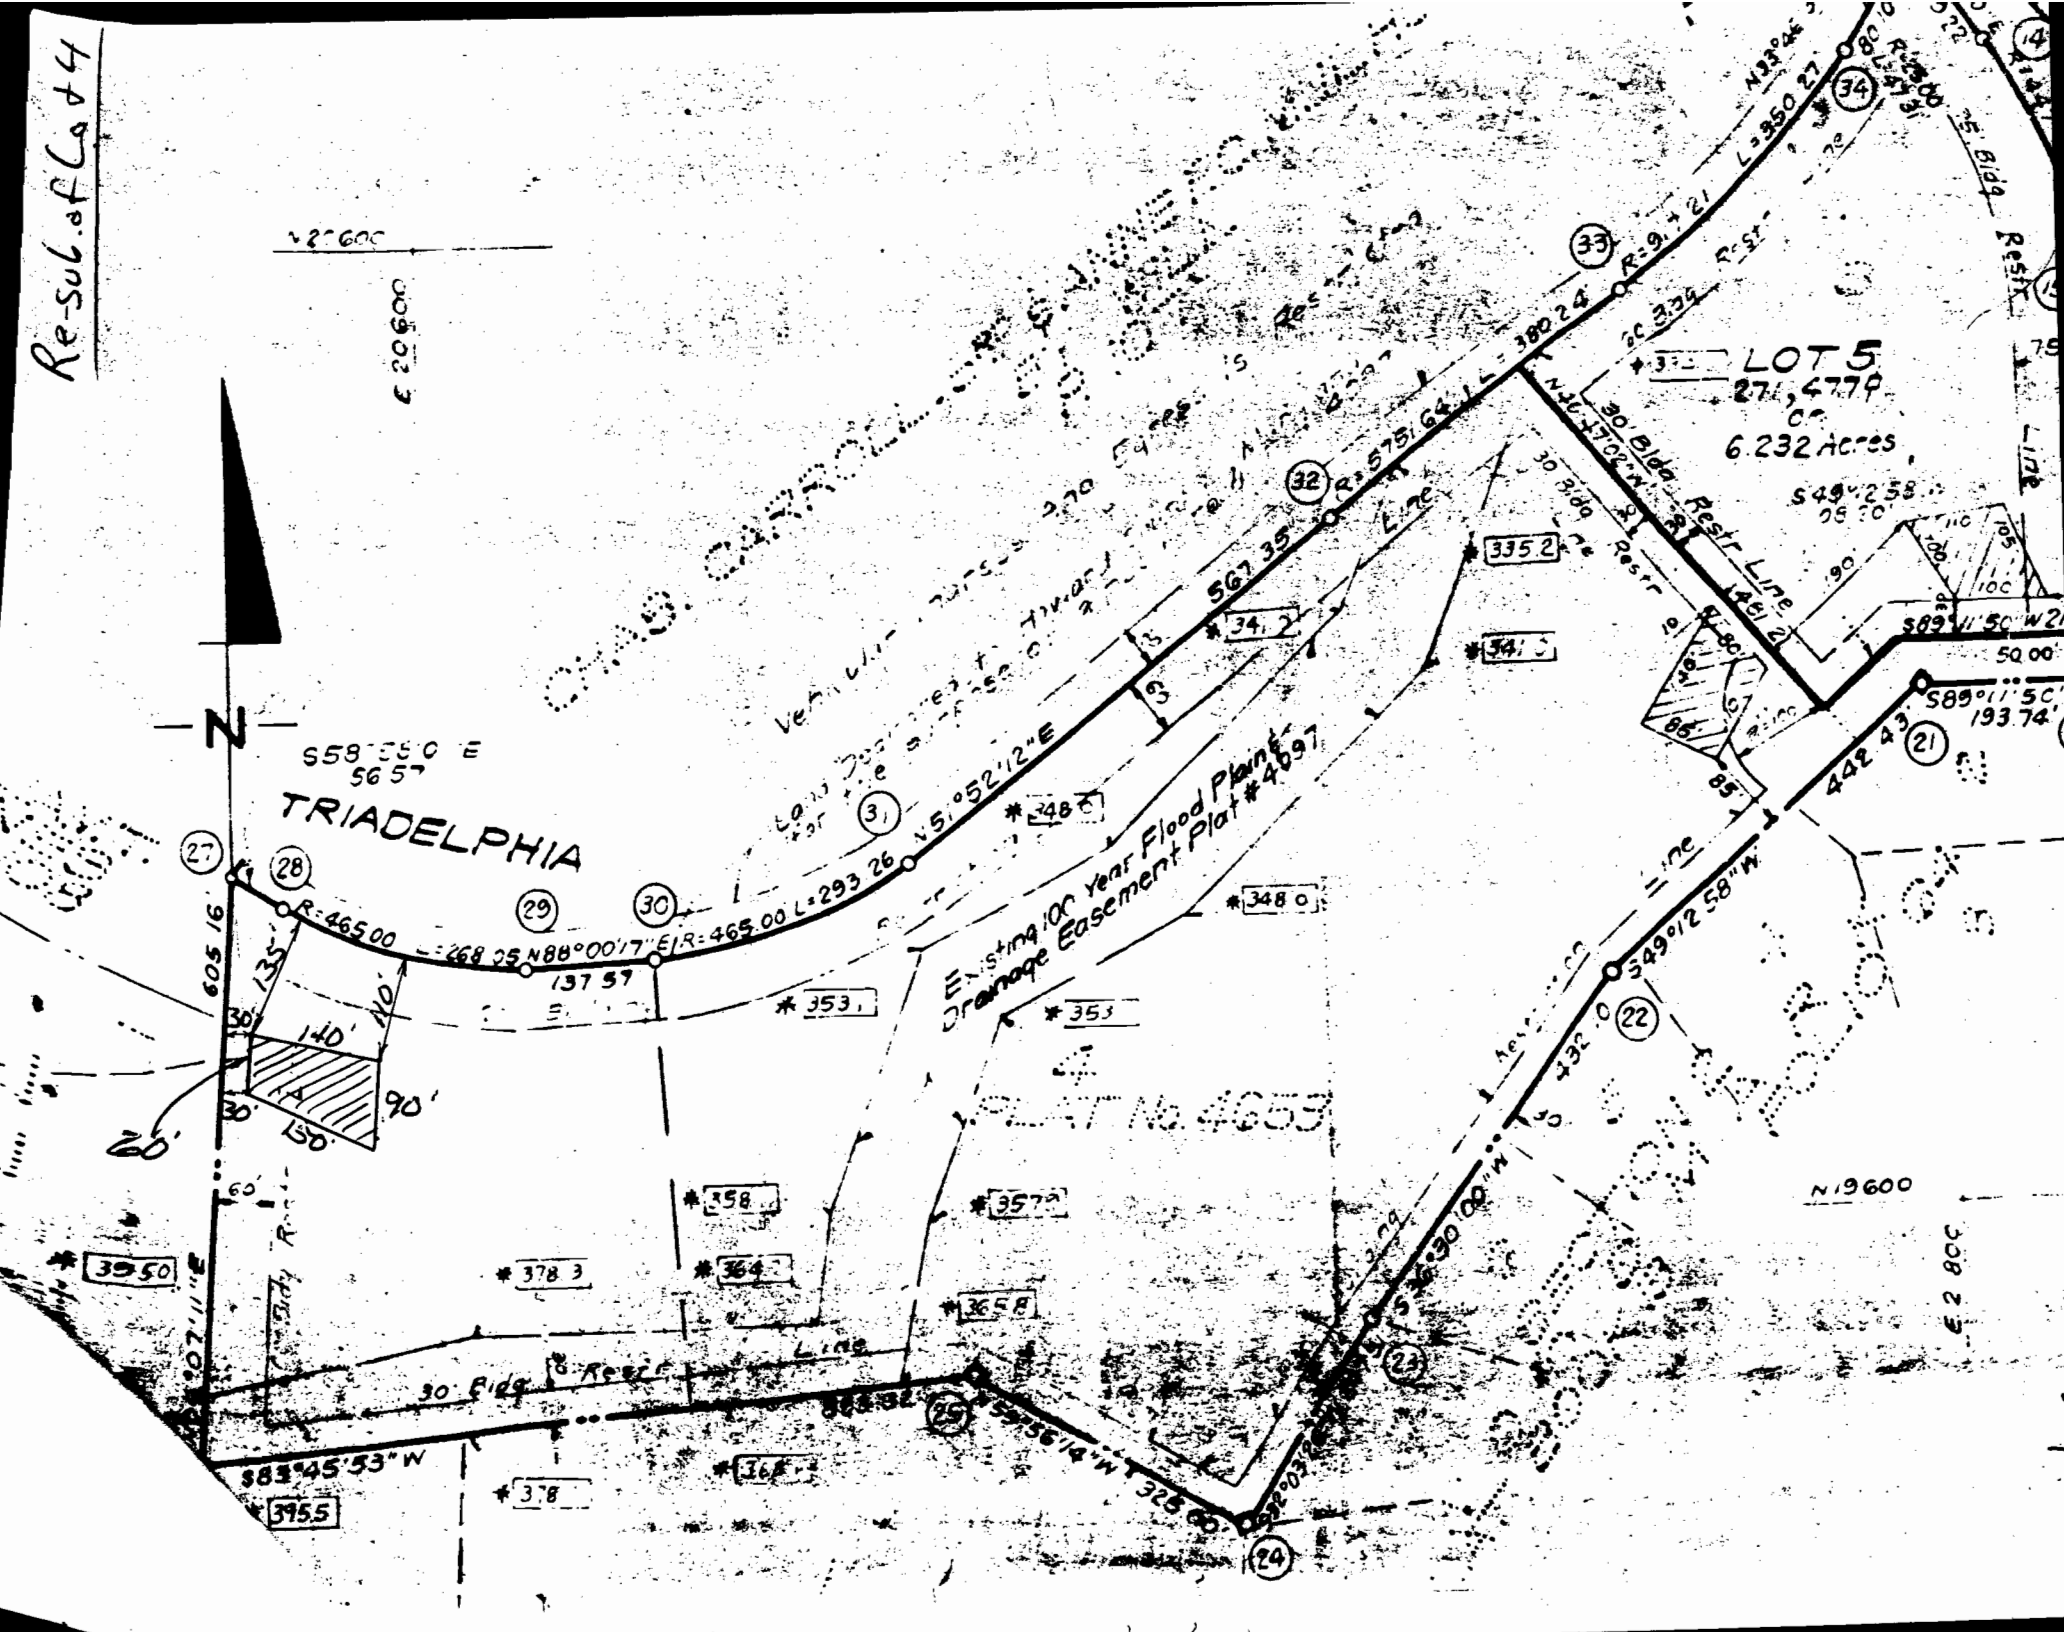

LOT 10 EXISTING HOUSE 12275 CANNON AVE #A27619
SHOW EXISTING SYSTEM (MAY BE ACROSS PROPOSED LOT LINE)
PROPOSE MODIFIED SEPTIC AREA AS TIGHT AS POSSIBLE
TO EXISTING AREA. ON GO FOR RE-PLAN TO
PROVE EXISTING PROPOSAL.

LOT 12 EXISTING HOUSE 12285 CANNON AVE A32288
^{NO CHANGE IN WELL & SEPTIC.}
EXISTING WELL IS IN OFF LOT EASEMENT,
PROPOSAL MAINTAINS THIS ARRANGEMENT
WELL LOCATION IS IN CONFLICT WITH LOT 11
SEPTIC AREA WHICH IS TO BE MODIFIED.

LOT 11 A27618 - PROPOSED BY ISSUED, BUT NOT BUILT.
SEPTIC AREA IN CONFLICT W/ EXISTING WELL
& WELL LINE EASEMENT. MODIFY IS SHOWN.
SEE NOTE ABOUT ^{EXISTING} SEPTIC SYSTEM LOT 10.

LOT 8 A 39496 (OLD LOT C)
SLIDE SEPTIC AREA UPHILL 1 CONTAIN INTERVAL
* NEED CHECK ^{INSTALLER} SEPTIC LOT 1 SECT 12
* L8 BLOCK B SECT 11

LOT 9 A 33323 (OLD LOT 4)
REFINE STEEP SLOPE TO BE 25' FROM SEPTIC
NEED TO KNOW ~~LOT~~ 546 WOODMARK SECT 2
SEPTIC AREAS VERY WELL
BEFORE DETERMINATION OF WELL SITE,
MAINTAIN TESTED SEPTIC CONFIGURATION OR
TEST IN CENTER OF PROPOSED PATTERAN
ADD FAULTS TEST HOLE

2/2

COT 7 A322~~28~~

REFINE AREA AS SHOWN TO FACILITATE
TRENCH INSTALLATION

COT 6 A322~~27~~ — OK AS SHOWN —

ZACH FISCH }
2 BRINKMAN } IN ATTENDANCE

7/21/92

Willis

JOHN BINKER 9/1

RECENTLY
RE-DIVIDED

SEVERAL LOTS

IN WOODMAN 13
SECTION

RECENTLY DRILLED
HO-94-2655

TO SWITCH WITH

THE WELL ON HIS

PERSONALLY OCCUPIED

LOT + OTHER "EXCHANGE" ISSUES.

I DON'T THINK ANYONE CAN

MAKE SENSE OF THIS UNTIL

THE PRESSURE OF A PLAT-TO-SIG

FORCES HIM TO COME IN &
SORT ALL THESE FILES OUT

Howard County Health Department

To: BRINKER PROPERTY
TRIAD RD, PAST CREEK
6 SAND HILLS
LOCATION,
POTENTIALLY 8-18

For PROXIMITY ASSESSMENT
ON POTENTIAL TO
CONVERT TO 4-1 ACRE LOTS,
For JUNE 4 EVALUATION...

From: _____

Date: _____

HD-170

Howard County Health Department

To: FILE

No records for lot 10 or
maybe 11 - No plats
showing ex. lots 6-12
layout available
so unable to determine
if ex houses are on
lots 11 & 12 or 10 & 12.

From: Ann

Date: 10/9/00

HD-170