

APPLICATION

SEWAGE DISPOSAL TESTING

STATE OF MARYLAND - DEPARTMENT OF HEALTH AND MENTAL HYGIENE

HOWARD COUNTY HEALTH DEPARTMENT
ENVIRONMENTAL HEALTH SERVICES

P. O. BOX 476 ELLICOTT CITY, MARYLAND 21043
TELEPHONE: 992-2330

6/10/83
9:30 AM.

DISTRICT

DATE

A 32807

P _____

3rd

5/26/83

TO: THE COUNTY HEALTH OFFICER
ELLICOTT CITY, MARYLAND

I, HEREBY, APPLY FOR THE NECESSARY TEST IN ORDER TO CONSTRUCT (OR RECONSTRUCT) A SEWAGE DISPOSAL SYSTEM.

PROPERTY OWNER ✓ JOEL ABRAMSON (JOHN'S. FITZGERALD) - CONTRACT BUYER

ADDRESS ✓ 13501 TURKEY BRANCH PKWY. ROCKVILLE, MD. 20853 PHONE ✓ 301-587-6955 (W) 301-933-7606 (H)

PROPERTY LOCATION:

SUBDIVISION ✓ TRIDELPHIA FARMS I LOT NO. ✓ 2

ROAD AND DESCRIPTION ✓ PRIVATE DRIVE ACROSS WALT ANN RD

SIZE OF LOT ✓ 5.056 ACRES TYPE BLDG. ✓ SINGLE FAMILY
(NUMBER OF BEDROOMS)

THE SYSTEM INSTALLED UNDER THIS APPLICATION IS ACCEPTABLE ONLY UNTIL PUBLIC FACILITIES BECOME AVAILABLE. I FULLY UNDERSTAND THE FEE CONNECTED WITH THE FILING OF THIS PERC TEST APPLICATION IS NON-REFUNDABLE UNDER ANY CIRCUMSTANCES. I ALSO AGREE TO COMPLY WITH ALL M.O.S.H.A. REQUIREMENTS IN TESTING THIS LOT. X

John S. Fitzgerald
(SIGNATURE OF APPLICANT)


APPROVED BY C. Williams FOR TRENCHES DATE 6-10-83

REJECTED BY _____ FOR _____ DATE _____

HOLD PENDING FURTHER TESTS C. Williams DATE _____

REASONS FOR REJECTION OR HOLDING _____

THIS IS NOT A PERMIT

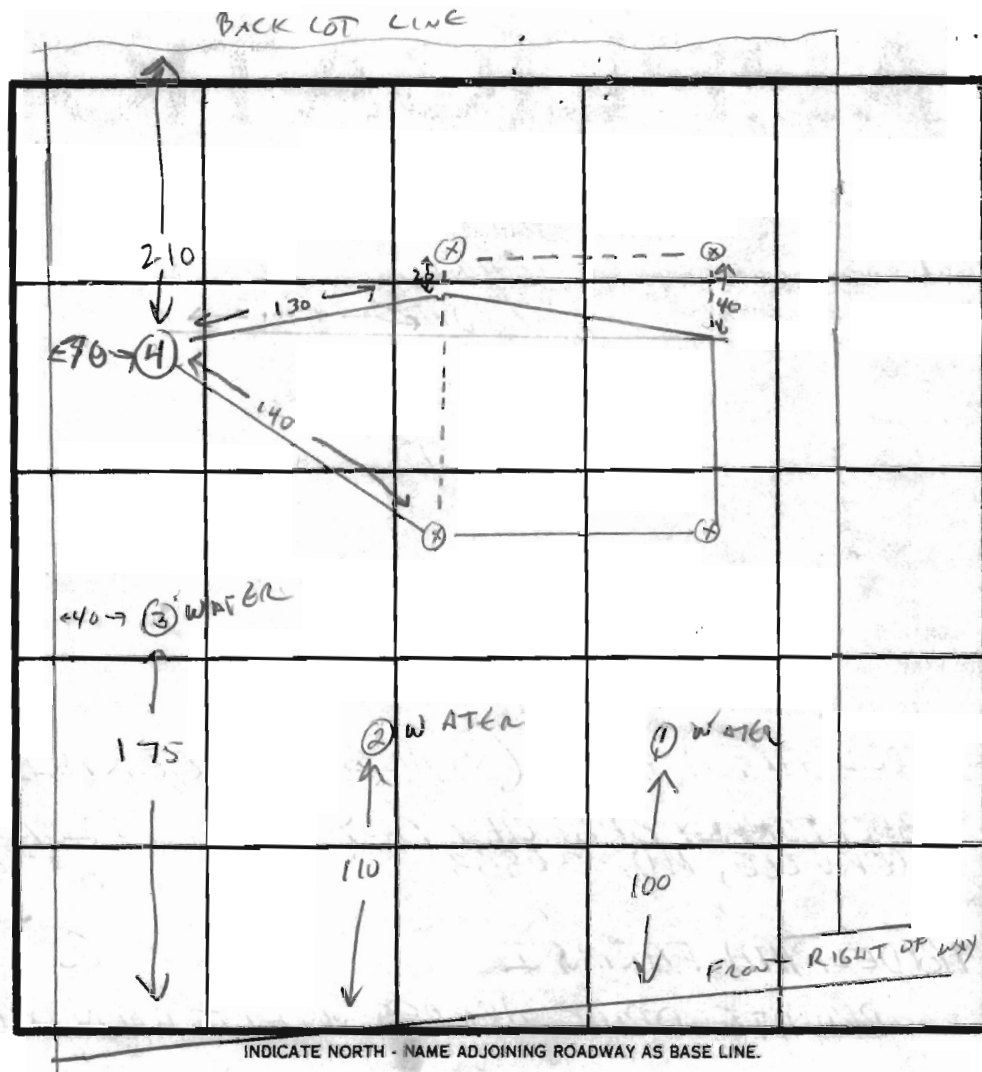

INDICATE NORTH - NAME ADJOINING ROADWAY AS BASE LINE

[illegible]

REMARKS BASEMENT FIXTURES OK IF HOUSE IS SUFFICIENTLY ELEVATED 6-10-83 C

TYPE OF SOIL MICA SAND

TESTED BY C. Wilton

PAT LENDRIM
ALSO PRESENT JOHN FITZGERALD

EH-12-1079