

APPLICATION

A 21549

SEWAGE DISPOSAL TESTING

P _____

STATE OF MARYLAND - DEPARTMENT OF HEALTH AND MENTAL HYGIENE

HOWARD COUNTY HEALTH DEPARTMENT
ENVIRONMENTAL HEALTH SERVICES

DISTRICT 3

P. O. BOX 476, ELLICOTT CITY, MARYLAND 21043
TELEPHONE: 465-5000, EXT. 356

DATE 5/22/75

TO: THE COUNTY HEALTH OFFICER
ELLICOTT CITY, MARYLAND

I, HEREBY, APPLY FOR THE NECESSARY TEST IN ORDER TO CONSTRUCT (OR RECONSTRUCT) A SEWAGE DISPOSAL SYSTEM.

PROPERTY OWNER Lois Maisel

ADDRESS _____ PHONE Any questions call:
Mr. Joel Abramson
730-7733

PROPERTY LOCATION:

SUBDIVISION (Tráadelphia Farms) LOT NO. 2

ROAD AND DESCRIPTION Tráadelphia Road - across from Walt-Ann Drive

SIZE OF LOT 5.056 acres TYPE BLDG. 3 or 4

IF NOT SINGLE RESIDENCE DESCRIBE NUMBER OF BEDROOMS
(Single Fmly. Dwllg.)

THE SYSTEM INSTALLED UNDER THIS APPLICATION IS ACCEPTABLE ONLY UNTIL PUBLIC FACILITIES BECOME AVAILABLE.

SIGNATURE OF APPLICANT /s/ Joel Abramson


APPROVED BY _____ FOR _____ DATE _____
(KIND OF SYSTEM)

REJECTED BY _____ FOR _____ DATE _____
(KIND OF SYSTEM)

HOLD PENDING FURTHER TESTS _____ DATE _____

REASONS FOR REJECTION OR HOLDING _____

THIS IS NOT A PERMIT

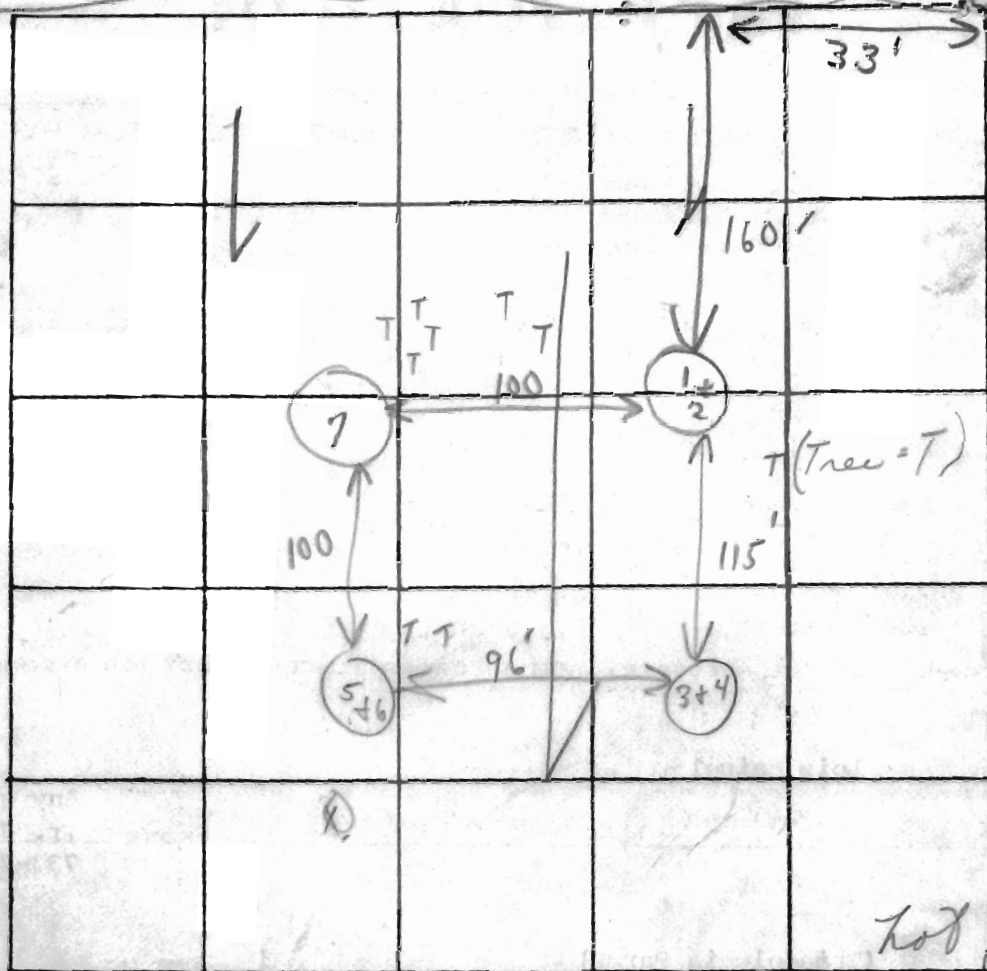

INDICATE NORTH - NAME ADJOINING ROADWAY AS BASE LINE

Unnamed Road

DATE	TEST NO.	DEPTH	PRE-WET		TEST - 1" DROP		TIME
			START	STOP	START	STOP	
5/23/75	1	4'	1:50	1:52	1:52	2:09	15m
	(H) 2	11'	1:49	1:51	1:51	1:59	7m
	3	4'	2:01	2:03	2:03	2:10	7m
	4	11'	2:01	2:03	2:03	2:10	8m
	5	3'	2:24	2:26	2:26	2:27	3m
	6	10 1/2'	2:23	2:25	2:25	2:32	7m
	(H) 7	10 1/2'	Visual sampler to other				6/47 8m

REMARKS

TYPE OF SOIL


TESTED BY

ALSO PRESENT:

Sandy silt below clay

C.B.O.

P. Hendrym
B.F. 10

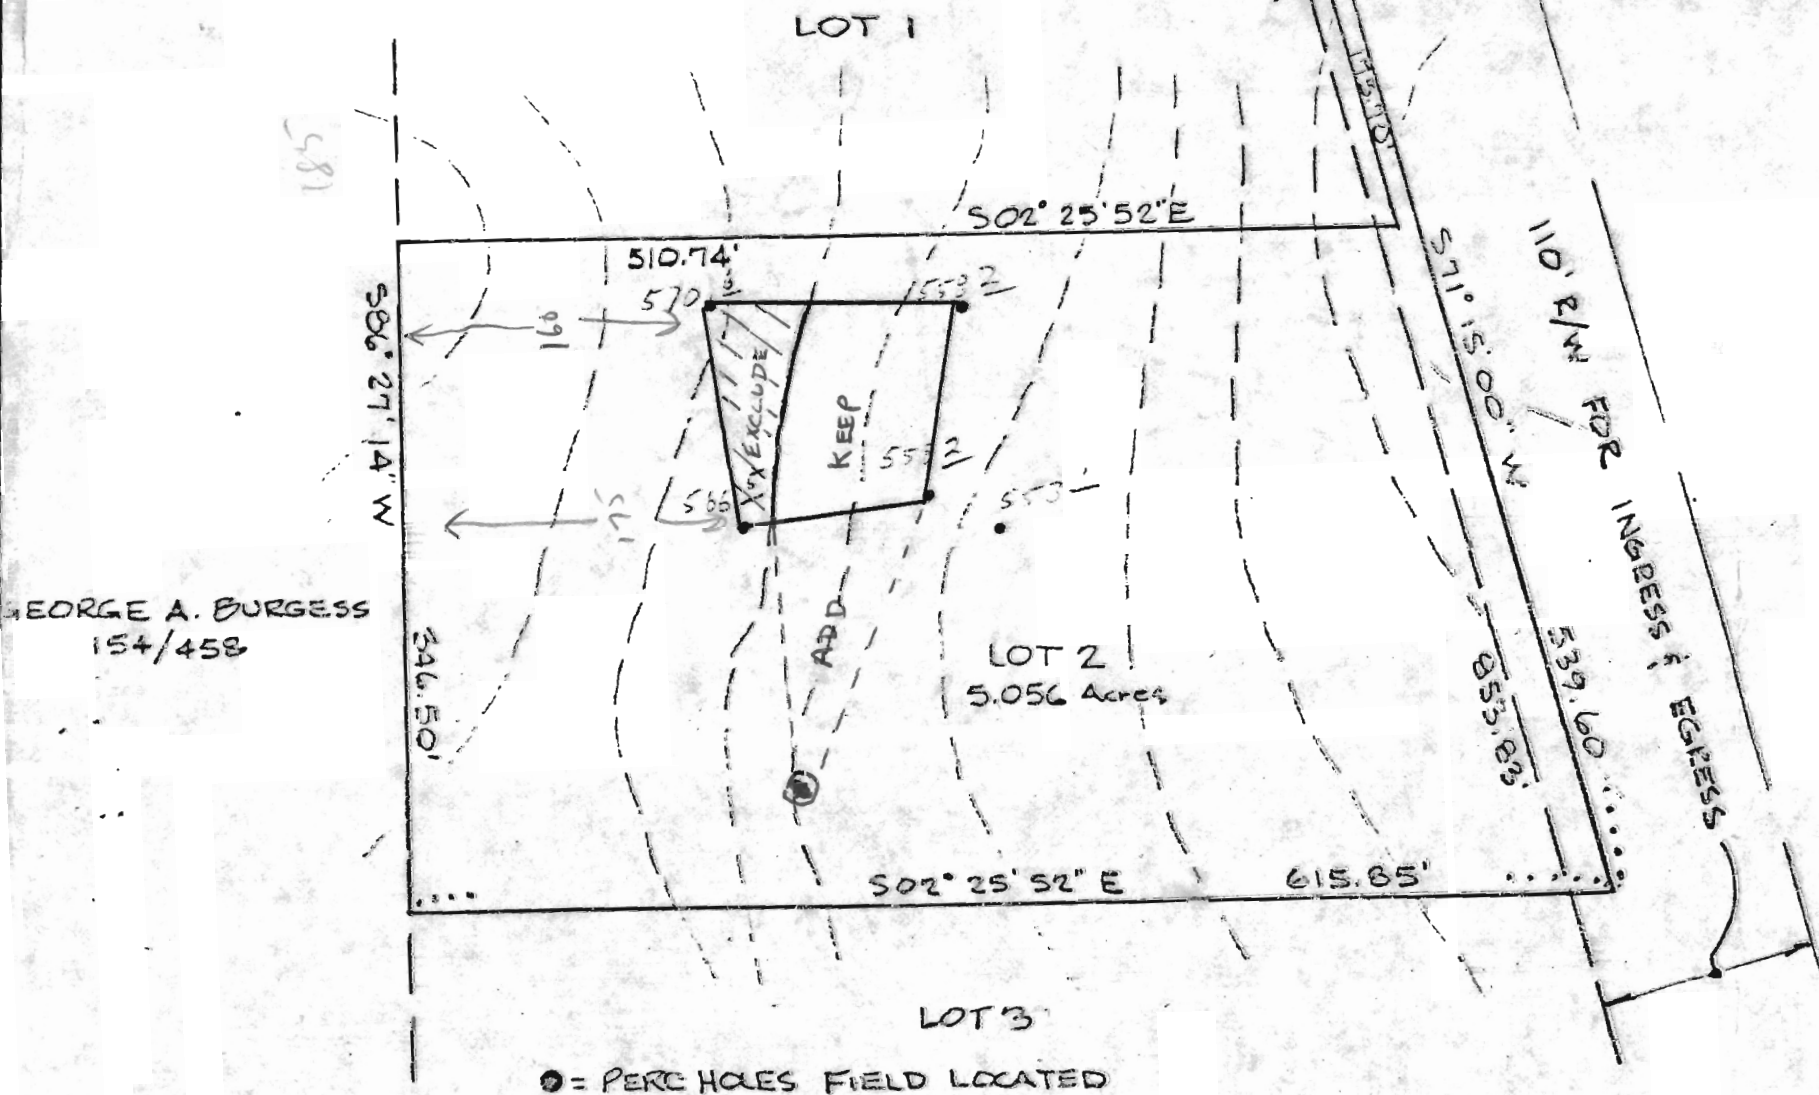

GEORGE A. BURGESS
154/458

REFERENCE

MERIDIAN

MAP OF PROPERTY OF

RICHARD P. BROWNE ASSOCIATES

CONSULTING ENGINEERS, PLANNERS
WAYNE, N.J. COLUMBIA, MD.

SITUATED IN
3rd Election District
Howard County, Md.

SCALE: 1" = 100'



DATE: 6-6-75

No. _____

The lots shown hereon comply with the minimum ownership and lot areas as required by the Maryland State Health Department.


APPROVED: Private Water & Private Sewer
[Signature] 6/19/75
 Howard County Health Officer

GEORGE A. BURGESS
 154/458

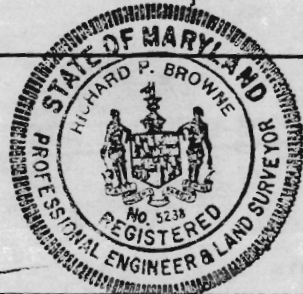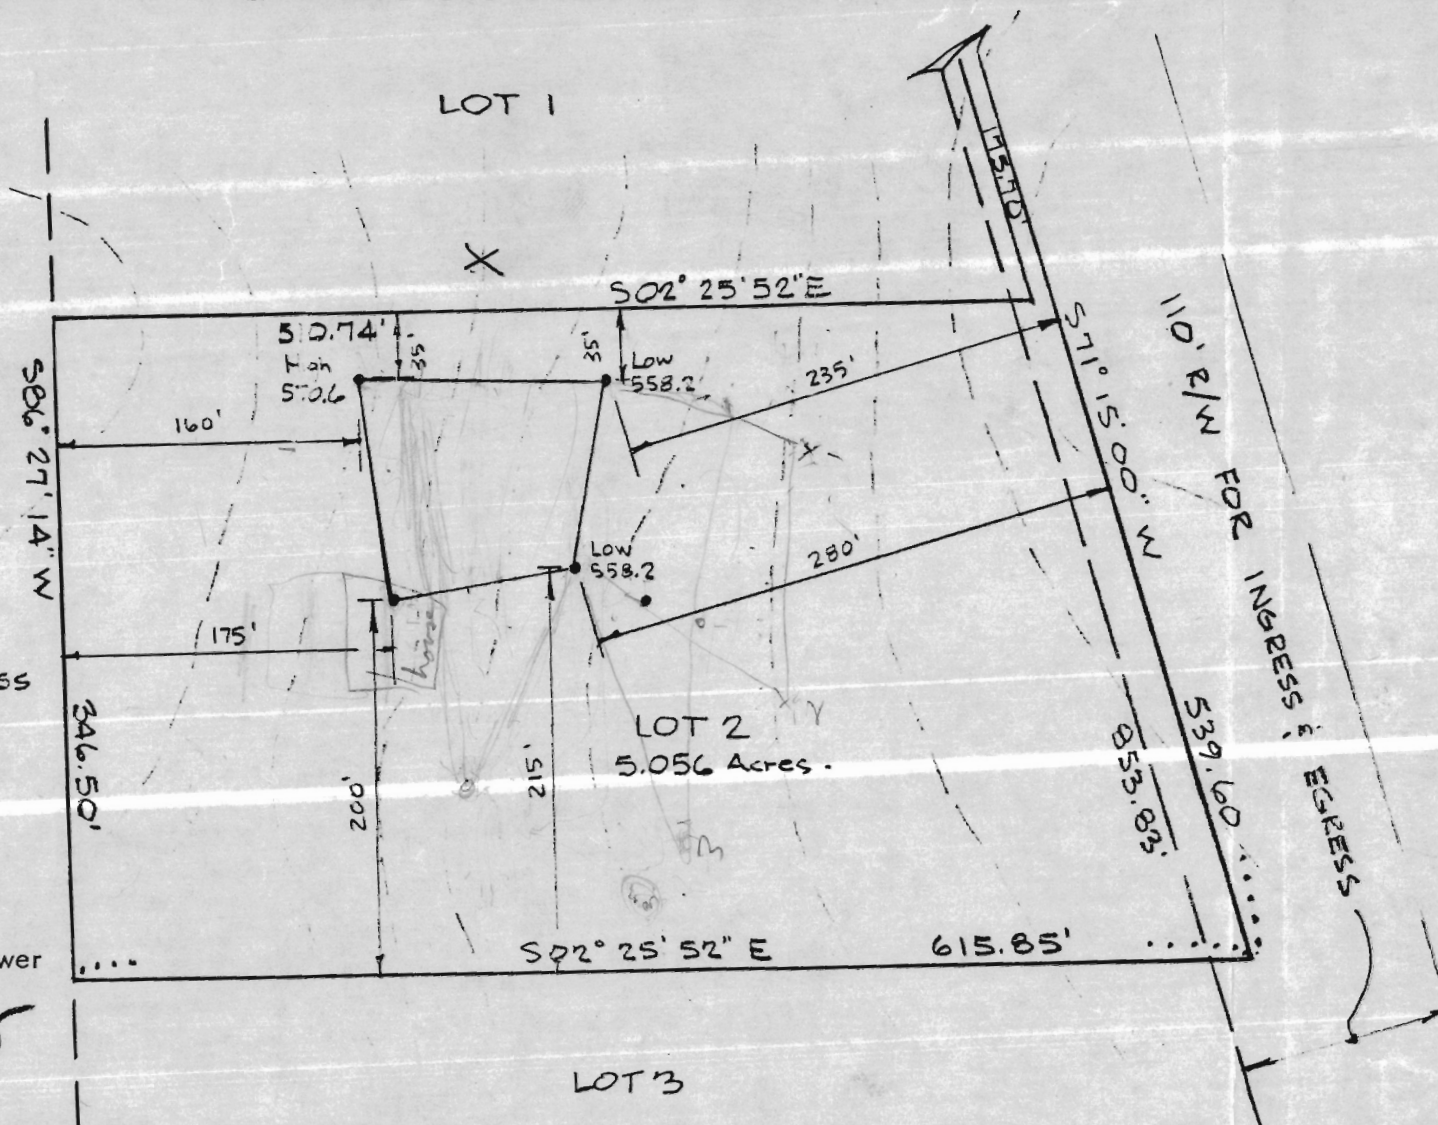

REFERENCE

MERIDIAN

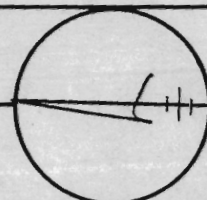

RICHARD P. BROWNE ASSOCIATES
 CONSULTING ENGINEERS, PLANNERS
 WAYNE, N.J. COLUMBIA, MD.

MAP OF PROPERTY OF
 Stephanie Abramson & Lois Maisel

SITUATED IN
 3rd Election District
 Howard County, Md.

SCALE: 1" = 100'

DATE: 6-6-75

BRUNING 40-105 11334

PROJECT No. W. O. No.

GEORGE A. BURGESS
154/458

586° 27' 14" W

346.50'

LOT 1

S 02° 25' 52" E

510.74'
570.0'

553.2

566.5

553.2

553.1

LOT 2
5.056 Acres

S 02° 25' 52" E

615.85'


LOT 3

● = PERC HOLES FIELD LOCATED

175.10'
S 71° 15' 00" W
110' R/W FOR INGRESS & EGRESS
539.60'
853.83'
.....

REFERENCE

MERIDIAN

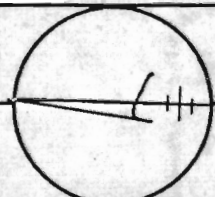

RICHARD P. BROWNE ASSOCIATES
CONSULTING ENGINEERS, PLANNERS
WAYNE, N.J. COLUMBIA, MD.

MAP OF PROPERTY OF

SITUATED IN
3rd Election District
Howard County, Md.

SCALE: 1" = 100'

DATE: 6-6-75

DRAWN _____ CHECKED _____

PROJECT No. _____ W. O. No. _____

No. _____

BRUNING 40-105 11334