

OK TO EXCLUDE




CROSSED AREA
FROM DISPOSAL FIELD,
10,000 FT OF USABLE AREA
STILL REMAINS.
6-13-83 *William*

EDRGE A. BURGESS
154/458

M. 21, L2, 985

05.752 SUGGESTED
WELL SITES

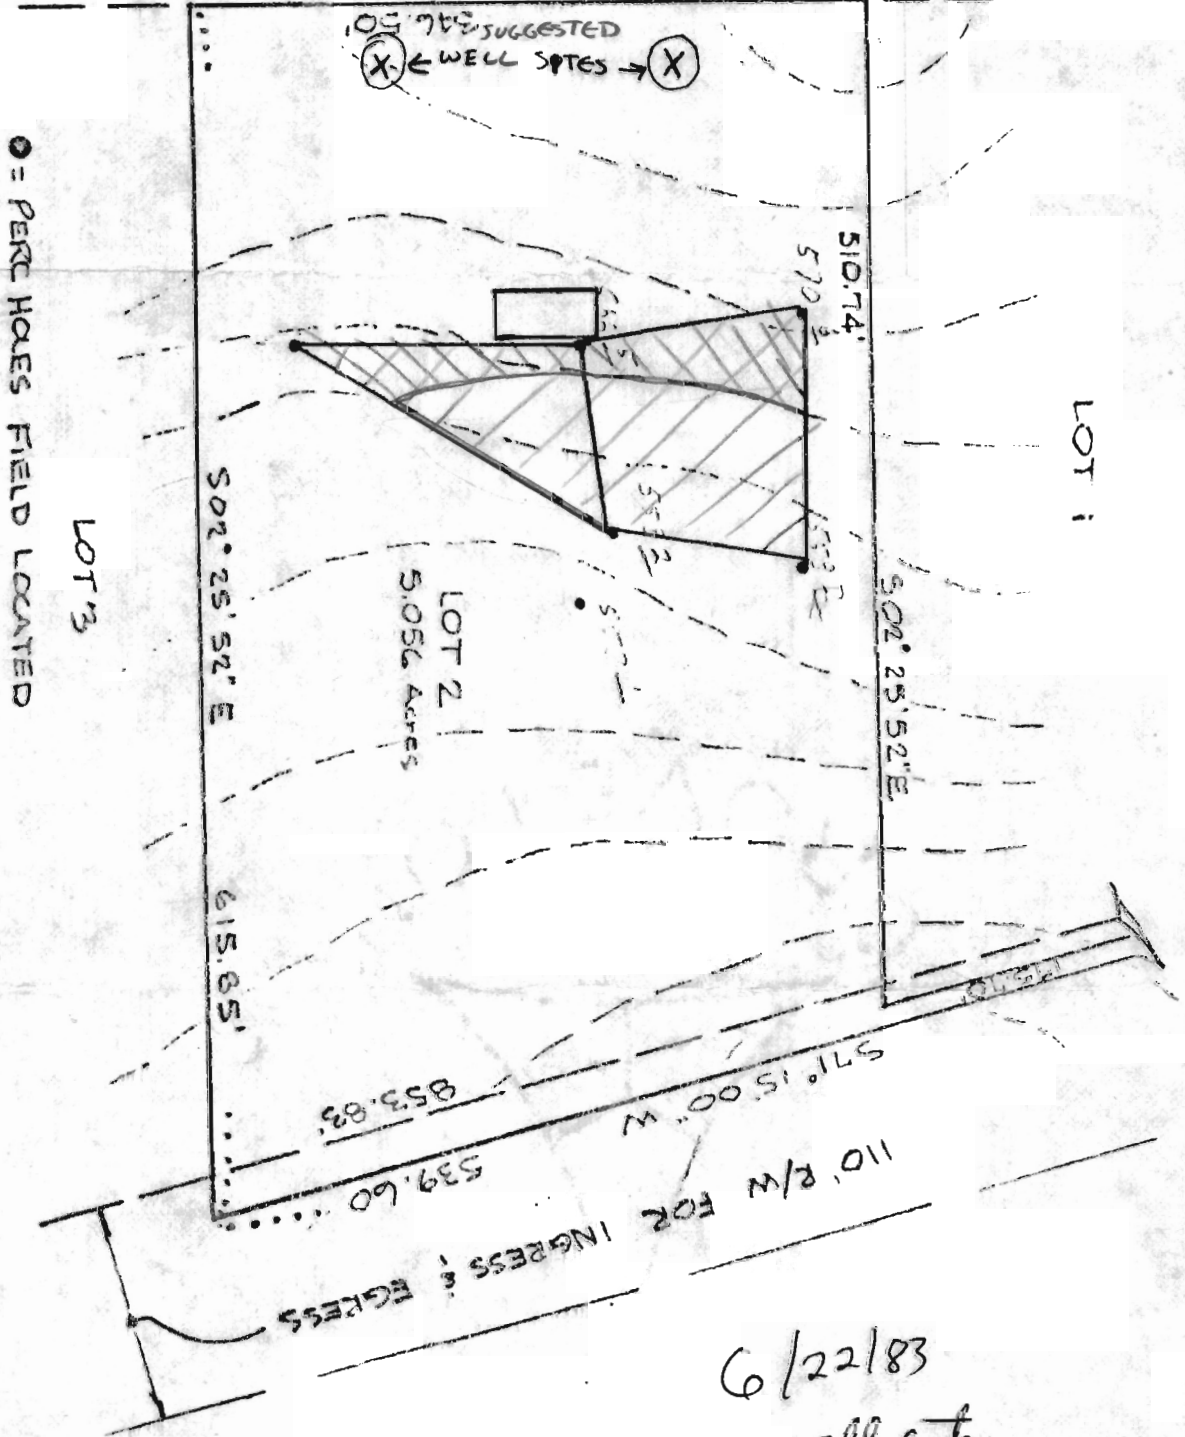

LOT 1

LOT 3

LOT 2
5.056 Acres

● = PERC HOLES FIELD LOCATED

REFERENCE

MERIDIAN



MAP OF PROPERTY OF
TRIDELPHIA FARMS I
Lot 2

SITUATED IN
3rd Election District
Howard County, Md.

RICHARD P. BROWNE ASSOCIATES
CONSULTING ENGINEERS, PLANNERS
BETHESDA, MD.

John S. Fitzgerald 6/13/83

NO

SCALE: 1"=100'

DATE: 6-6-75

6/22/83

well sites

OK
T.S.