

B15003127 Signed-off
3/4/16 -
H.O.

Menu Save Reset Cancel ? Help

Record Detail * (This section is required.)

Permit Type Building/Residential/Alteration/SFD Permit Number B15003127 Opened Date 07/22/2015

Description of Work
SFD/ FINISH BASEMENT TO INCLUDE: UNFINISHED STORAGE AREA, LIVING AREA, 2 STORAGE CLOSETS, WORK AREA, BATHROOM, BEDROOM/OFFICE, APPROXIMATELY 858 SQ FT // *02.09.16 REVISED FLOOR PLAN TO CHANGE LIVING AREA TO FINISHED GYM AND REMOVE BATHROOM AND BEDROOM/OFFICE*

check spelling

Address * (This section is required.)

Search Reset Clear Get Parcel & Owner

Street # 757 Street Name WEST WATERSVILLE Street Type RD
Unit Type --Select-- Unit # X Coordinate -77.12139 Y Coordinate 39.35527
City MOUNT AIRY State MD Zip Code 21771 Primary Yes

Parcel * (This section is required.)

Search Reset Clear Get Address & Owner

GIS ID * 830290 Parcel 109 Parcel Area 42122 Land Value 192700 Improved Value 331100 Exemption Value 138400

Legal Description
IMPSLOT 5[]757 W WATERSVILLE RD[]NURSESY VIEW

check spelling

Block Plan Area Section Grid SDP No. Record Plat No. Owner Occupied Historic District Registry No. Building No

Lot 5 Census Tract 604001 Council Dist 5 Supervisor Dist Map # DAP Zone Primary Yes
State Tax Id 1404309758 Subdivision Name
Area Tax Map 2
Zoning District ADC Map 4691-A4
Final Plan No. WP File No.
WS Contract No. FDP No.
Year Built Stat Area 4-01 Historic District Flood Plain
Year Built Historic District Flood Plain

Owner (This section is not required.)

Search Reset Clear

Name *
MICHAEL A LARKIN


DATE: 6/30/16
DESC. OF WORK: Carport

APP SAN
BR# mg
WALKTHRU BUILDING PERMIT

APPROVED


015663127

1
YD PROPERTY
209
R-20

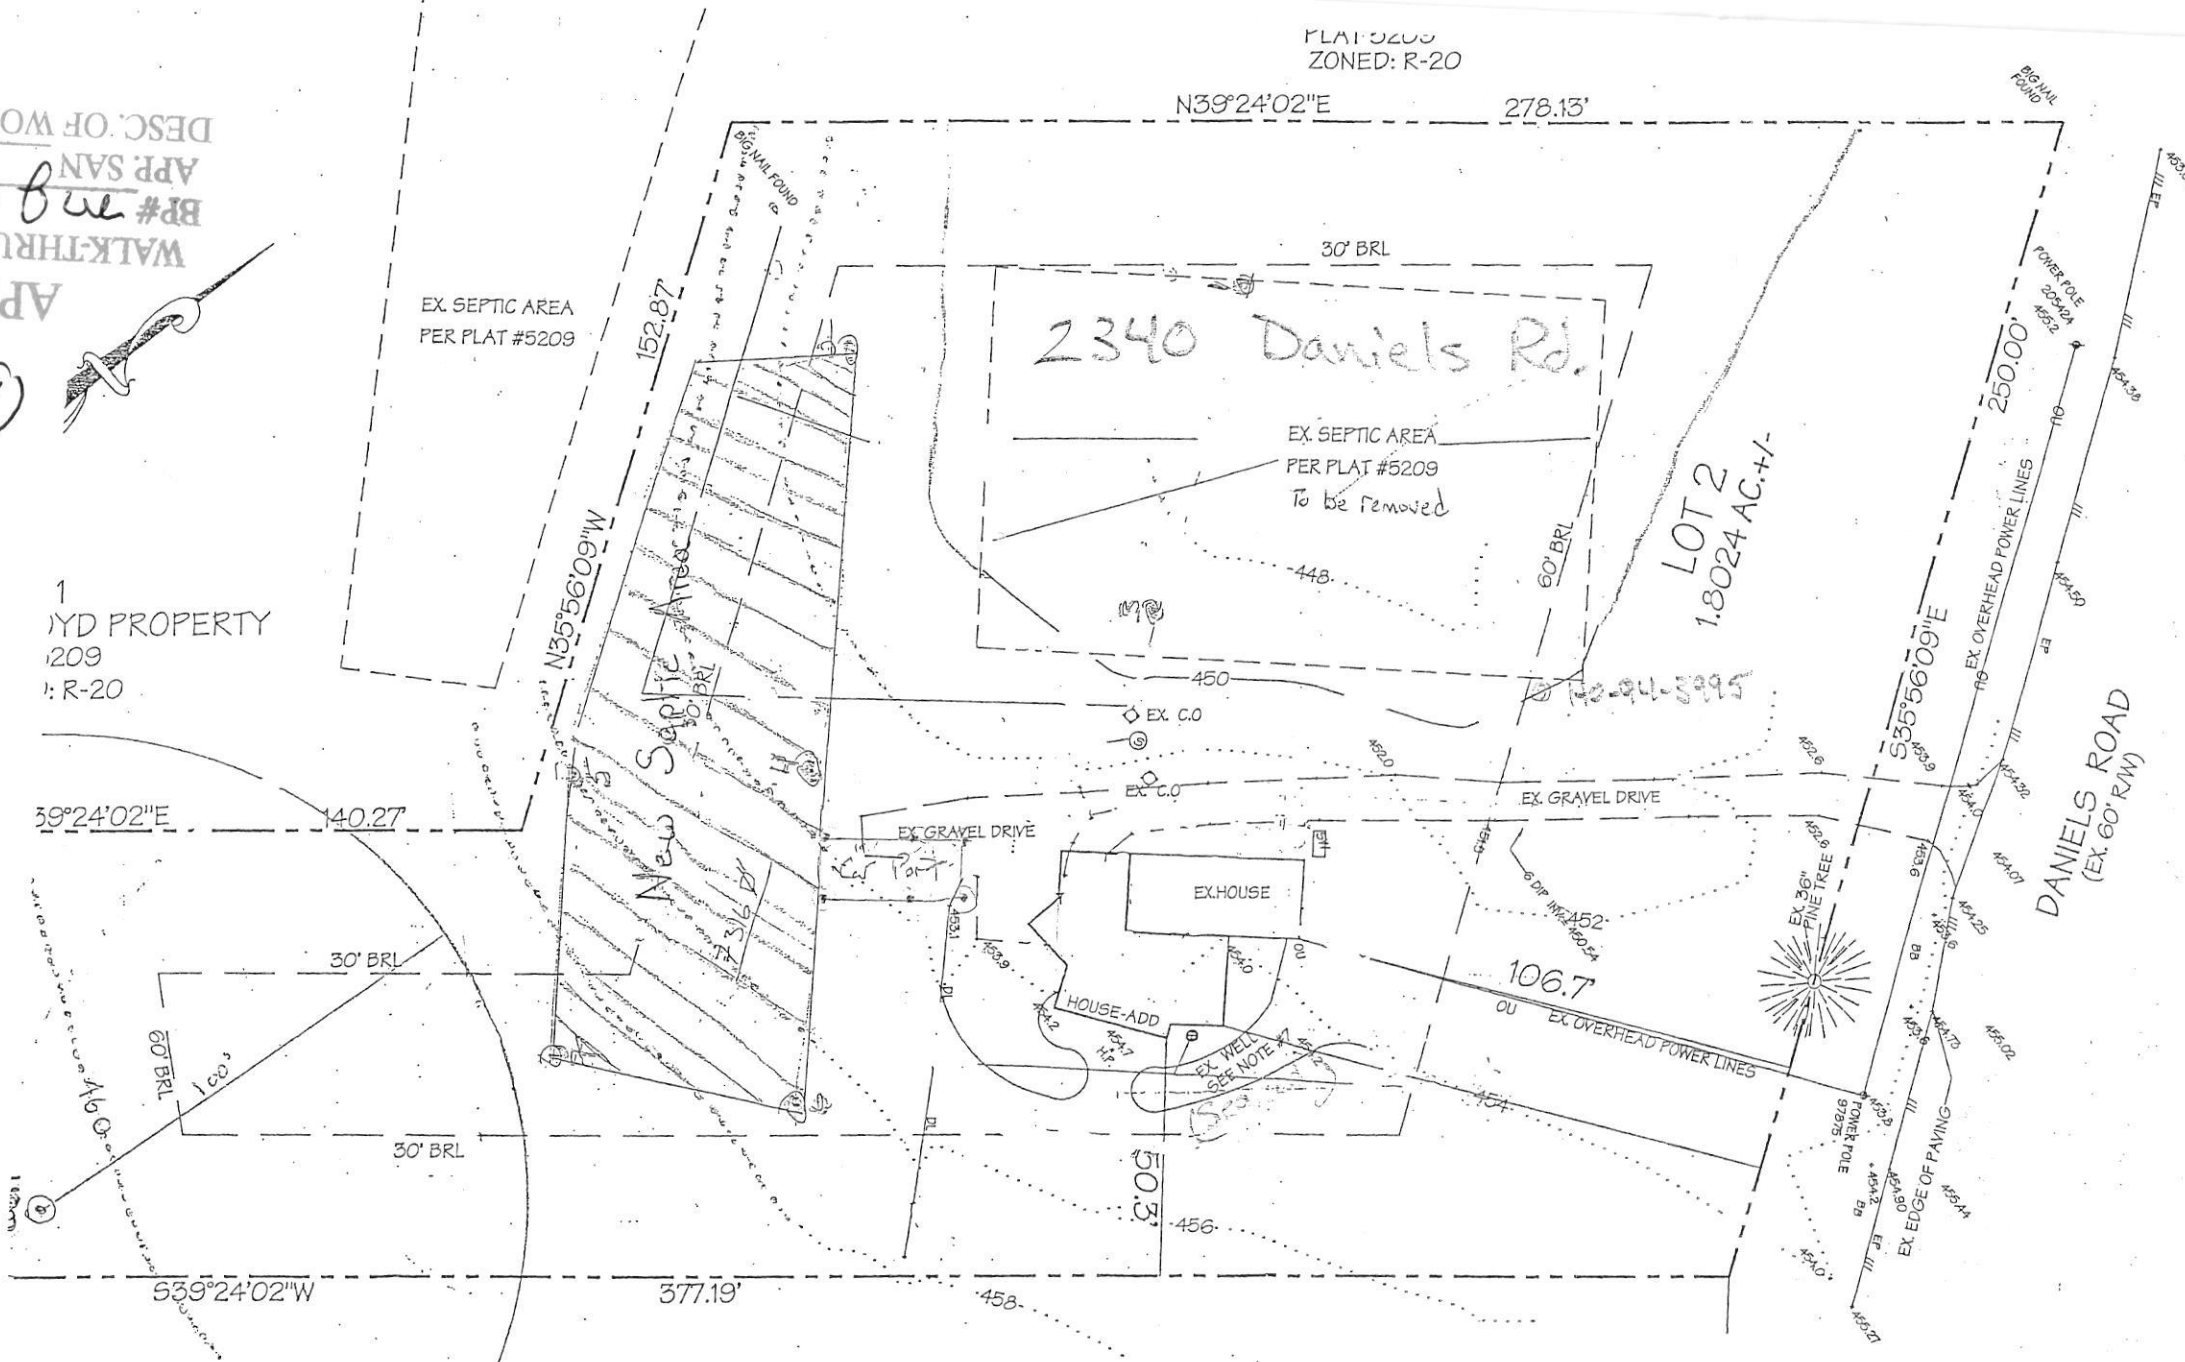

C.T. WEBB
L. 234 F. 77
ZONED: R-20
2370 Daniels

Scale: 1" = 40'

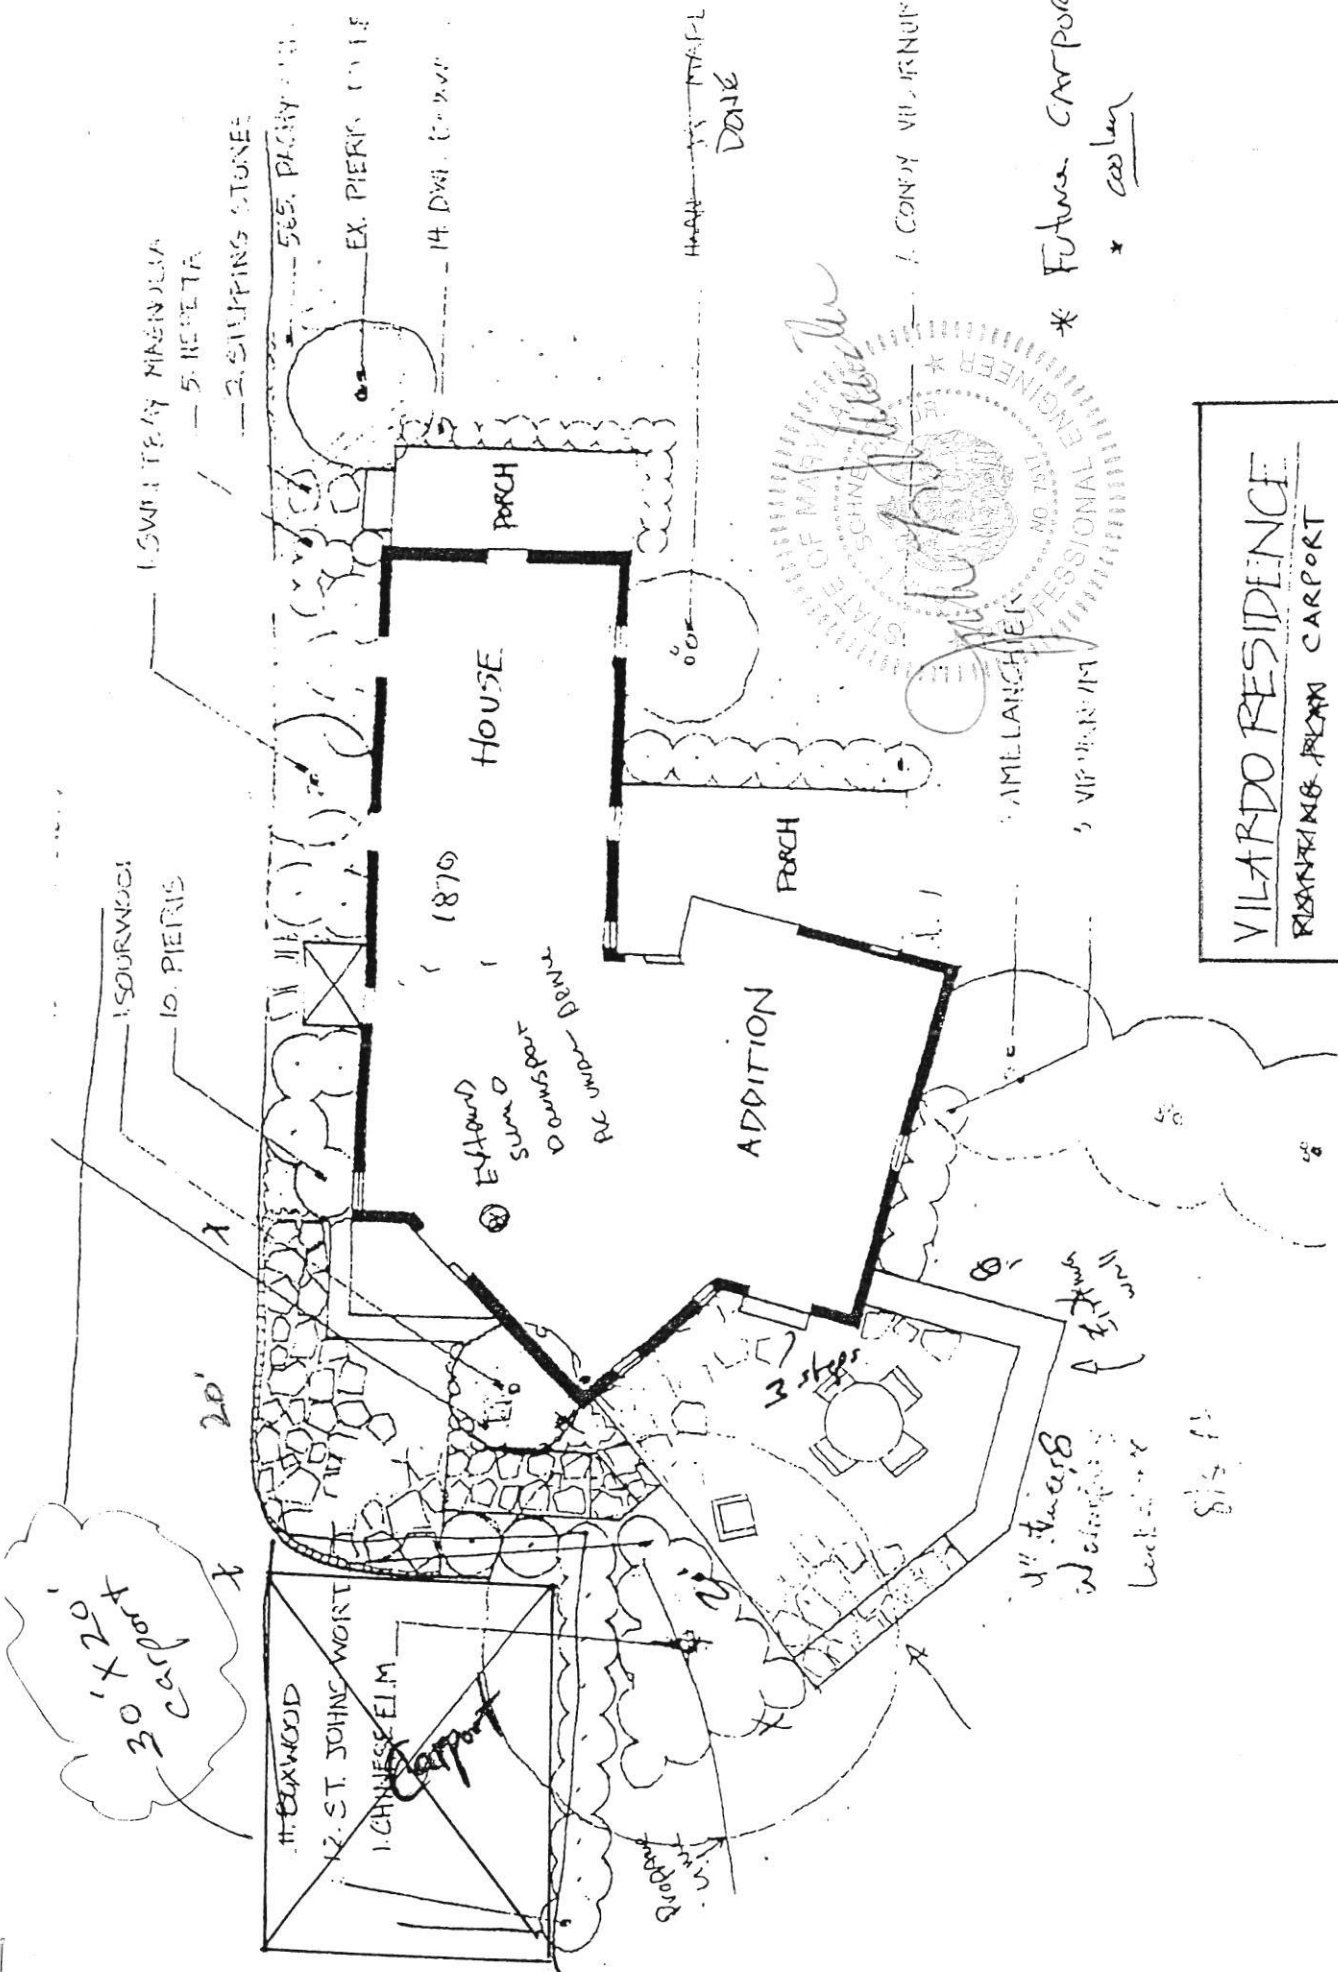

VILARDO RESIDENCE
 REPAIRING REAR CARPORT
 2340 Daniels Rd.
 Ellicott City, MD 21043

* Future Carport
 * ceiling