

APPLICATION

A 21463

SEWAGE DISPOSAL TESTING

P _____

STATE OF MARYLAND - DEPARTMENT OF HEALTH AND MENTAL HYGIENE

HOWARD COUNTY HEALTH DEPARTMENT
ENVIRONMENTAL HEALTH SERVICES

P. O. BOX 476, ELLICOTT CITY, MARYLAND 21043
TELEPHONE: 465-5000, EXT. 356

DISTRICT 3rd

DATE 5/7/75

TO: THE COUNTY HEALTH OFFICER
ELLICOTT CITY, MARYLAND

I, HEREBY, APPLY FOR THE NECESSARY TEST IN ORDER TO CONSTRUCT (OR RECONSTRUCT) A SEWAGE DISPOSAL SYSTEM.

PROPERTY OWNER LOIS MAISEL (CONTACT PURCHASER LYOYD Jerome FORD, JR., MARY REGINA FORD, his wife)
ADDRESS 5015 LAKE CIRCLE W. ELLICOTT CITY, Md 21044 PHONE 730 5038

PROPERTY LOCATION:

SUBDIVISION TRIDELPHIA FARMS LOT NO. 9

ROAD AND DESCRIPTION TRIDELPHIA ROAD OPPOSITE WALT ANN DRIVE

SIZE OF LOT 5.145 Acres TYPE BLDG. 4 Bedroom
NUMBER OF BEDROOMS

IF NOT SINGLE RESIDENCE DESCRIBE _____

THE SYSTEM INSTALLED UNDER THIS APPLICATION IS ACCEPTABLE ONLY UNTIL PUBLIC FACILITIES BECOME AVAILABLE.

SIGNATURE OF APPLICANT [Signature]


APPROVED BY _____ FOR _____ DATE _____
(KIND OF SYSTEM)

REJECTED BY _____ FOR _____ DATE _____
(KIND OF SYSTEM)

HOLD PENDING FURTHER TESTS _____ DATE _____

REASONS FOR REJECTION OR HOLDING _____

THIS IS NOT A PERMIT

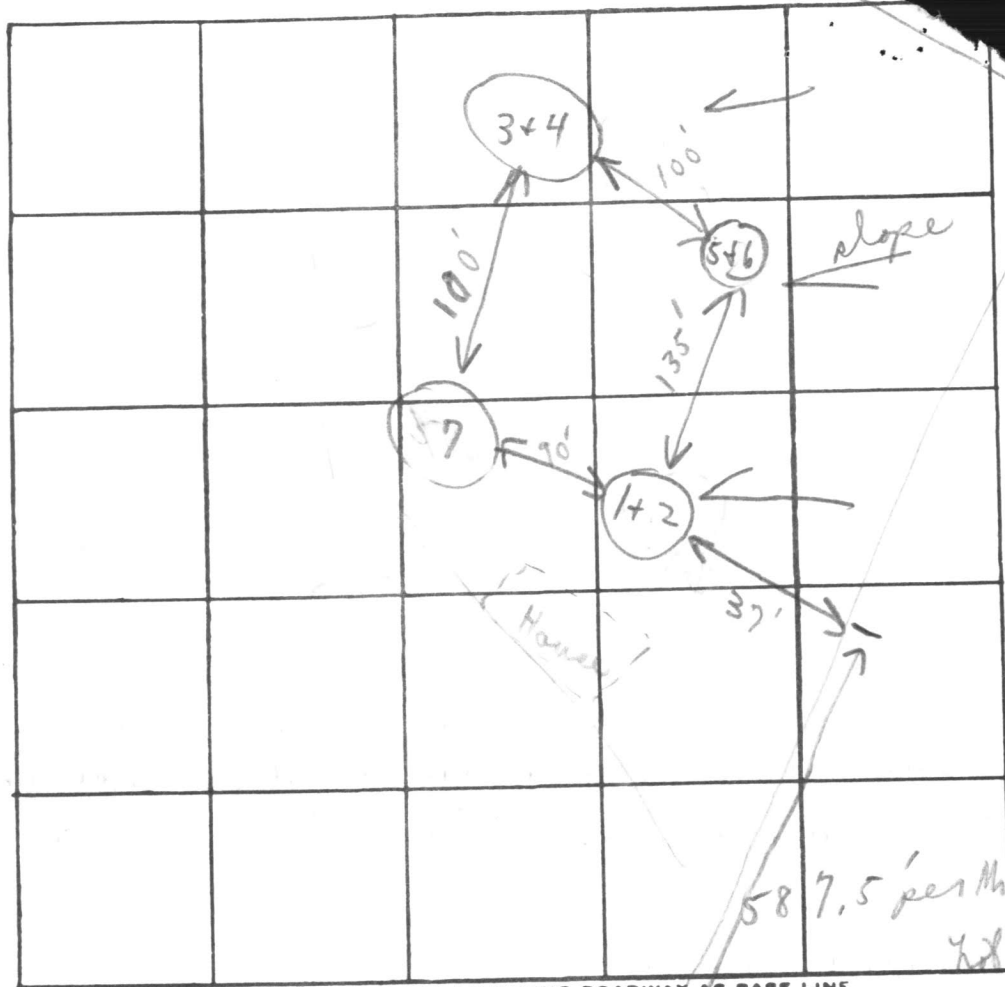

58 7.5' per Mr. Ford
Lid #9

INDICATE NORTH. - NAME ADJOINING ROADWAY AS BASE LINE

DATE	TEST NO.	DEPTH	PRE-WET		TEST - 1" DROP		TIME
			START	STOP	START	STOP	
5/23/78	1	4'	10:52	10:55	10:55	11:01	6 min
	(H) 2	11 1/2'	10:52	10:55	10:55	10:59	4 min
	3	4 1/2'	11:13	11:17	11:17	11:22	5 min
	(L) 4	11 1/2'	11:13	11:16	11:16	11:21	5 min
	5	5 1/2'	11:05	11:07	11:07	11:11	4 min
	(H) 6	12'	11:05	11:07	11:07	11:12	5 min
	(H) 7	10 1/2'	Visual	similar	similar	to	5 min
						6 29" test	

REMARKS

(Sandy mica below clay)

TYPE OF SOIL

TESTED BY

CBD

ALSO PRESENT:


L. Jerome Ford
Ls.

THE LOT SHOWN HEREON COMPLIES WITH THE MINIMUM
CITYSHIP & LOT AREA AS REQUIRED BY THE MARYLAND
STATE DEPARTMENT OF HEALTH.

FOR PRIVATE WATER & PRIVATE
SEWAGE SYSTEMS.

HOWARD COUNTY HEALTH OFFICER

DATE

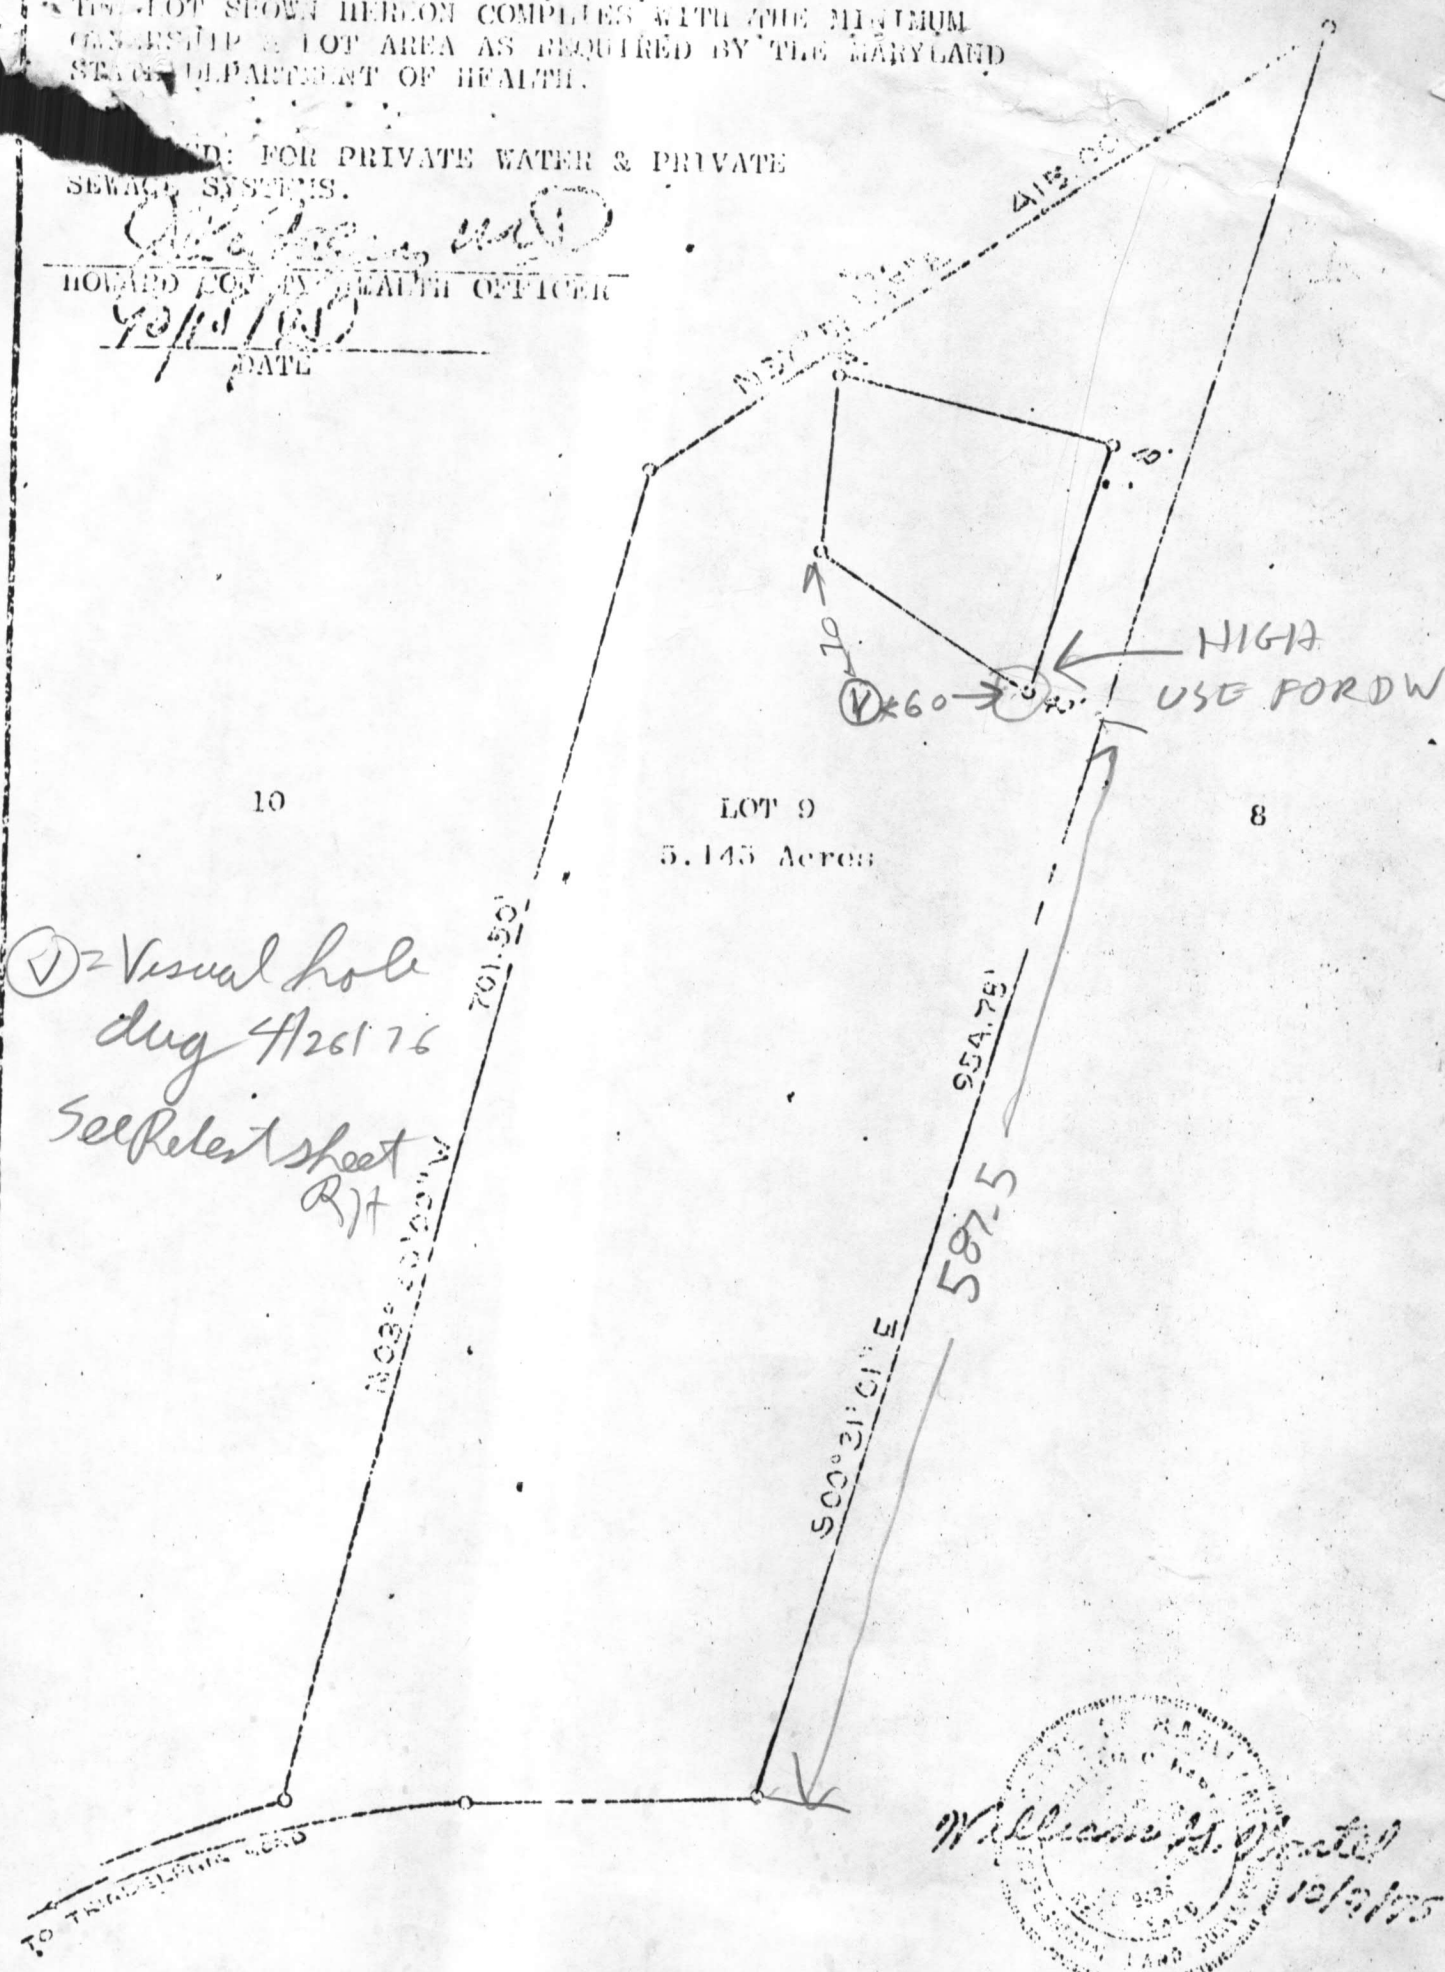

William H. Glatfelter
12/9/75

TITLE PERCOLATION TEST CERTIFICATION PLAT				ENGINEERING PLANNING SURVEYING BY BOENDER ASSOCIATES INC. BALTIMORE, MD. 474-7777 SALISBURY, MD. 743-1213 WESTMINSTER, MD. 840-6523
PROJECT TRIADELPHIA FARMS - SECTION 1 - LOT 9				
LOCATION THIRD ELECTION DISTRICT - HOWARD COUNTY, MD.				
DATE: Oct. 8, 1975	DESIGN BY:	DRAWN BY: DMR	CHECKED BY: WGH	
SCALE: 1" = 100'		JOSS CO. 75120	DRAWG. NO.: 1 of 1	

PERCOLATION CERT.