
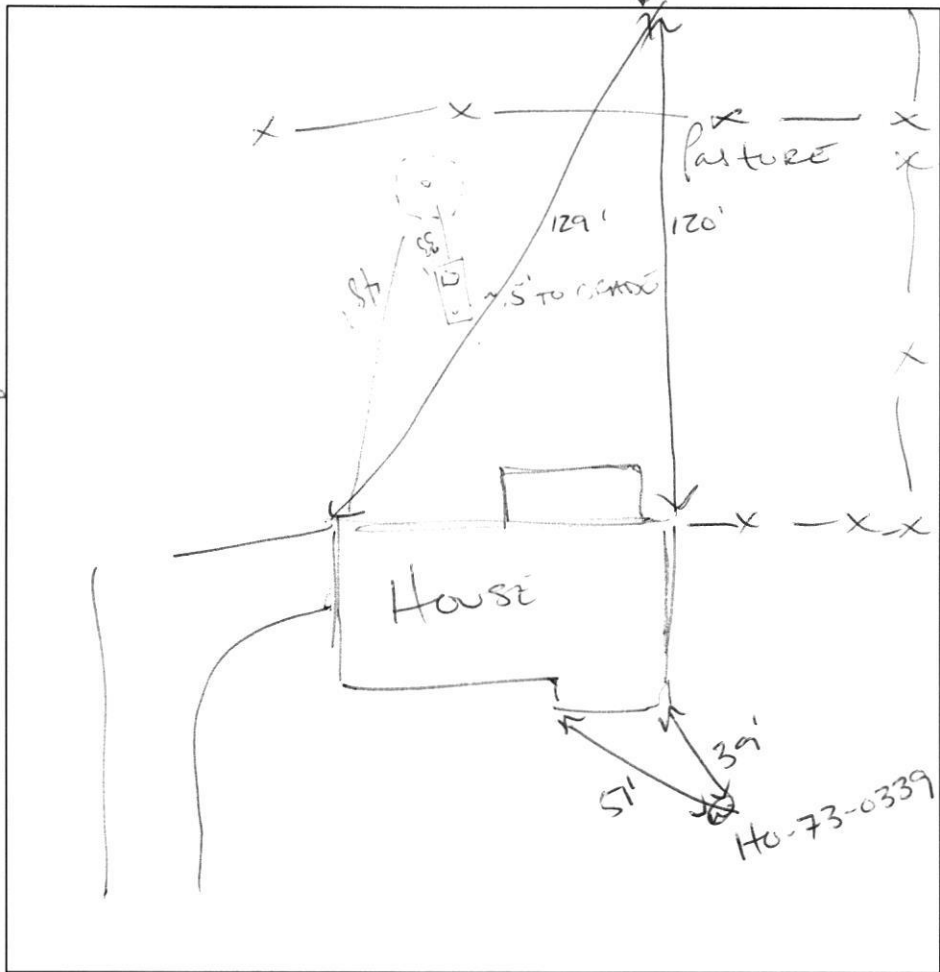


AP _____

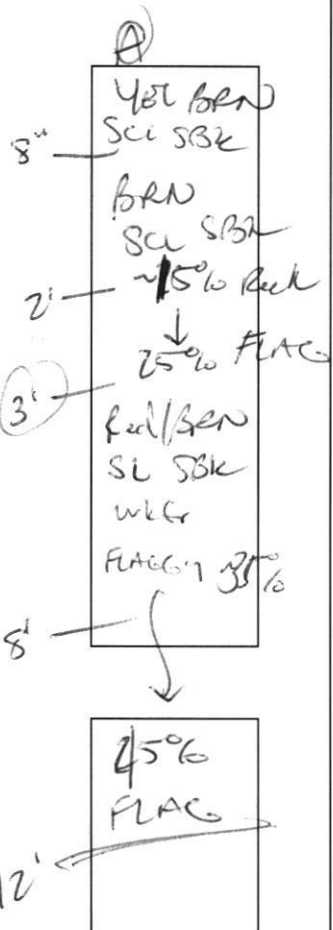

DATE	TEST #	DEPTH	START	BREAK 1" DROP	STOP 2" DROP	TIME OF 2ND INCH	P/F/H
12/02/2022	A	3' 8'	0:00	2:00	4:30	2:30	P

REMARKS EX DW IS COLLAPSING
 SANITARIAN CABANUG BACKHOE FOGLES OTHERS Homeowner
 TEST HOLES USED IN SDA 1 AVG. PERC TIME 2:30 SQ. FT/BR 4
 TRENCH WIDTH 3' INLET DEPTH 3' MAX. BOT DEPTH 8' EFFECTIVE SW 5'

Date: 12/2/22 Time: 10:00 AM
Job Name: Micahael Berlinger
Address: 2136 Woodbine Rd
Woodbine, MD 21797
Phone #: 240-381-2183
Permit #: P572868

Confirmed

- Yes
 Left Message
 Sent Email

Job Type: **Perc Repair**

Ms Utility: 22844778 expires 12/12/22

Start time: 10:00

Fogle's Operator: mike

End time: 11:30

County Sanitarian: JOESPH

Total Holes: 1

Engineer: _____

Passing Holes: 1

Notes: _____

Failing Holes: 0

Septic Design Info

Trench Info

Num. of Trenches: _____ Staked: Yes No

Total Trench Length: 60

Trench Width: 3

Trench Depth: 8

Stone Depth (Total): 5

D-box: 5 hole

Tank Info

Keep existing 1250 gallon tank

Existing tank has manhole riser

Install/replace riser and manhole lid on existing tank

1 ft of manhole riser 1 lid(s)

Install new _____ gallon tank

Install new _____ gallon pump chamber

Pipe Info

140 ft of 4" sch. PVC Pipe

_____ ft of 2" sch. PVC Pipe

20 ft of 6" sch. PVC Pipe to cross water line

Additional Notes: _____

Abandonment Info

Abandon existing drainfields in place

Repair
~~Pump, crush and backfill~~ existing drywell(s)

Pump, crush and backfill existing septic tank

Install bullrun valve to rest existing trenches/drywell

water + electric to barn need to be located by 4/0

sleeve sewer line over water line, leave dirt onsite

remove DIW lid Fill with stone with 4 way Tee

to overflow into new trench. 3 load of #2 for trench

1 load of #2 for DIW