

Bureau of Environmental Health
 8930 Stanford Boulevard, Columbia, MD 21045
 Main: 410-313-2640 | Fax: 410-313-2648
 TDD 410-313-2323 | Toll Free 1-866-313-6300
www.hchealth.org
 Facebook: www.facebook.com/hocohealth

Maura J. Rossman, M.D., Health Officer

RECEIPT DATE: 11/14/22 **ONSITE SEWAGE DISPOSAL SYSTEM** P 572686

APPROVAL DATE: 12/29/2023 **PERMIT:** REPAIR A _____

PROPERTY ADDRESS: 2136 Woodbine Road

SUBDIVISION: _____ LOT: _____ TAX ID: _____

CONTRACTOR: Fogle's Septic Clean Inc. EMAIL: kim@foglesinc.com

CONTRACTOR ADDRESS: 580 Obrecht Road, Sykesville, MD 21784 PHONE: 410-795-5670

PROPERTY OWNER: Michael Berlanger EMAIL: _____

OWNER ADDRESS: 2136 Woodbine Road, Woodbine, MD 21797 PHONE: _____

SEPTIC TANK SIZE (GALLONS): EXISTING TANK MANUFACTURER: UNKNOWN

PUMP MODEL: - PUMP SIZE: - PUMP TANK CAPACITY: -

DISTRIBUTION SYSTEM: GRAVITY PRESSURE DOSED BEDROOMS: _____ APPLICATION RATE: _____

TRENCHES:	LINEAR FEET REQUIRED: <u>61'</u>	INLET DEPTH: <u>3'</u>
	TRENCH WIDTH: <u>3'</u>	MAXIMUM BOTTOM DEPTH: <u>8'</u>
	MINIMUM SPACE BETWEEN TRENCHES: <u>N/A</u>	EFFECTIVE AREA BEGINNING DEPTH: <u>3'</u>

LOCATION: **PER APPROVED SITE PLAN. SEWAGE DISPOSAL AREA AND TANK LOCATIONS MUST BE STAKED BY LICENSED SURVEYOR PRIOR TO PRE-CONSTRUCTION INSPECTION.**


NOTES: REPLACE SEWER LINE, INSTALL RISER (TANK OUTLET)
*OK TO UPGRADE EX DW, OK TO TIE IN NEW TRENCH TO UPGRADED DW.

ISSUED BY: CABATHUG 001997 ISSUE DATE: 12/21/22 EXPIRATION DATE: 12/21/23

- NOTE: CONTRACTOR MUST SCHEDULE A PRE-CONSTRUCTION INSPECTION PRIOR TO BEGINNING ANY INSTALLATION
- NOTE: CONTRACTOR MUST SCHEDULE AN INSPECTION AND GAIN APPROVAL OF ALL COMPONENTS PRIOR TO COVERING
- NOTE: STONE MUST BE APPROVED BY HEALTH DEPARTMENT AND GRAVEL TICKET MUST BE AVAILABLE FOR REVIEW.
- NOTE: WATERTIGHT TANKS REQUIRED
- NOTE: ALL PARTS OF SEPTIC SYSTEM SHALL BE AT LEAST 100 FEET DOWNGRADIENT FROM ANY WATER WELL
- NOTE: MANHOLE RISERS REQUIRED ON ALL SEPTIC TANKS AND PUMP CHAMBERS
- NOTE: AN ELECTRICAL PERMIT IS REQUIRED FOR INSTALLATION OF ANY ELECTRICAL COMPONENTS OF THE SYSTEM
 ELECTRICAL PERMIT ISSUED E -
- NOTE: MDE RECOMMENDS SEPTIC TANKS, BAT, AND OTHER PRETREATMENT UNITS BE PUMPED AT A FREQUENCY ADEQUATE TO ENSURE THAT SOLIDS ARE NOT DISCHARGED TO THE DISPOSAL AREA

**NEITHER THE HOWARD COUNTY COUNCIL NOR THE HEALTH DEPARTMENT IS RESPONSIBLE FOR THE SUCCESSFUL OPERATION OF ANY SYSTEM.
 PERMITTEE RESPONSIBLE FOR OBTAINING FINAL APPROVAL ON THIS PERMIT.
 CALL 410-313-1771 TO SCHEDULE INSPECTIONS.**

NOT TO SCALE

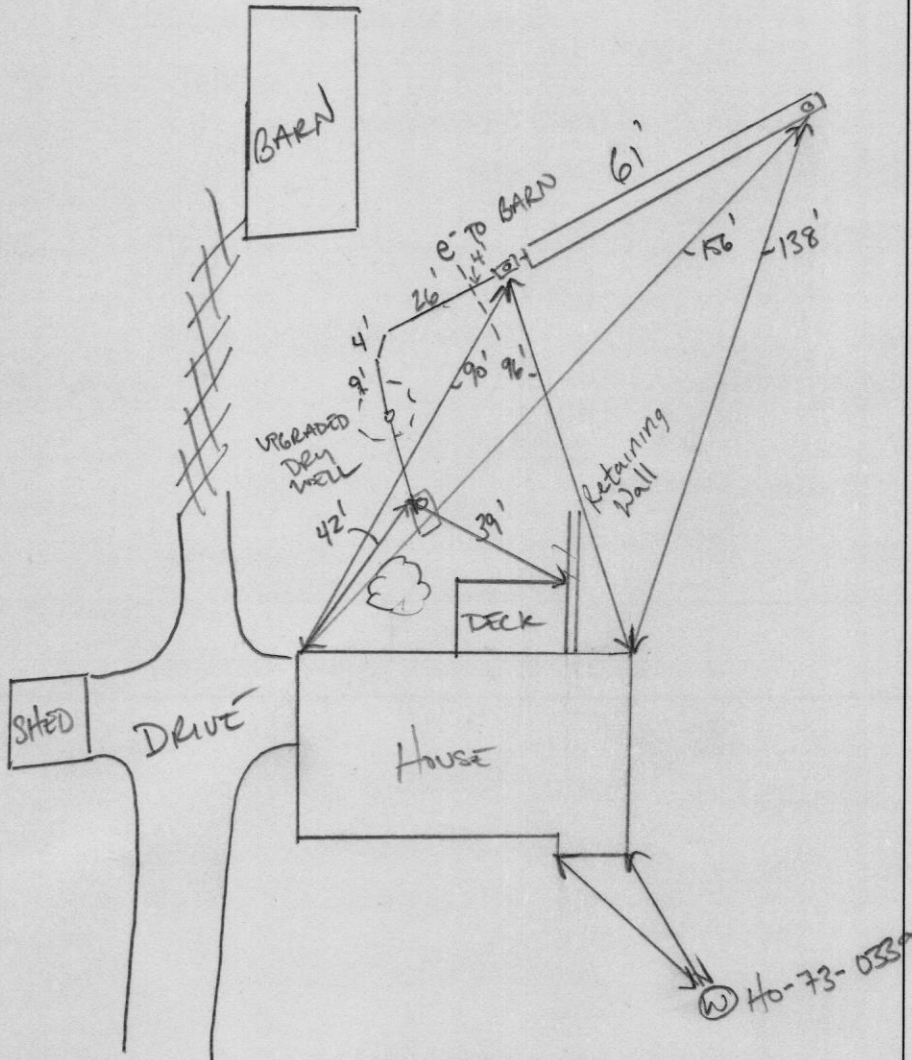

TRENCH/DRAINFIELD DATA		
WIDTH	INLET	BOTTOM
3	3'	8'
NUMBER OF TRENCHES		1
TOTAL LENGTH		61 F
ABSORPTION AREA		183 SF + 9' SIDE WALL
DISTRIBUTION BOX LEVEL		N/A
DISTRIBUTION BOX BAFFLE		DW1
DISTRIBUTION BOX PORT		YES

SEPTIC TANK DATA	
SEPTIC TANK 1 LEVEL	0
MANUFACTURER	
CAPACITY	GAL
SEAM LOC	
TANK LID DEPTH	
BAFFLES	
BAFFLE FILTER	
MANHOLE LOC	
6" PORT LOC	
WATERTIGHT TEST	
SLOTTED	
DATE ON LID	
PUMP/SEPTIC TANK LEVEL	
MANUFACTURER	
CAPACITY	GAL
SEAM LOC	
TANK LID DEPTH	
BAFFLES	
BAFFLE FILTER	
MANHOLE LOC	
6" PORT LOC	
WATERTIGHT TEST	
SLOTTED	
DATE ON LID	

ROAD NAME
COMMON DRIVE TO WOODBINE ROAD

PRE-CONSTRUCTION: 12/02/2022 Contractor laid out proposed trench on contour. *[Signature]*

INSTALLATION: 12/29/2022 RISER INSTALLED; DW UPGRADED; NEW OUTLET BAFFLE INSTALLED; TRENCH COMPLETE. *[Signature]*

FINAL INSPECTOR *[Signature]* DATE OF APPROVAL 12/29/2022

Woodbine RD

Ex. Well 1181

2136

6" Ex. 6/40

New Riser/Lid
New Box
New

280'

Dropped off @ HCHD to Kevin Wolfe on 12-14-22

608'

NO Neighboring Wells within 100 ft

Trench Detail
1-61' Length
3" wide
8' Deep
5' Stone below pipe

2136 Woodbine Rd.
Woodbine, MD-
21797

Permit #P-572868

Approved Septic System Plan
Howard County Health Department

Signature

Date

12/16/2022

Fogle's Septic Clean, Inc. Office Copy
Sykesville, MD 21784

Job #	279
-------	-----

Job Type	Permit #	Elec Needed	Job Received Date	Follow Up Due	Ms Util Exp. Date	Operator
Perc Repair	P572686	Unknown	11/11/2022	11/11/2022	12/27/2022	MTH

Billing Address		Job Address		Customer Contact Info	
MICHAEL BERLANGER 2136 WOODBINE RD WOODBINE, MD 21797		MICHAEL BERLANGER 2136 WOODBINE RD WOODBINE, MD 21797		Phone	240-381-2183
				Alt. Phone	
				E-mail	michaelberlanger@gmail...

Job Notes

Job 279 - Berlanger - 2136 Woodbine Rd
 Paperwork Location: permit folder
 Signed Perc Proposal: 11/10/22
 Signed Proposal: 12/8/22
 Deposit: 12/9/22
 Ms Utility Ticket Info:
 22799039 expires 11/22/22
 22844778 expires 12/12/22
 22879498 expires 12/27/22
 11/11/22 - sending Jeff to HCHD on Mon with permit application and check
 Emailed Kevin Wolf to schedule perc
 11/15/22 - updated paperwork with permit; will call and email Kevin again tomorrow
 11/17/22 - sent Kevin dates we are available; waiting for reply
 11/18/22 - still waiting to hear back from Kevin; left VM
 Scheduled perc with Kevin for Fri 12/2/22 at 10am (w/ Joseph)
 Confirmed with homeowner
 12/6/22 - emailed proposal and spoke with homeowner. He wants this taken care of ASAP as the drywell could collapse and is a safety hazard for his kids.
 Since it's in Woodbine, Kurt said we can start once permit is approved and we have a free operator. Waiting for homeowner to call back about proposal and will update when we can start.
 12/8/22 - giving to Jeff to finalize permit with HCHD; Michael bringing deposit check to office
 12/19/22 - Kevin pending review
 -> w/ Joseph
 12/21/22 - ^{Permit} ready for pickup per Joseph
