

HOWARD COUNTY
PERMIT APPLICATION

PERMIT NUMBER

BOO157351

Building Address 13964 TRIADUPLINA RD
GLENMELB MD 21737
Suite/Apt. #: N/A SDP/WP/Permit #: 2-211410
Census Tract 603000 Subdivision CRYSTAL CLEAR
Section _____ Area _____ Lot 15
Tax Map 22 Parcel 533 Grid 7
Zoning R2050 Map Coordinates _____ Lot size 5.67 AC.

Property Owner's Name SAME AS OCCUPANT
Address DANA BORG
City _____ State _____ Zip Code _____
Home Phone _____ Work Phone _____
Applicant's Name & Mailing Address, (if other than stated hereon):
Phone _____ Fax _____

Existing Use SFD
Proposed Use SFD WITH MORNING RUSH ADDITION
Estimated Construction Cost \$ 30,000
Description of Work 16' x 21' MORNING RUSH 2 STORIES
WITH FP, 13' x 16' DECK WITH STAIRS,
1.5' x 4' GARDEN

Contractor Company SAME AS OCCUPANT
Contact Person _____
Address _____
City _____ State _____ Zip Code _____
License No. _____
Phone _____ Fax _____

Occupant or Tenant DANA DOUGLAS BORG
Contact Name DANA BORG
Address 13964 TRIADUPLINA RD
City GLENMELB State MD Zip Code 21737
Phone 410-984-2986 Fax _____

Engineer or Architect Company D.W. Taylor
Contact Person MIKE HAMMEL
Address 5024 DUNN HALL DRIVE
City NEW HAVEN CITY State MD Zip Code 21242
Phone 410-914-1121 Fax 410-997-2424

BUILDING DESCRIPTION - COMMERCIAL

BUILDING DESCRIPTION - RESIDENTIAL

Building Characteristics	Utilities
Height: _____	Water Supply: _____ Public ☐ Private ☐
No. of stories: _____	Sewage Disposal: _____ Public ☐ Private ☐
Gross area, sq. ft. per floor: _____	Electric Yes ☐ No ☐ Gas Yes ☐ No ☐
Use group: _____	Heating System: _____ Electric ☐ Oil ☐ Natural Gas ☐ Propane Gas ☐
Construction type: _____ Reinforced Concrete ☐ Structural Steel ☐ Masonry ☐ Wood Frame ☐ State Certified Modular ☐	Sprinkler system: <u>N/A</u> ☐ Full ☐ Partial ☐ Other Suppression ☐ # of Heads _____

Building Characteristics	Utilities
SF Dwelling ☒ SF Townhouse ☐ Depth _____ Width _____ 1st floor: <u>16</u> <u>21</u> 2nd floor: <u>N/A</u> <u>N/A</u> Basement: <u>1</u> <u>21</u> Finished Basement ☒ Unfinished Basement ☐ Crawl space ☐ Slab on Grade ☐ No. of Bedrooms: _____ Height: _____ Multi-family dwellings: No. of efficiency units: _____ No. of 1 BR units: _____ No. of 2 BR units: _____ No. of 3 BR units: _____ Other Structure: _____ Dimensions: _____ Footings: _____ Roof Height: _____ State Certified Modular ☐ Manufactured Home ☐	Water Supply: _____ Public ☐ Private ☒ Sewage Disposal: _____ Public ☐ Private ☒ Electric Yes ☐ No ☐ Gas Yes ☐ No ☐ Heating System: _____ Electric ☐ Oil ☐ Natural Gas ☐ Propane Gas ☒ Sprinkler system: <u>N/A</u> ☐ NFPA #13D ☐ NFPA #13R ☐ Other: _____

THE UNDERSIGNED HEREBY CERTIFIES AND AGREES AS FOLLOWS: (1) THAT HE/SHE IS AUTHORIZED TO MAKE THIS APPLICATION; (2) THAT THE INFORMATION IS CORRECT; (3) THAT HE/SHE WILL COMPLY WITH ALL REGULATIONS OF HOWARD COUNTY WHICH ARE APPLICABLE THERETO; (4) THAT HE/SHE WILL PERFORM NO WORK ON THE ABOVE REFERENCED PROPERTY NOT SPECIFICALLY DESCRIBED IN THIS APPLICATION; (5) THAT HE/SHE GRANTS COUNTY OFFICIALS THE RIGHT TO ENTER ONTO THIS PROPERTY FOR THE PURPOSE OF INSPECTING THE WORK PERMITTED AND POSTING NOTICES.

Dana D. Borg
Applicant's Signature
DW-1573
Title/Company

DANA D. BORG
Print Name
12/2/05
Date

Checks payable to: DIRECTOR OF FINANCE OF HOWARD COUNTY
** PLEASE WRITE NEATLY AND LEGIBLY. **
- FOR OFFICE USE ONLY -

AGENCY	DATE	SIGNATURE APPROVAL
☒ Land Development DPZ		
☐ State Highways		
☒ Building Official		
☒ Dev. Engineering DPZ		
☒ Health	<u>12/29/05</u>	<u>[Signature]</u>
☒ Fire Protection		

Is Sediment Control approval required prior to issuance?
YES ☐ NO ☐


CONTINGENCY CONSTRUCTION START: ☐
ONE STOP SHOP: ☐

Distribution of Copies: _____
White: Building Official
Green: LDD, DPZ
Name/PERMIT.FRM

DPZ SETBACK INFORMATION

Front: _____	Filing fee	\$ <u>5.00</u>
Rear: _____	Permit fee	\$ _____
Side: _____	Excise tax	\$ _____
Side St.: _____	Add'l per. fee	\$ _____
All minimum setbacks met?	TOTAL FEES	\$ _____
YES ☐ NO ☐	Sub-total paid	\$ _____
Is Entrance Permit required?	Balance due	\$ _____
YES ☐ NO ☐	Check	\$ <u>2.00</u>
Historic District?	Validation	# _____
YES ☐ NO ☐		
Lot Coverage for New Town Zone _____		
SDP/Red-line approval date _____		

Accepted by _____
Yellow: DED, DPZ
Pink: Health
Gold: SPA

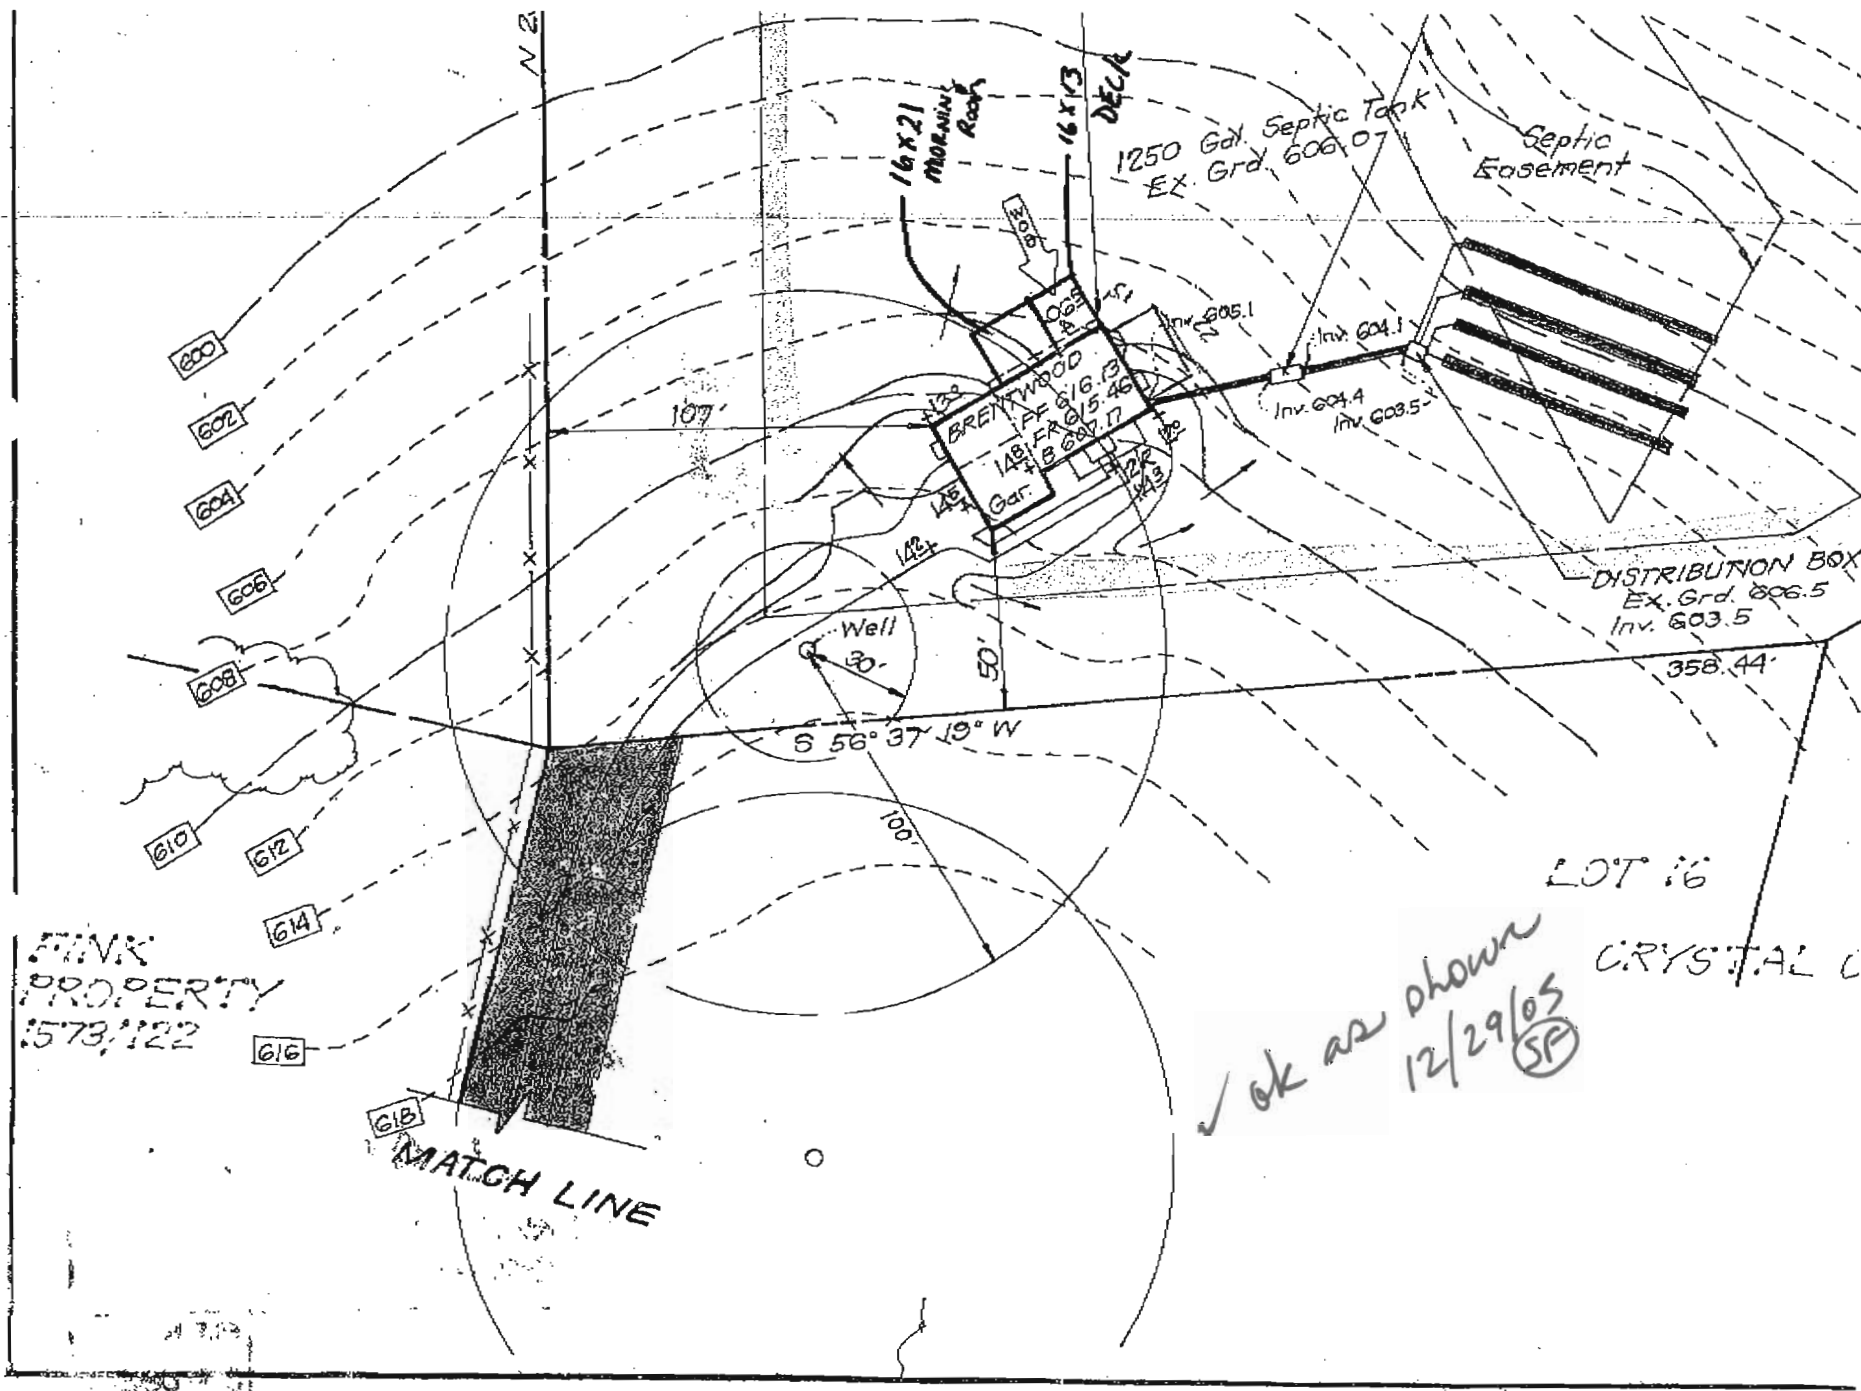

MINOR
PROPERTY
1952/83

MELGAN ACRES
LOT 2
PLAT 6828

PINK
PROPERTY
1573/122

LOT 14
CRYSTAL CLEAR

LOT 16
CRYSTAL CLEAR

LOT 17

LEGEND

Contour Interval 2 Ft.
Existing Contour ————
Proposed Contour ————
Spot Elevation + 00.0
Direction of Drainage ————
Walkout Basement ————

VICINITY MAP

Scale: 1" = 2000'

GENERAL NOTES

1. Existing topography was taken from plans prepared by Madris, Hehricks and Witmer P.A.
2. Length of Septic trenches to be determined at time of permit issuance.
3. Total number of bedrooms: 4
4. Reference plat number 8446

CLARK • FINEFROCK & SACKETT, INC.
ENGINEERS • PLANNERS • SURVEYORS

7135 MINSTREL WAY • COLUMBIA, MD. 21045 • (410) 381-7500 — BALTO. • (301) 621-8100 — WASH.

DESIGNED JME	SITE DEVELOPMENT PLAN LOT 15 CRYSTAL CLEAR 3RD ELECTION DISTRICT HOWARD COUNTY MARYLAND For: DOUGLAS HOMES P.O. Box 628 Ellicott City, Md. 21046	SCALE 1" = 50'
DRAWN BAL		DRAWING 1 OF 1
CHECKED JME		JOB NO. 94-089
DATE 5-13-94		FILE NO. 94-089-X