

June 23
9:30
J. Frock

APPLICATION

PERCOLATION TESTING

6/23/86
perc OK'd
pending plat
②

A 37089

P _____

HOWARD COUNTY HEALTH DEPARTMENT
BUREAU OF ENVIRONMENTAL HEALTH
P.O. BOX 476 ELLICOTT CITY, MARYLAND 21043
TELEPHONE: 461-9933

DISTRICT 4th

DATE JUNE 2, 1986

TO: THE COUNTY HEALTH OFFICER
ELLICOTT CITY, MARYLAND

I, HEREBY, APPLY FOR THE NECESSARY TEST IN ORDER TO CONSTRUCT (OR RECONSTRUCT) A SEWAGE DISPOSAL SYSTEM.

PROPERTY OWNER JOHN F. RETTALIATA

ADDRESS 4300 HERITAGE HILL DRIVE ELLICOTT CITY PHONE 581-3824

PROSPECTIVE BUYER _____

ADDRESS _____ PHONE _____

PROPERTY LOCATION:

SUBDIVISION VACK'S CHOISE LOT NO. 2 ^{m from}

ROAD AND DESCRIPTION 14860 TAIADLONIA ROAD

TAX MAP 27 PARCEL # 40

SIZE OF LOT 3+ ACRES TYPE BLDG. SINGLE FAMILY
(SINGLE FAMILY DWELLING OR COMMERCIAL)

THE SYSTEM INSTALLED UNDER THIS APPLICATION IS ACCEPTABLE ONLY UNTIL PUBLIC FACILITIES BECOME AVAILABLE. I FULLY UNDERSTAND THE FEE CONNECTED WITH THE FILING OF THIS PERC TEST APPLICATION IS NON-REFUNDABLE UNDER ANY CIRCUMSTANCES. I ALSO AGREE TO COMPLY WITH ALL M.O.S.H.A. REQUIREMENTS IN TESTING THIS LOT.

John Rettaliata
(SIGNATURE OF APPLICANT)

APPROVED BY _____ FOR _____ DATE _____

REJECTED BY _____ FOR _____ DATE _____

HOLD PENDING FURTHER TESTS _____ DATE _____

REASONS FOR REJECTION OR HOLDING For certified plat

BLDG. PERMIT SIGNED
AND RETURNED 5/15/87
GP 11932
S.H.

THIS IS NOT A PERMIT

APPLICATION

PERCOLATION TESTING

A 37189

HOWARD COUNTY HEALTH DEPARTMENT
BUREAU OF ENVIRONMENTAL HEALTH
P.O. BOX 476 ELLICOTT CITY, MARYLAND 21043
TELEPHONE: 461-9933

P. _____
DISTRICT 4^{cd}

DATE JUNE 2 1986

TO: THE COUNTY HEALTH OFFICER
ELLICOTT CITY, MARYLAND

I, HEREBY, APPLY FOR THE NECESSARY TEST IN ORDER TO CONSTRUCT (OR RECONSTRUCT) A SEWAGE DISPOSAL SYSTEM.

PROPERTY OWNER JOHN F. RETTALIATA

ADDRESS 4300 HERITAGE HILL DRIVE ELLICOTT CITY PHONE 531-3824

PROSPECTIVE BUYER _____

ADDRESS _____ PHONE _____

PROPERTY LOCATION:

SUBDIVISION VACK'S CHOISE LOT NO. A

ROAD AND DESCRIPTION TAIADELPHIA ROAD

TAX MAP 27 PARCEL # 40

SIZE OF LOT 3+ ACRES TYPE BLDG. SINGLE FAMILY
(SINGLE FAMILY DWELLING OR COMMERCIAL)

THE SYSTEM INSTALLED UNDER THIS APPLICATION IS ACCEPTABLE ONLY UNTIL PUBLIC FACILITIES BECOME AVAILABLE. I FULLY UNDERSTAND THE FEE CONNECTED WITH THE FILING OF THIS PERC TEST APPLICATION IS NON-REFUNDABLE UNDER ANY CIRCUMSTANCES. I ALSO AGREE TO COMPLY WITH ALL M.O.S.H.A. REQUIREMENTS IN TESTING THIS LOT.

John Rettalata
(SIGNATURE OF APPLICANT)

APPROVED BY _____ FOR _____ DATE _____

REJECTED BY _____ FOR _____ DATE _____


HOLD PENDING FURTHER TESTS _____ DATE _____

REASONS FOR REJECTION OR HOLDING _____

THIS IS NOT A PERMIT

fence

WOODED AREA ↑ = 70'

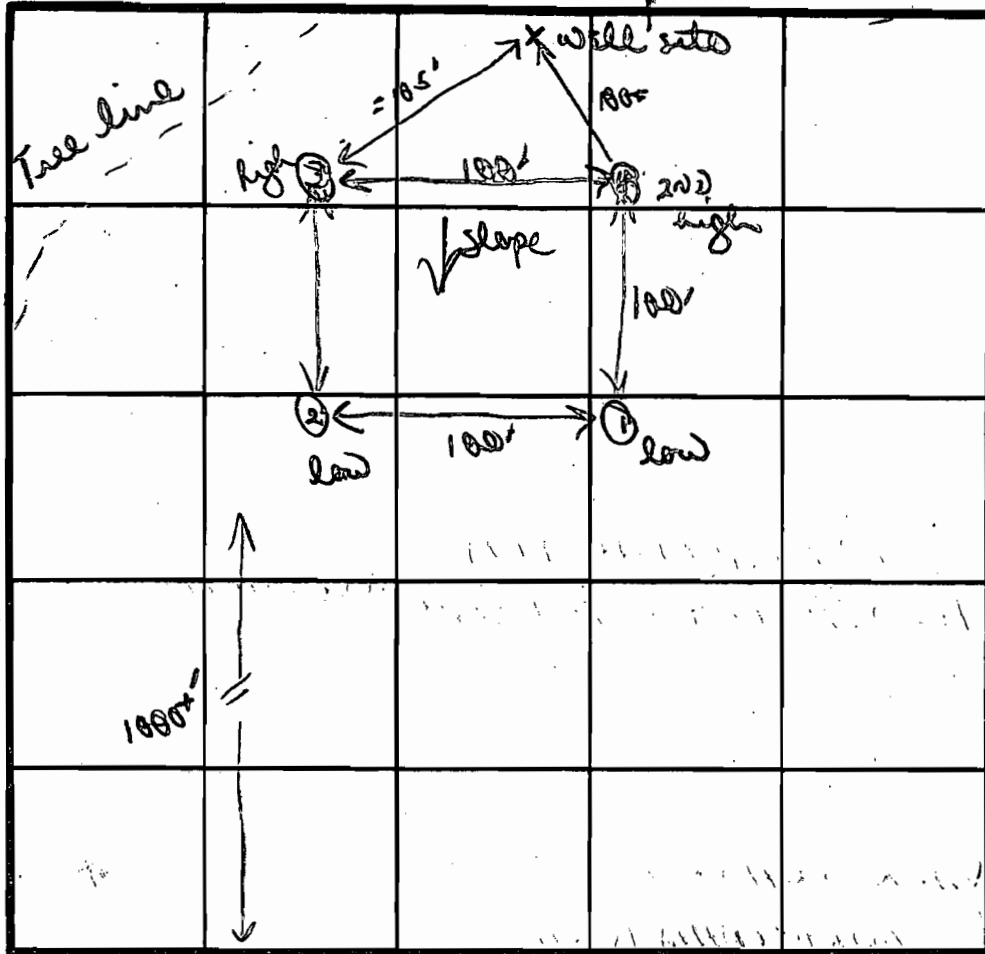

INDICATE NORTH - NAME ADJOINING ROADWAY AS BASE LINE.
TRIADELPHIA RD

SOIL PROFILE

AP zone
orange/brown
clay loam
4'
brown
grey/brown
silty
sandy
mice
loam
9' - small
frag weathered
rock 5-10%
12 1/2' D

orange silty
clay loam
changing
fine powder
purple/brown
silty mice
loam
w/ 5% fine
weathered
material

13' D

fine powder
tan/purple
silty clay
loam

AP ZONE 4'
orange/brown
pretty sandy
clay loam
changing
fine/mud
gray
sandy/mice
loam
5-10% small
frag hard
rock
12 1/2' D

loam
fairly
uniform
silty loam
bottom

13' D
SPECIES
160 Φ
INLET
BOTTOM
7 PERC
3M

DATE	TEST NO.	DEPTH	PRE-WET		TEST - 1" DROP		TIME	
			START	STOP	START	STOP		
6/23/86	①	4'5"	1105	1108	1108	1112	4 MIN	
		12 1/2'	bottom (see profile)					
	②	4 1/2'5"	1107	1109	1109	1112	3 MIN	
		12 1/2' D	bottom (see profile)					
	③	4'5"	1115	1116	1116	1119	3 MIN	
		13' D	bottom (see profile)					
	④	4 1/2'5"	1120	1122	1122	1125	3 MIN	
		13'	bottom (see profile)					

INLET 3 1/2'
MAX DEPTH 8'
33 MIN

REMARKS: sand per lines; soils fairly uniform throughout
majority powdery silty loams, clay % small top.
TYPE OF SOIL: B Nylon
TESTED BY: B Nylon ALSO PRESENT: Skip/Jack