

4/20/79
as far as possible

App.
20 Apr 79
(GLK)

PERMIT

P 29715
A 27991

SEWAGE DISPOSAL SYSTEM

MARYLAND STATE DEPARTMENT OF HEALTH*

HOWARD COUNTY

05-385687

ELLICOTT CITY
5th DISTRICT

INDEXED

DATE 4/16/79

James L. Que IS PERMITTED TO INSTALL ALTER

ADDRESS Route 2, Monrovia, Md. PHONE 831-6228

SUBDIVISION Jeremy Station ROAD 14875 Triadelphia Road LOT 4

PROPERTY OWNER Thomas S. Warfield

ADDRESS 14425 Triadelphia Rd. Glenelg, Md. 21737 PHONE: 442-1186

SPECIFICATIONS
3 Bedrooms
SEPTIC TANK CAPACITY 1000 GALLONS
DRAIN FIELD _____ DEPTH _____ FEET, BOTTOM AREA _____ SQ. FT.
DEEP TRENCH _____ DEPTH _____ FEET, BOTTOM AREA _____ SQ. FT.
SEEPAGE PITS _____ ABSORBENT SIDE-WALL AREA _____ SQ. FT.
INLET PIPE _____ FT. BELOW ORIGINAL GRADE. MAXIMUM DEPTH _____ FT. BELOW ORIGINAL GRADE
EFFECTIVE DEPTH AT _____ FT. BELOW ORIGINAL GRADE.
LOCATE DISPOSAL AREA _____ FT. FROM _____ LOT LINE AND _____ FT. FROM _____ LOT LINE AS SEEN WHEN
FACING LOT FROM


DRY WELL to have 120 square feet of sidewall area per bedroom DRY WELL inlet to be maximum 3 feet below original grade. DRY WELL BOTTOM (Maximum depth) to be 13 feet below original grade. Place the dry well 543 feet from the front lot line and 30 feet from the left lot line as seen when facing the lot from Triadelphia Road.

PLANS APPROVED BY Raymond Hodges DATE 8/22/78

- COVER NO WORK UNTIL INSPECTED AND APPROVED.
- NEITHER THE HOWARD COUNTY COUNCIL NOR THE HEALTH DEPARTMENT IS RESPONSIBLE FOR THE SUCCESSFUL OPERATION OF ANY SYSTEM.
- NOTE: IF TRENCH IS USED CALL FOR INSPECTION BEFORE PLACING GRAVEL IN TRENCH.
- NOTE: NO DRY WELL SHALL EXCEED 15 FOOT IN DIAMETER.
- NOTE: ALL PIPE FROM HOUSE TO DISPOSAL AREA MUST BE CAST IRON.
- PERMIT VOID AFTER THREE YEARS.
- NOTE: INSTALL STAND PIPE ON SEPTIC TANK AND DRY WELL. STAND PIPES MUST BE 6 INCHES IN DIAMETER. CAST IRON, CONCRETE OR TERRA COTTA ACCEPTED.

*INSTALLER IS RESPONSIBLE FOR OBTAINING FINAL APPROVAL ON THIS PERMIT.

A
27991
16642

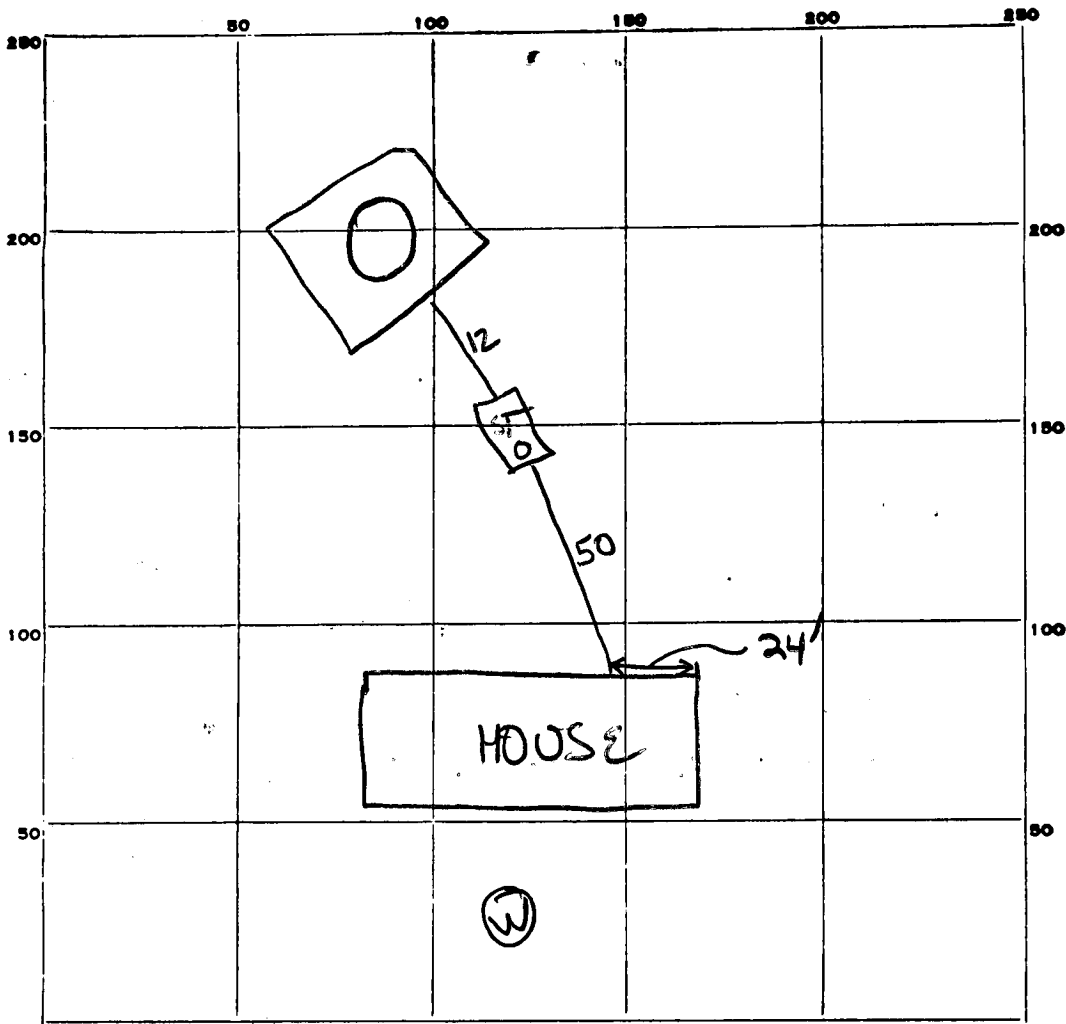

INDICATE NORTH. - NAME ADJOINING ROADWAY AS BASE LINE.

TRIDELPHIA RD

PERMIT CARD

SEPTIC TANK, LEVEL S 1000 Rectangular CLEANOUTS ST | DW CAST IRON

DISTRIBUTION BOX, LEVEL Na

TILE FIELD, DEPTH Na FT. TRENCH WIDTH _____ FT.

GRAVEL DEPTH _____ IN. TOTAL LENGTH _____ FT.

NUMBER OF TRENCHES _____ TOTAL BOTTOM AREA _____

SEEPAGE PITS, INSIDE DIAMETER perimeter 48 FT. DEPTH BELOW INLET 3 → 11 1/2 8 1/2 FT.

ABSORBENT AREA ±408 SQ. FT.

REMARKS 20 Apr 79 FINAL OK (GLK)

DATE SYSTEM APPROVED 20 Apr 79 INSPECTOR G. Keller