

APPLICATION

SEWAGE DISPOSAL TESTING

MARYLAND STATE DEPARTMENT OF HEALTH

HOWARD COUNTY

ELLICOTT CITY

DISTRICT 5th

DATE 9-15-72

17461

A 17460

P _____

TO: THE COUNTY HEALTH OFFICER
ELLICOTT CITY, MARYLAND

I, HEREBY, APPLY FOR THE NECESSARY TESTS IN ORDER TO CONSTRUCT (OR RECONSTRUCT) A SEWAGE DISPOSAL SYSTEM.

PROPERTY OWNER Russell Coleman % Mr. Best

ADDRESS 10412 Montrose Avenue PHONE 493-5790
Bethesda, Maryland 20014

PROPERTY LOCATION:

SUBDIVISION (Coleman-Lerch property) LOT NO. _____

ROAD AND DESCRIPTION Philadelphia Mills Road, Dayton, Md. 21036

OCCUPANT Undeveloped land PHONE _____

PERSON TO CONSTRUCT SYSTEM To be determined

ADDRESS _____ PHONE _____

SIZE OF LOT 6 Acres per survey A-3370-11 TYPE BLDG. Four (4)
NUMBER OF BEDROOMS

IF NOT SINGLE RESIDENCE DESCRIBE _____

SIGNATURE OF APPLICANT Russell Coleman
By Mary Harries Bunte


APPROVED BY _____ FOR _____ DATE _____
(KIND OF SYSTEM)

REJECTED BY _____ FOR _____ DATE _____
(KIND OF SYSTEM)

HOLD PENDING FURTHER TESTS _____ DATE _____

REASONS FOR REJECTION OR HOLDING _____

THIS IS NOT A PERMIT

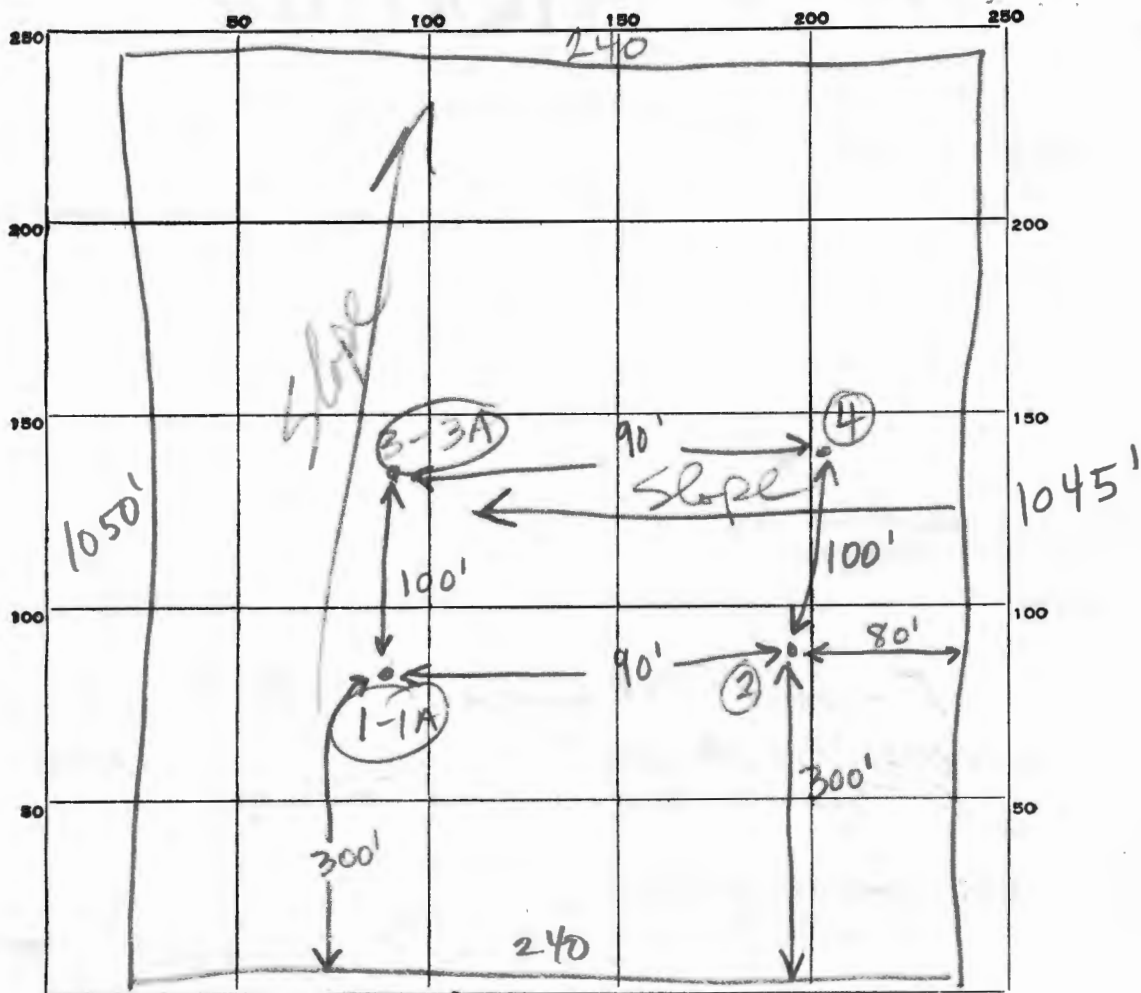

INDICATE NORTH. - NAME ADJOINING ROADWAY AS BASE LINE.

Tridelfia Mill

DATE	TEST NO.	DEPTH	PRE-WET		TEST - 1" DROP		TIME
			START	STOP	START	STOP	
	1	5'	1215	1217	1217	1227	10
	1A	11'	1215	1219	1219	1227	8
	2	11' TOP 4 1/2' clay) Dry				
	3	4'	1155	1206	1206	1214	8
	3A	11'	1155	1206	1206	1218	12
	4	11' TOP 5' clay) Dry				

Average
10 min

SOIL AUGER FINDING

TESTED BY

REMARKS

Dry Well 1-1A

Min Depth 5'

Max Depth 12'

APPLICATION

SEWAGE DISPOSAL TESTING

17461

27462

A _____

P _____

MARYLAND STATE DEPARTMENT OF HEALTH

HOWARD COUNTY Septic tank - 1250 gal

ELLICOTT CITY

DISTRICT 5th

DATE 9-15-72

Dry well - 125 sq ft absorbent area per bedroom
with inlet 5' & max depth 12' below original grade.
Location - 300' from front property line & 170' from right
property line as seen when facing property from Philadelphia
Mill Rd - HTS

TO: THE COUNTY HEALTH OFFICER
ELLICOTT CITY, MARYLAND

I, HEREBY, APPLY FOR THE NECESSARY TESTS IN ORDER TO CONSTRUCT (OR RECONSTRUCT) A SEWAGE
DISPOSAL SYSTEM.

PROPERTY OWNER Russell Coleman % Mr. Best

ADDRESS 10412 Montrose Avenue PHONE 493-5790
Bethesda, Maryland 20014

PROPERTY LOCATION:

SUBDIVISION (Coleman-Lorch property) LOT NO. 11

ROAD AND DESCRIPTION Philadelphia Mills Road, Dayton, Ind. 21036

OCCUPANT Undeveloped land PHONE _____

PERSON TO CONSTRUCT SYSTEM To be determined

ADDRESS _____ PHONE _____

SIZE OF LOT 6 Acres per survey A-3370-11 TYPE BLDG. Four (4)
NUMBER OF BEDROOMS

IF NOT SINGLE RESIDENCE DESCRIBE _____

SIGNATURE OF APPLICANT Russell Coleman
By Mary Harris Bente


APPROVED BY HTS FOR dry well DATE 10/24/72
(KIND OF SYSTEM)

REJECTED BY _____ FOR _____ DATE _____
(KIND OF SYSTEM)

HOLD PENDING FURTHER TESTS _____ DATE _____

REASONS FOR REJECTION OR HOLDING _____

THIS IS NOT A PERMIT

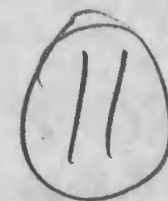

PLAT OF SURVEY
FOR
RUSSELL COLEMAN
FIFTH ELECTION DISTRICT OF HOWARD COUNTY
DAYTON, MARYLAND

SCALE: 1 IN. = 200 FT.

MAY 3, 1972

Claude M. Skinner, Jr.

Claude M. Skinner, Jr.
Reg. Professional Engineer &
Land Surveyor No. 2237

